




4873 006002592 I:\ACAD\PROJ\06002592\06005362 Scale: 1:32 Date: 05/01/1997 Time: 08:36

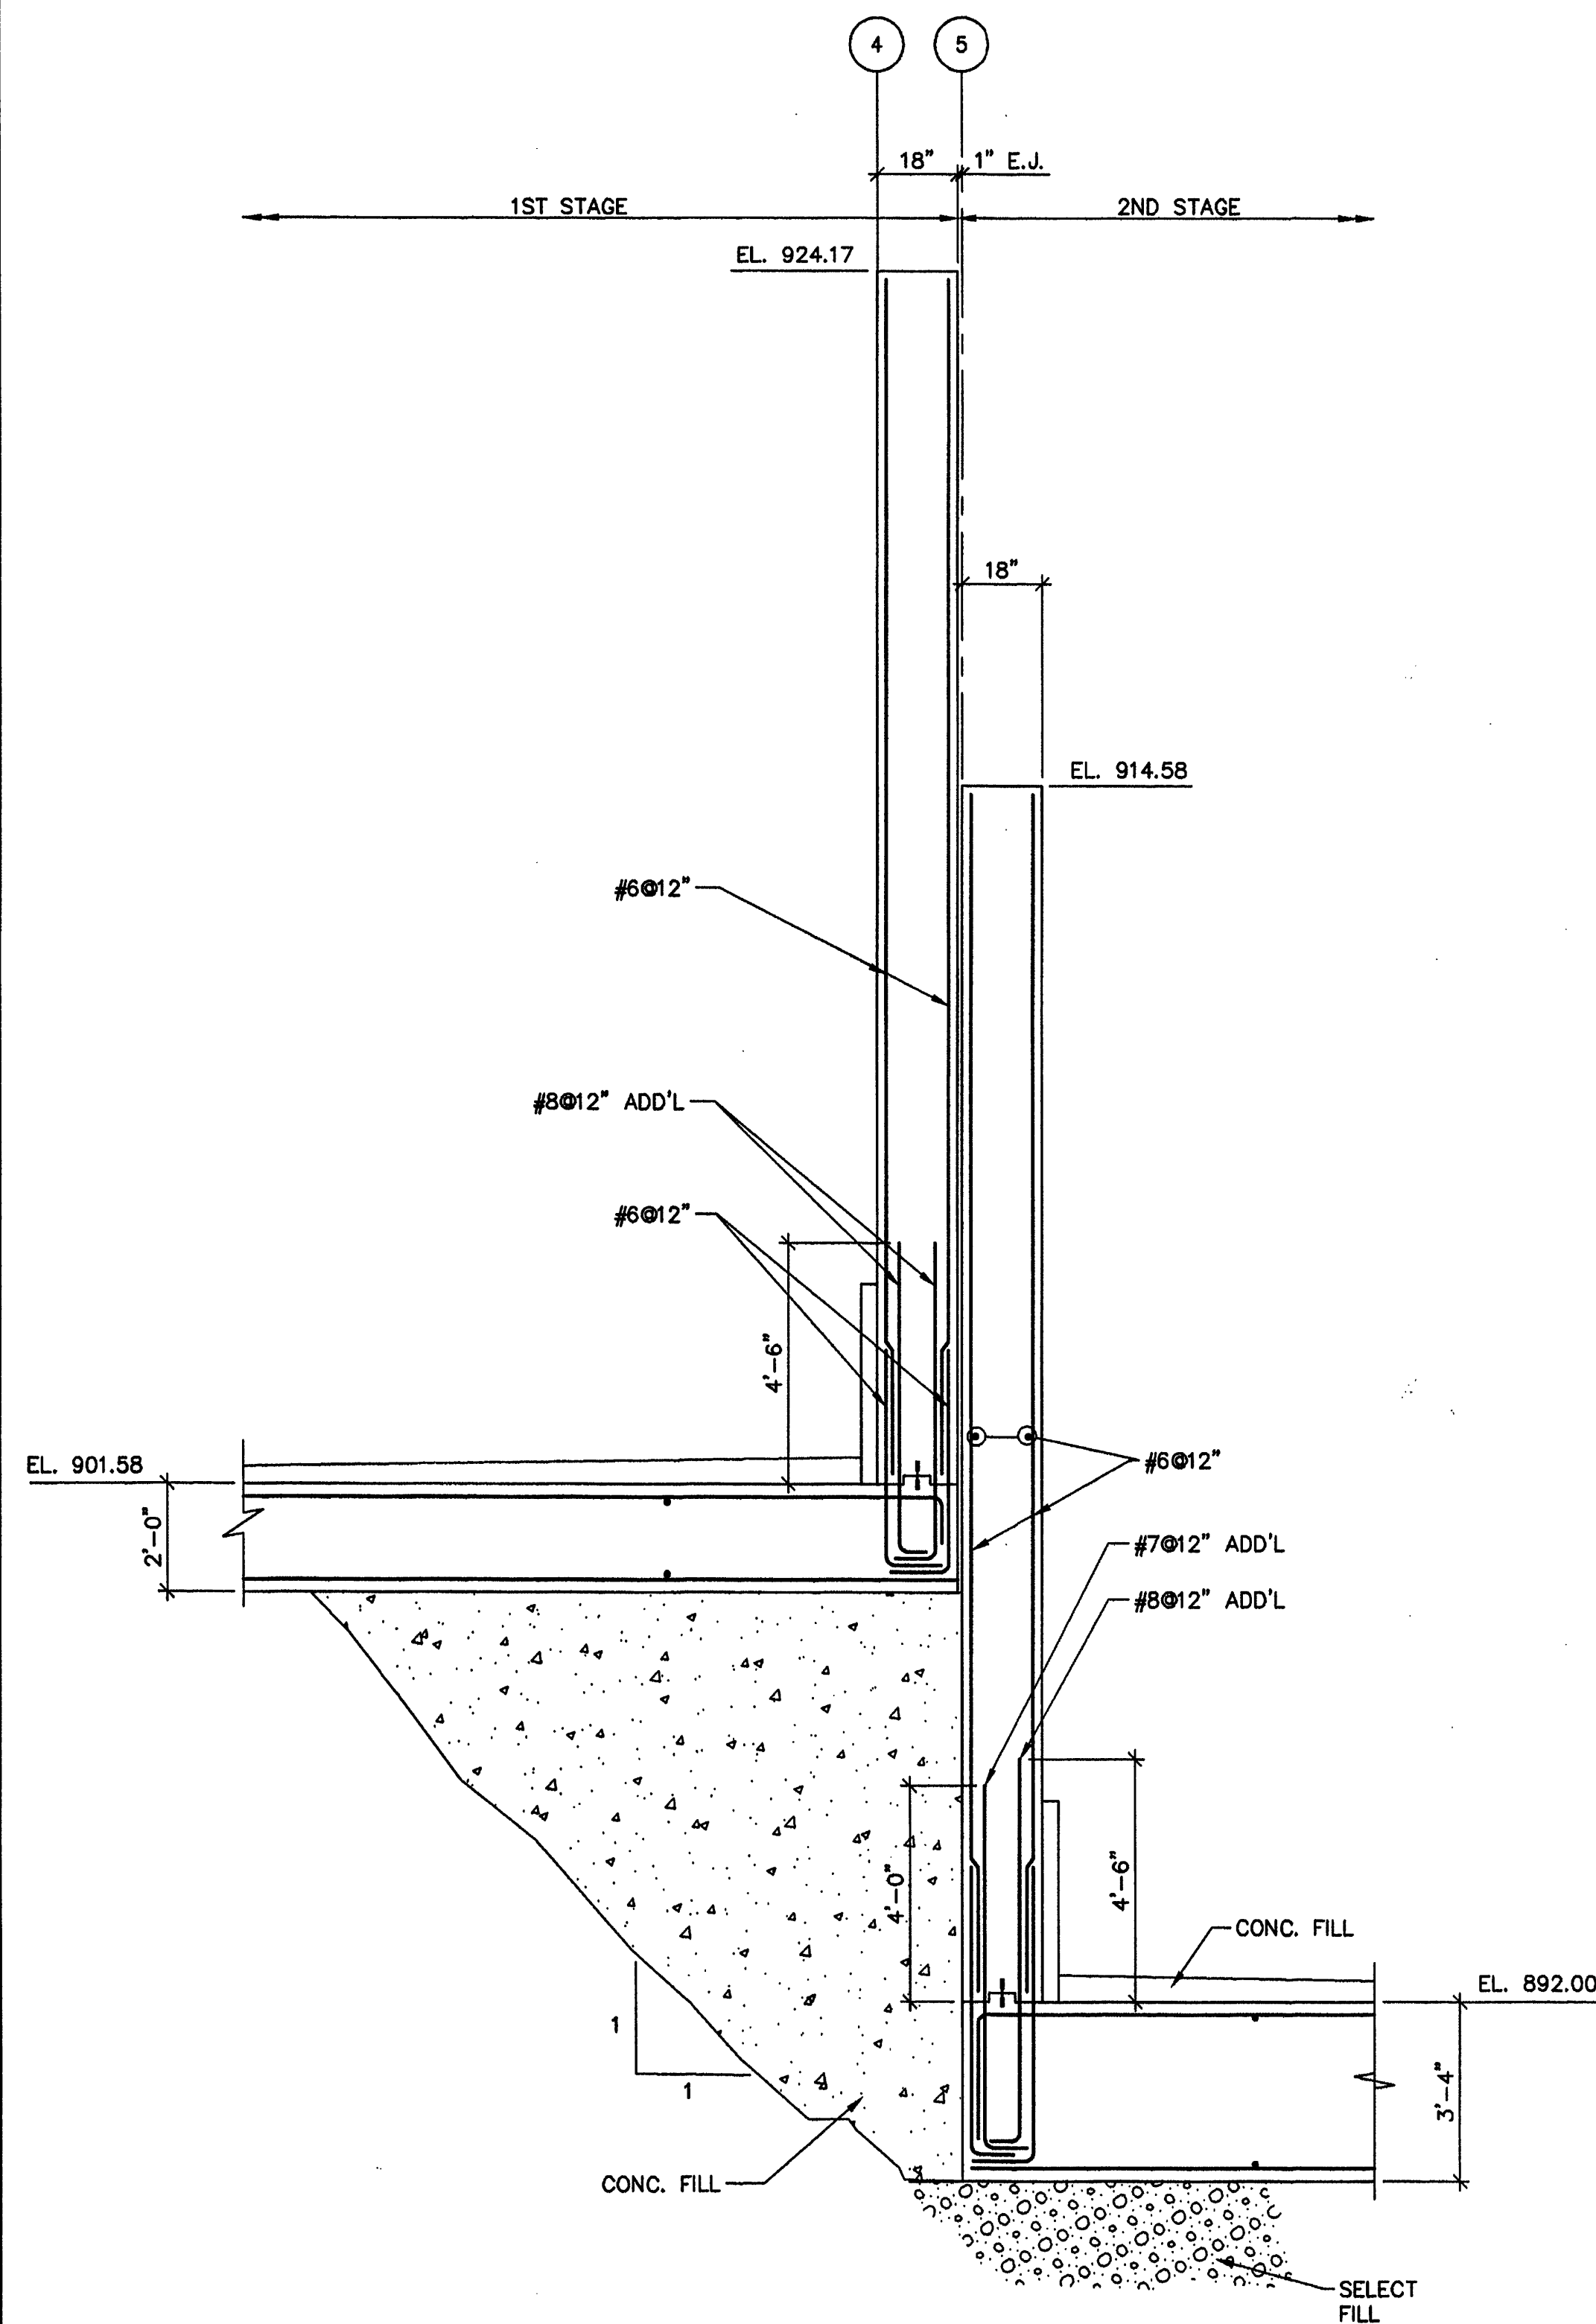


SECTION 1/2

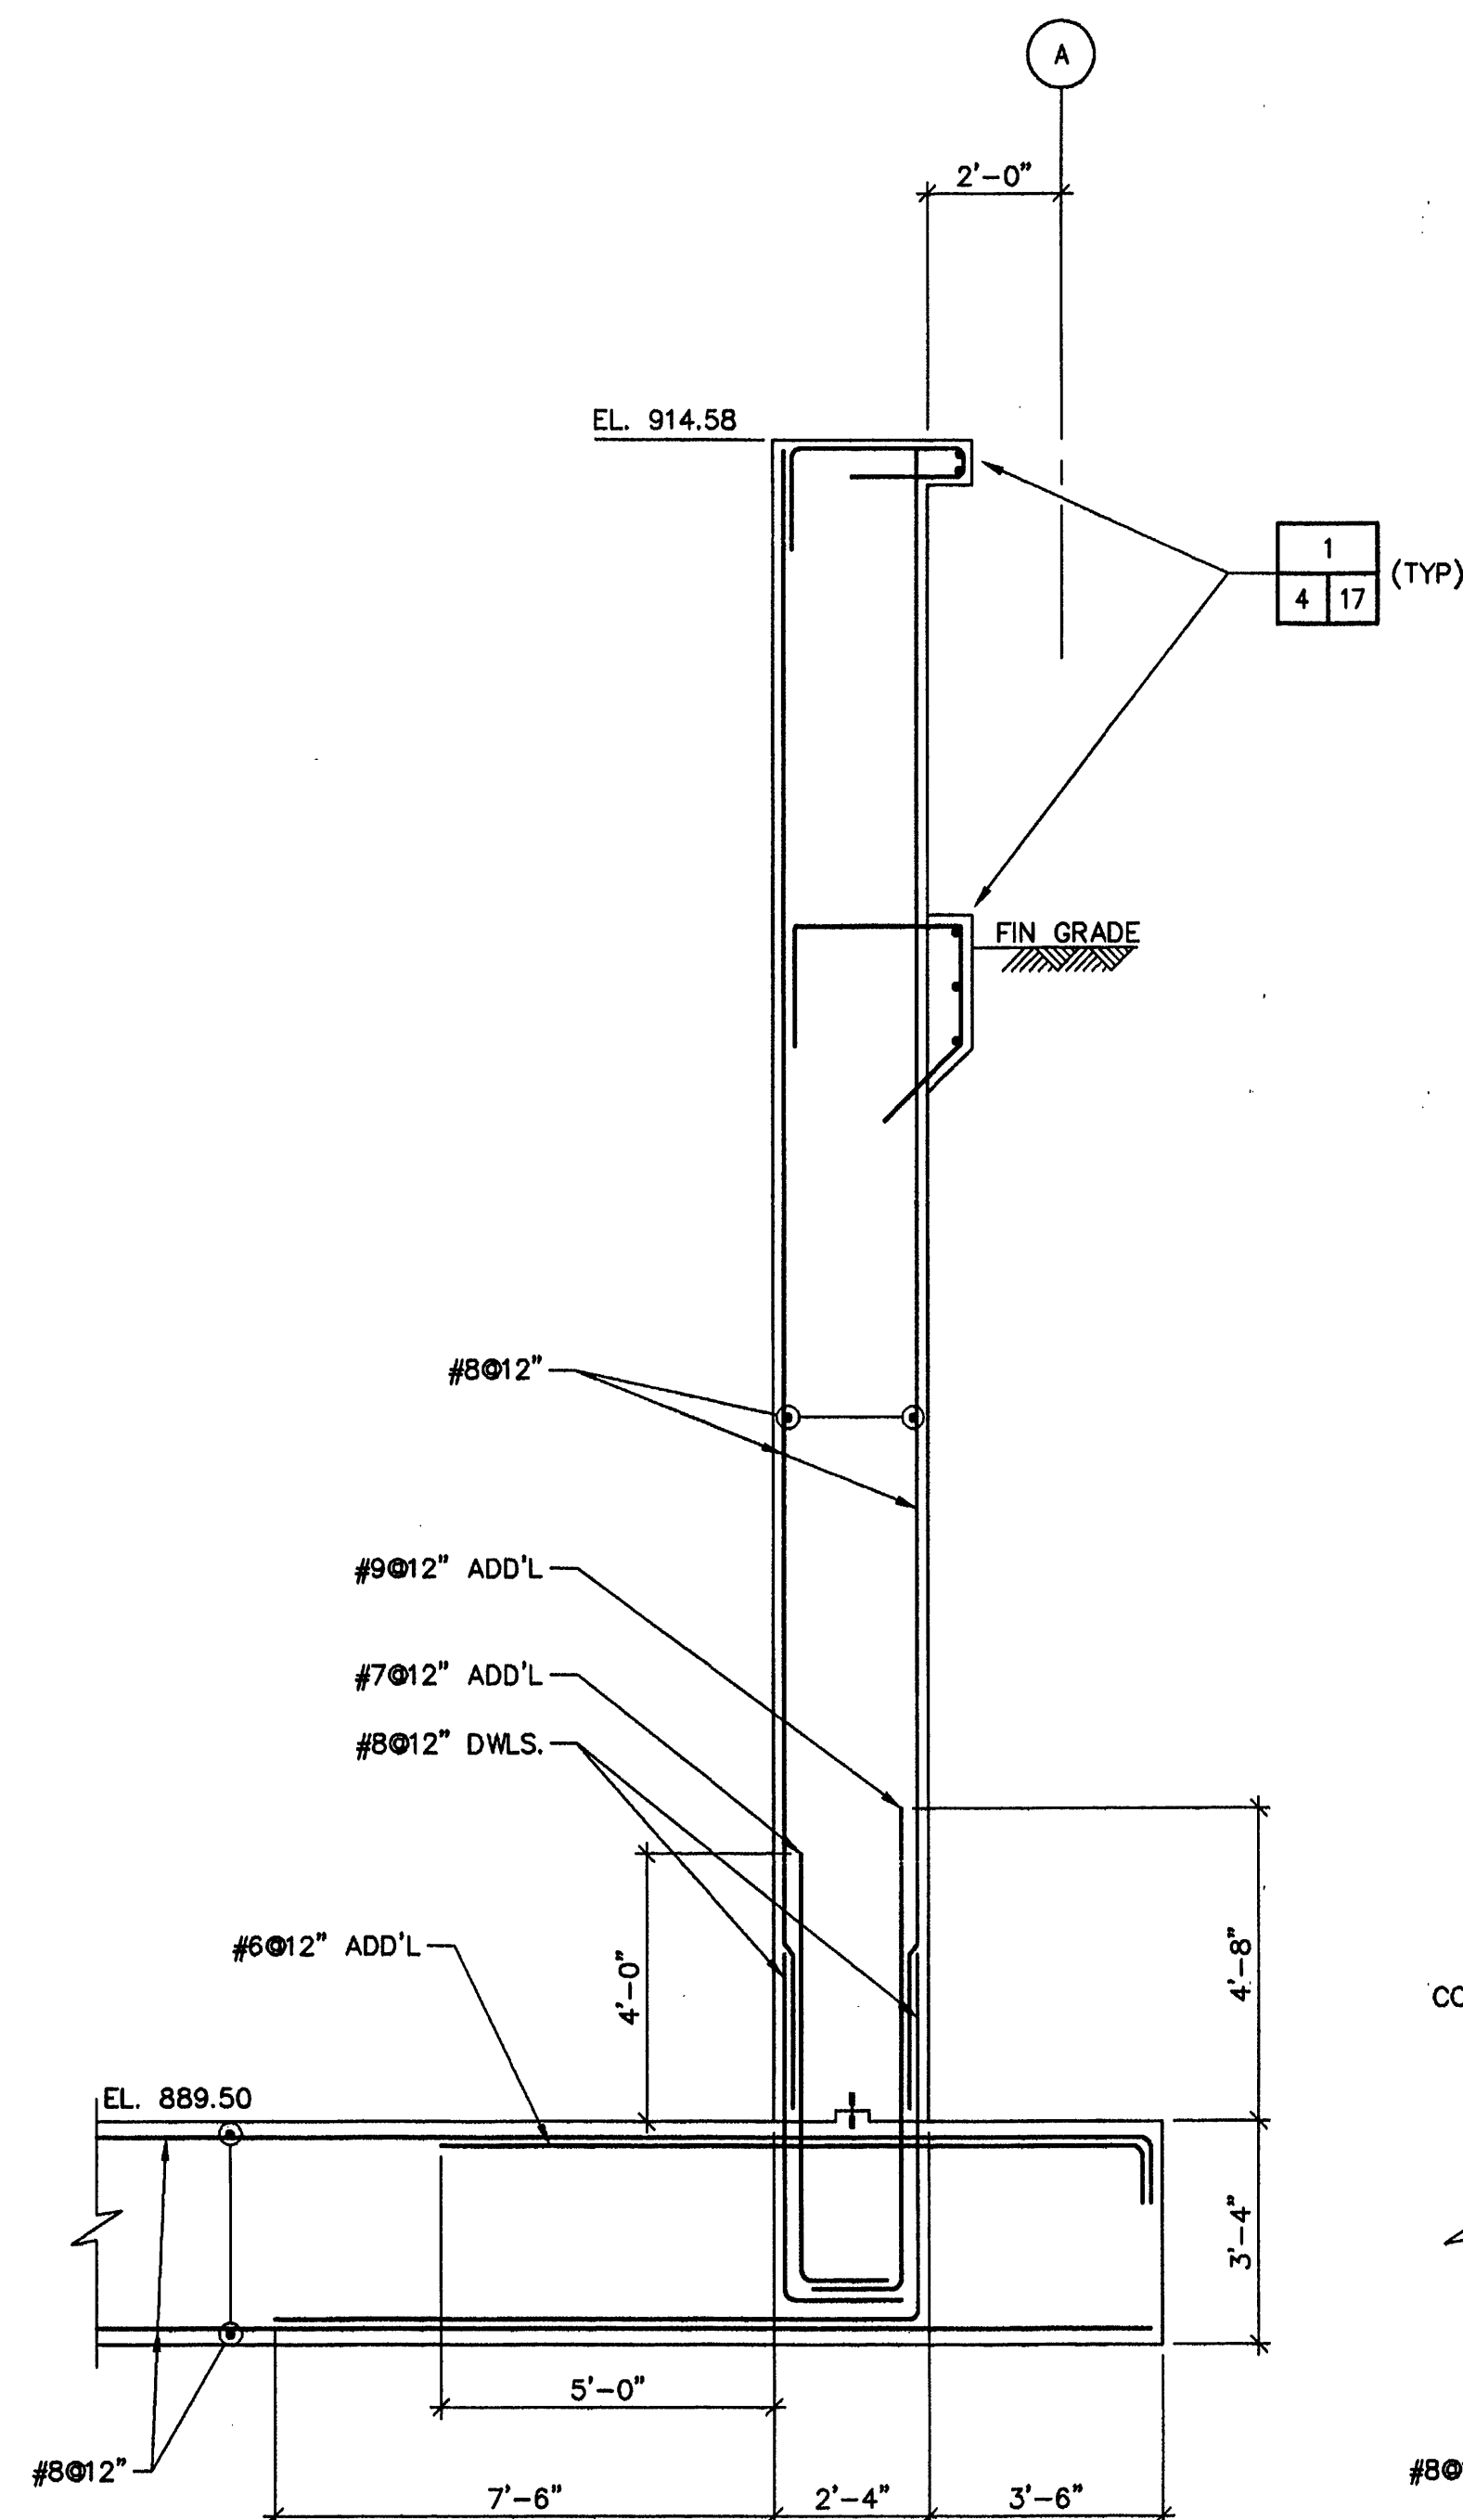

SECTION 1/3

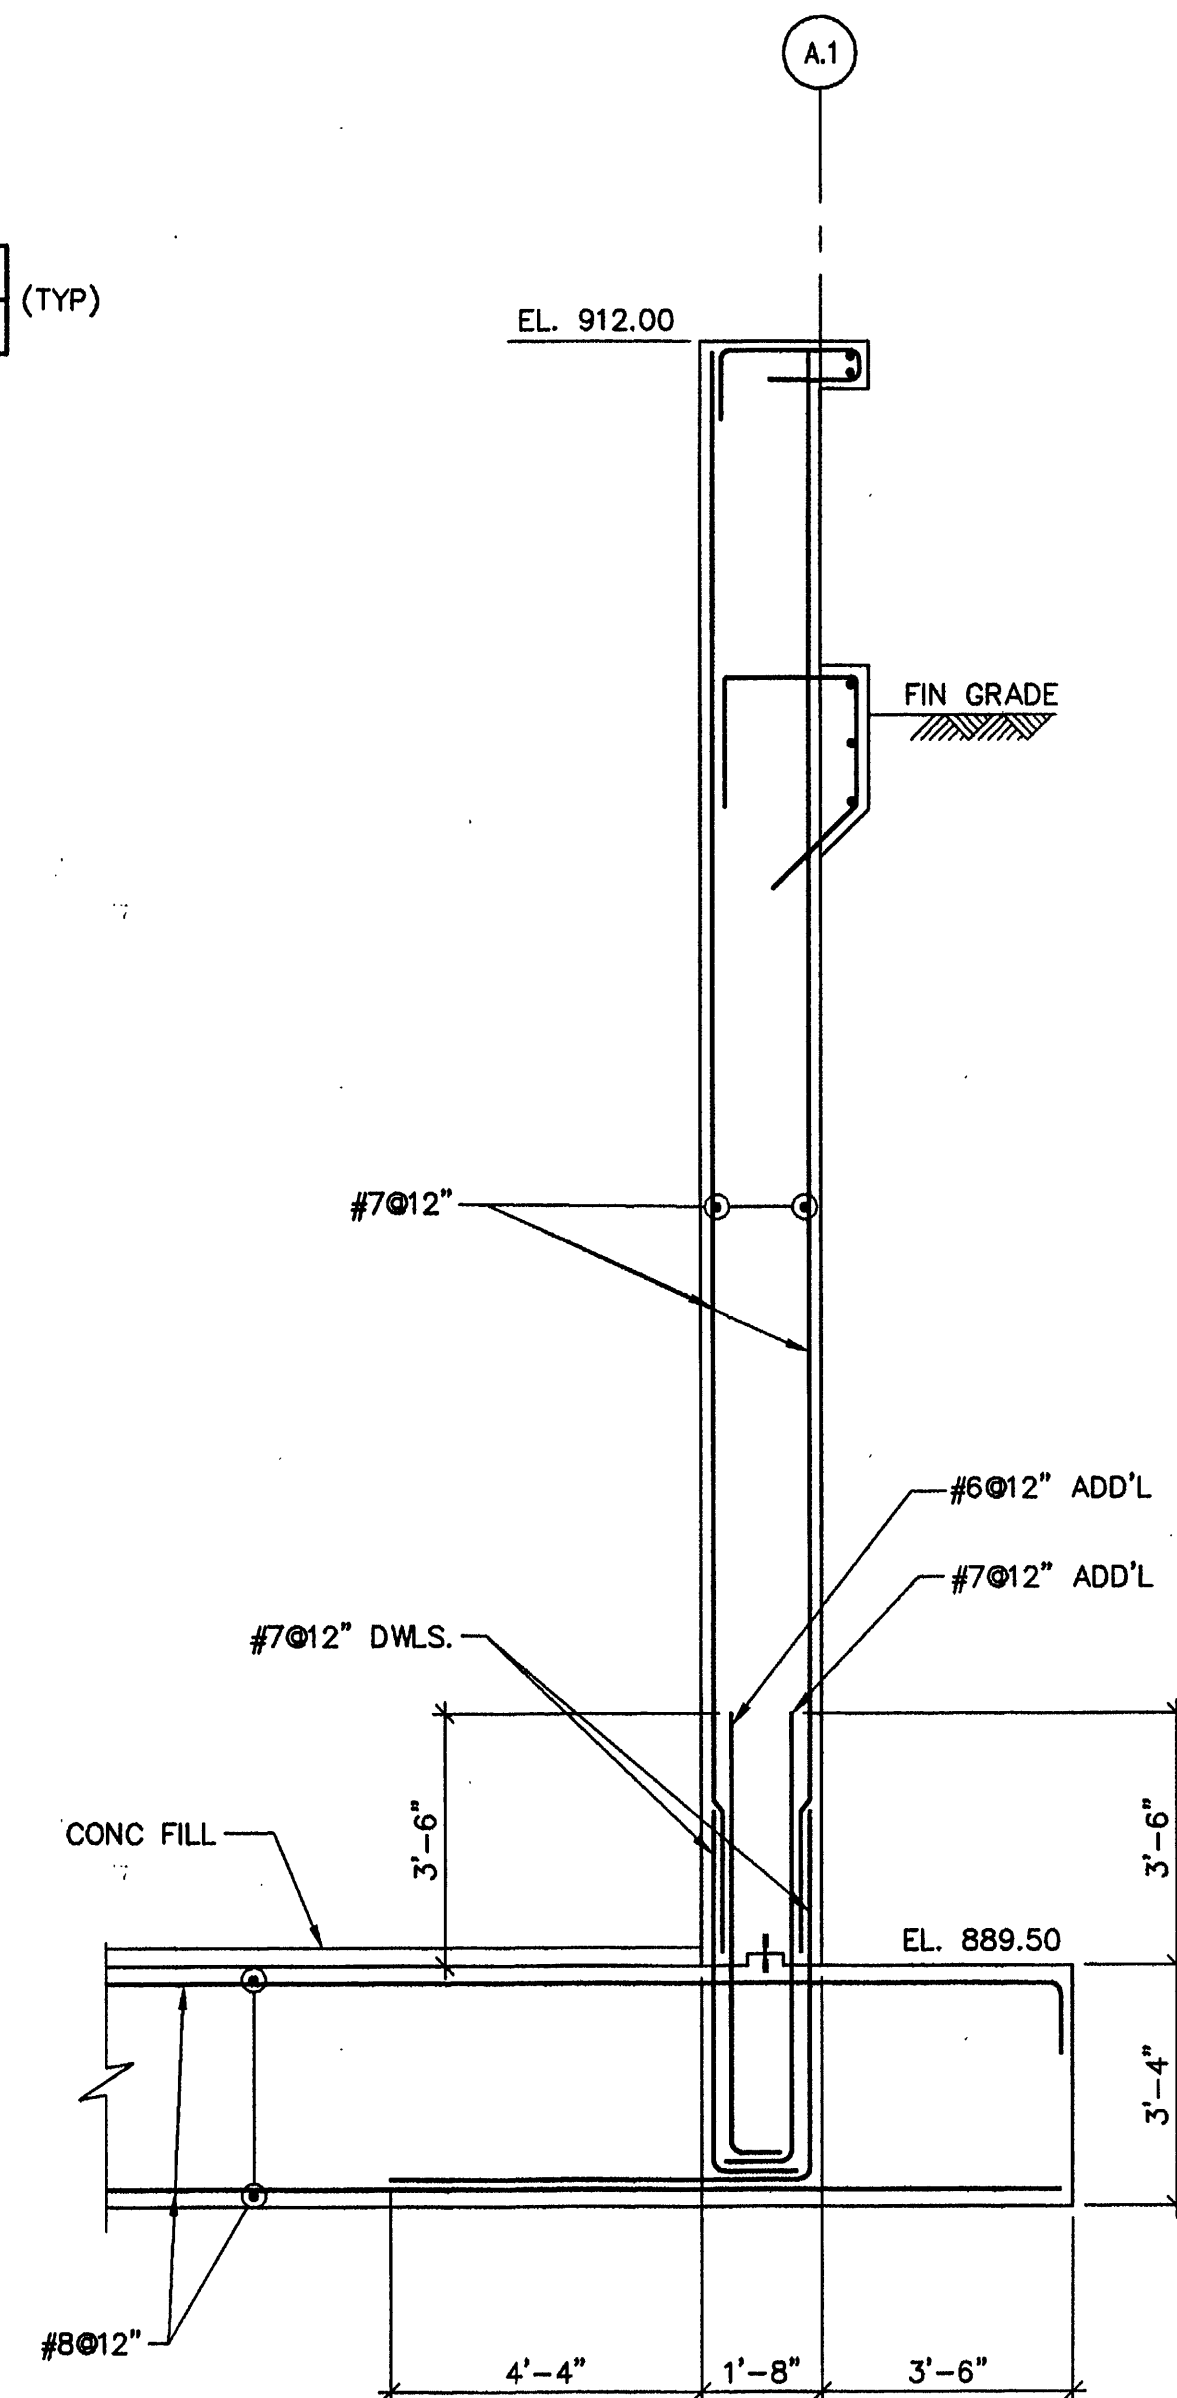

SECTION 2/3

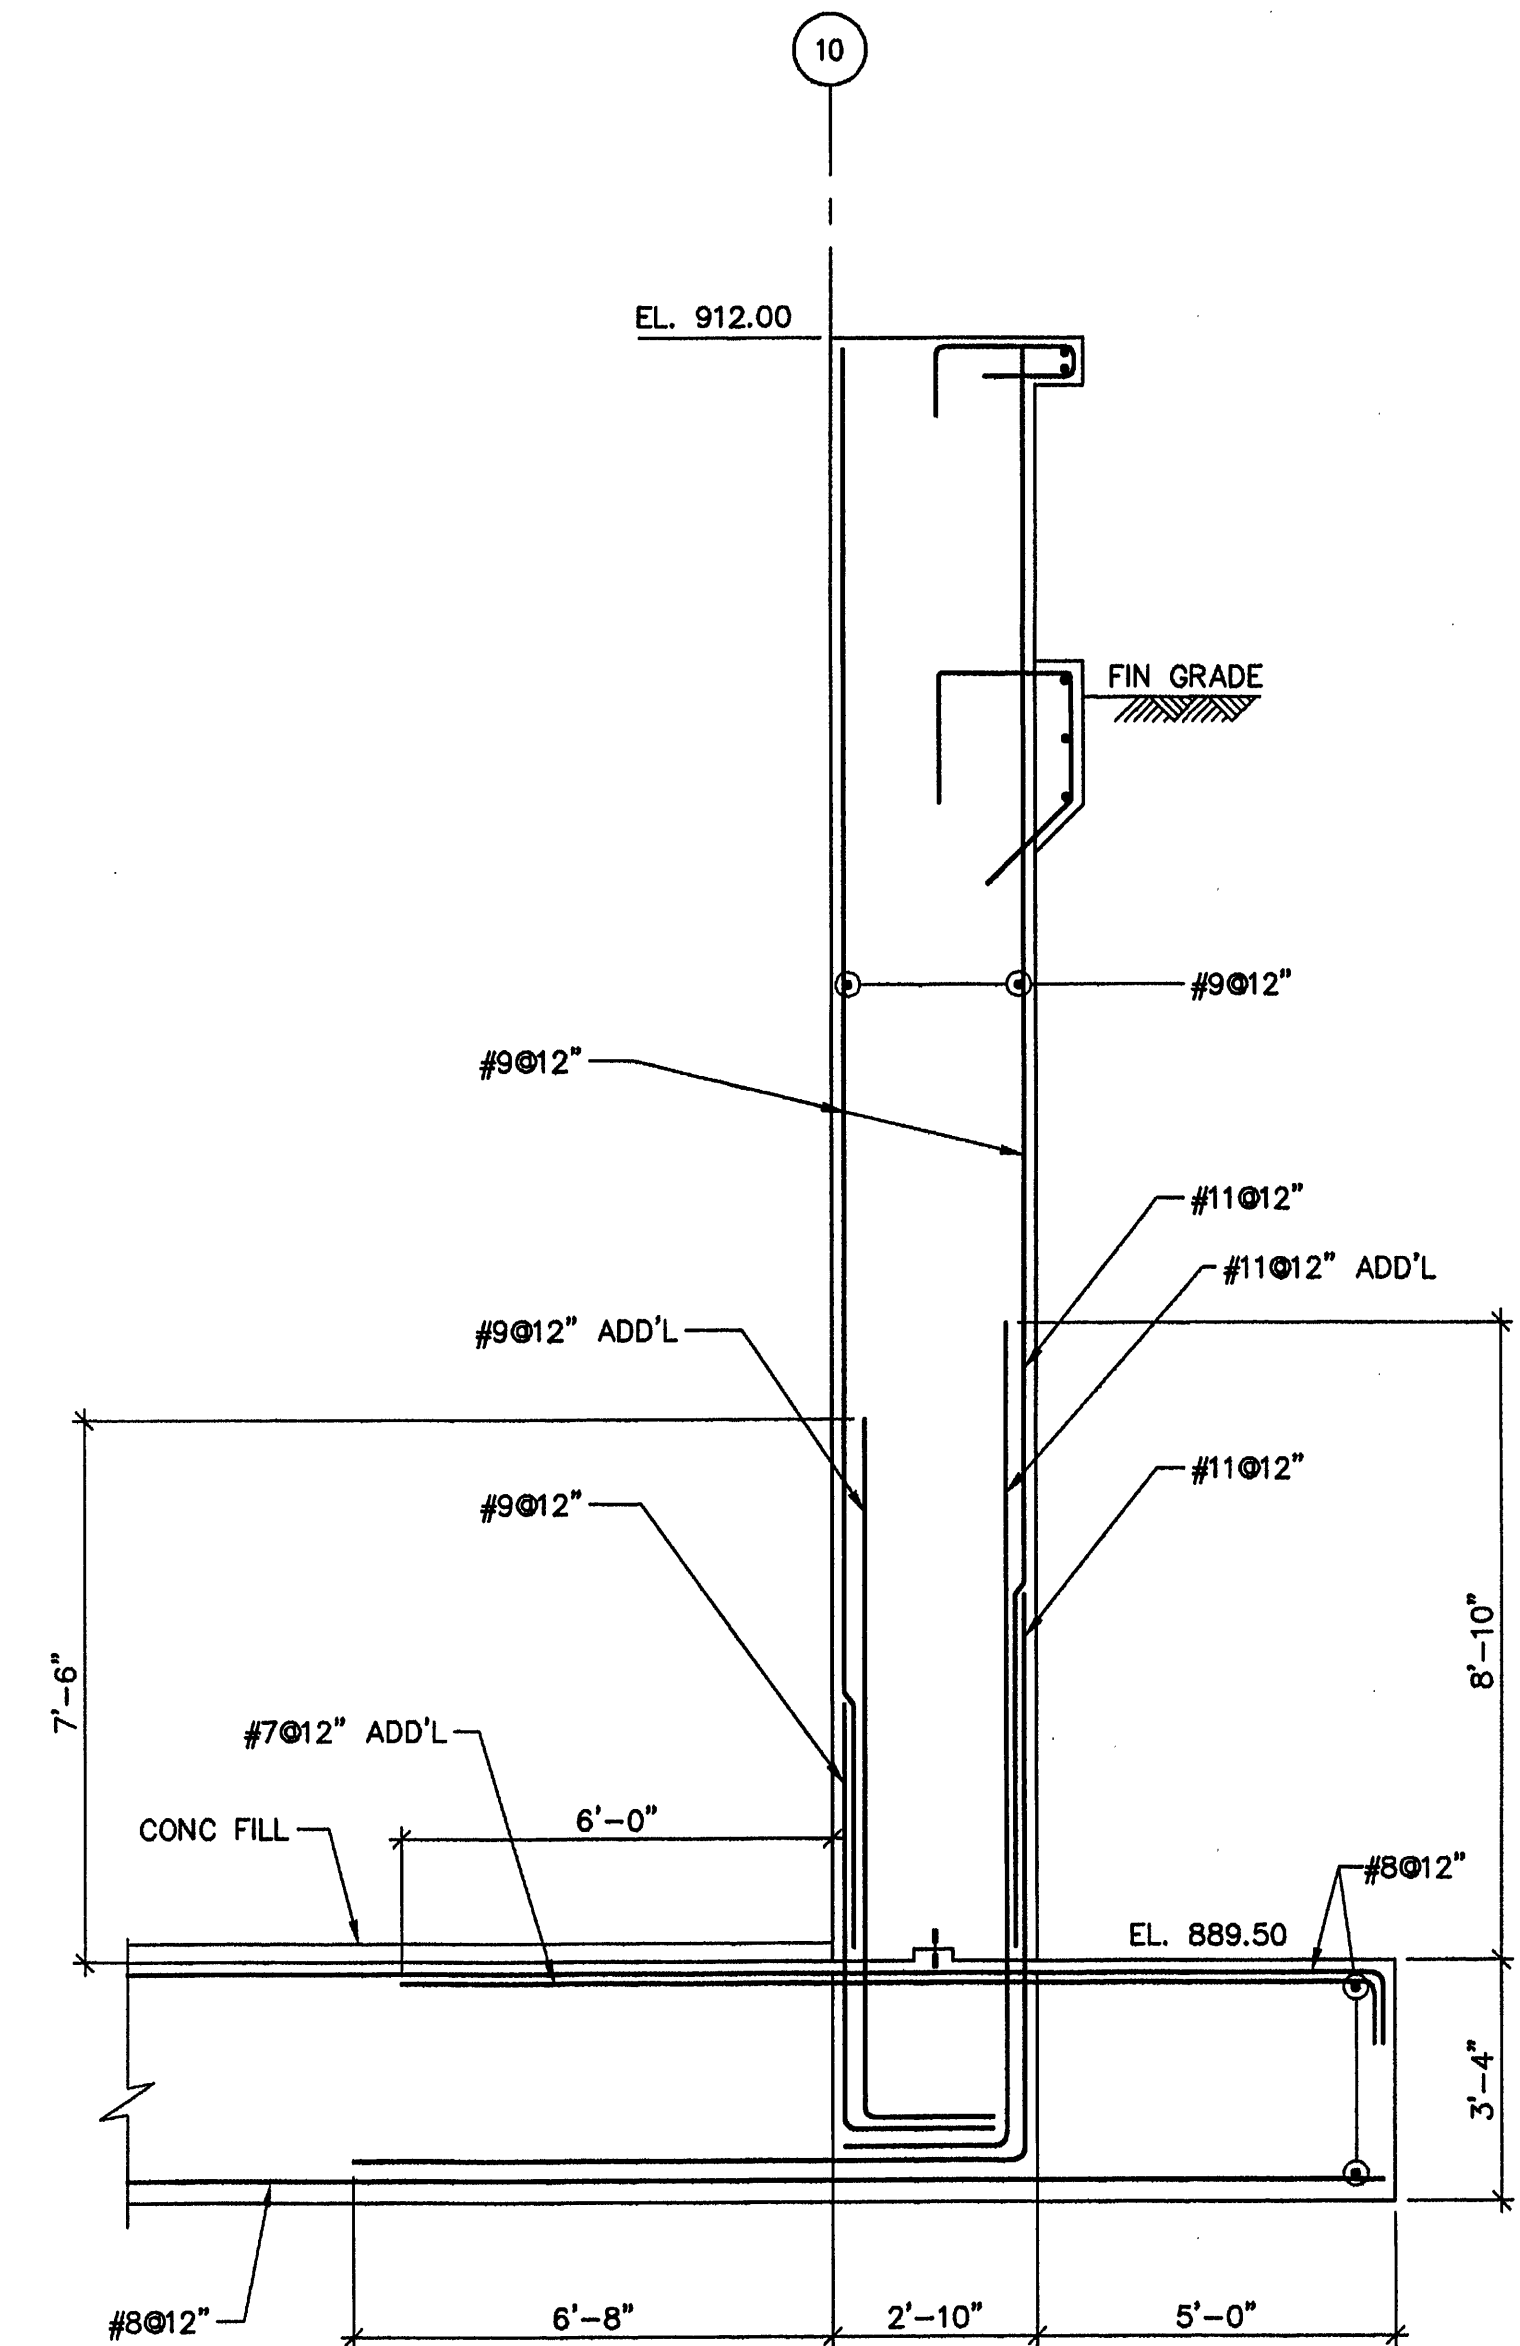

SECTION 3/3

GENERAL NOTE:

NOT ALL BAF EQUIPMENT, PIPING, VALVES AND APPURTENANCES ARE SHOWN. SEE SPECIFICATIONS AND BAF MANUFACTURER'S SHOP DRAWINGS FOR ADDITIONAL ITEMS AND SCOPE OF EQUIPMENT, PIPING, VALVES AND APPURTENANCES SUPPLIED TO THE CONTRACTOR BY THE BAF MANUFACTURER.

**MALCOLM
PIRNIE**

11832 Rook Landing Drive, Suite 400
Newport News, Virginia 23606

REVISIONS				DES	DWN	CKD
NO.	BY	DATE	REMARKS			
1	ARB	JAN. 2000	RECORD DRAWING	MZ	DRK	DB



CITY OF ROANOKE, VIRGINIA
WATER POLLUTION
CONTROL PLANT
UPGRADE AND EXPANSION

BIOLOGICAL AERATED FILTER
SECTIONS

3/8"=1'-0"

COPYRIGHT © 1997
MALCOLM PIRNIE, INC.

DATE MAY 1997

SHEET 11 OF 44

CAD REF. NO. 00605362