




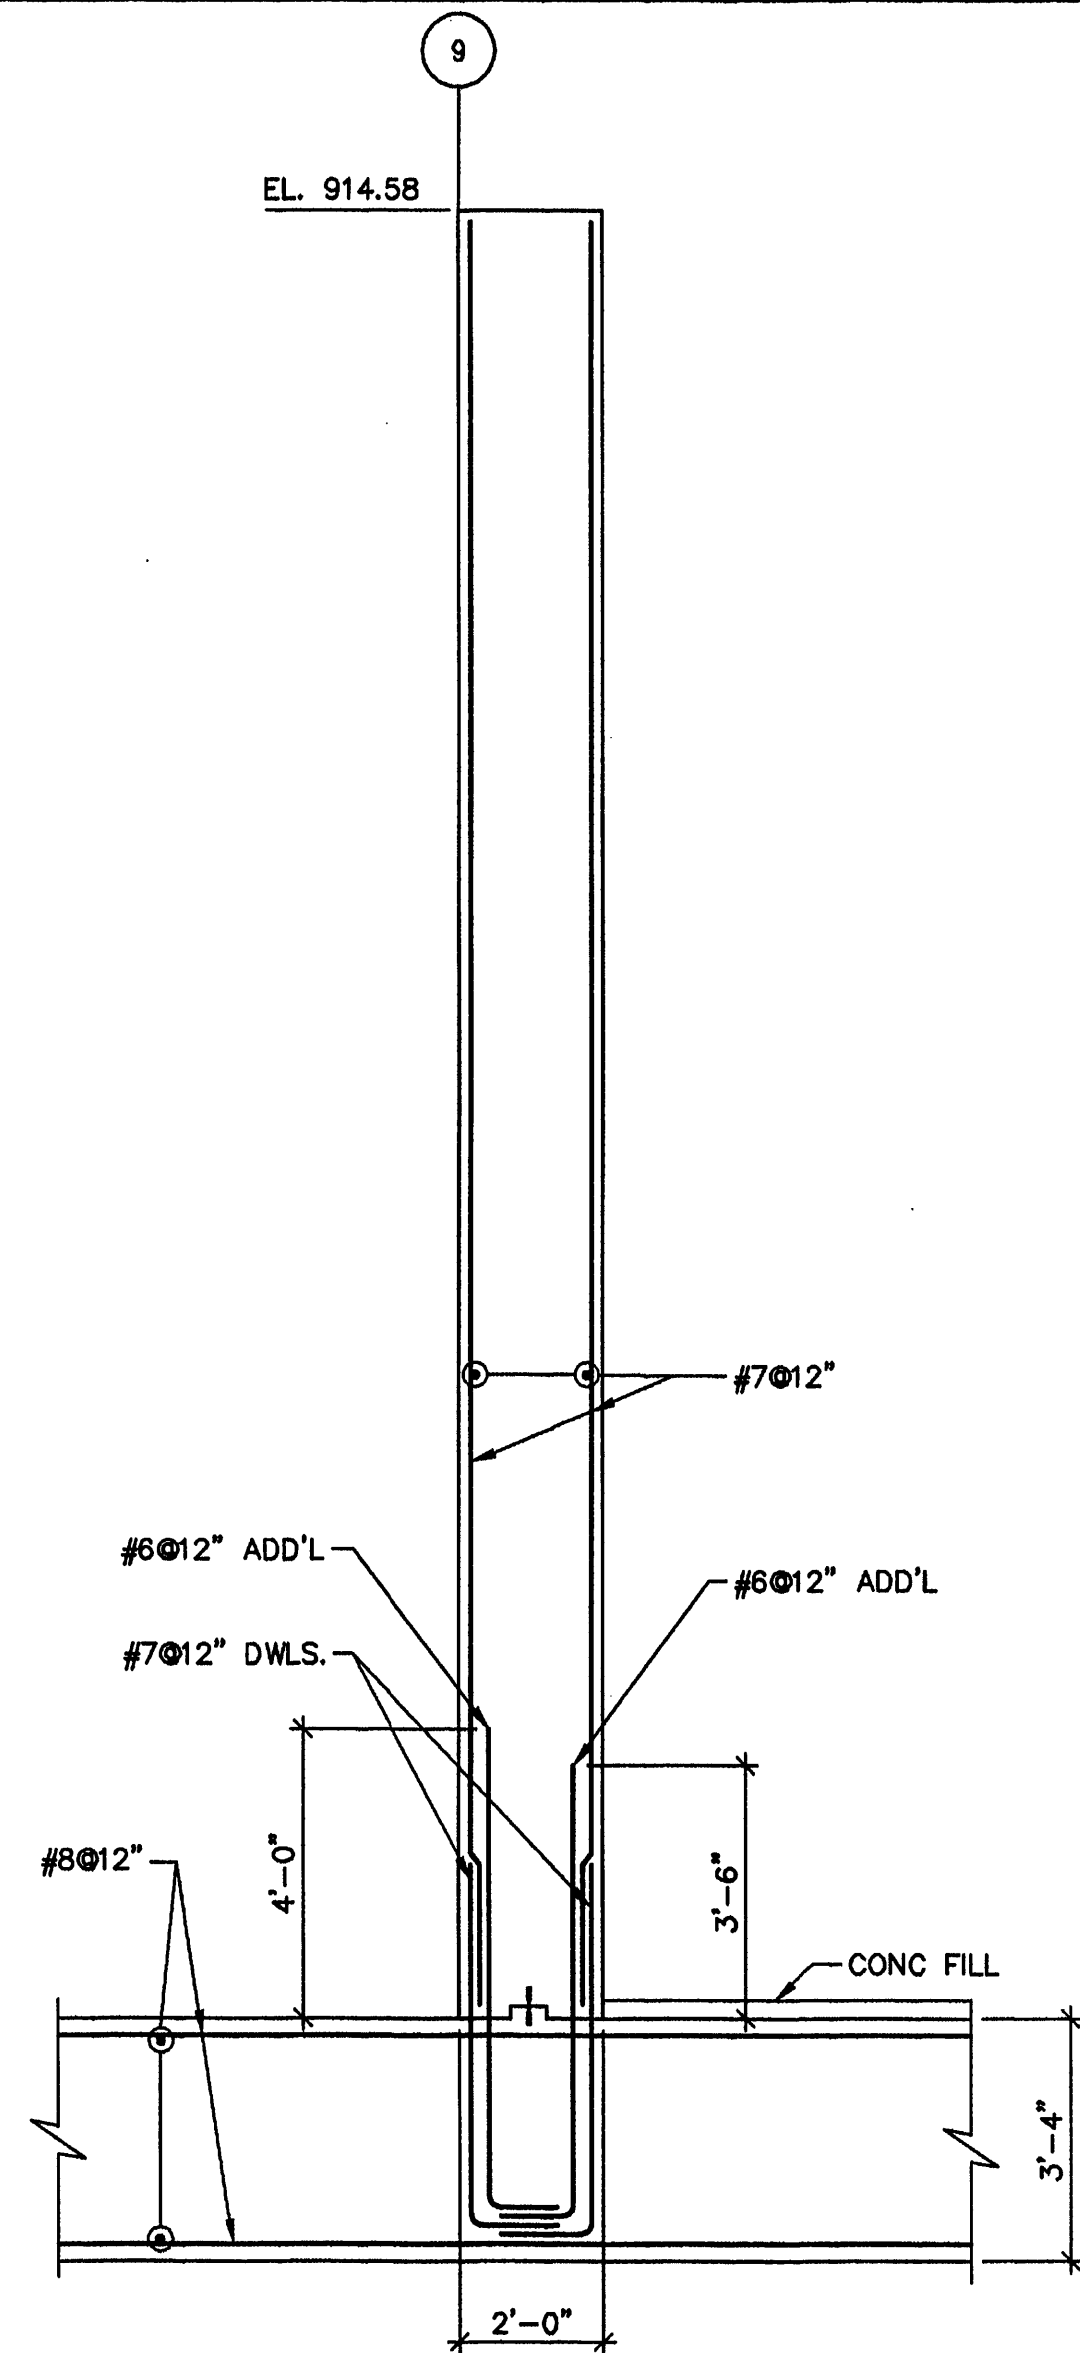


SECTION 1
3/12

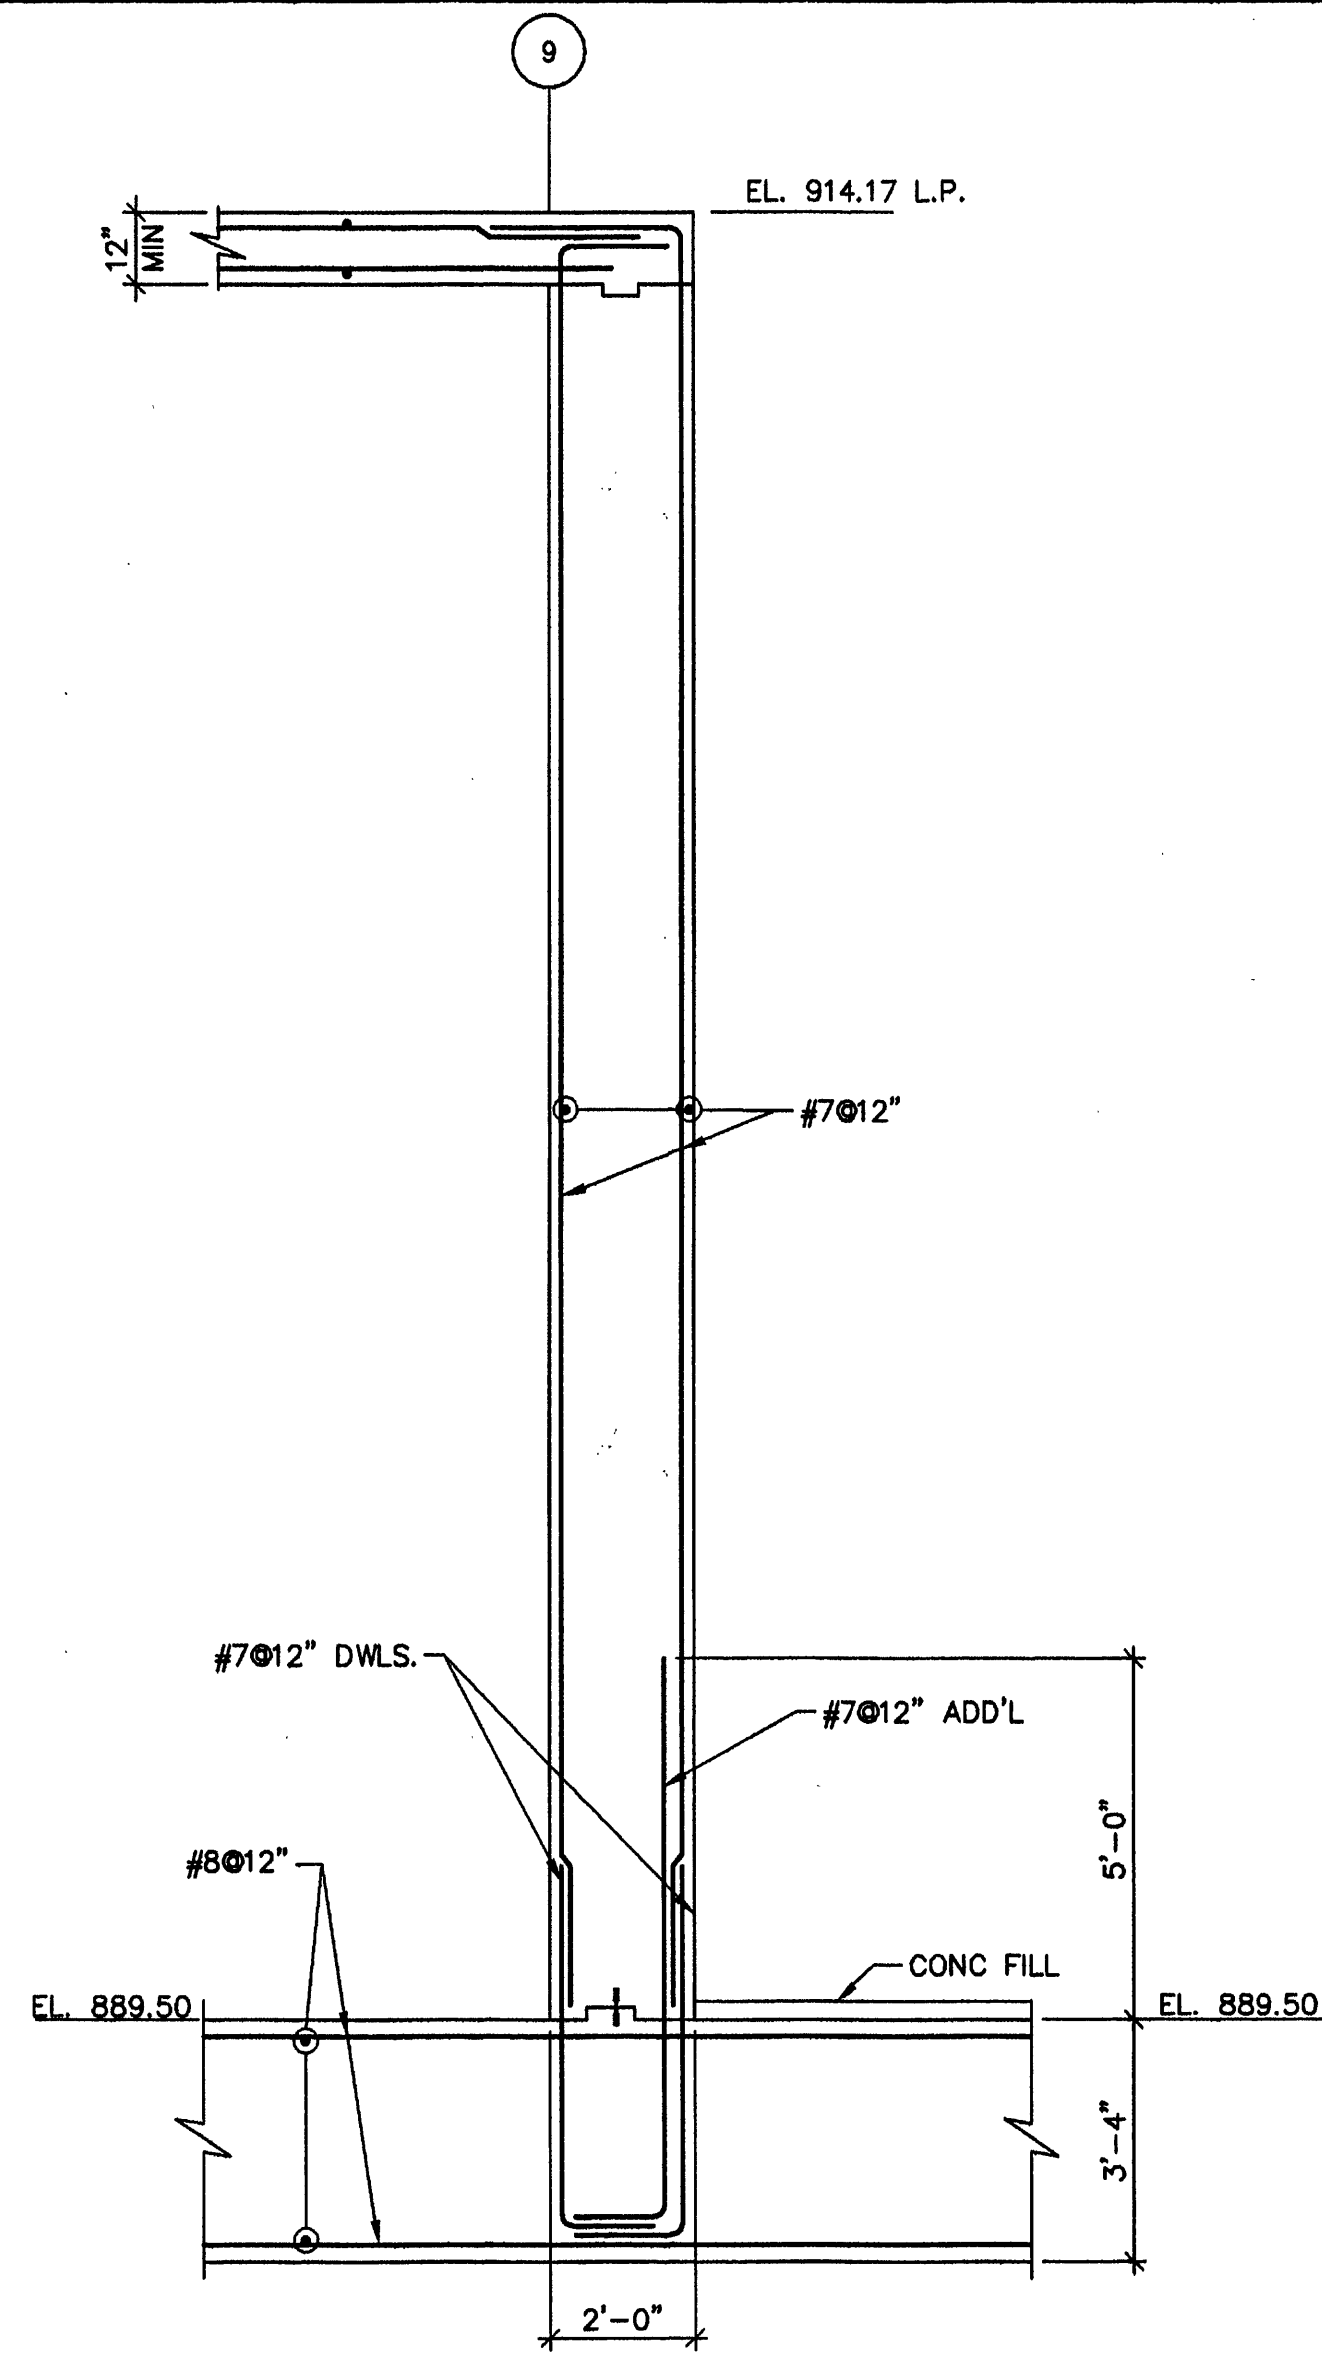


SECTION 2
3/12

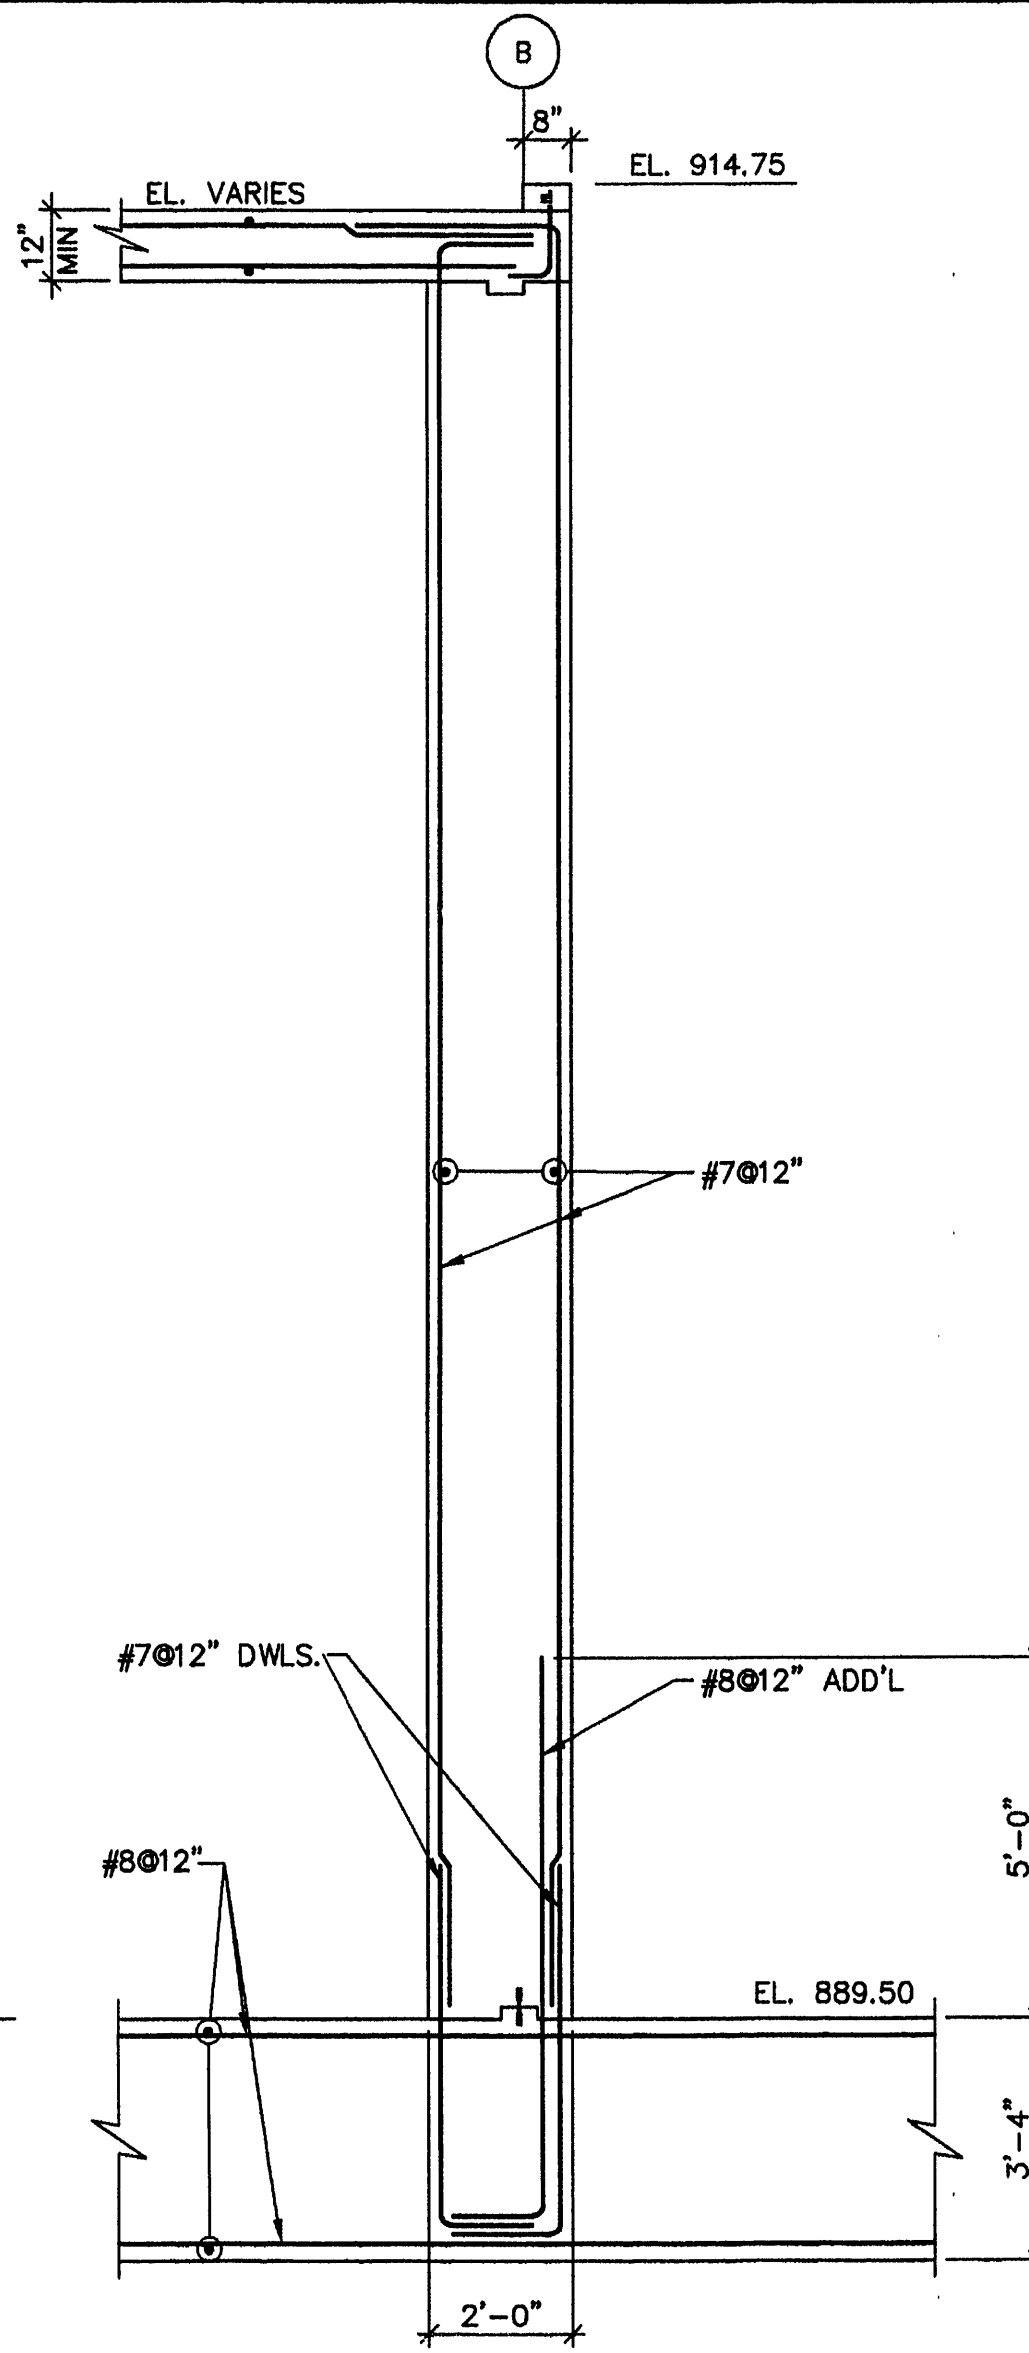

SECTION 3
3/12

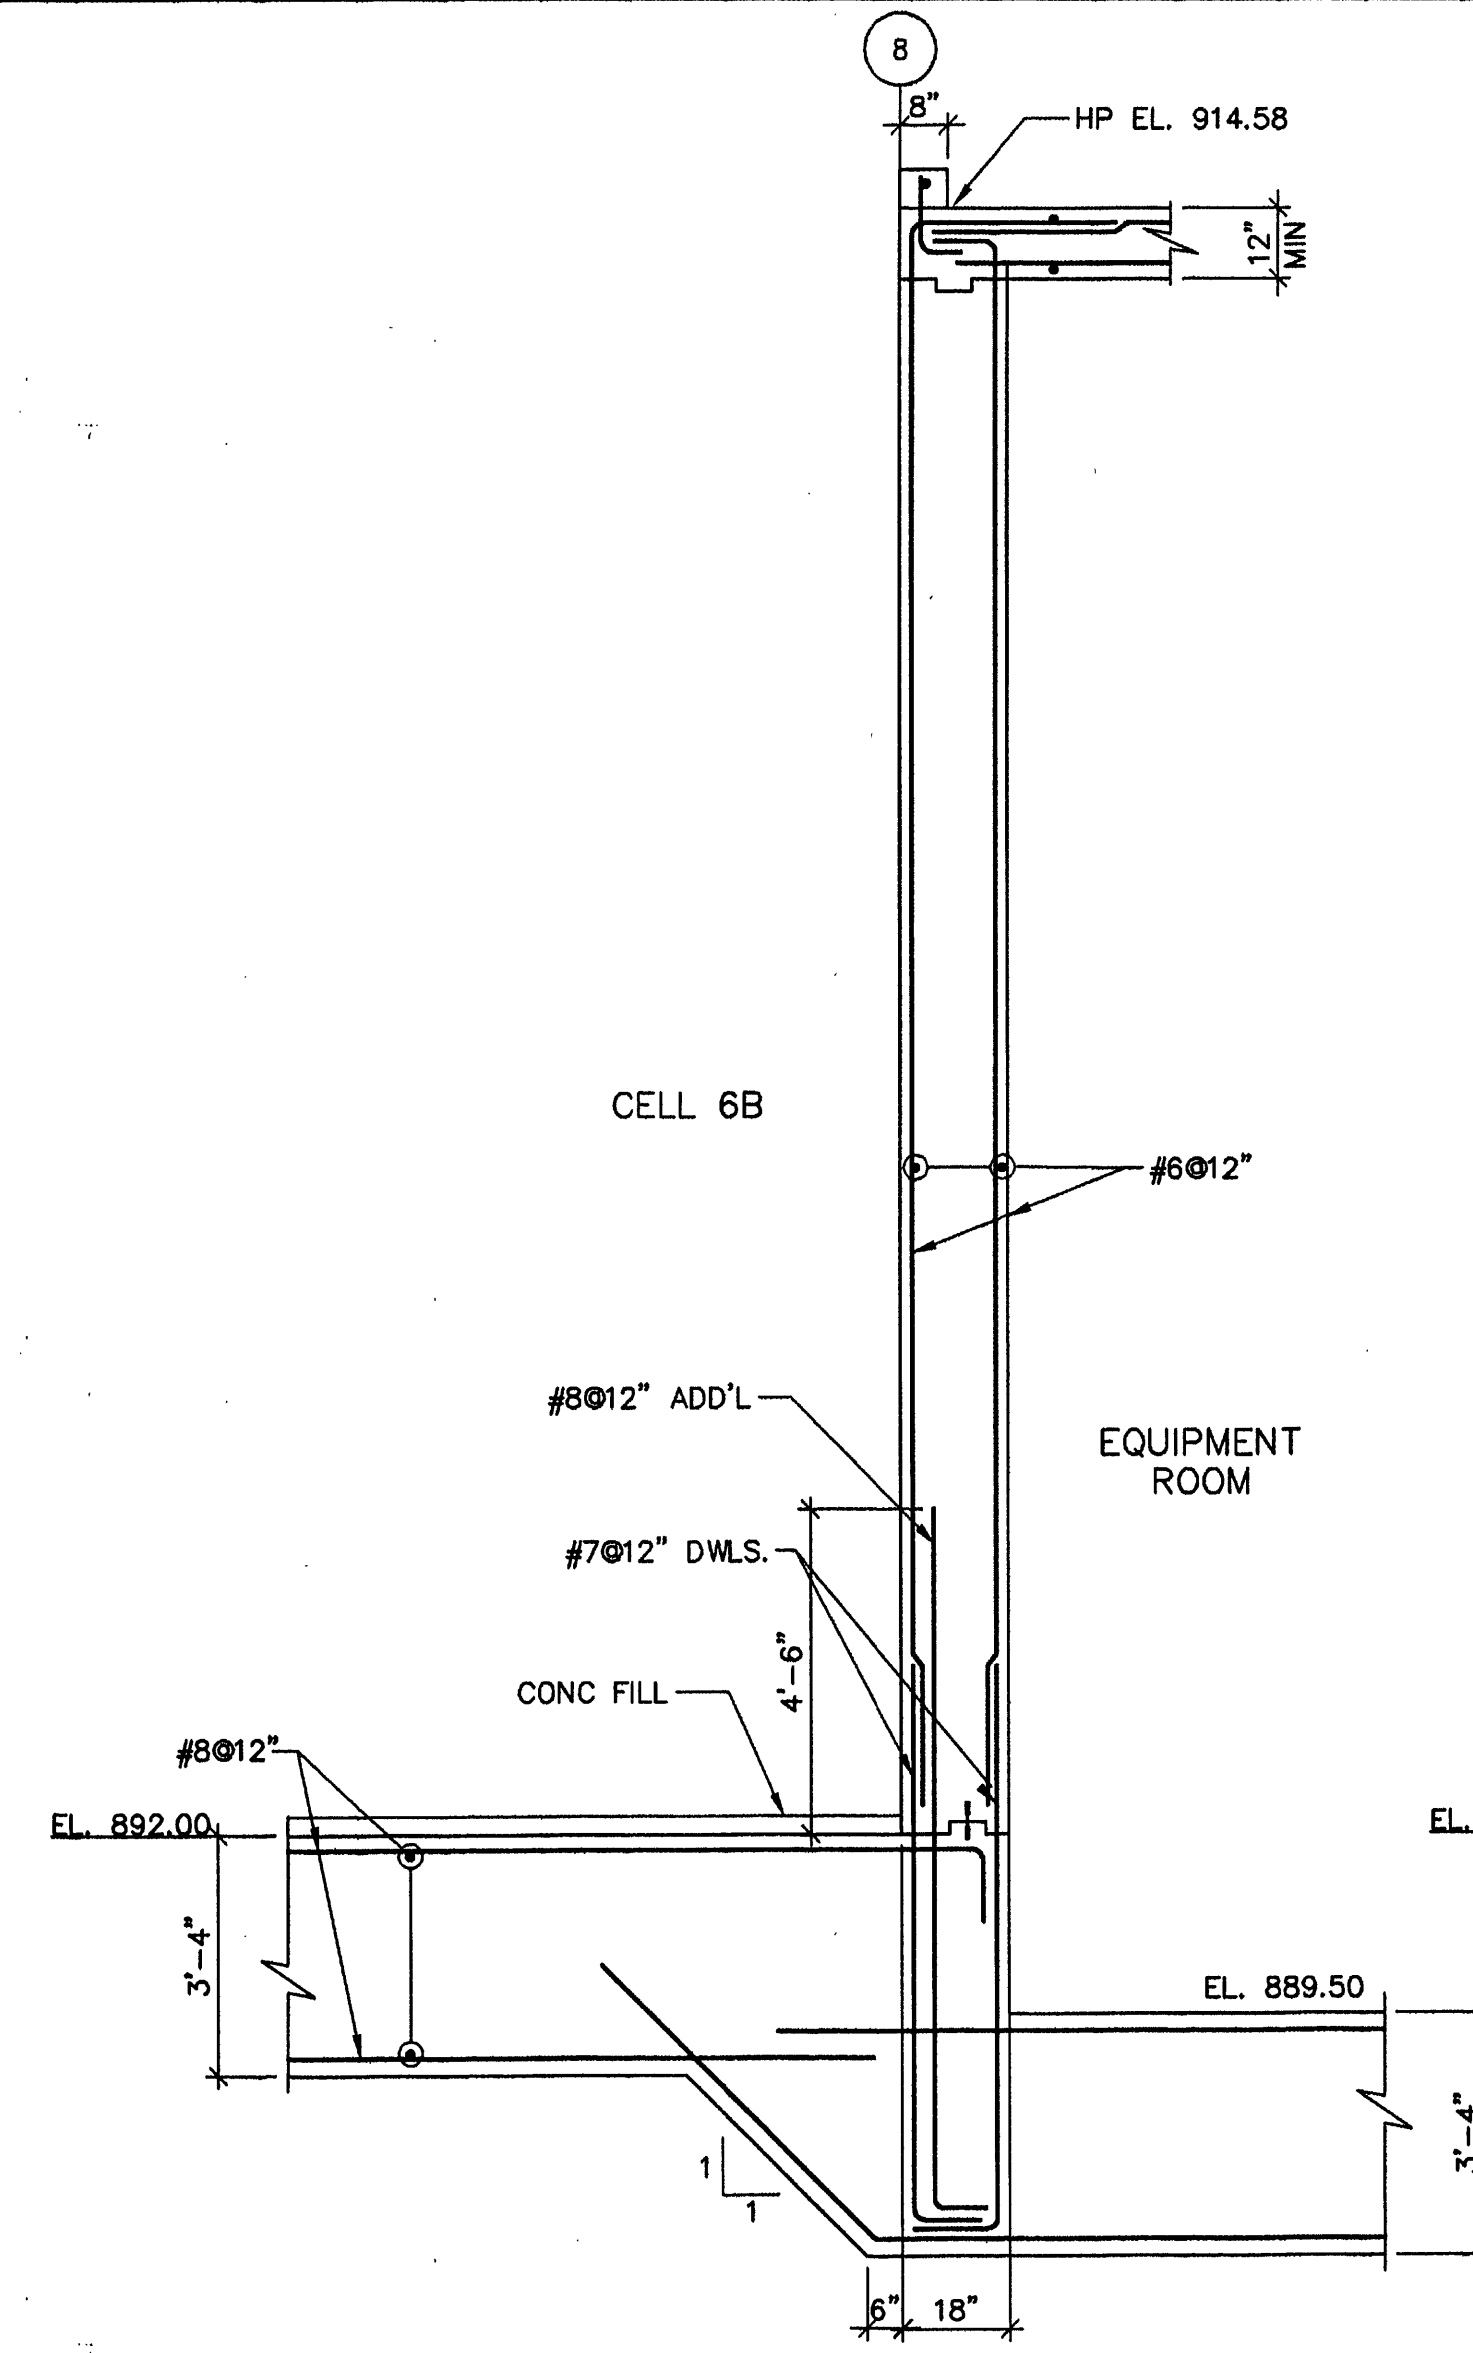


SECTION 4
3/12

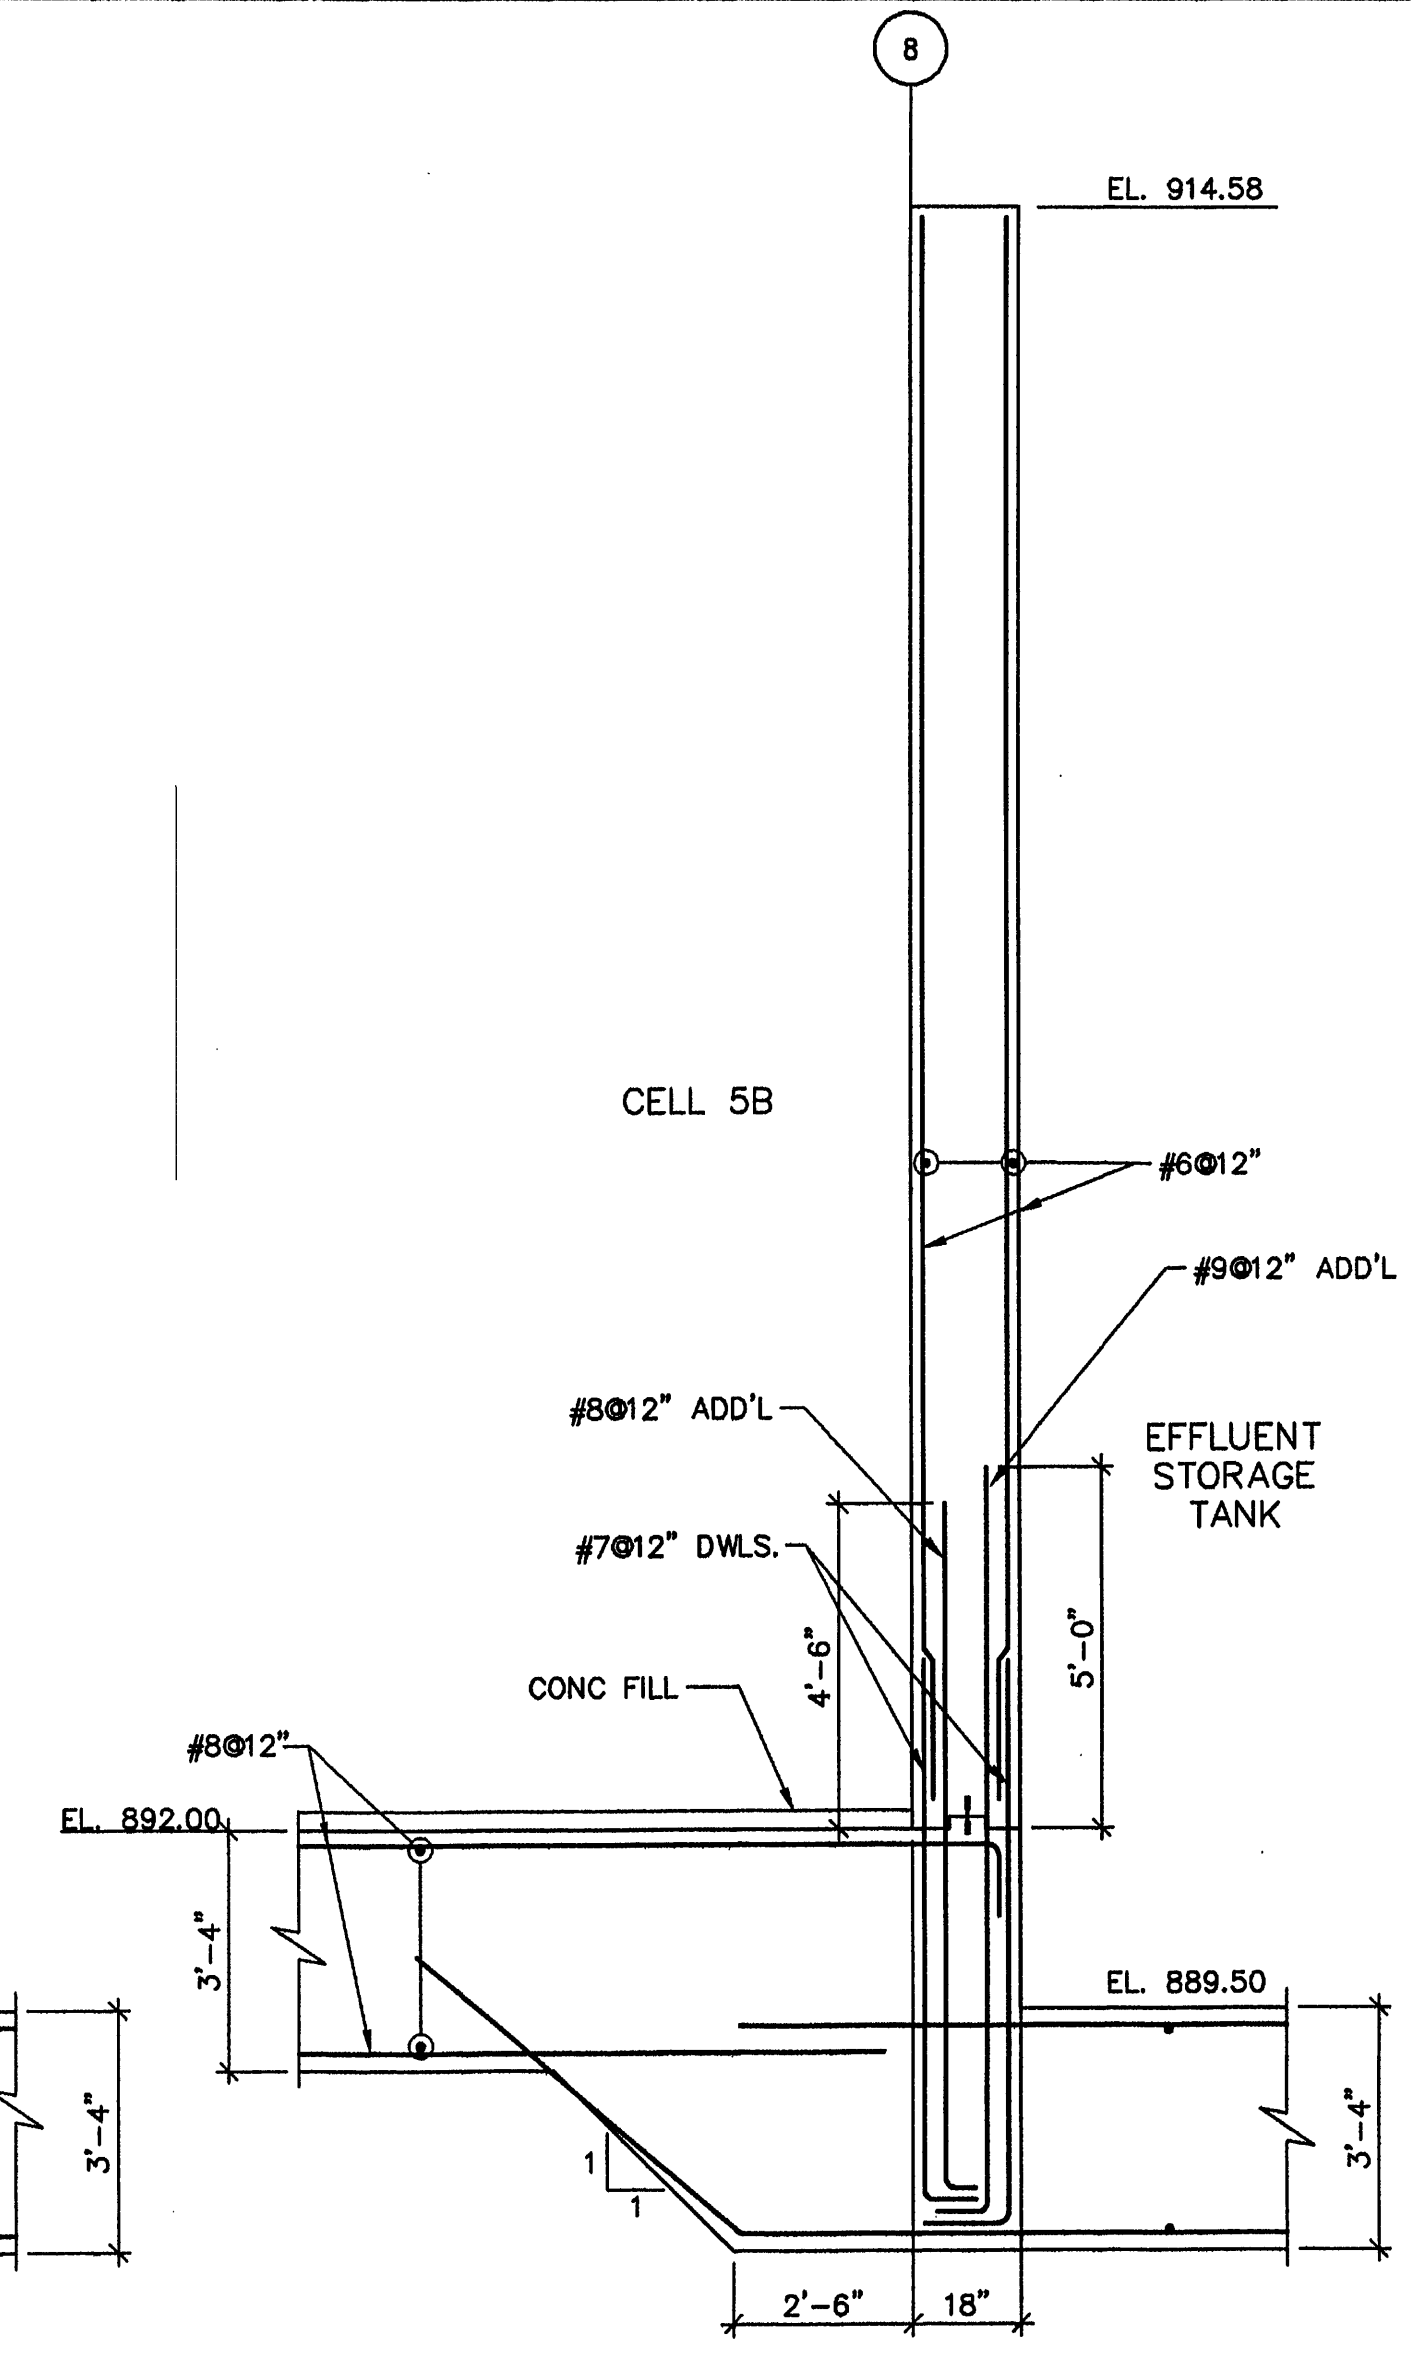

SECTION 5
3/12

SEE REVISED SECTION
PER RFI 1
10/20/97

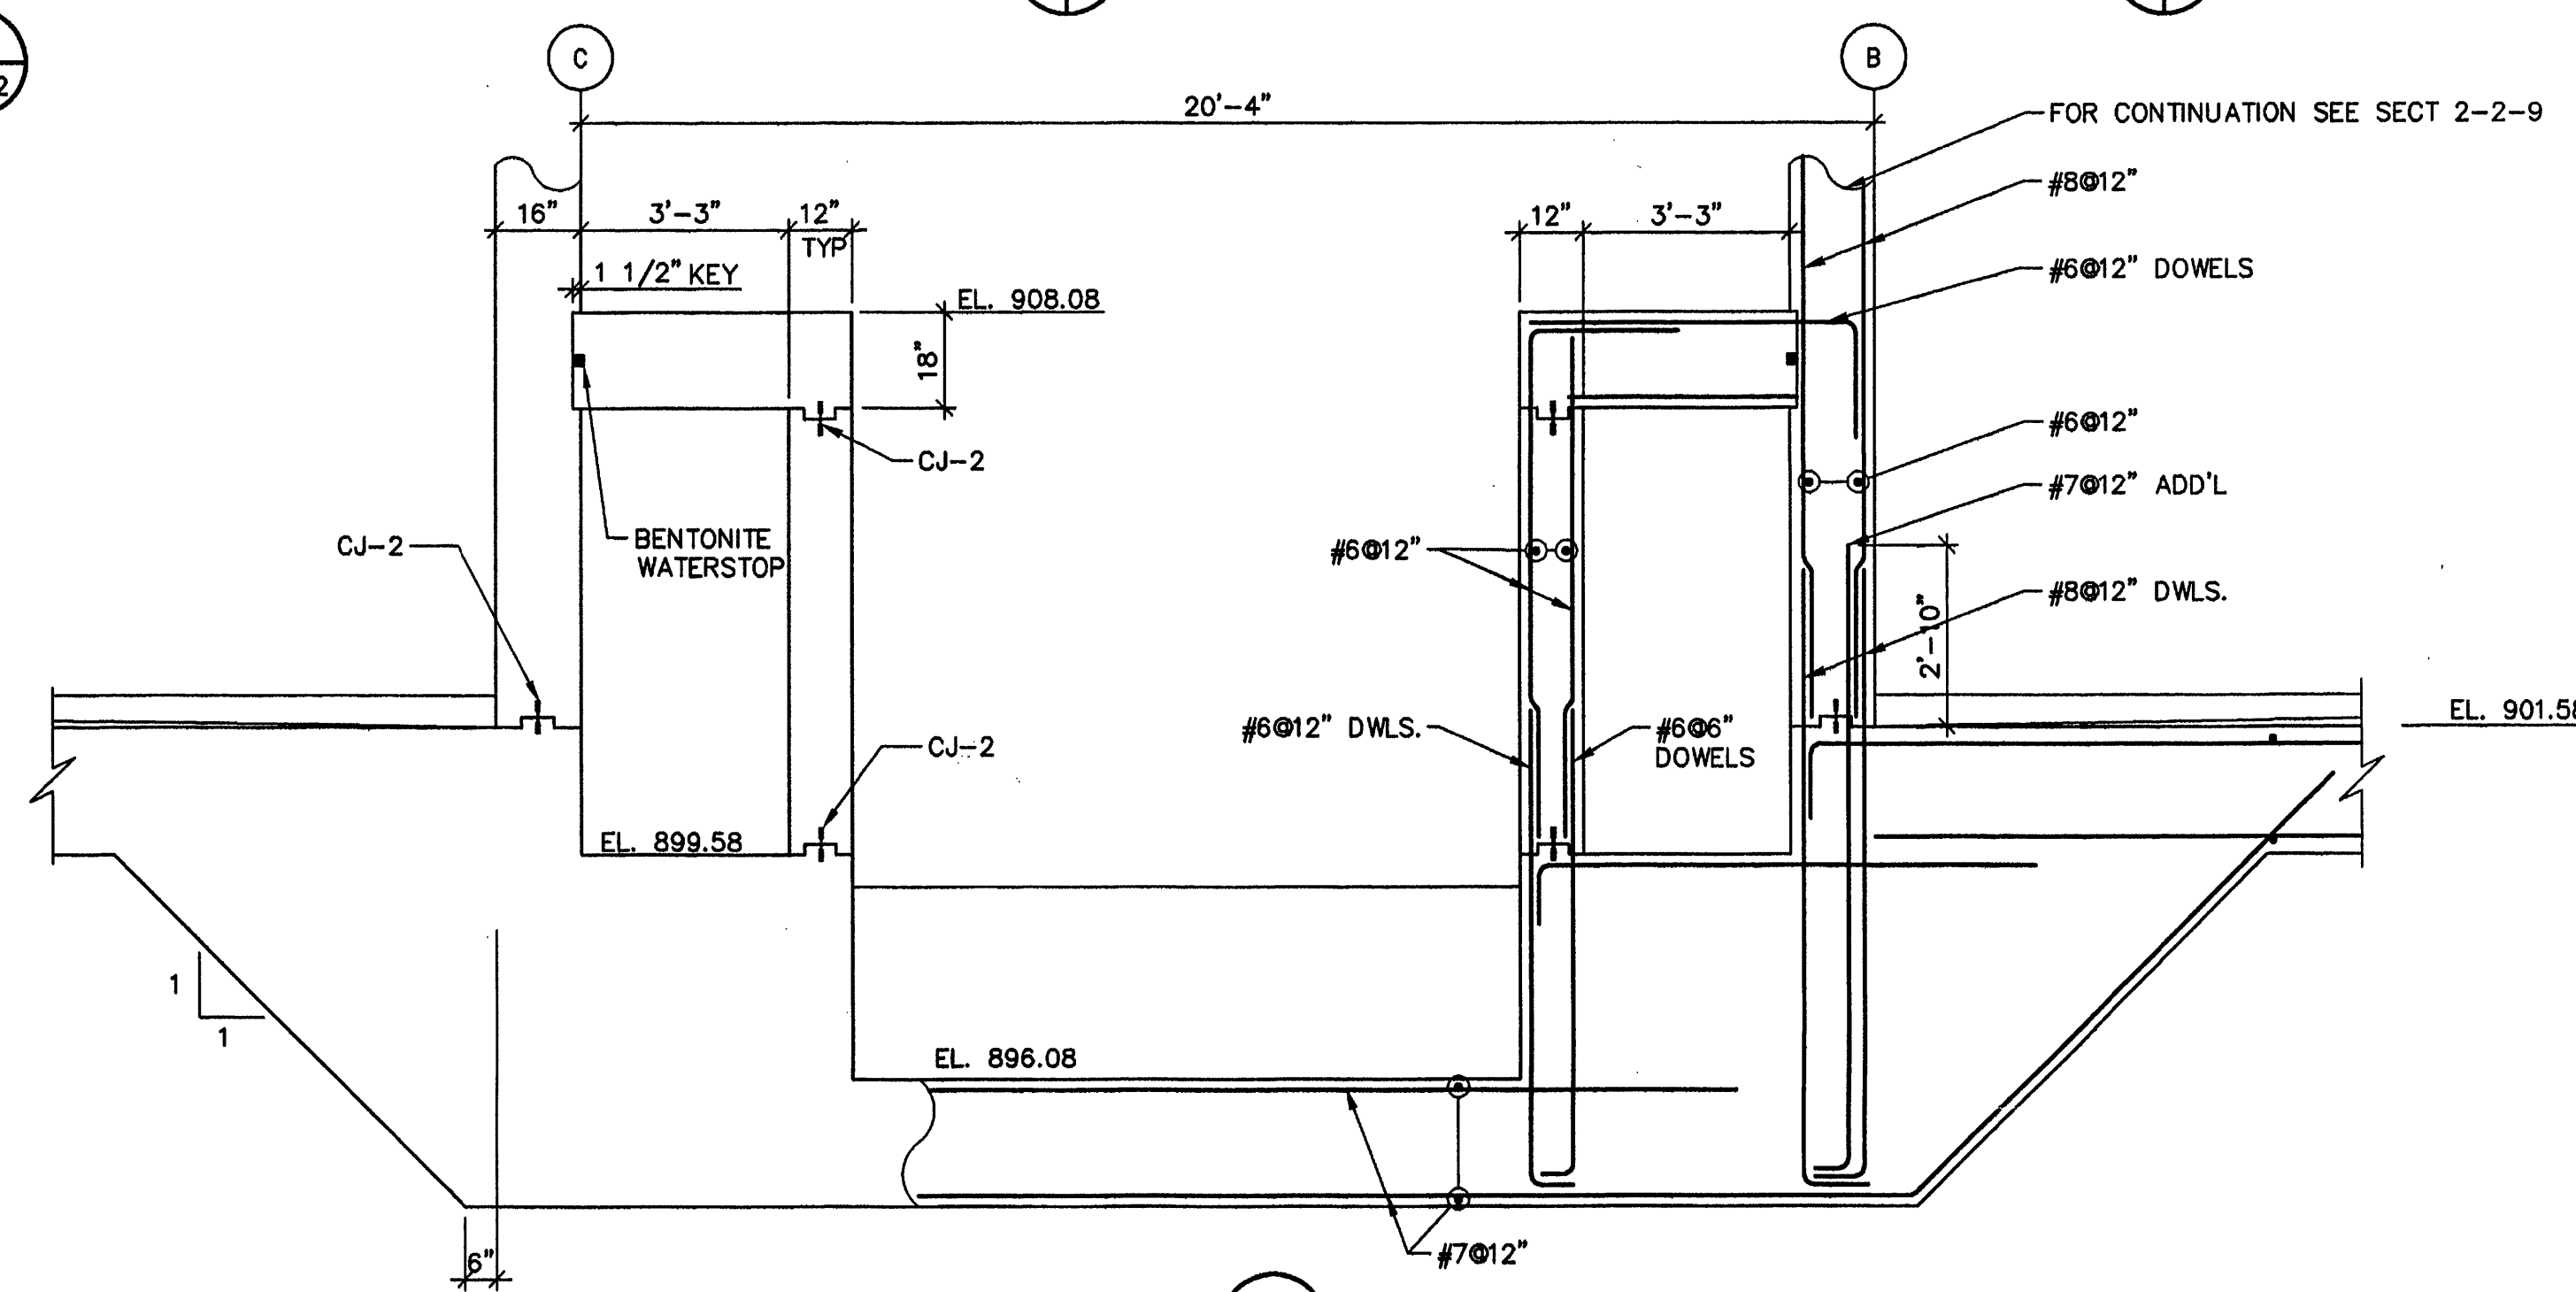

SECTION 6
3/12

GENERAL NOTE:

NOT ALL BAF EQUIPMENT, PIPING, VALVES AND APPURTENANCES ARE SHOWN.
SEE SPECIFICATIONS AND BAF MANUFACTURER'S SHOP DRAWINGS FOR ADDITIONAL
ITEMS AND SCOPE OF EQUIPMENT, PIPING, VALVES AND APPURTENANCES
SUPPLIED TO THE CONTRACTOR BY THE BAF MANUFACTURER.

**MALCOLM
PIRNIE**
11832 Rock Landing Drive, Suite 400
Newport News, Virginia 23606

NO.	BY	DATE	REVISIONS	REMARKS
1	ARB	JAN. 2000	RECORD DRAWING	

DES --- MZ ---
DWN --- DRK ---
CKD --- DB ---



CITY OF ROANOKE, VIRGINIA
WATER POLLUTION
CONTROL PLANT
UPGRADE AND EXPANSION

BIOLOGICAL AERATED FILTER
SECTIONS

3/8"=1'-0"

COPYRIGHT © 1997
MALCOLM PIRNIE, INC.
DATE --- MAY 1997 ---
S SHEET 12 OF 44 ---
CAD REF. NO. 0080S363 ---