




4445 0060028505 I:\ACAD\PROJ\00600285\006003380 Scale: 1:1 Date: 05/06/1997 Time: 08:51

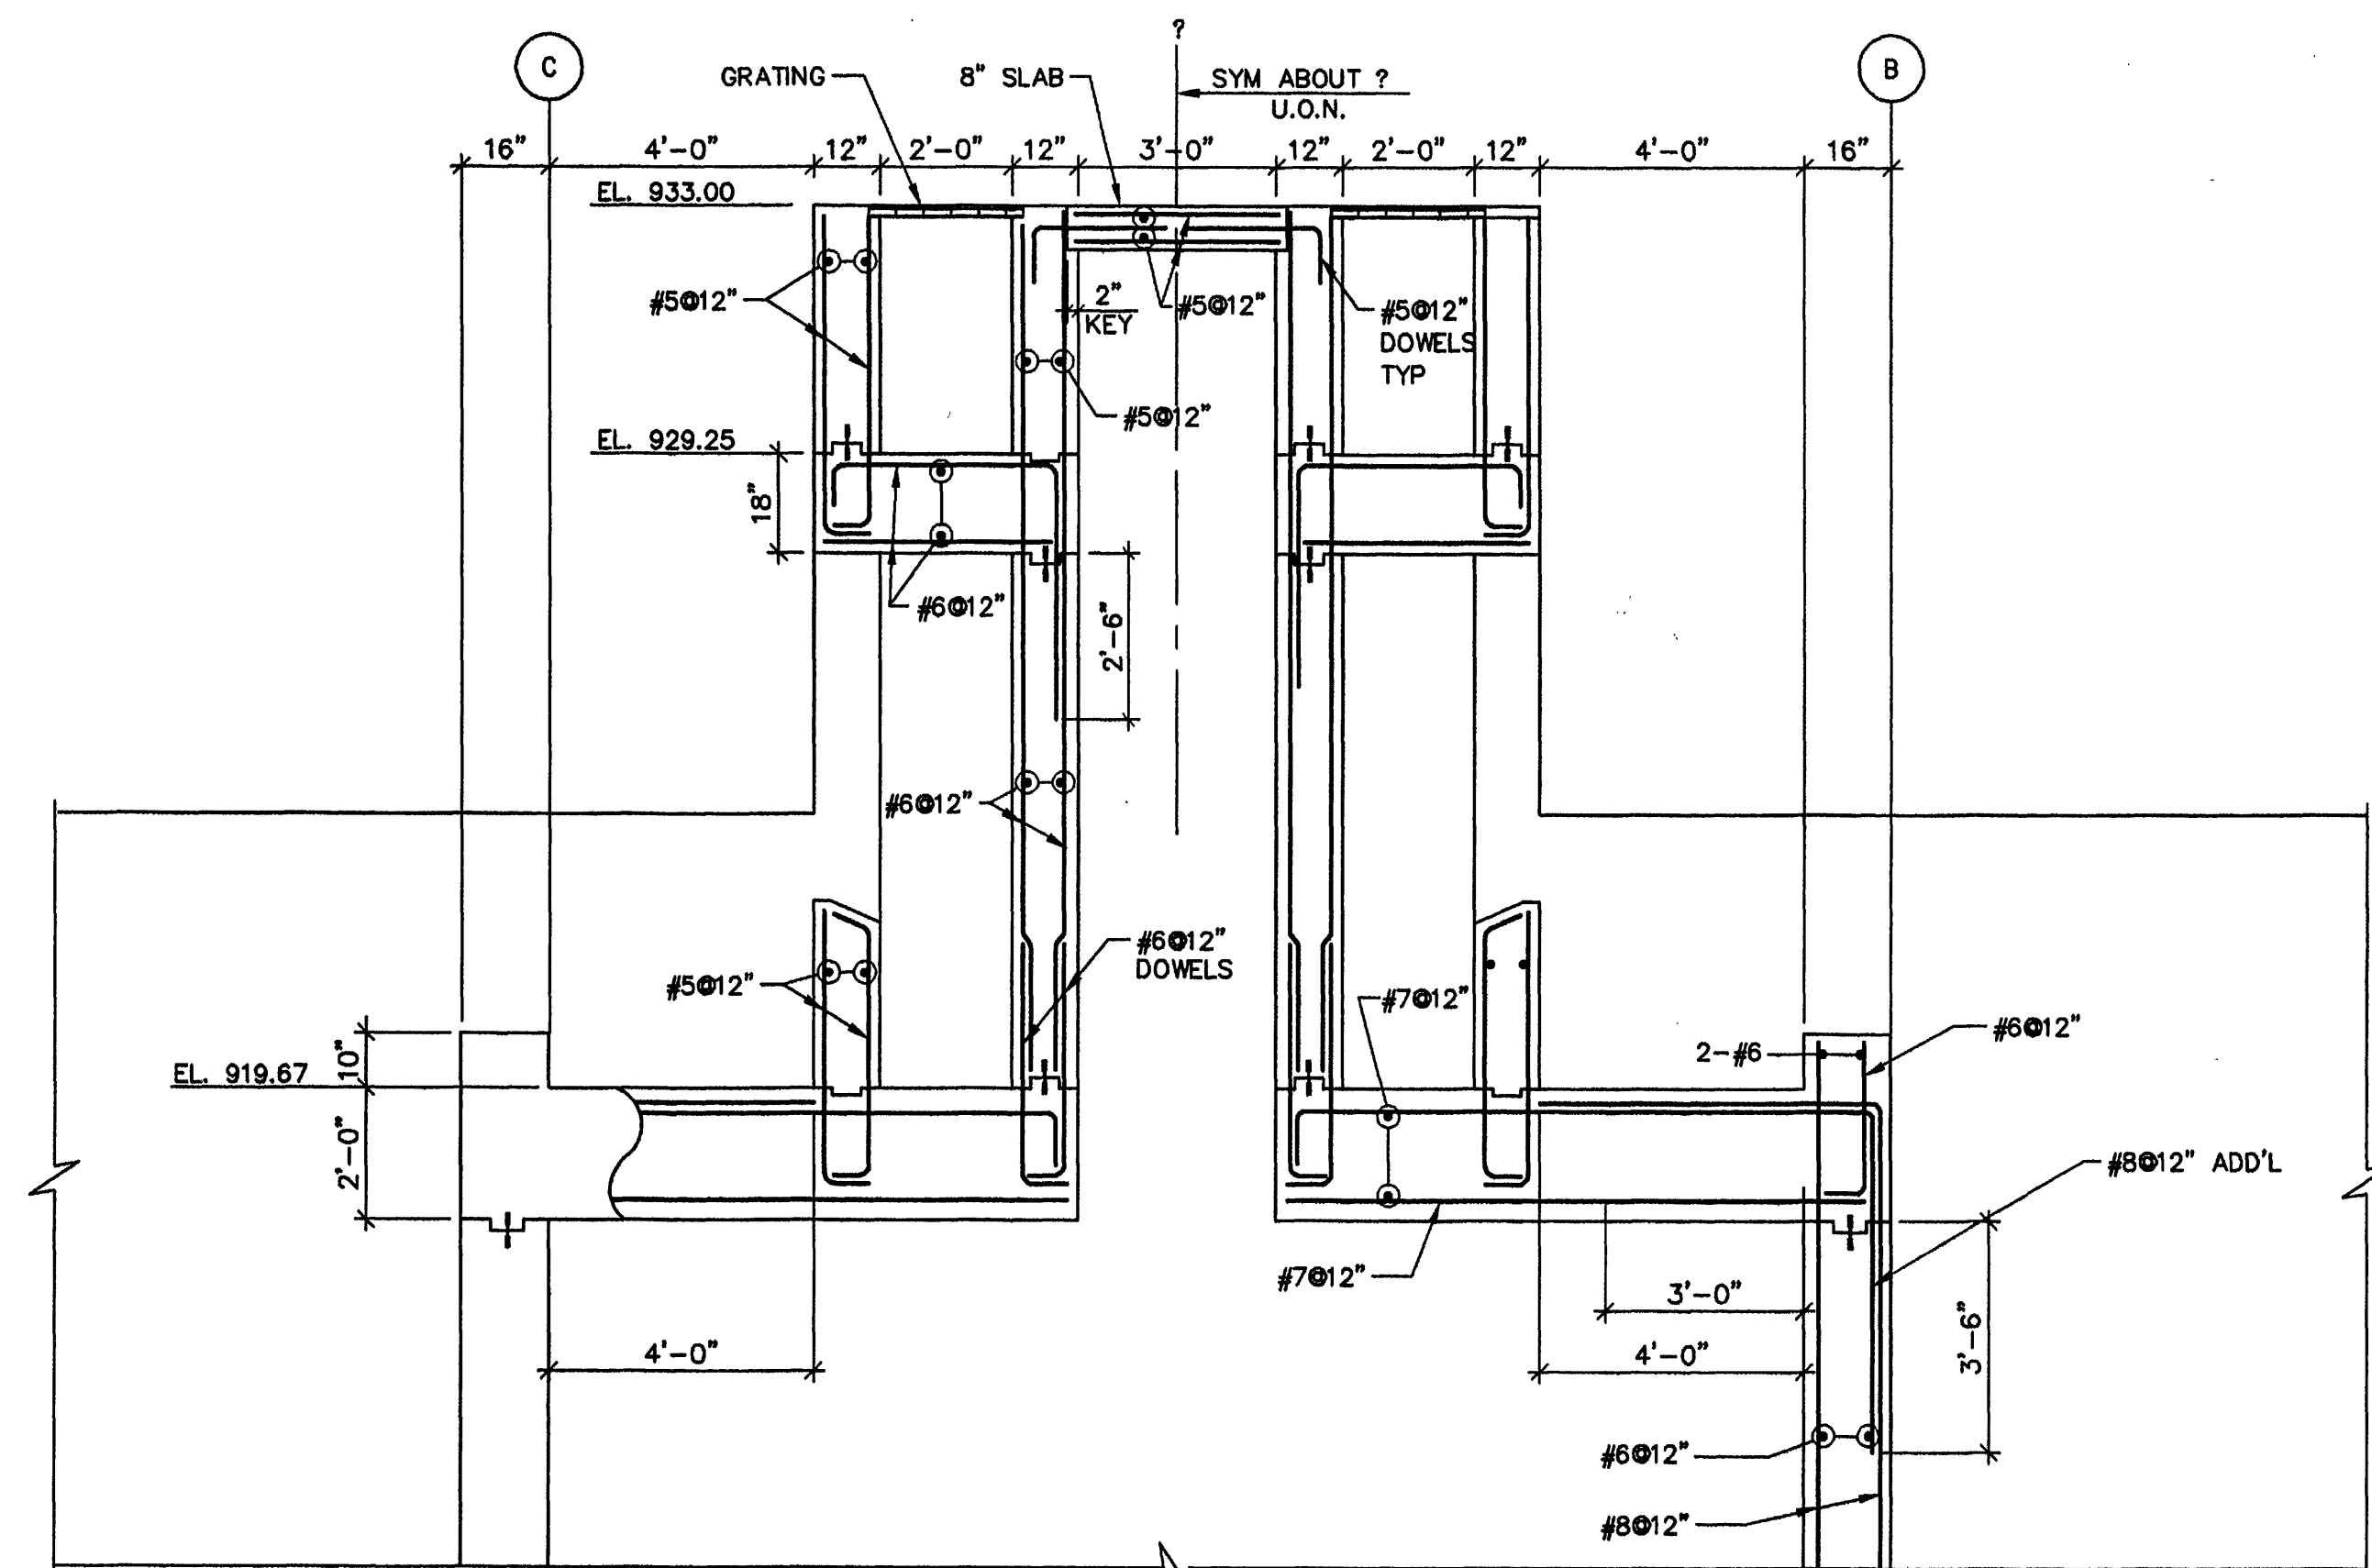


SECTION 1  
SCALE: 3/8" = 1'-0"

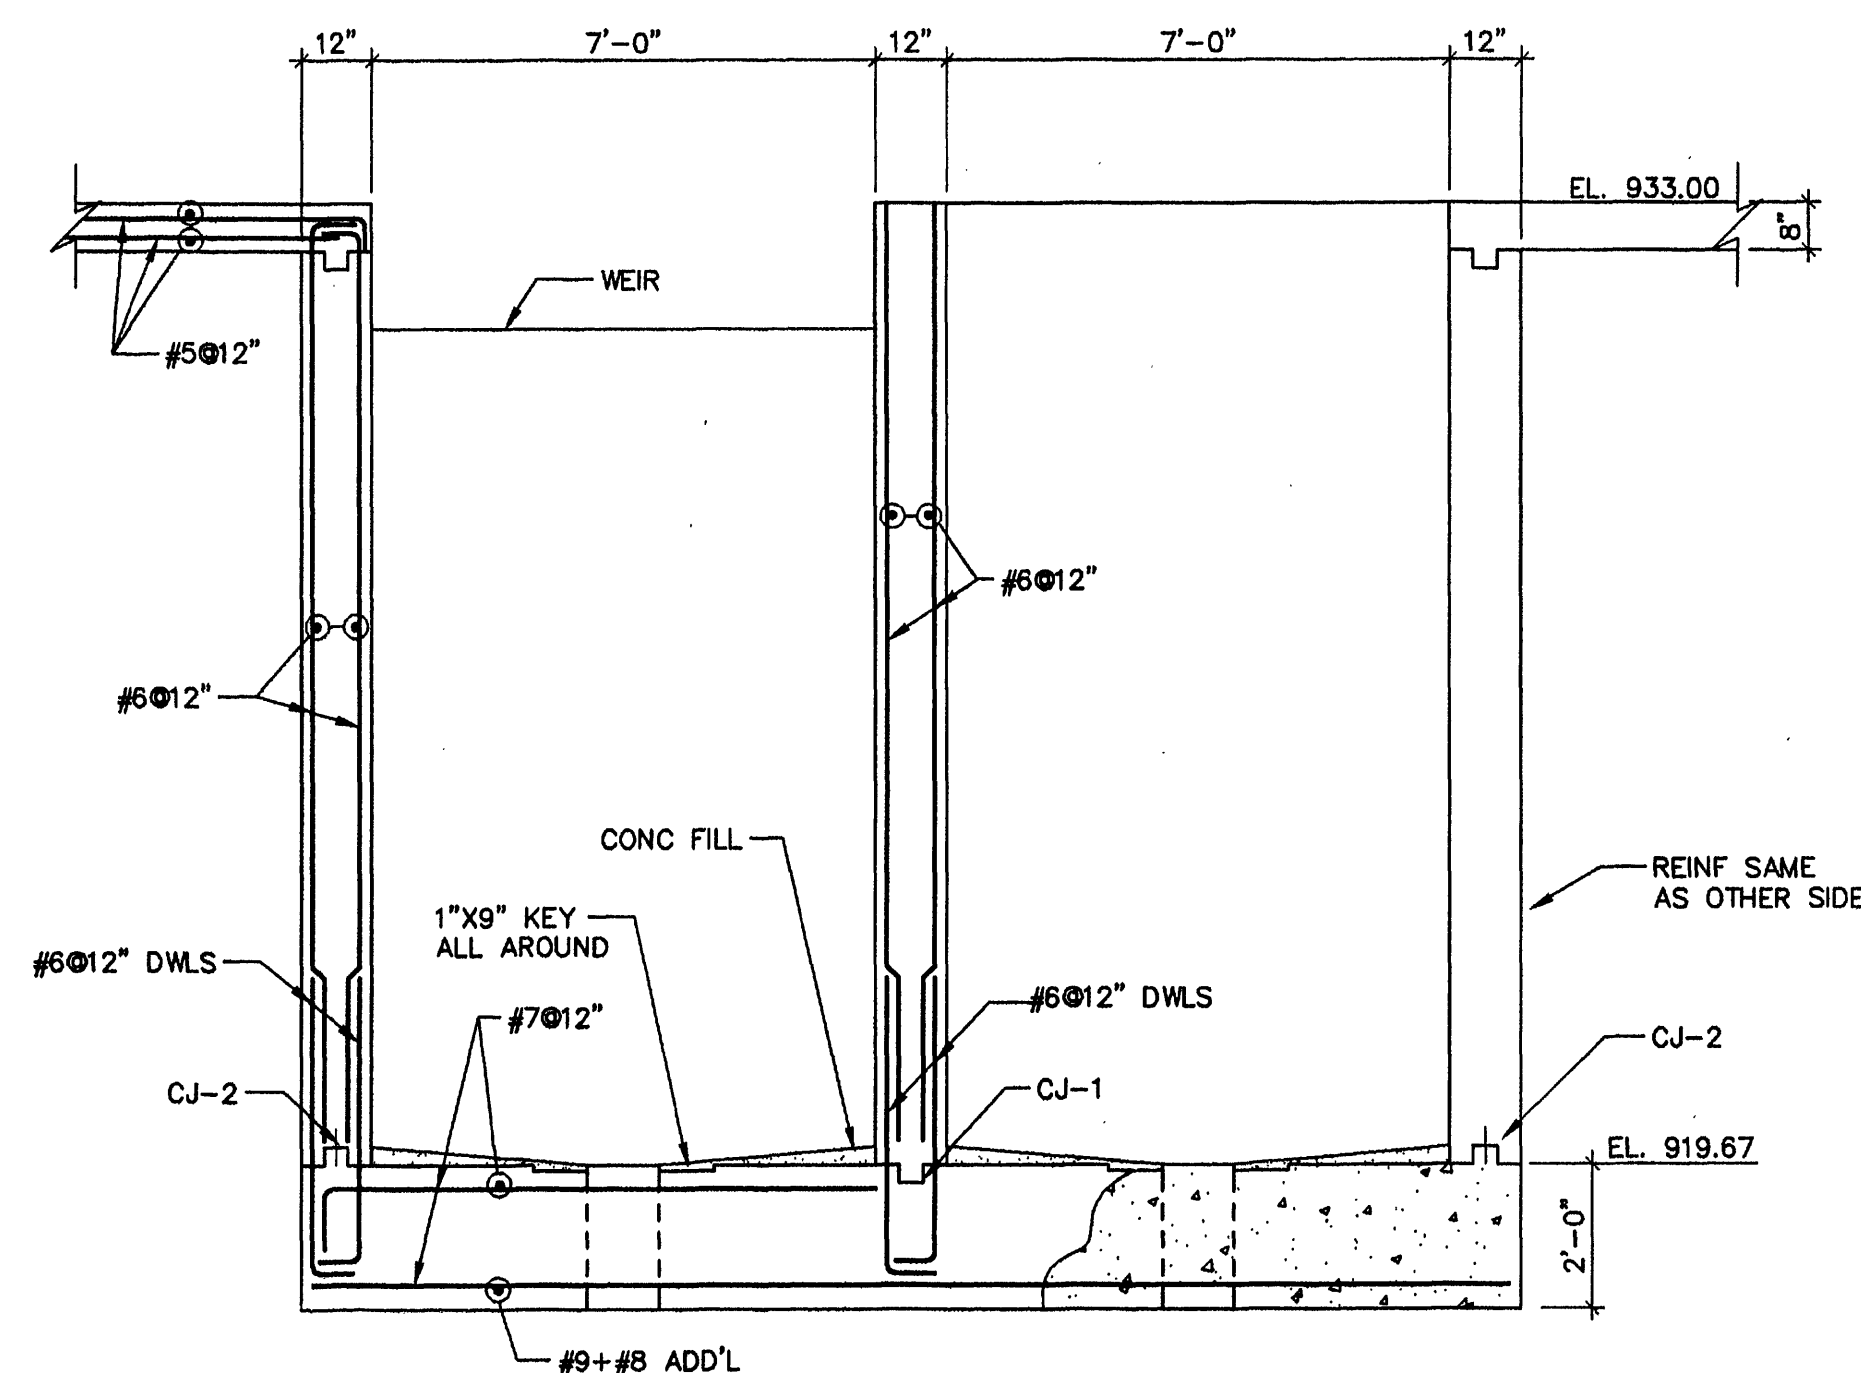


SECTION 2  
SCALE: 3/8" = 1'-0"

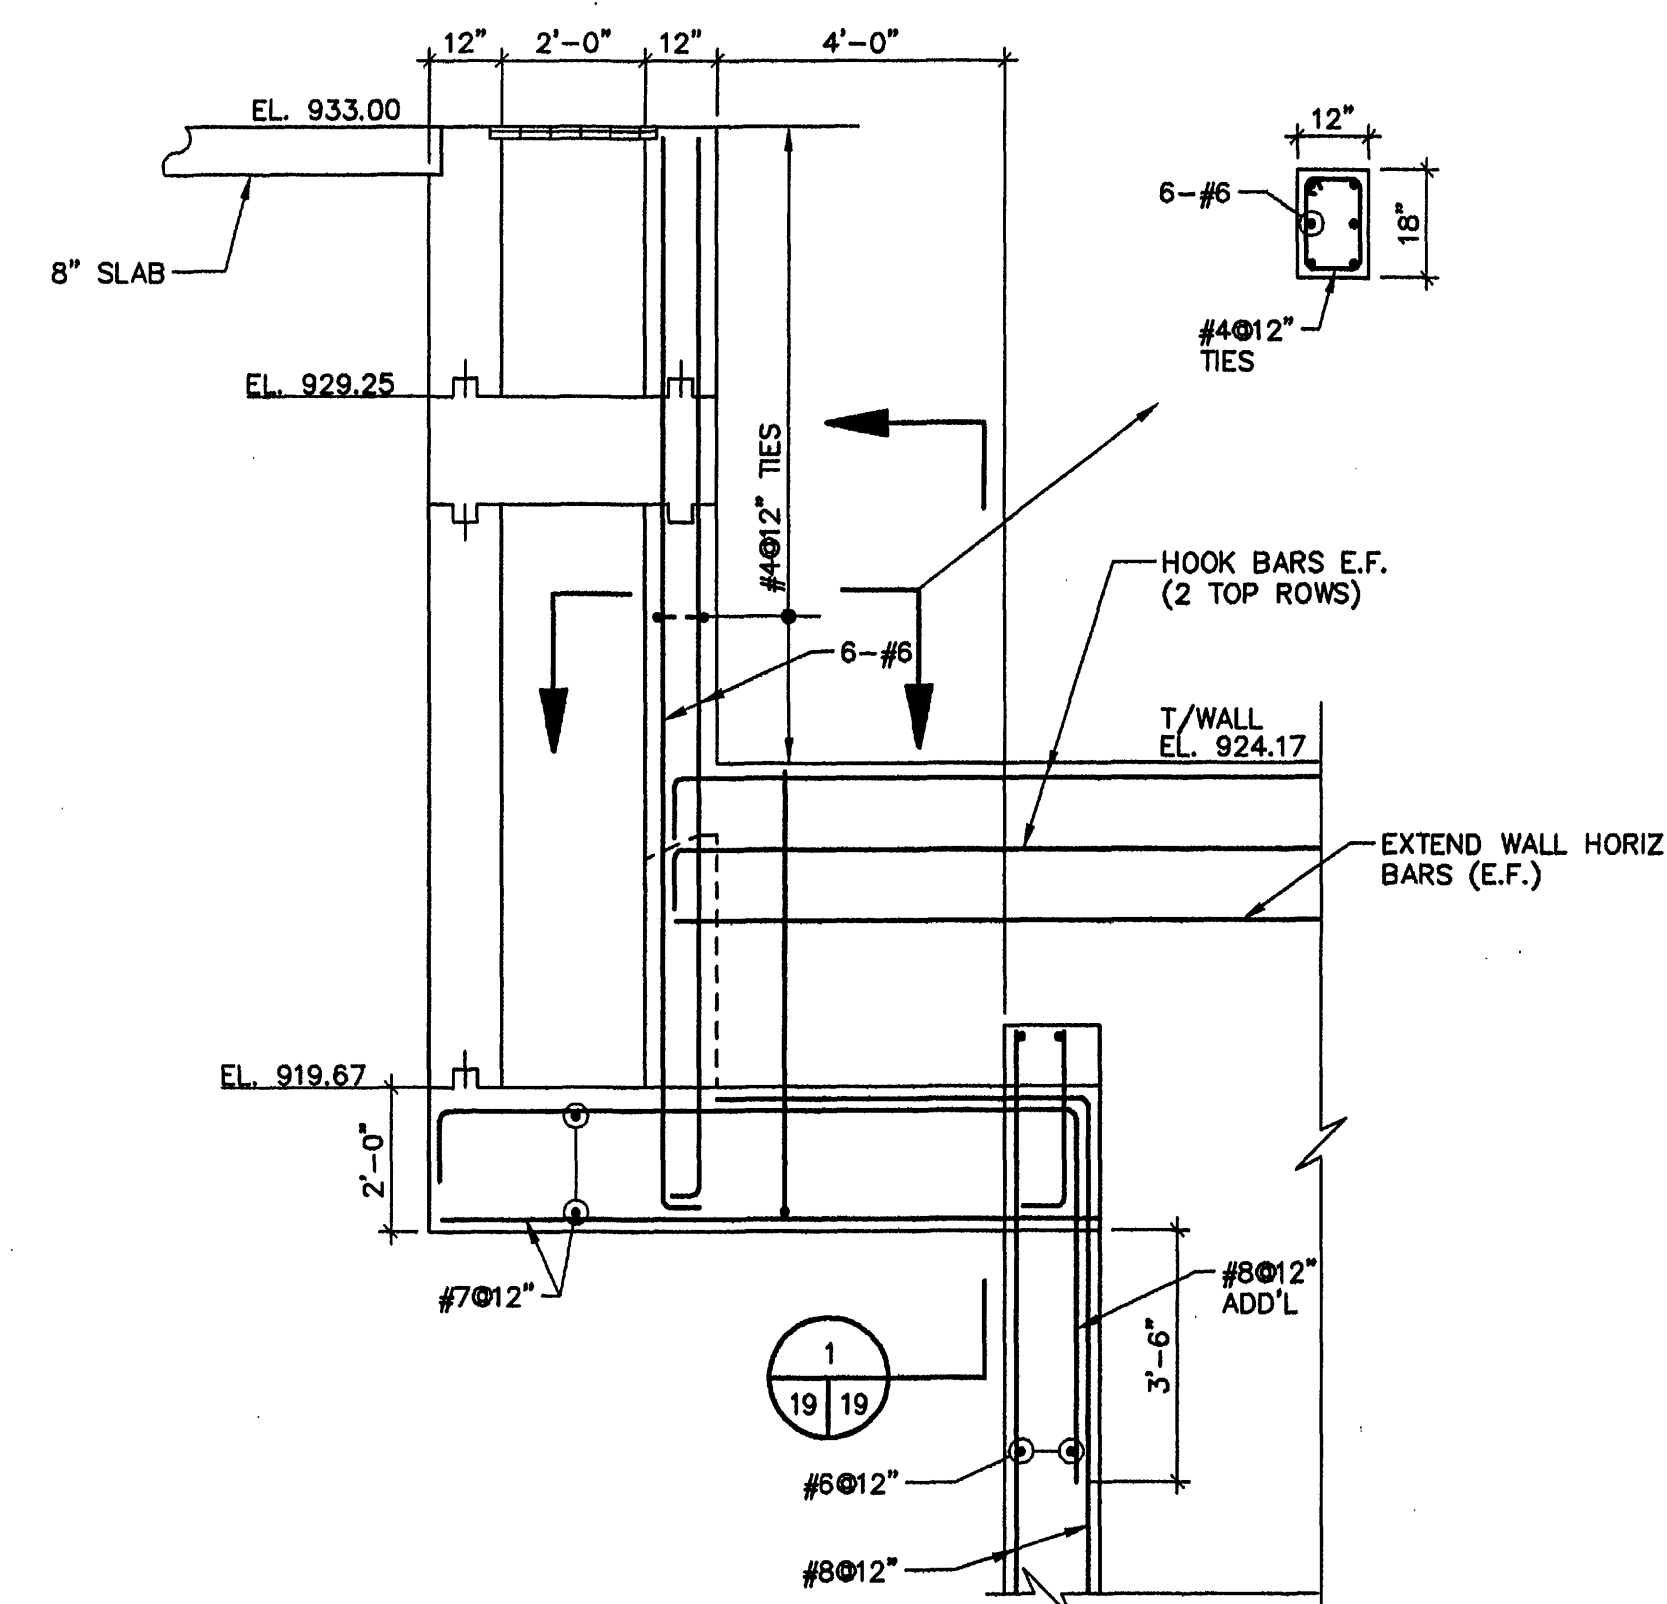

SECTION 3  
SCALE: 3/8" = 1'-0"

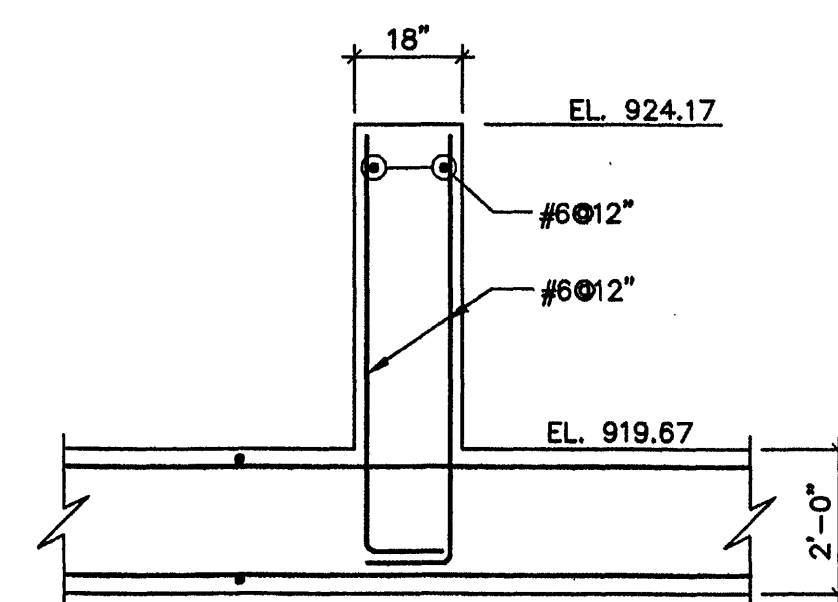


SECTION 4  
SCALE: 3/8" = 1'-0"

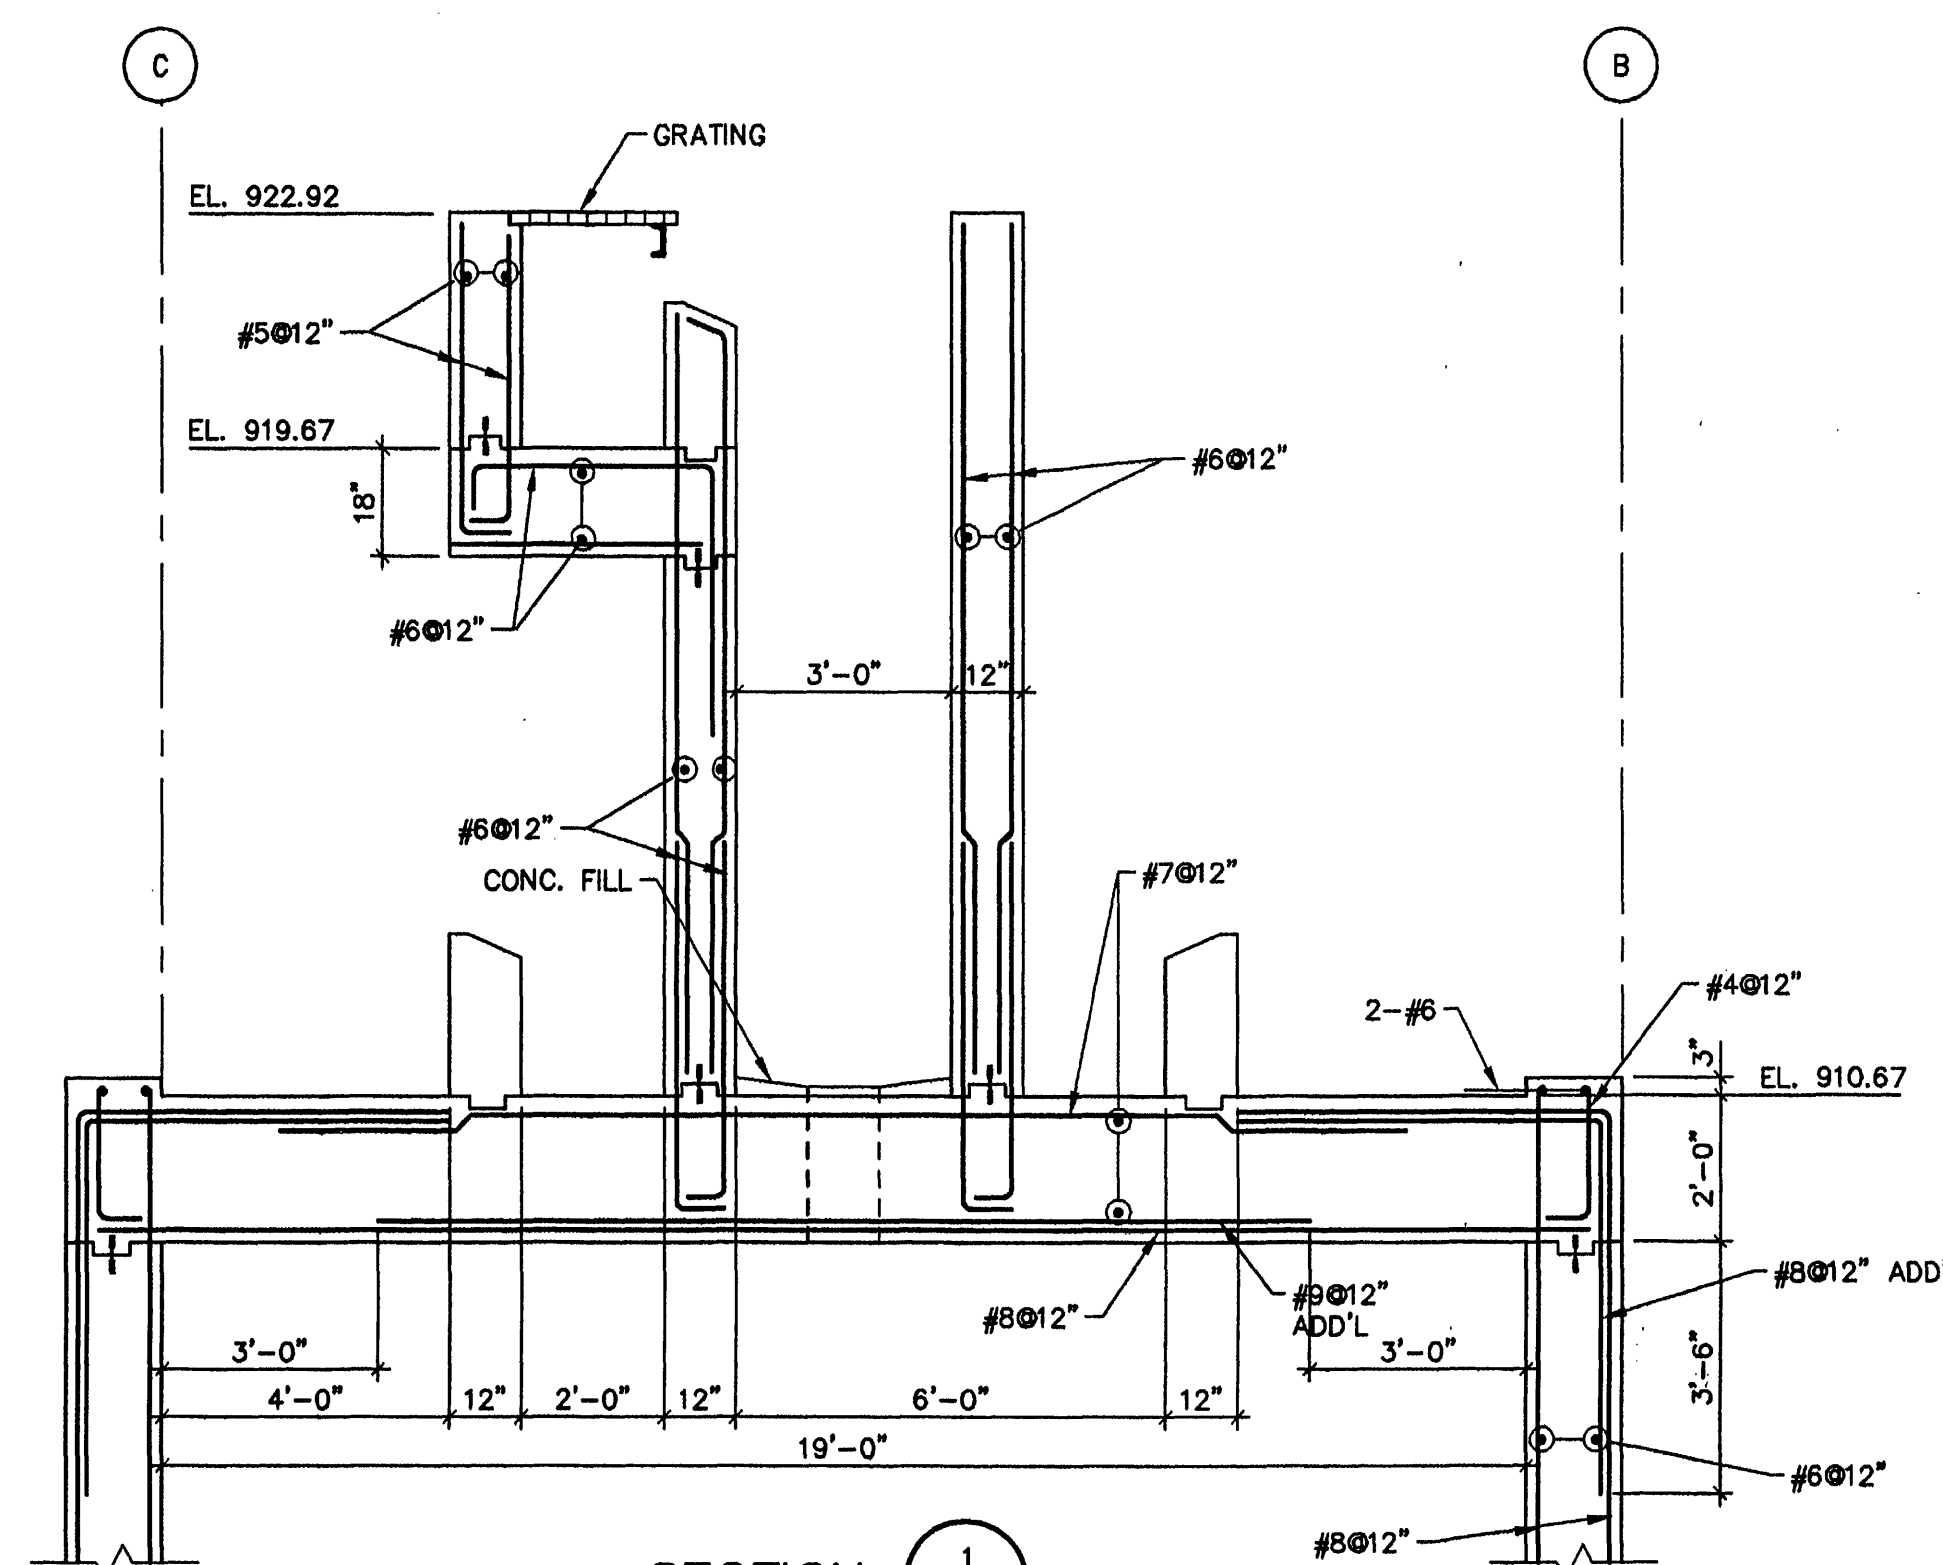

SECTION 5  
SCALE: 3/8" = 1'-0"

**MALCOLM  
PIRNIE**  
11832 Rock Landing Drive, Suite 400  
Newport News, Virginia 23606

| REVISIONS |     |           |                | DES | DWN     | CKD |
|-----------|-----|-----------|----------------|-----|---------|-----|
| NO.       | BY  | DATE      | REMARKS        |     |         |     |
| 1         | ARB | JAN. 2000 | RECORD DRAWING | MMZ | MMZ/CBM | DB  |
|           |     |           |                |     |         |     |
|           |     |           |                |     |         |     |
|           |     |           |                |     |         |     |

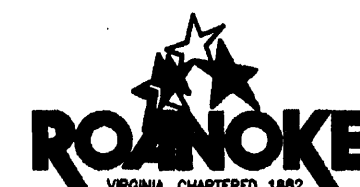

CITY OF ROANOKE, VIRGINIA  
WATER POLLUTION  
CONTROL PLANT  
UPGRADE AND EXPANSION

BIOLOGICAL AERATED FILTER  
SECTIONS

SCALE AS NOTED

COPYRIGHT © 1997  
MALCOLM PIRNIE, INC.  
DATE MAY 1997  
SHEET 19 OF 44  
CAD REF. NO. 006003380