




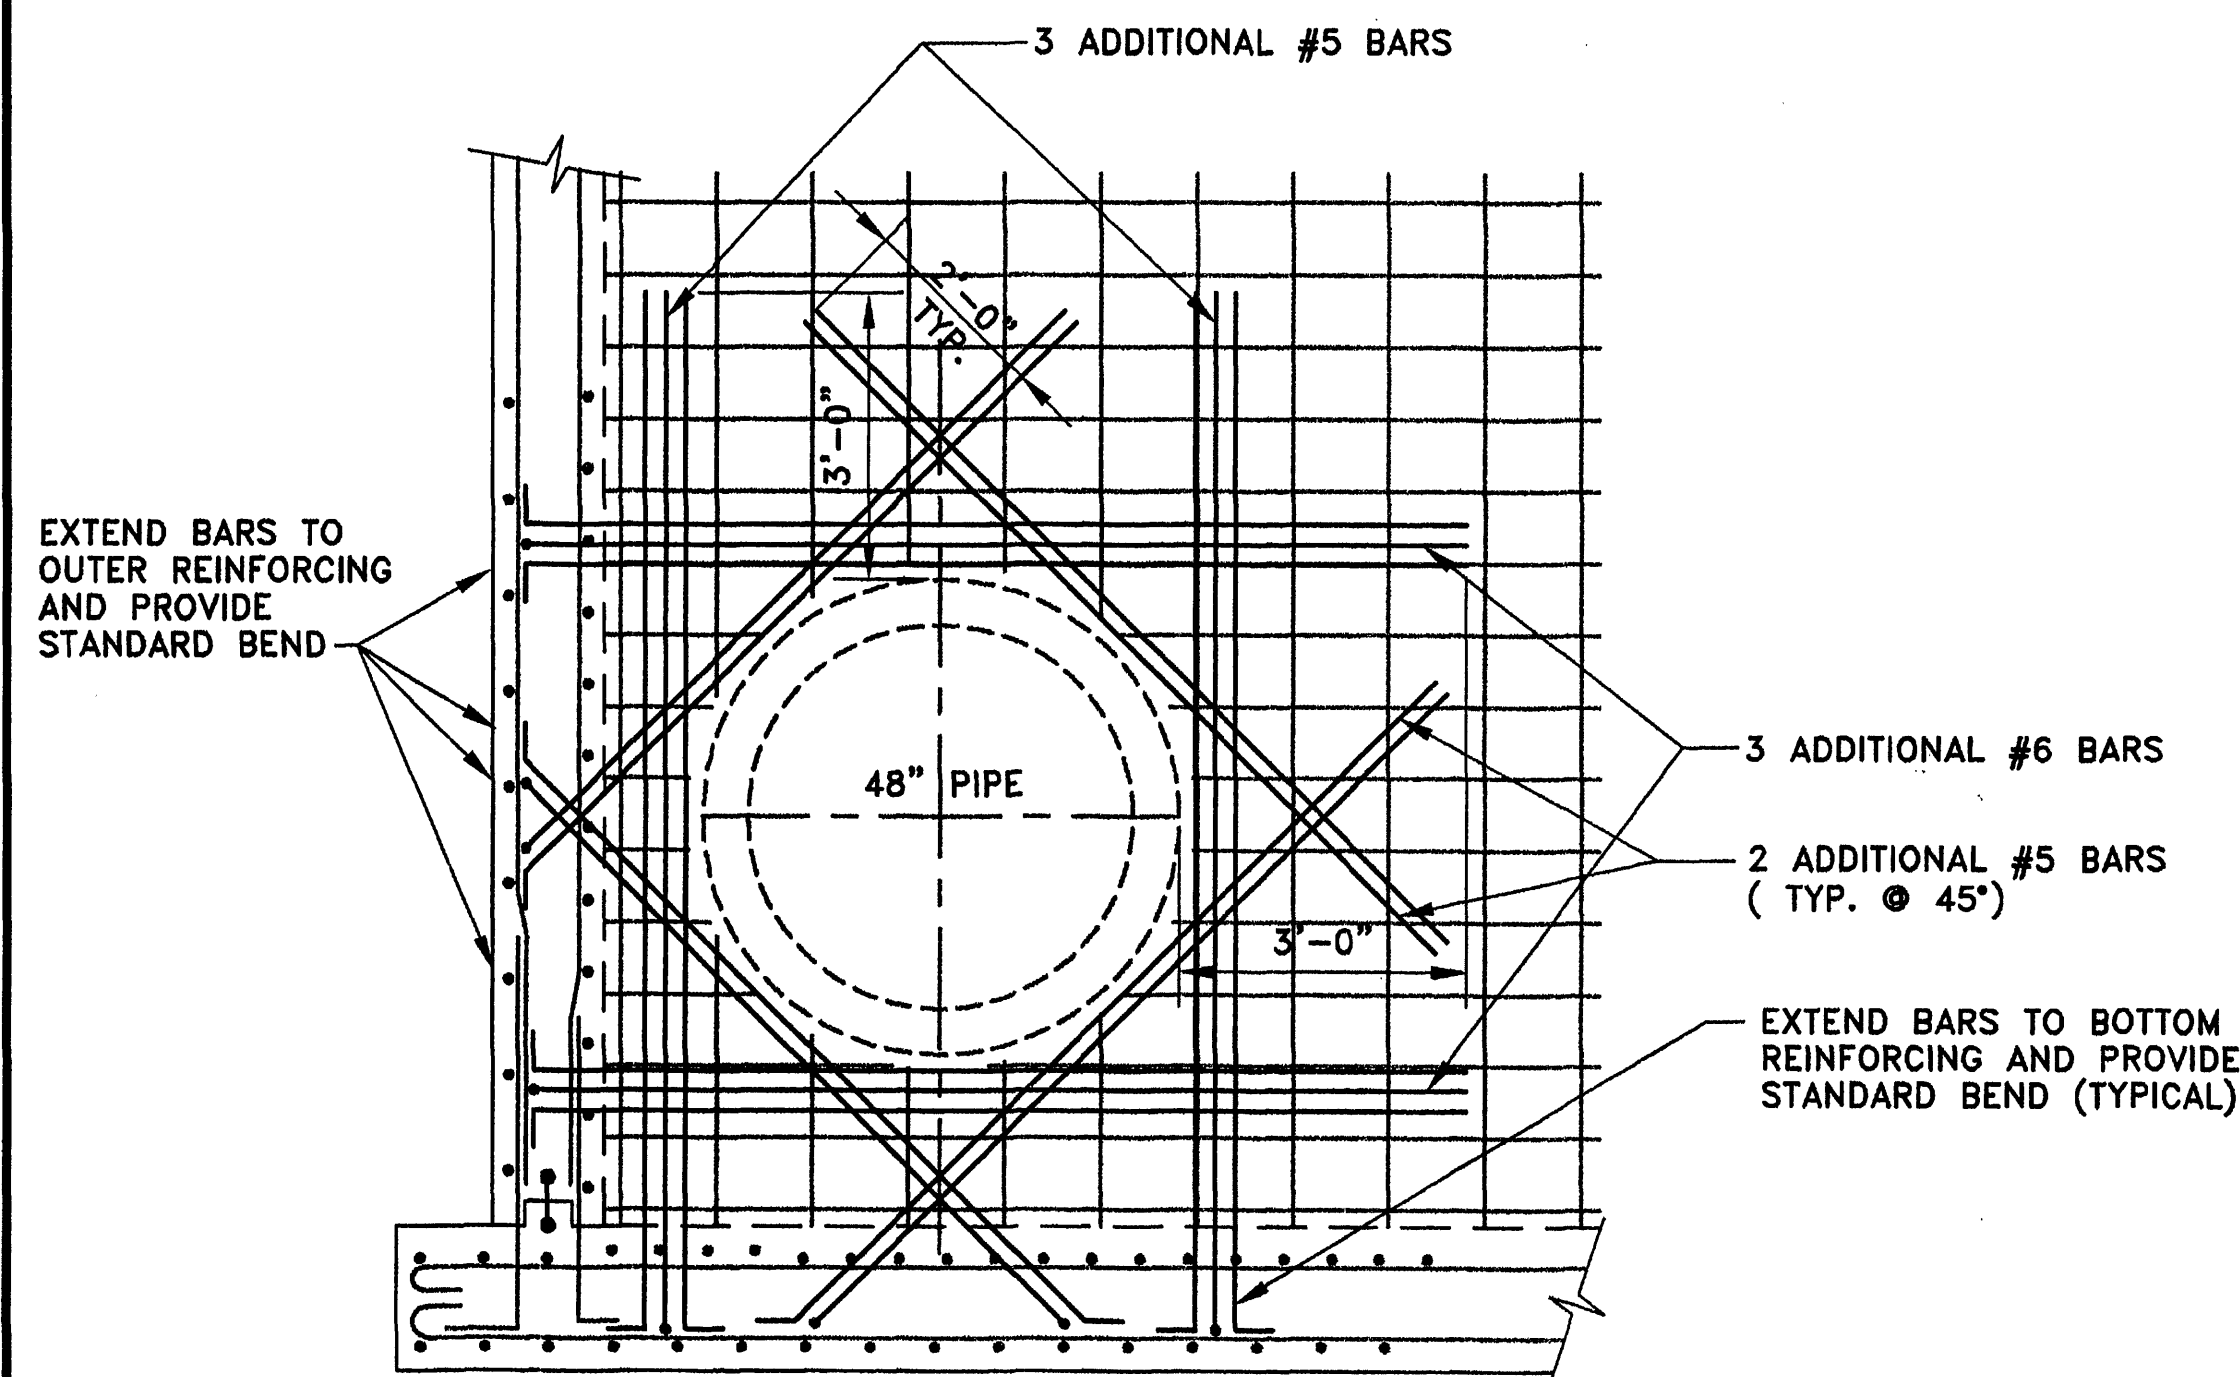


REBAR DETAIL @ 48" PIPE OPENING (INTERIOR FACE)
SCALE: 1/2"=1'-0"

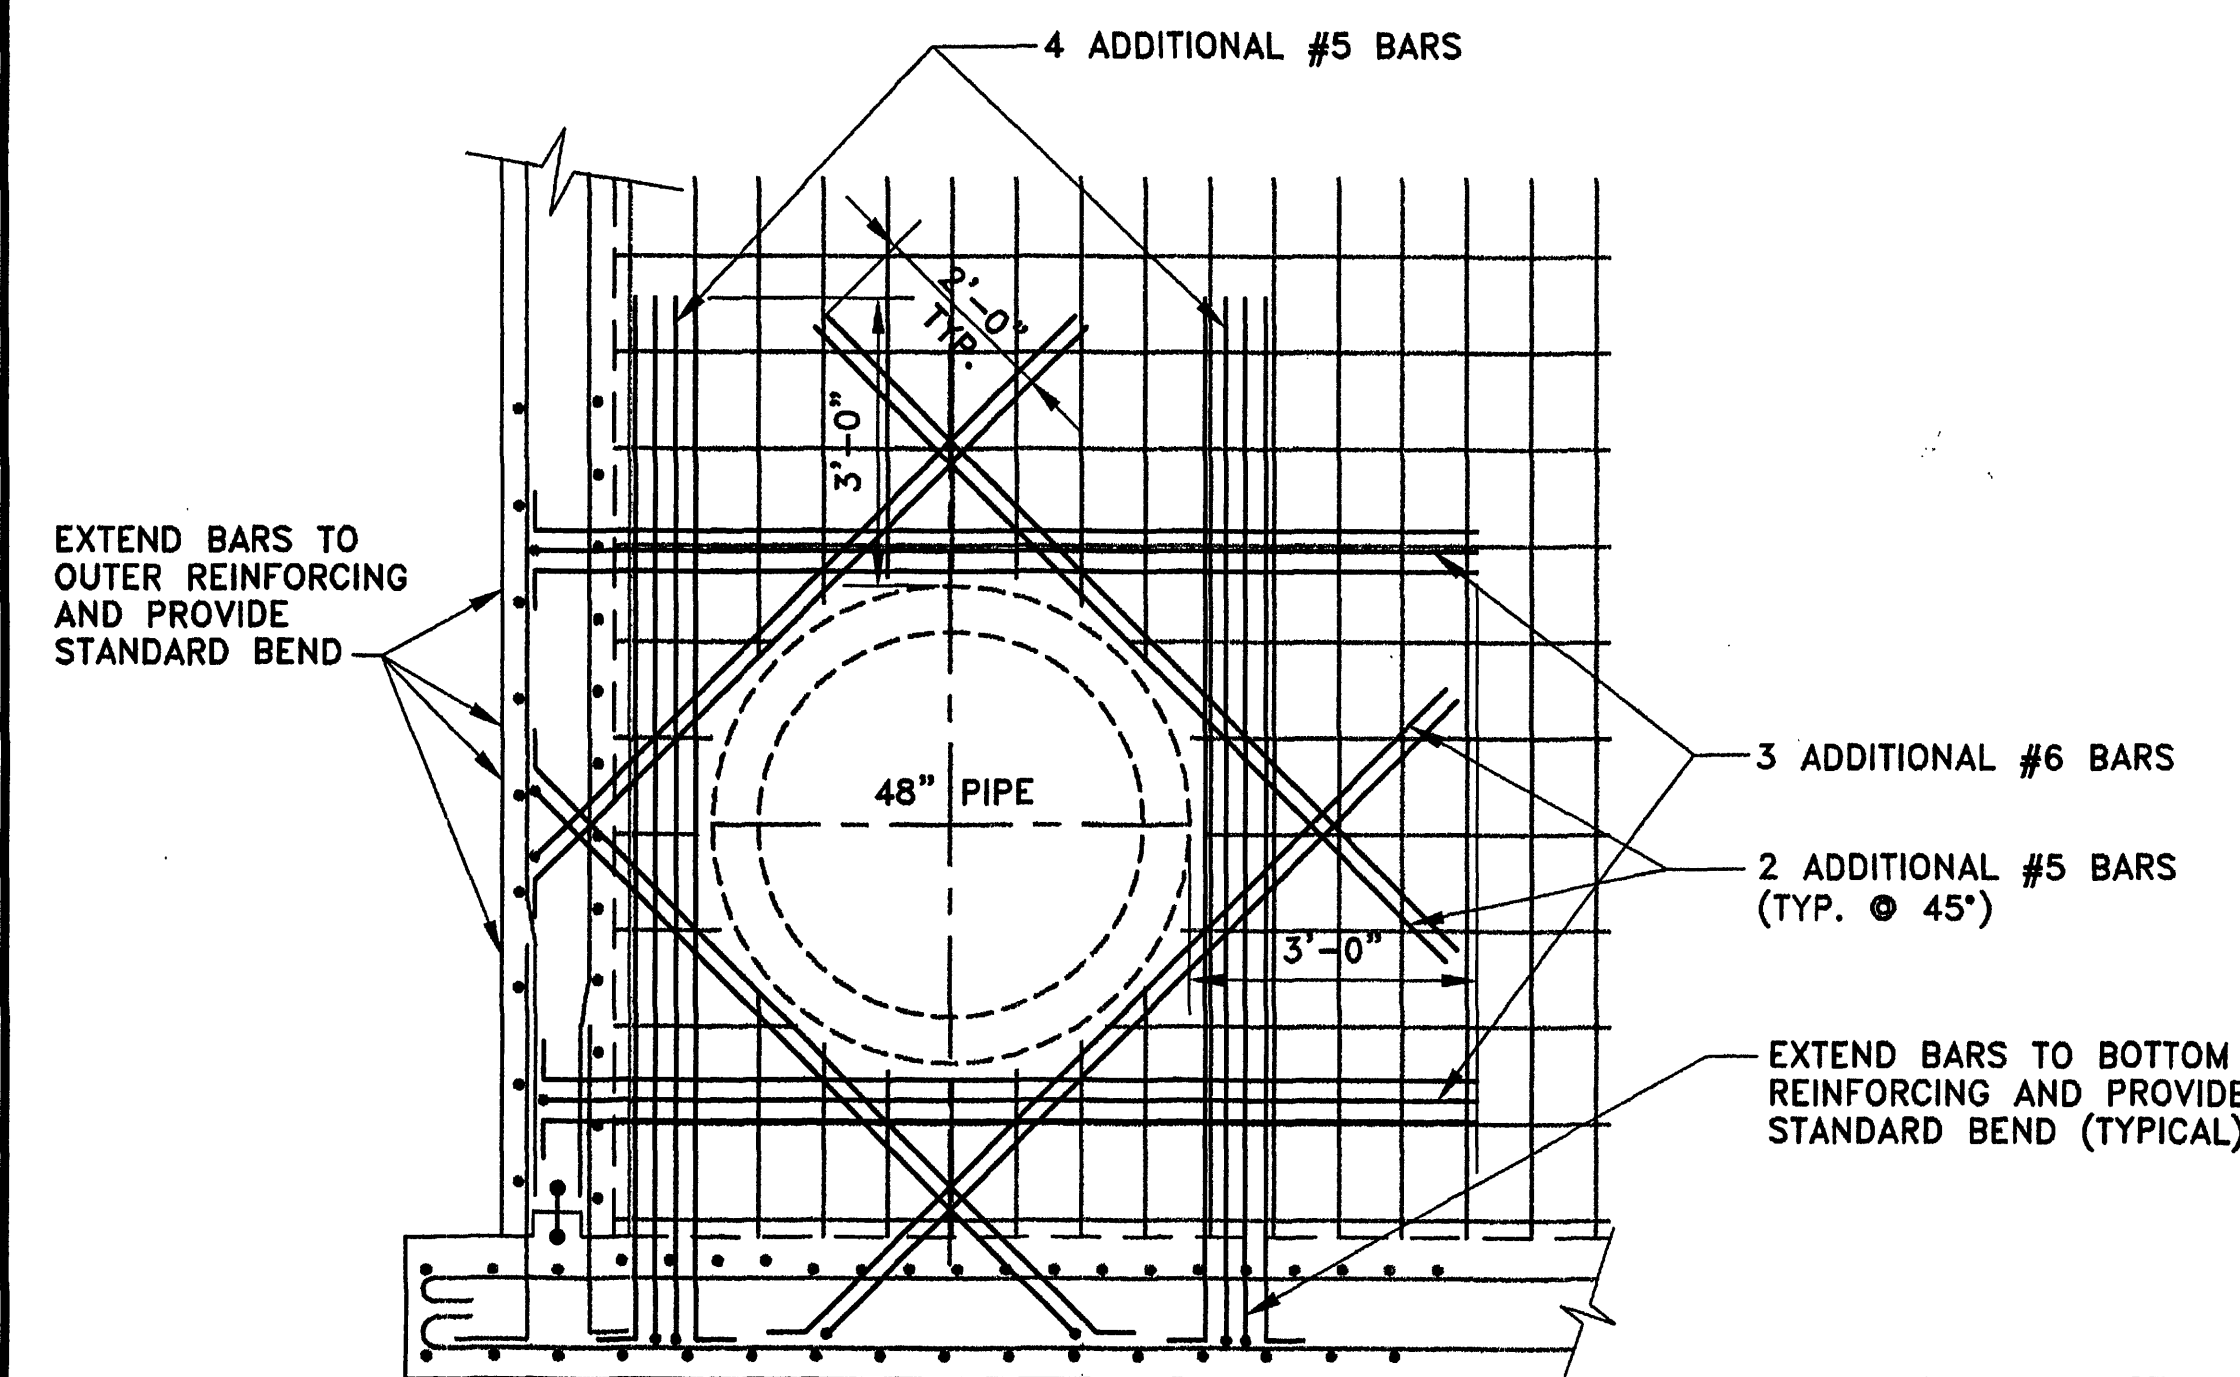


REBAR DETAIL @ 48" PIPE OPENING (EXTERIOR FACE)
SCALE: 1/2"=1'-0"

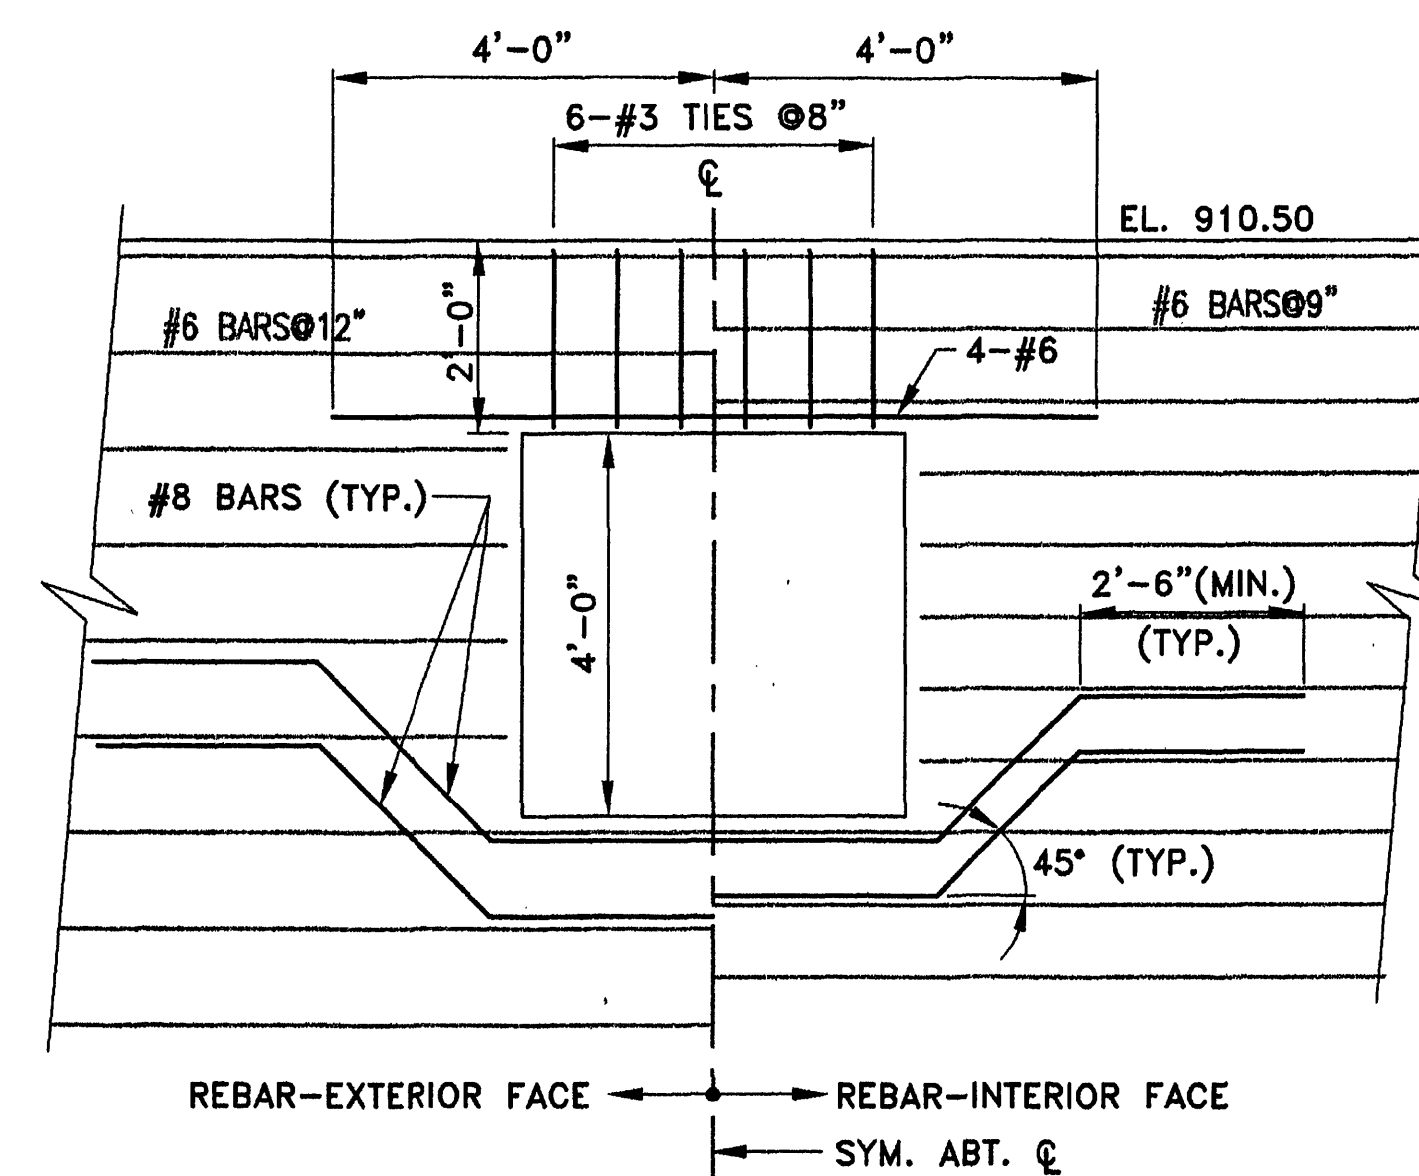


REBAR SPLICES @ WEIR GATE OPENING
SCALE: 1/2"=1'-0"

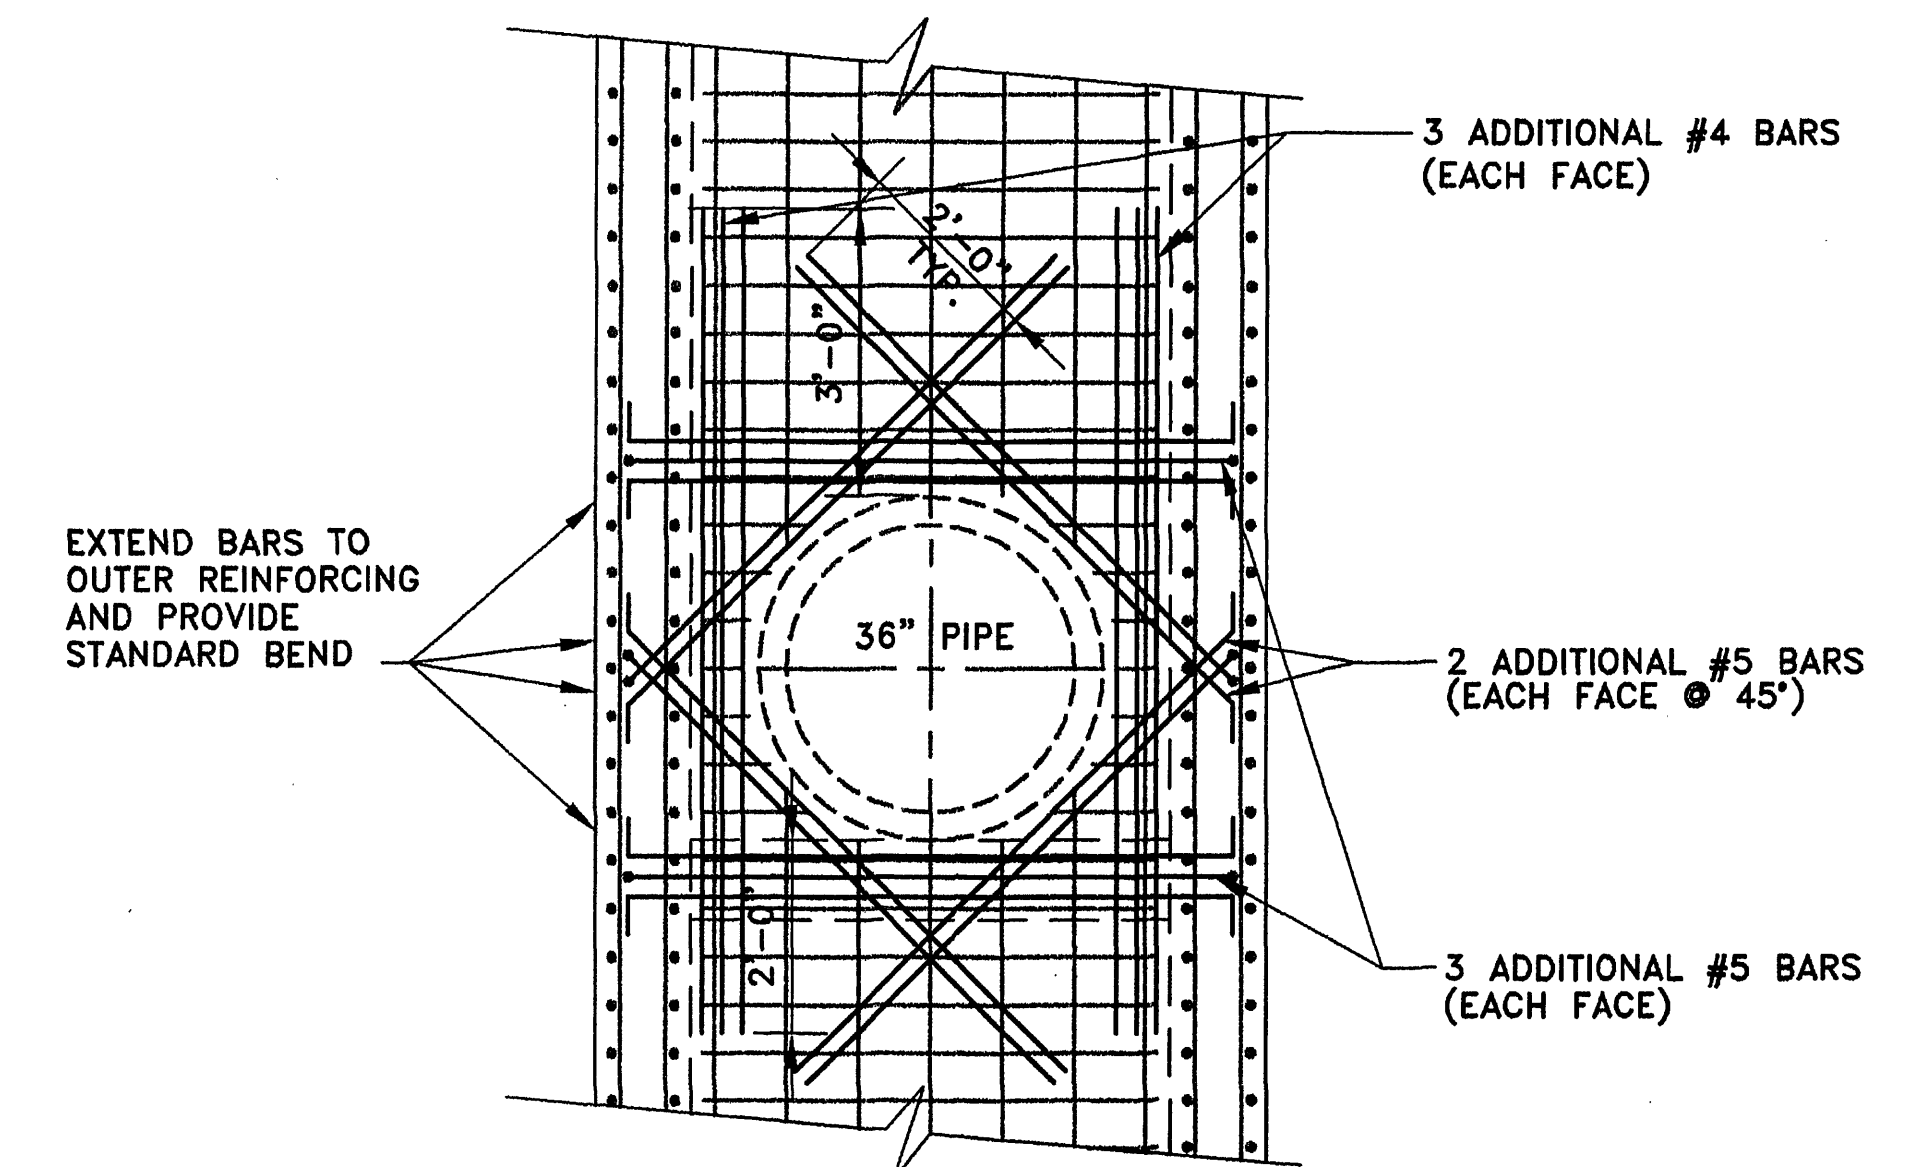

REBAR DETAIL @ 36" PIPE OPENING
SCALE: 1/2"=1'-0"

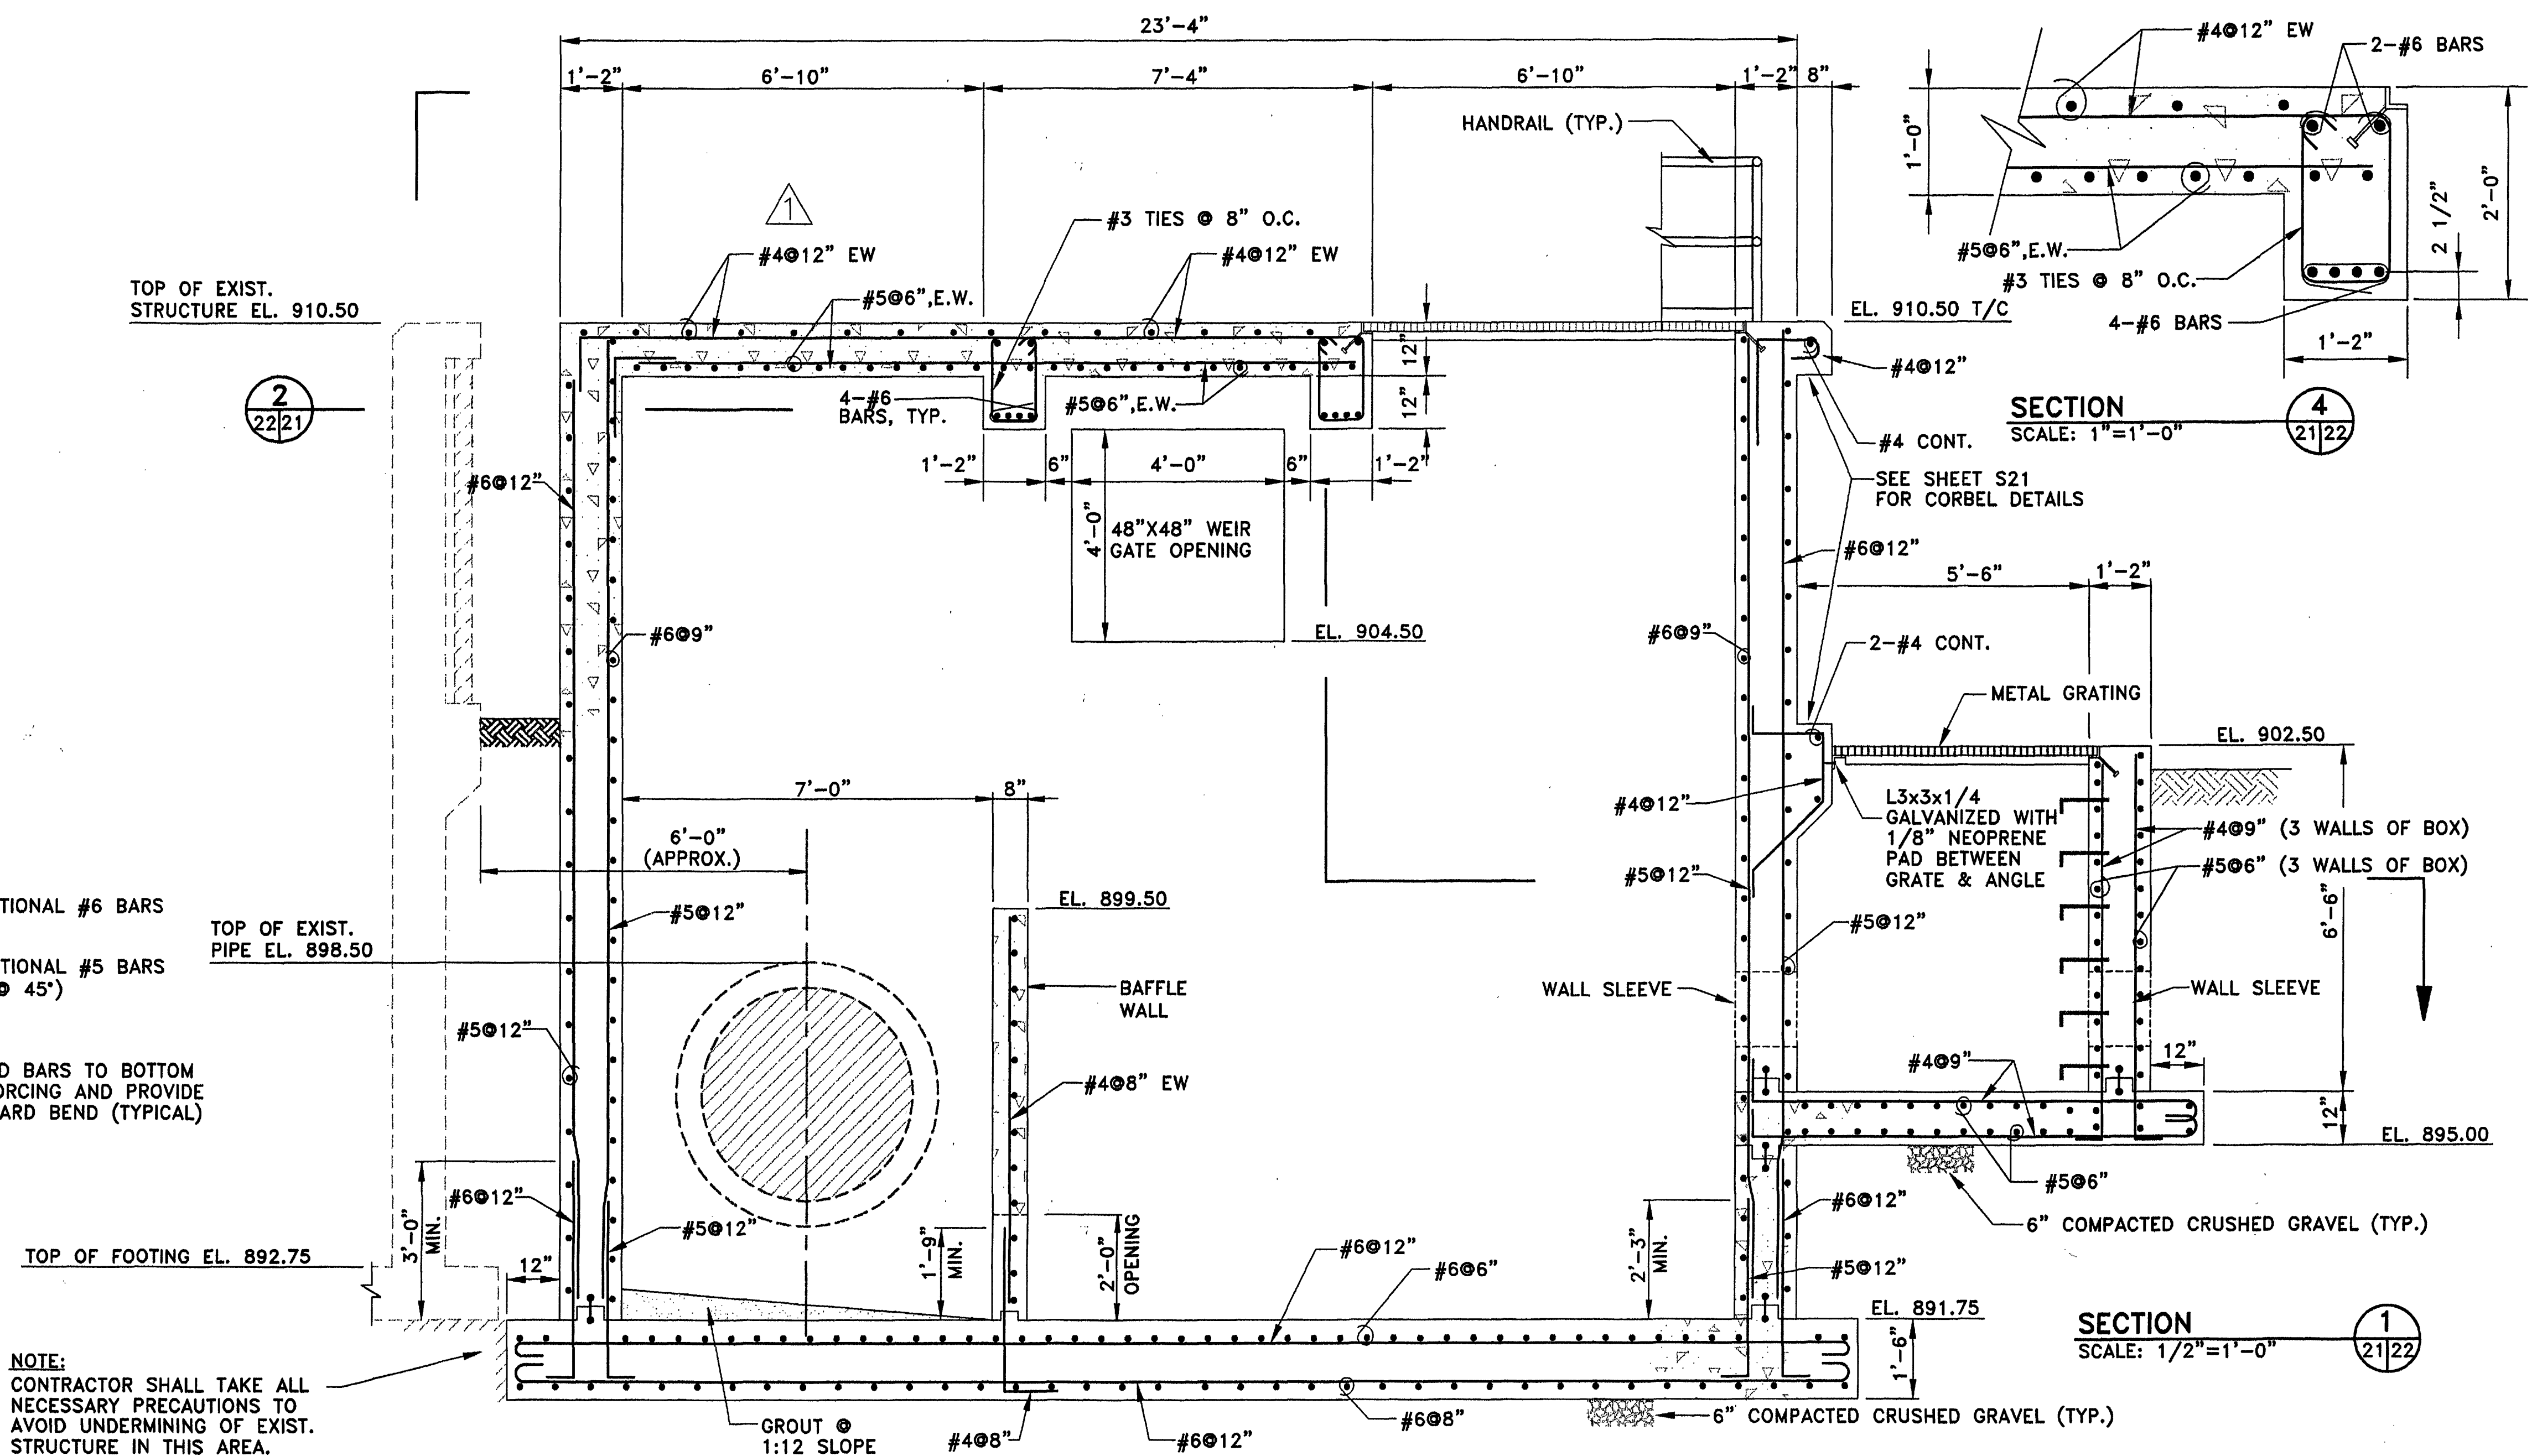

NOTE:
CONTRACTOR SHALL TAKE ALL
NECESSARY PRECAUTIONS TO
AVOID UNDERMINING OF EXIST.
STRUCTURE IN THIS AREA.

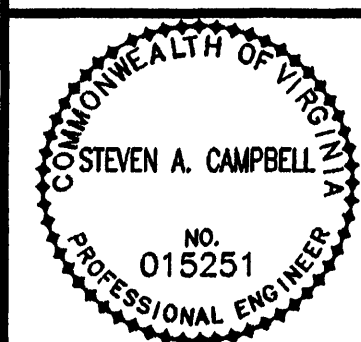

Mattern & Craig, Inc.
CONSULTING ENGINEERS • SURVEYORS
101 TRUMP STREET, S.W.
ROANOKE, VIRGINIA 24018
(800) 544-0044
(540) 945-7001 FAX

NO.	BY	DATE	REVISIONS	REMARKS
1	WTA	10/7/98	REPOSITIONED VFD ENCLOSURE	
2	ARB	JAN. 2000	RECORD DRAWING	

DES NAB,GPH
DWN ARB,LDL
CKD GPH,SAC



CITY OF ROANOKE, VIRGINIA
**WATER POLLUTION
CONTROL PLANT
UPGRADE AND EXPANSION**

BAF INFLUENT PUMP STATION

SECTIONS AND DETAILS
SCALE: AS SHOWN

DATE MAY, 1997
SHEET 22 OF 44
CAD REF. NO. S22.DWG