

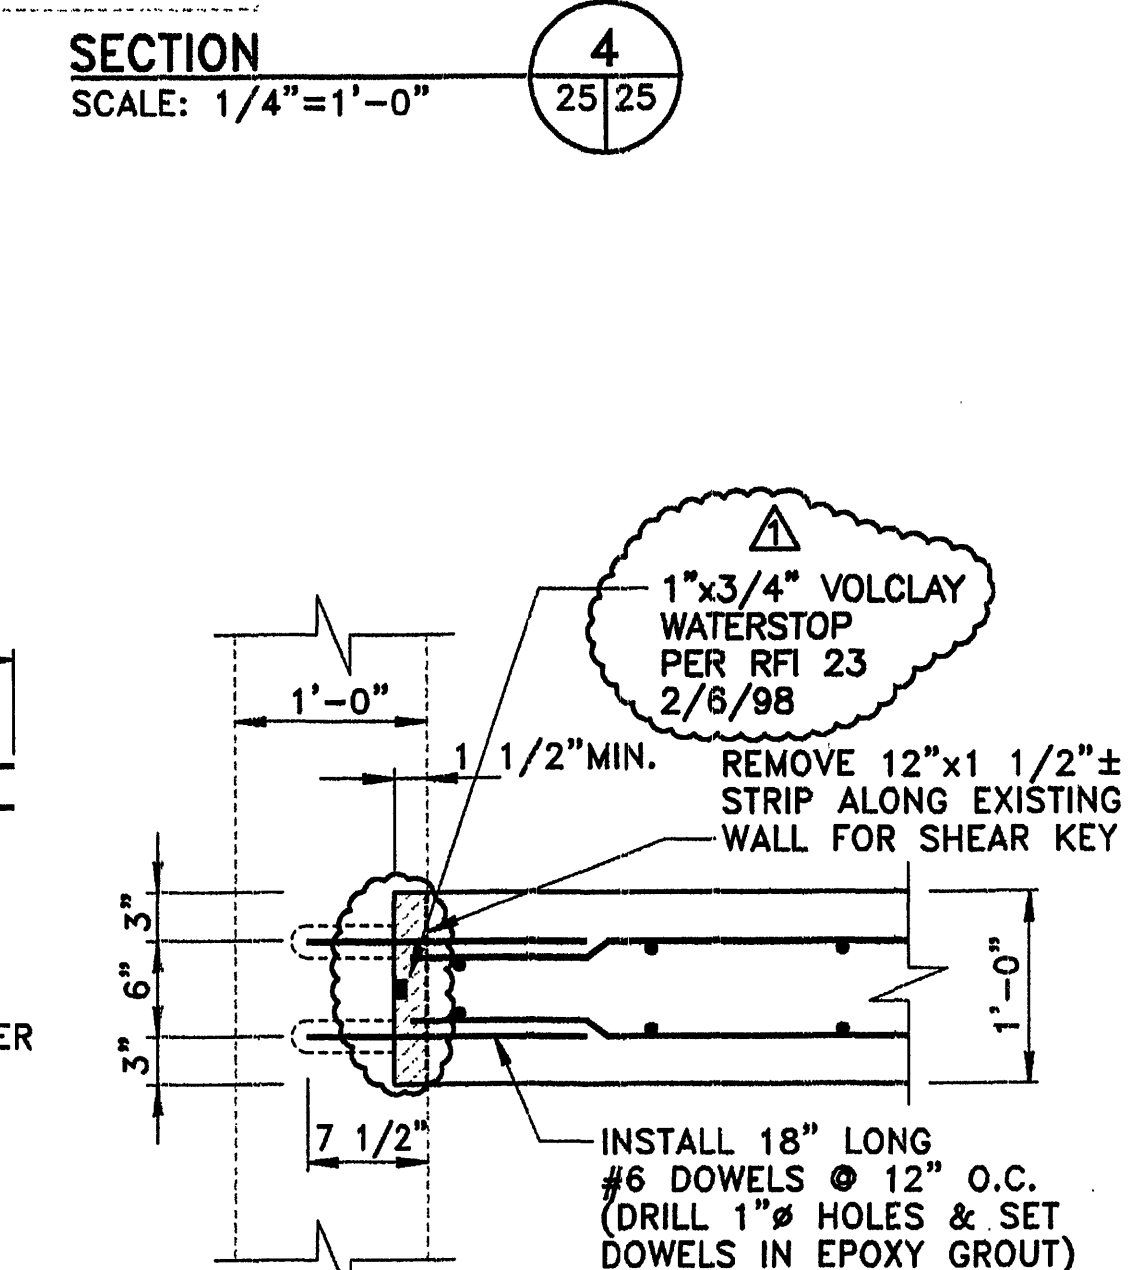
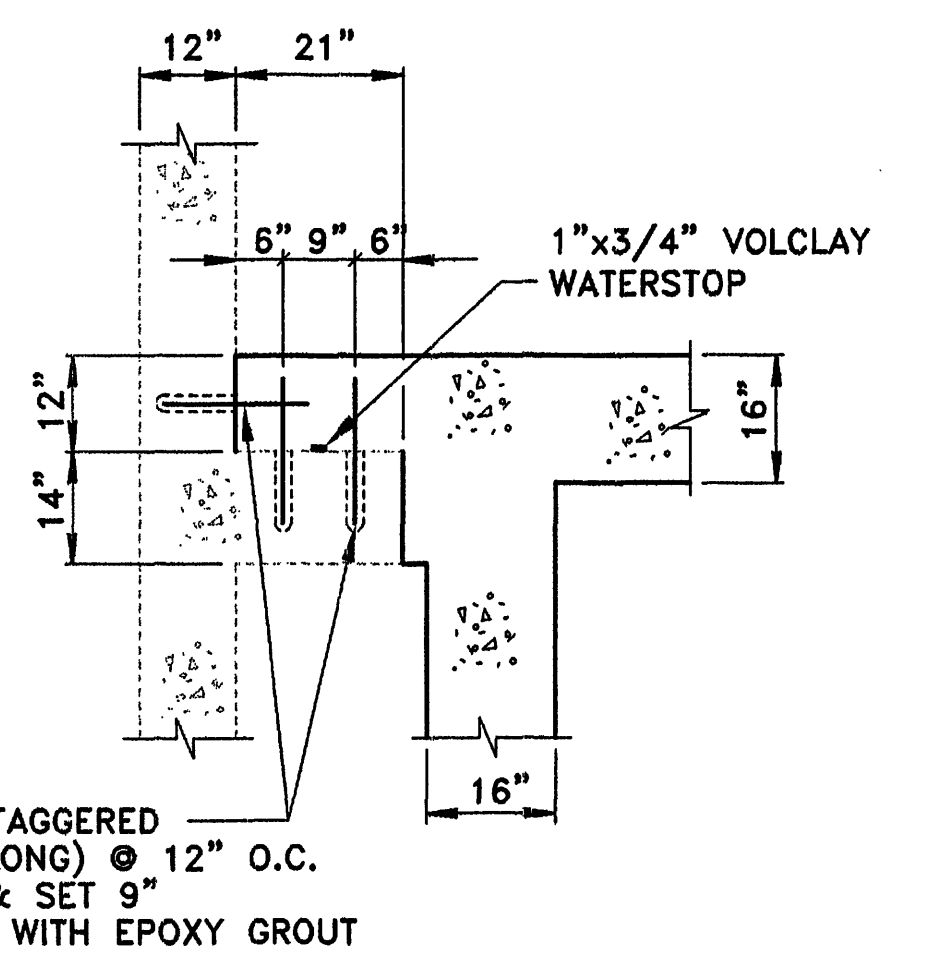
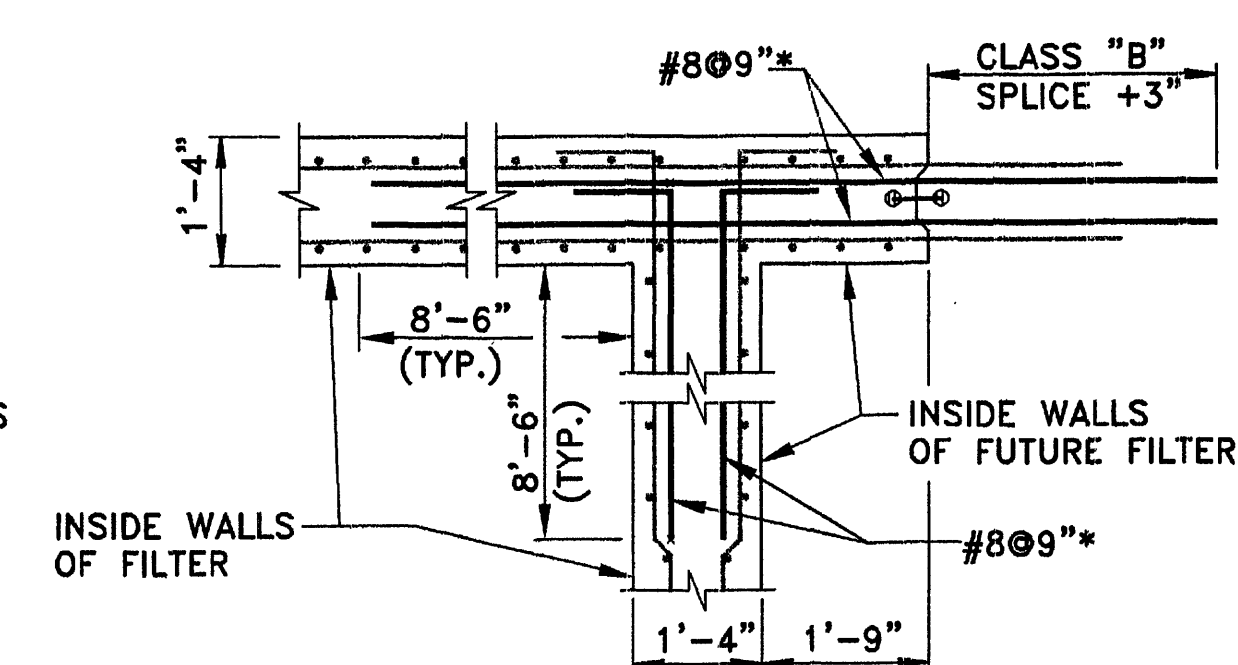
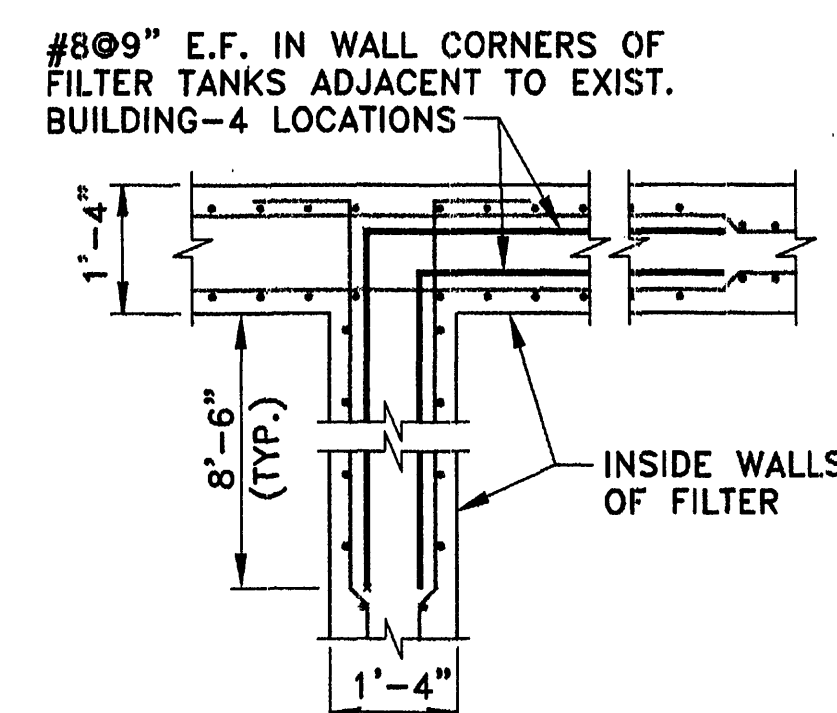
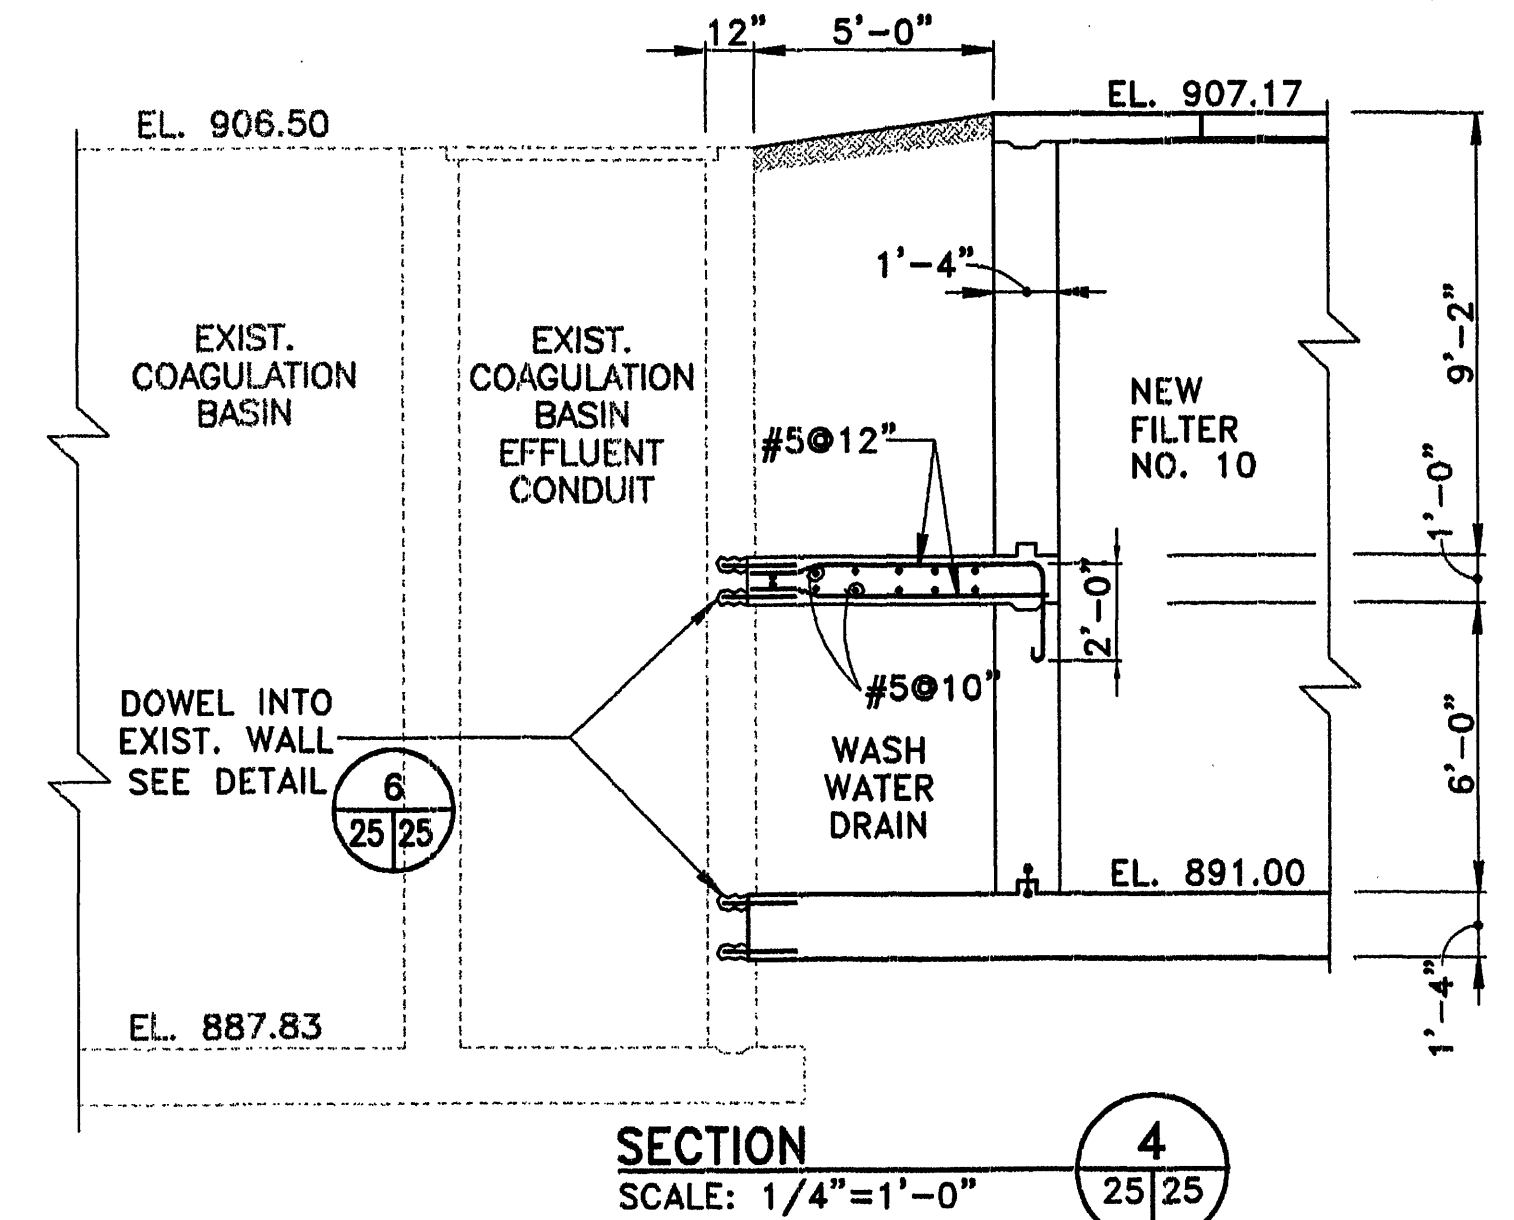
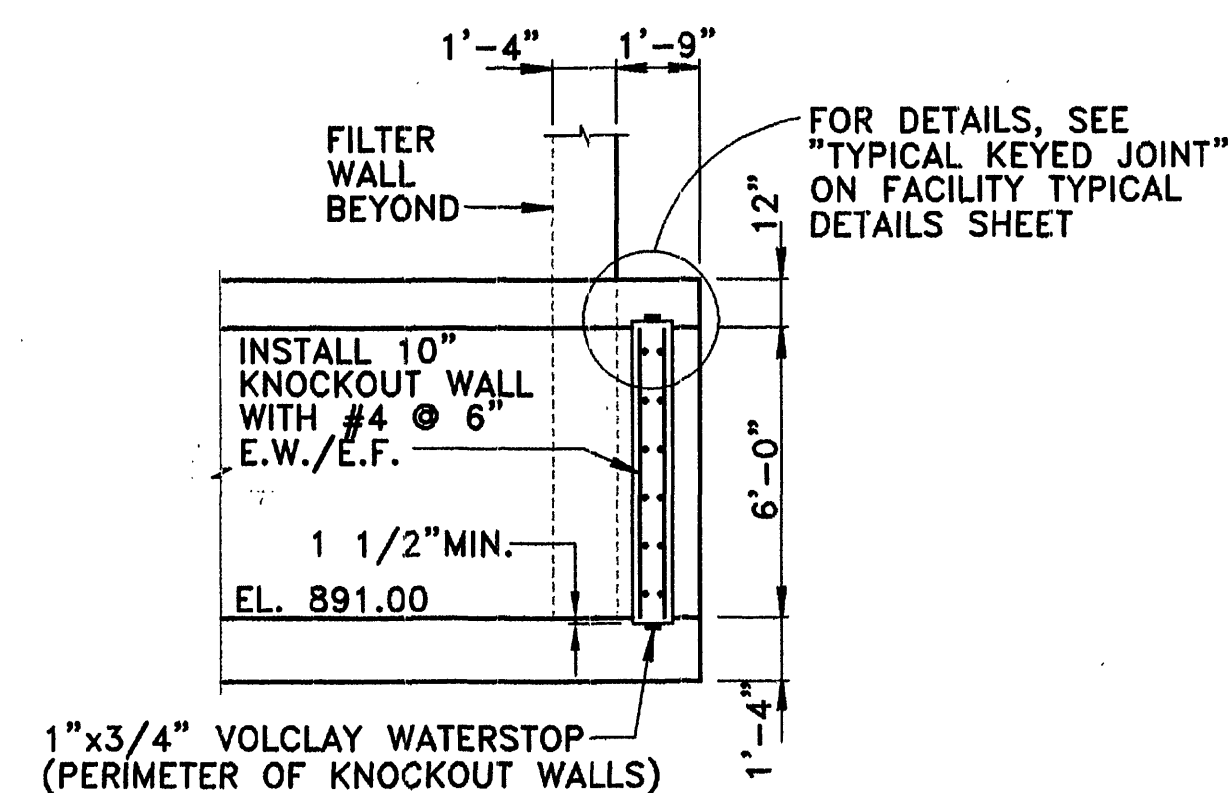
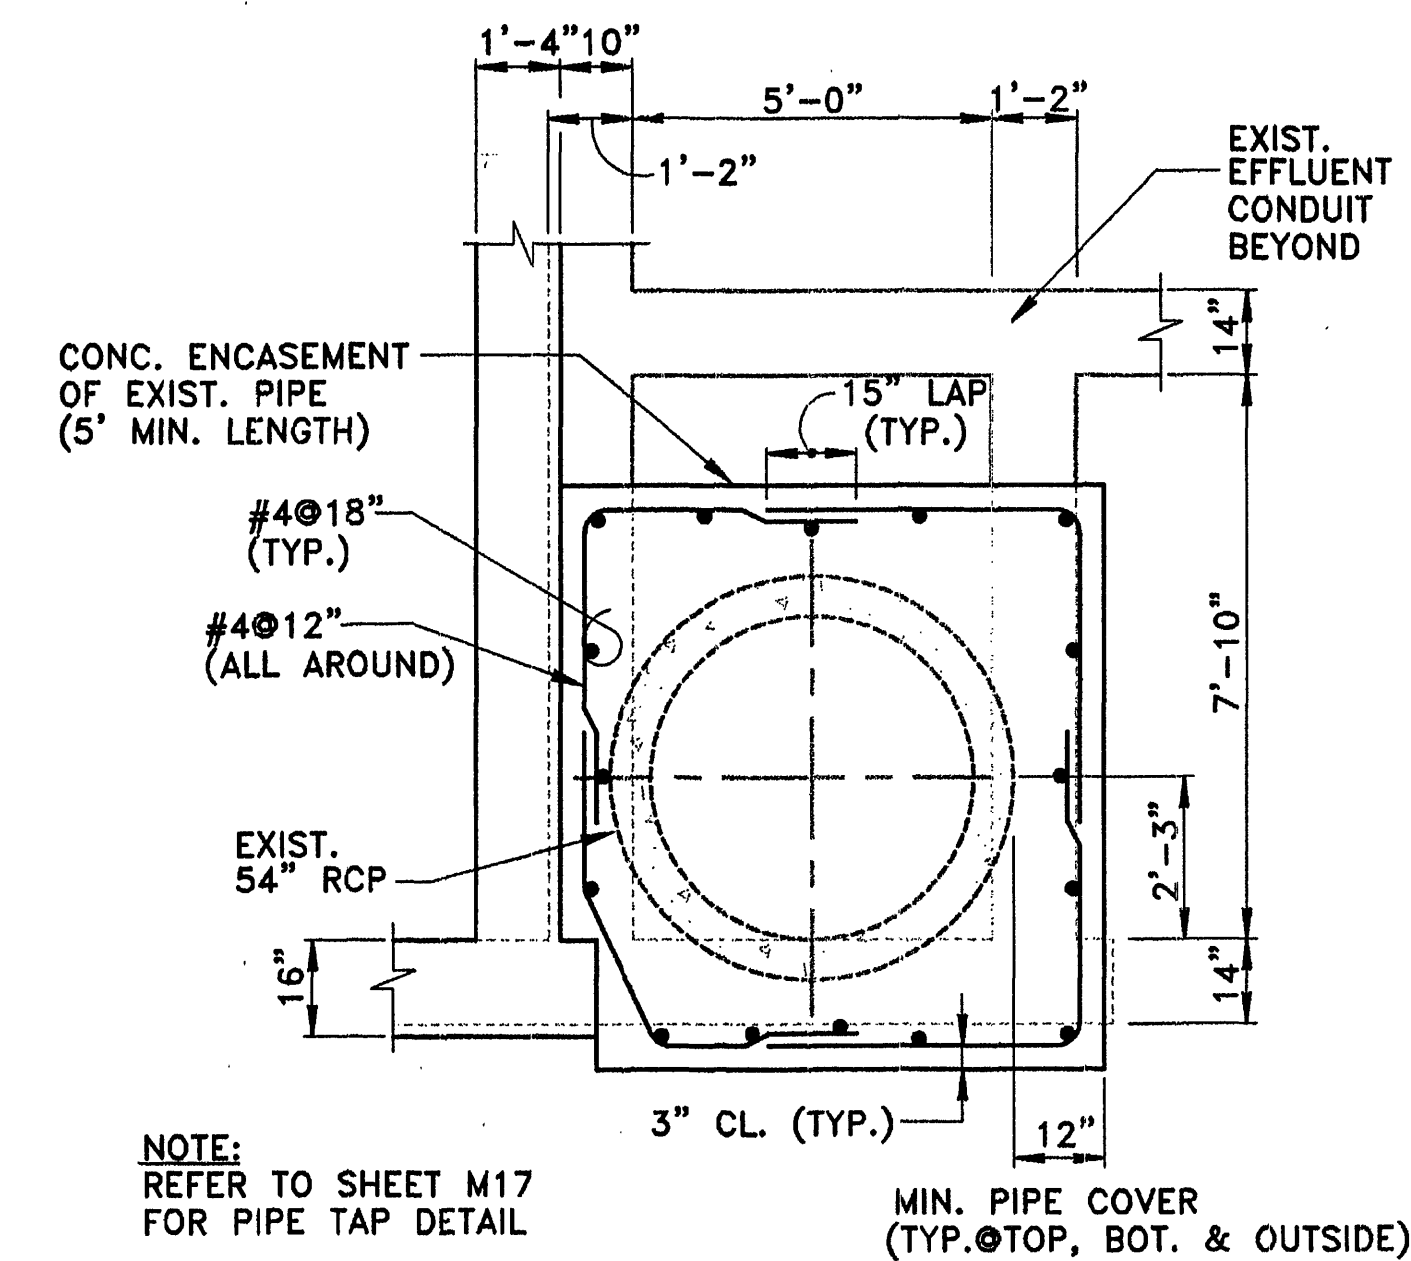
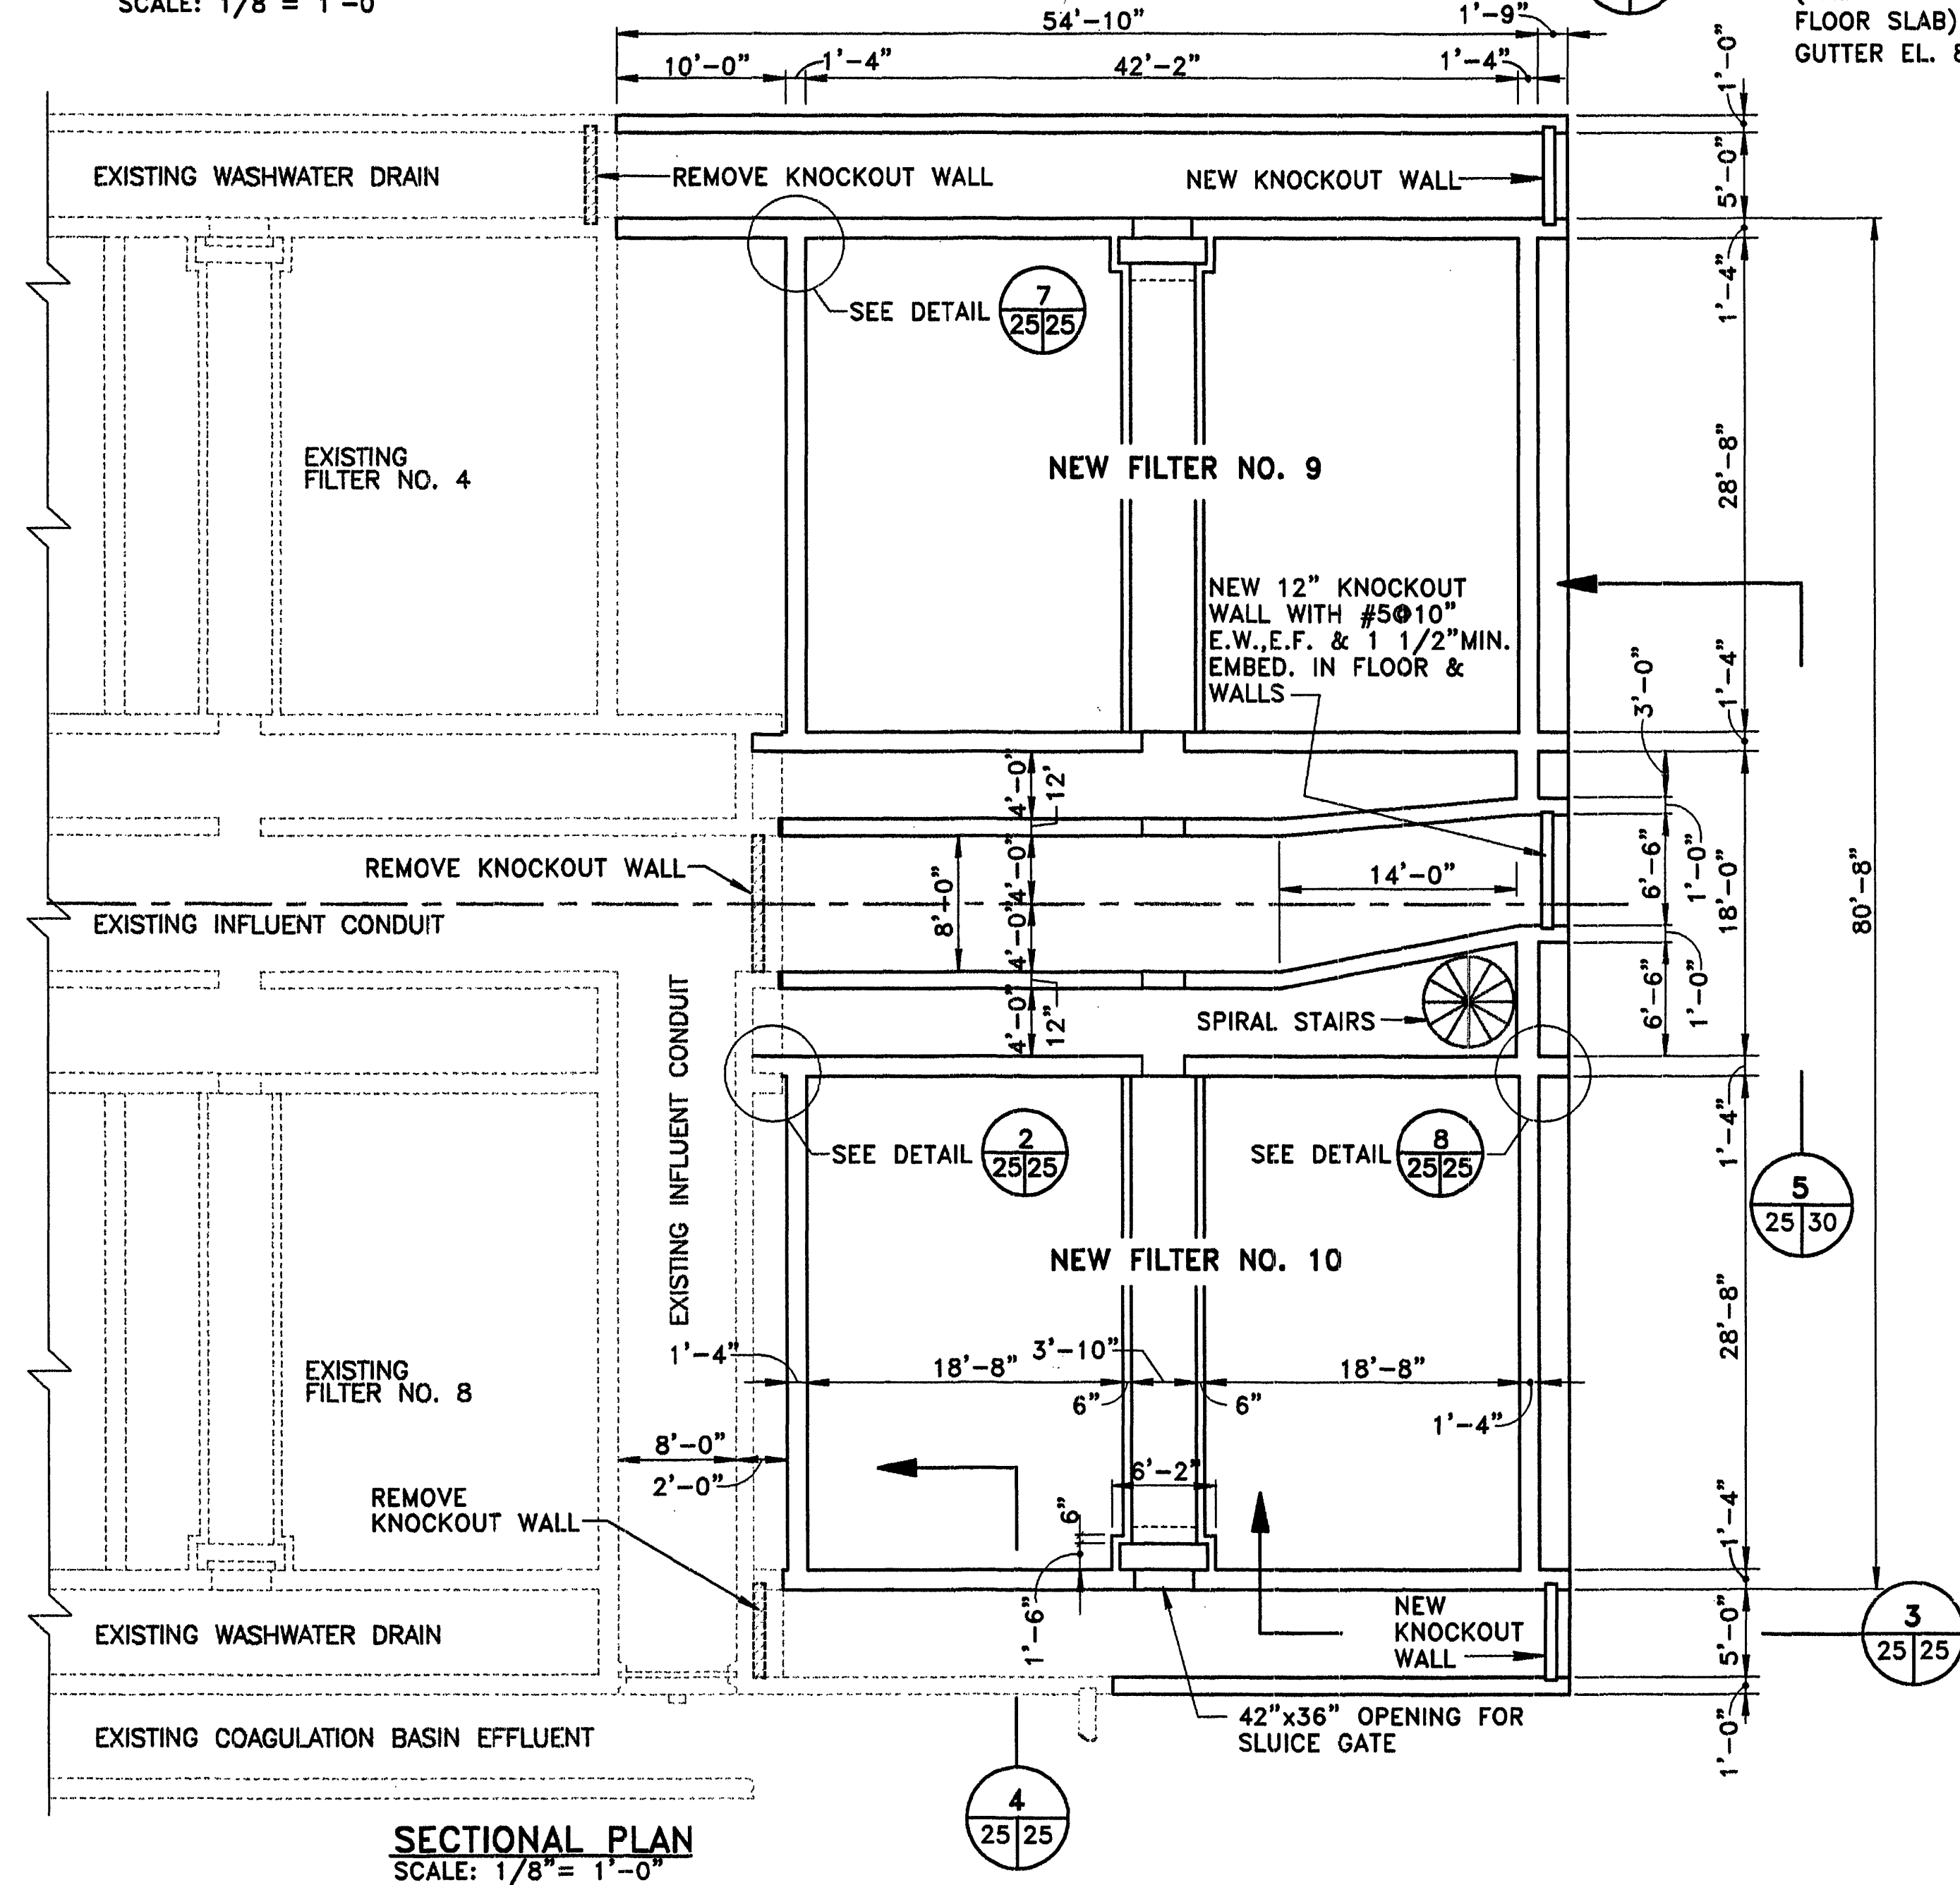
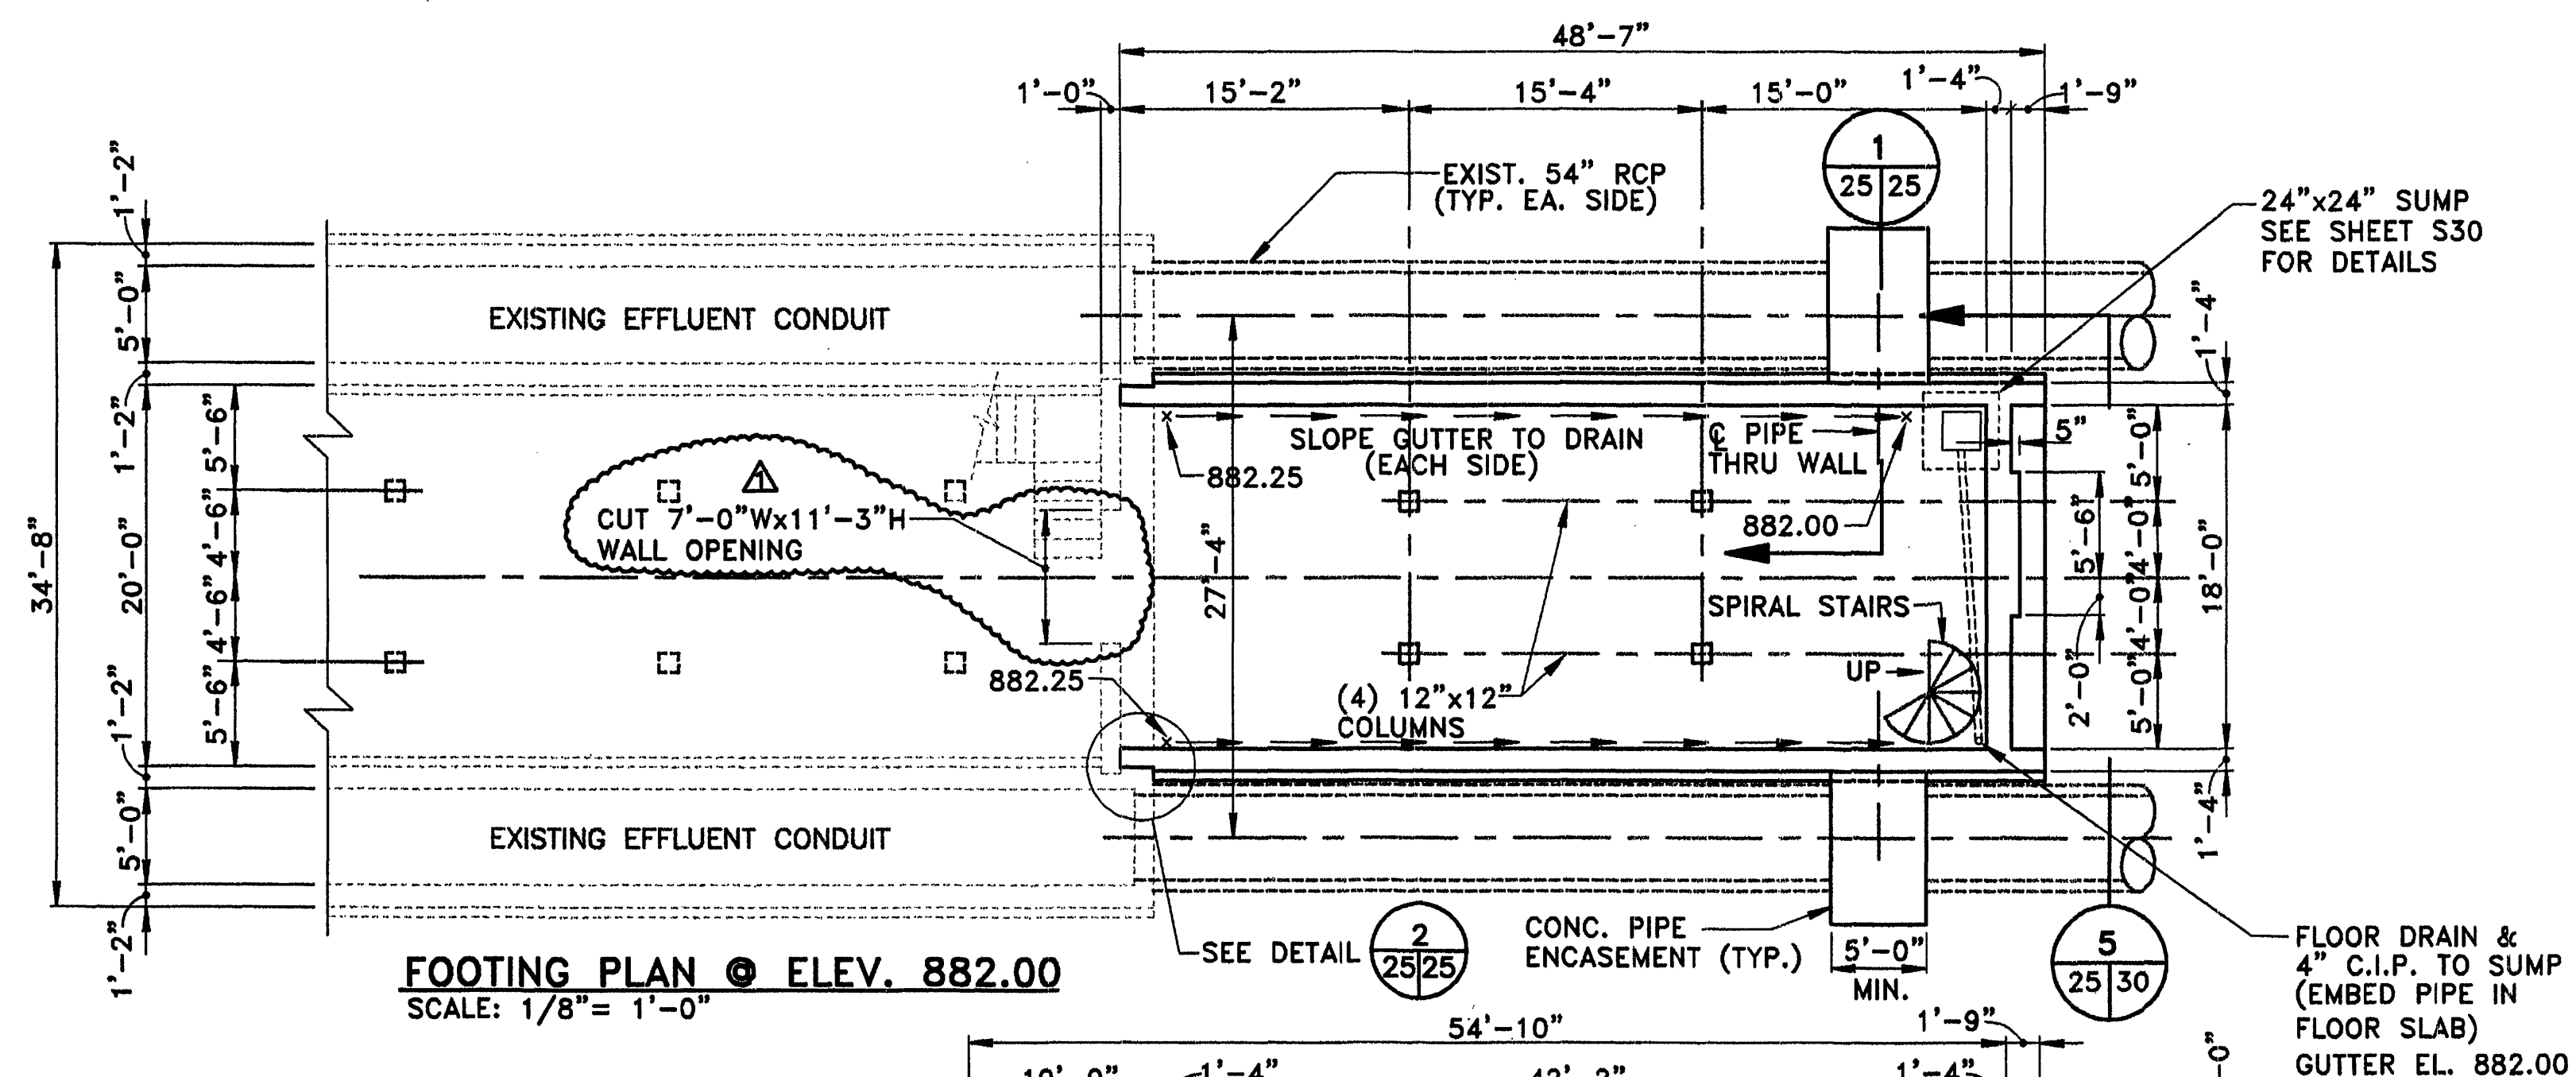


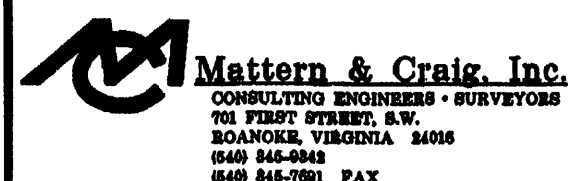

NOTE:
ALL REINFORCING STEEL SHALL BE 2" CLEAR OF
CONCRETE SURFACE UNLESS OTHERWISE NOTED.

[illegible]

DES	NAB ₂ GPH
DWN	ARB,LDL
CKD	GPH,SAC

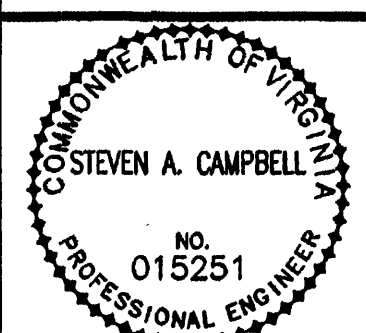

CITY OF ROANOKE, VIRGINIA
WATER POLLUTION
CONTROL PLANT
UPGRADE AND EXPANSION

EFFLUENT FILTERS
PLAN
DETAILS AND SECTIONS
SCALE: AS SHOWN

DATE MAY, 1997
SHEET 25 OF 44
CAD REF. NO. S25.DWG