


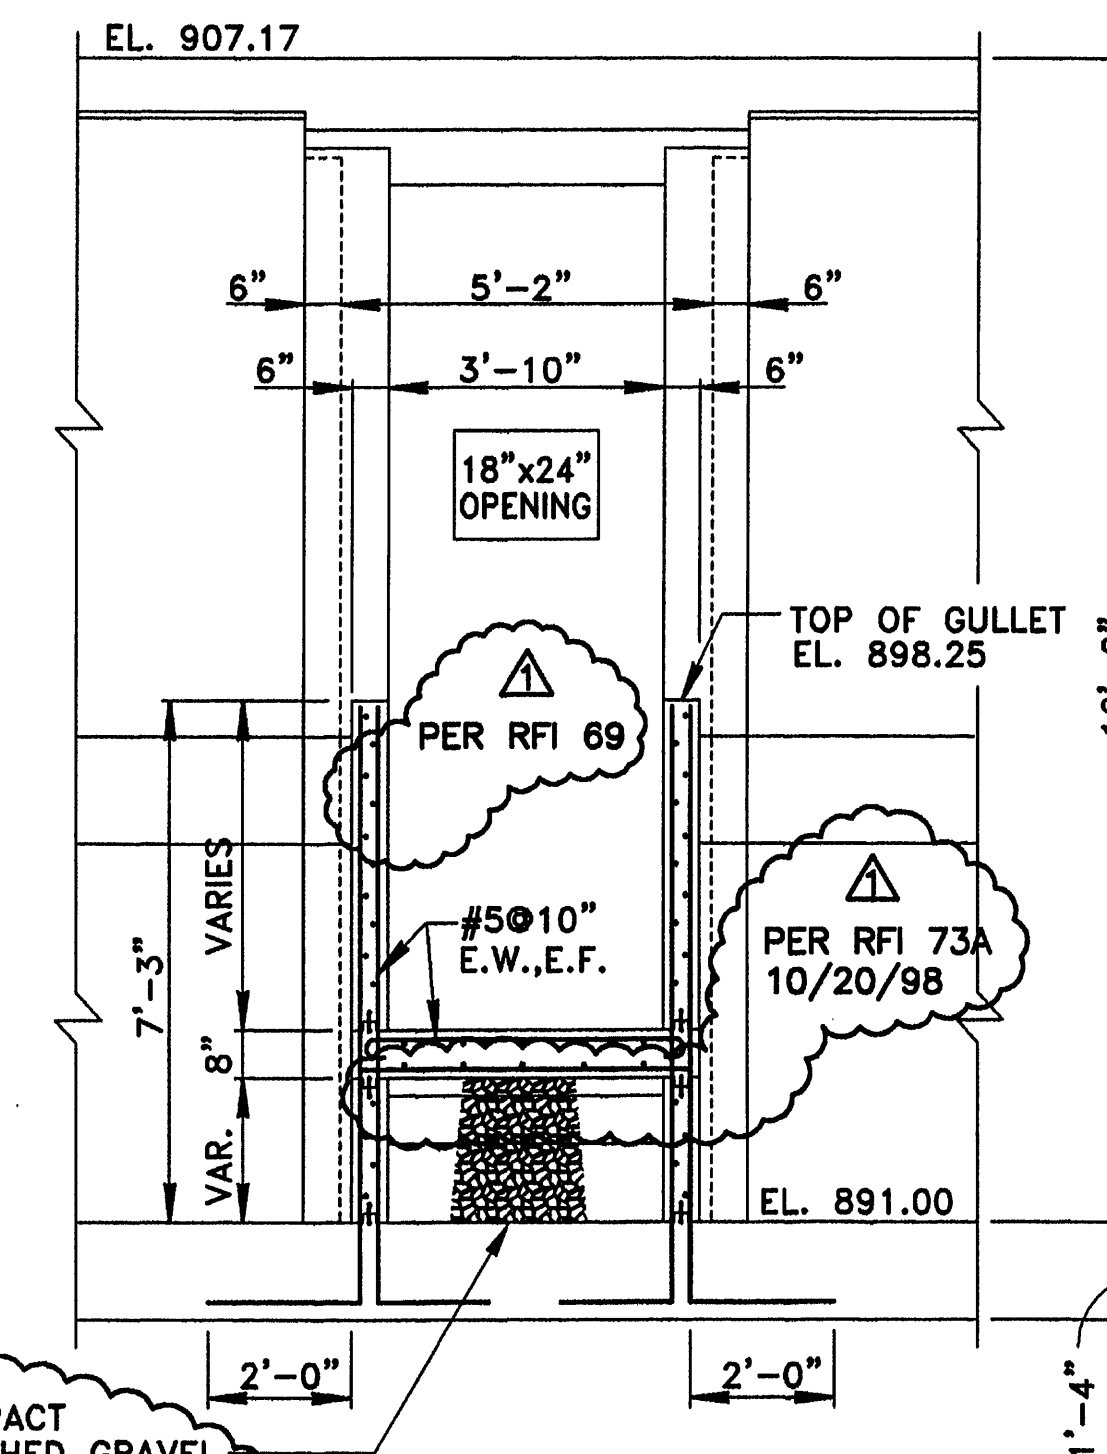

PER RFI 73
6/11/98

COMPACT
CRUSHED GRAVEL
(TYP.)

2'-0"

2'-0"

SECTION

SCALE: $\frac{3}{8}" = 1'-0"$

5
2925

