




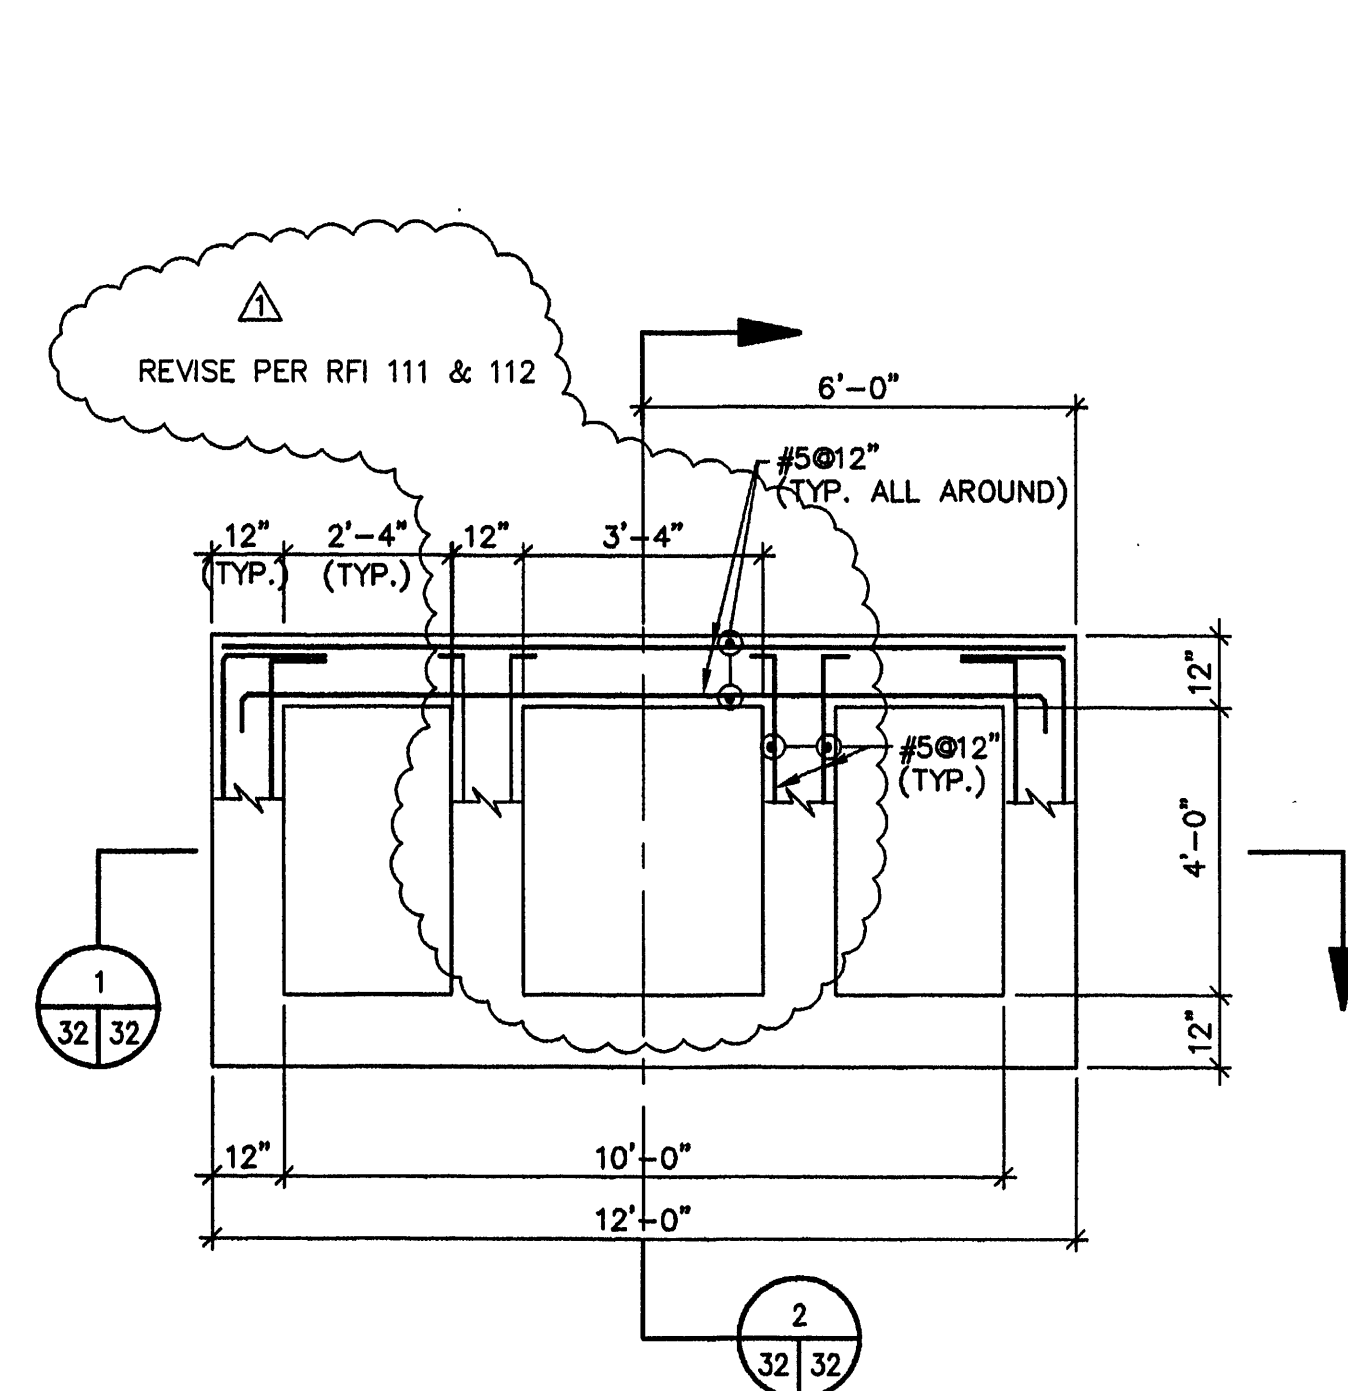


PLAN AT EL. 900.00

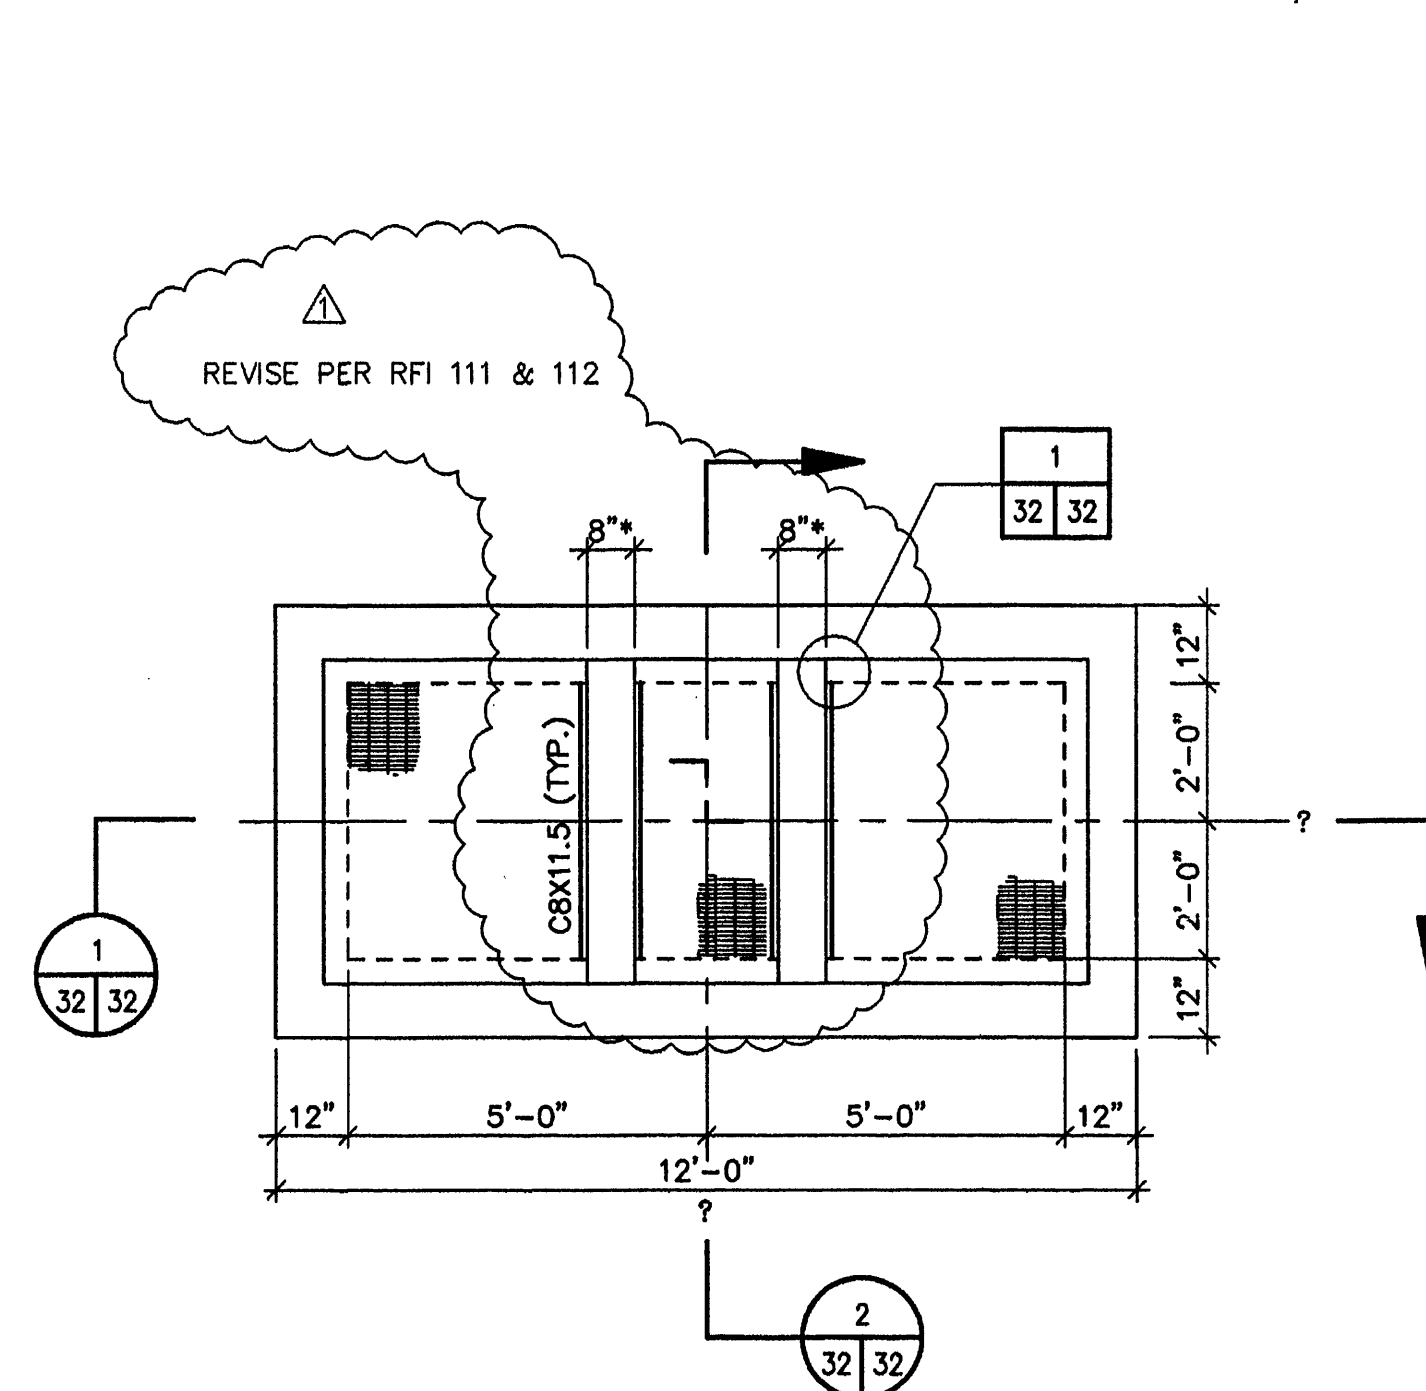


PLAN AT EL. 905.00

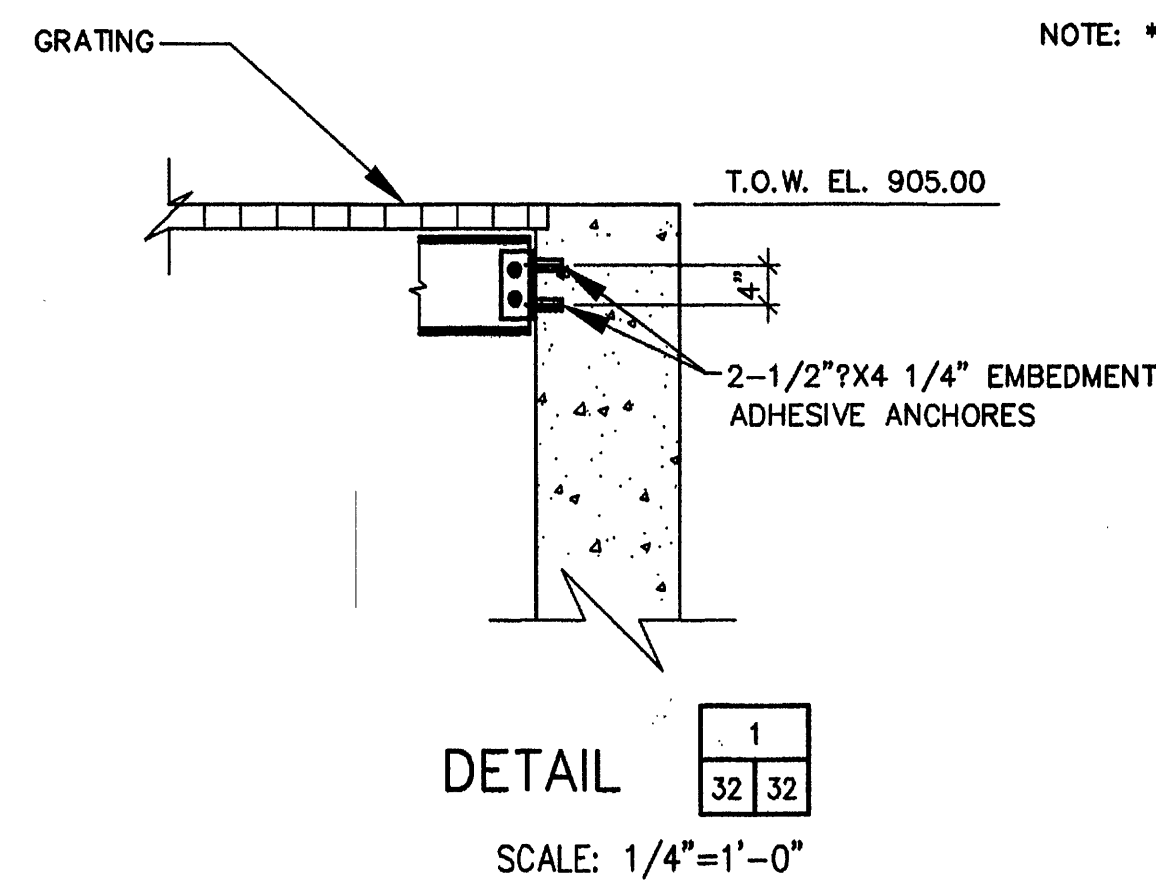

DETAIL
SCALE: 1/4"=1'-0"

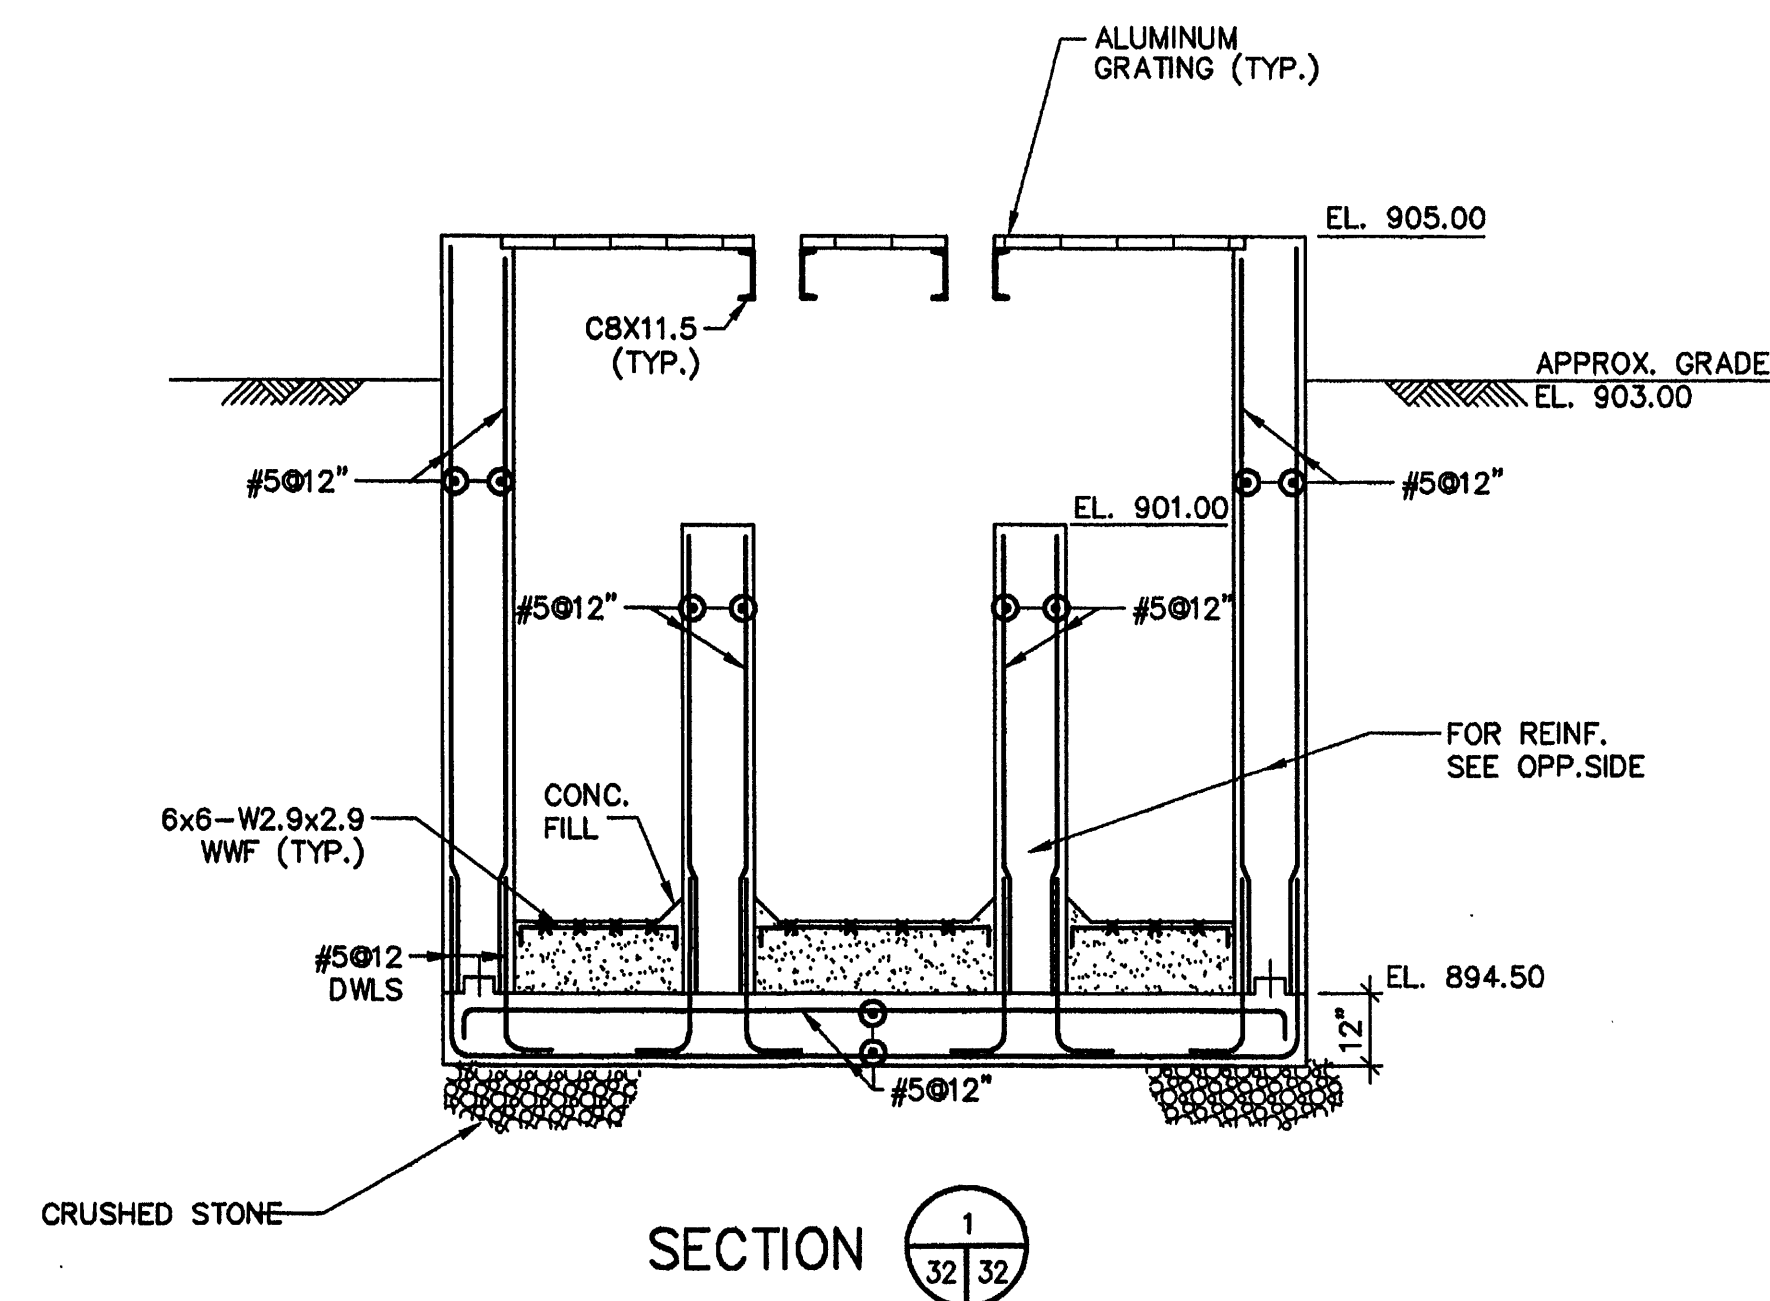


SECTION 1
32 32

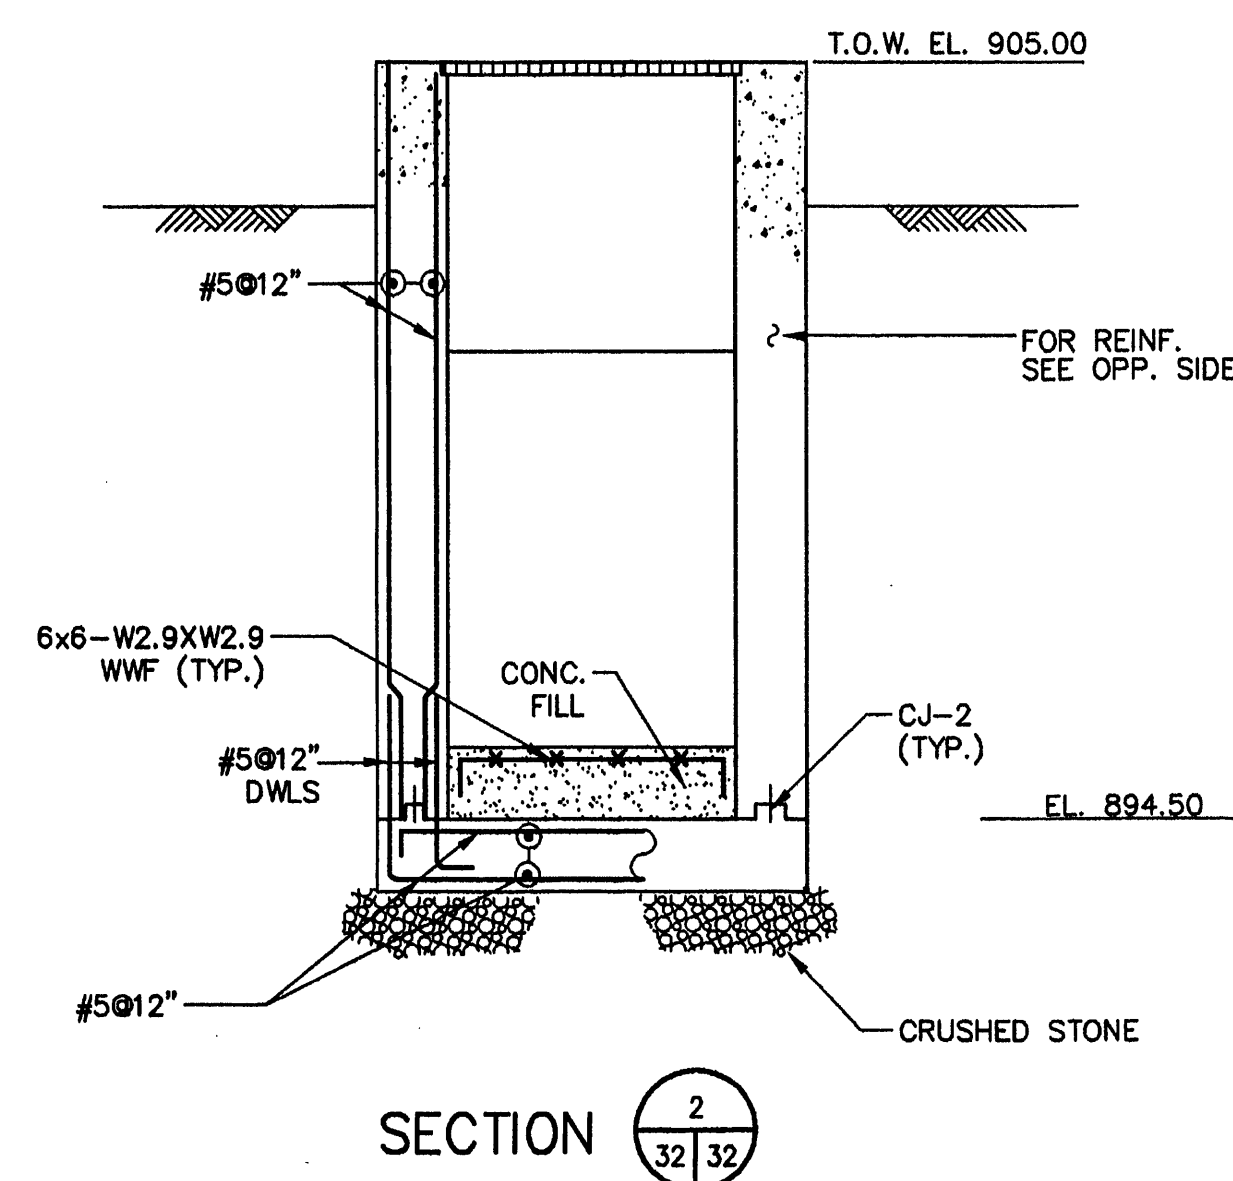


SECTION 2
32 32

INFLUENT DISTRIBUTION CHAMBER

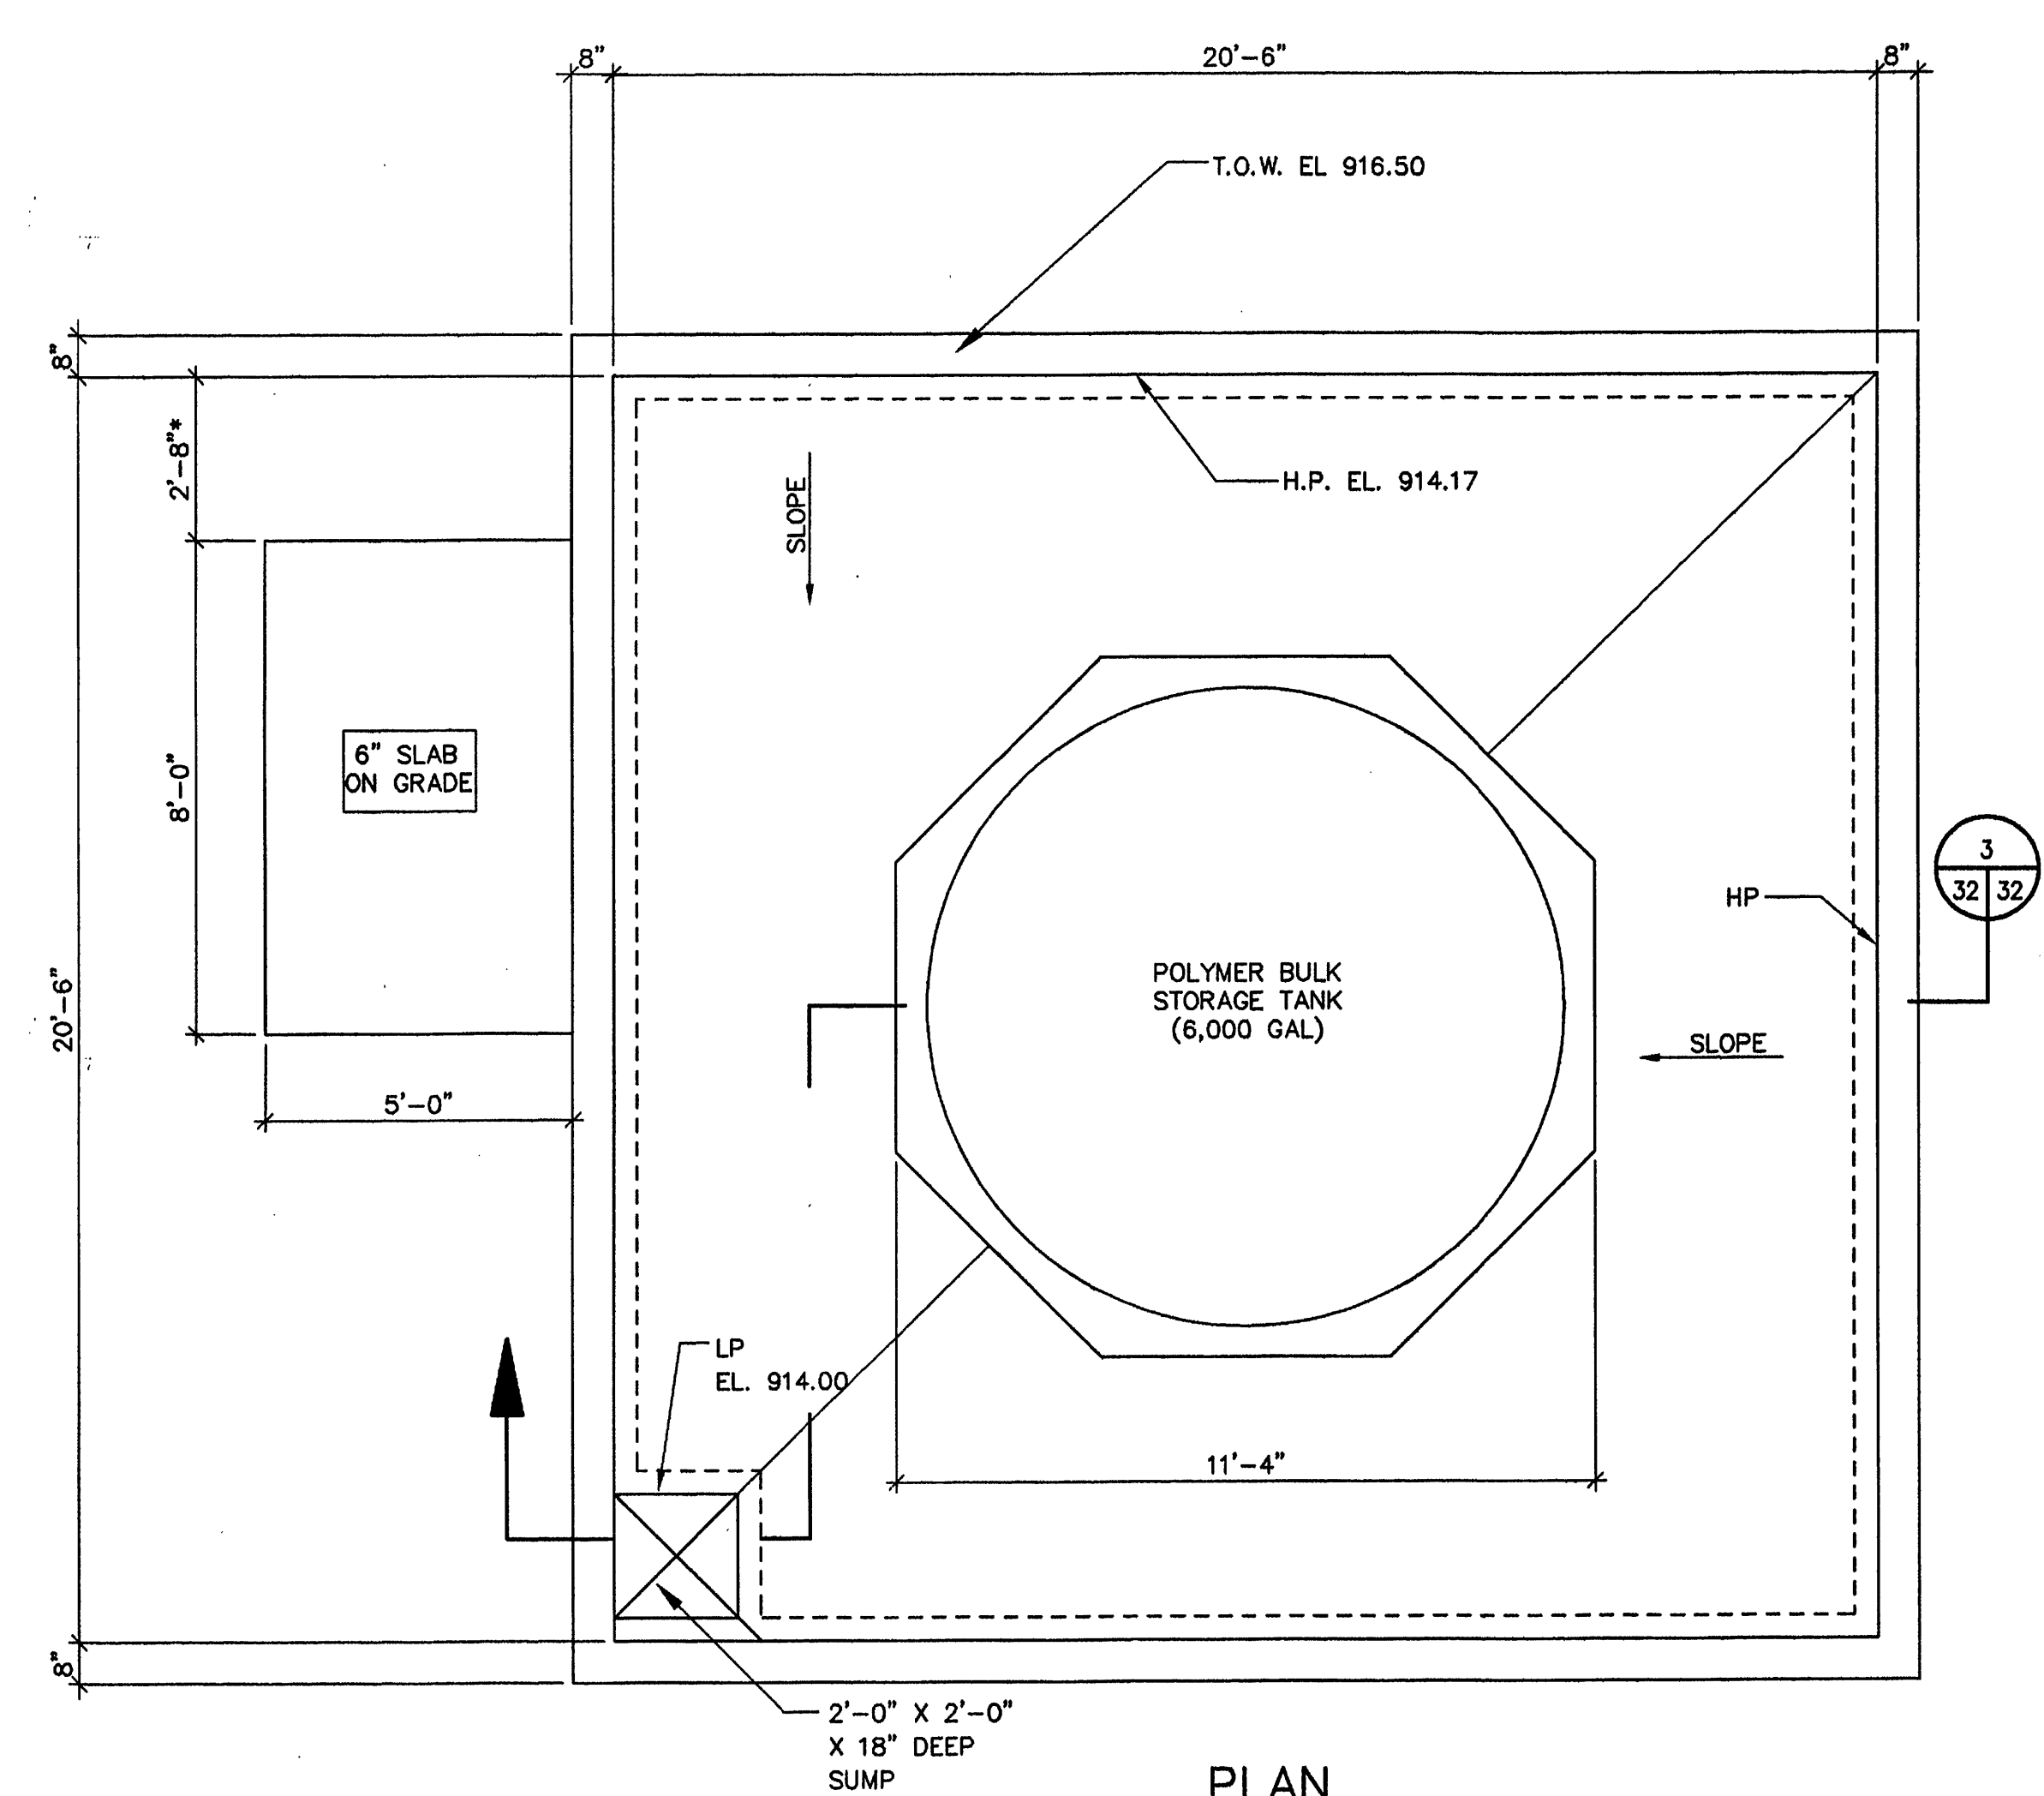

PLAN

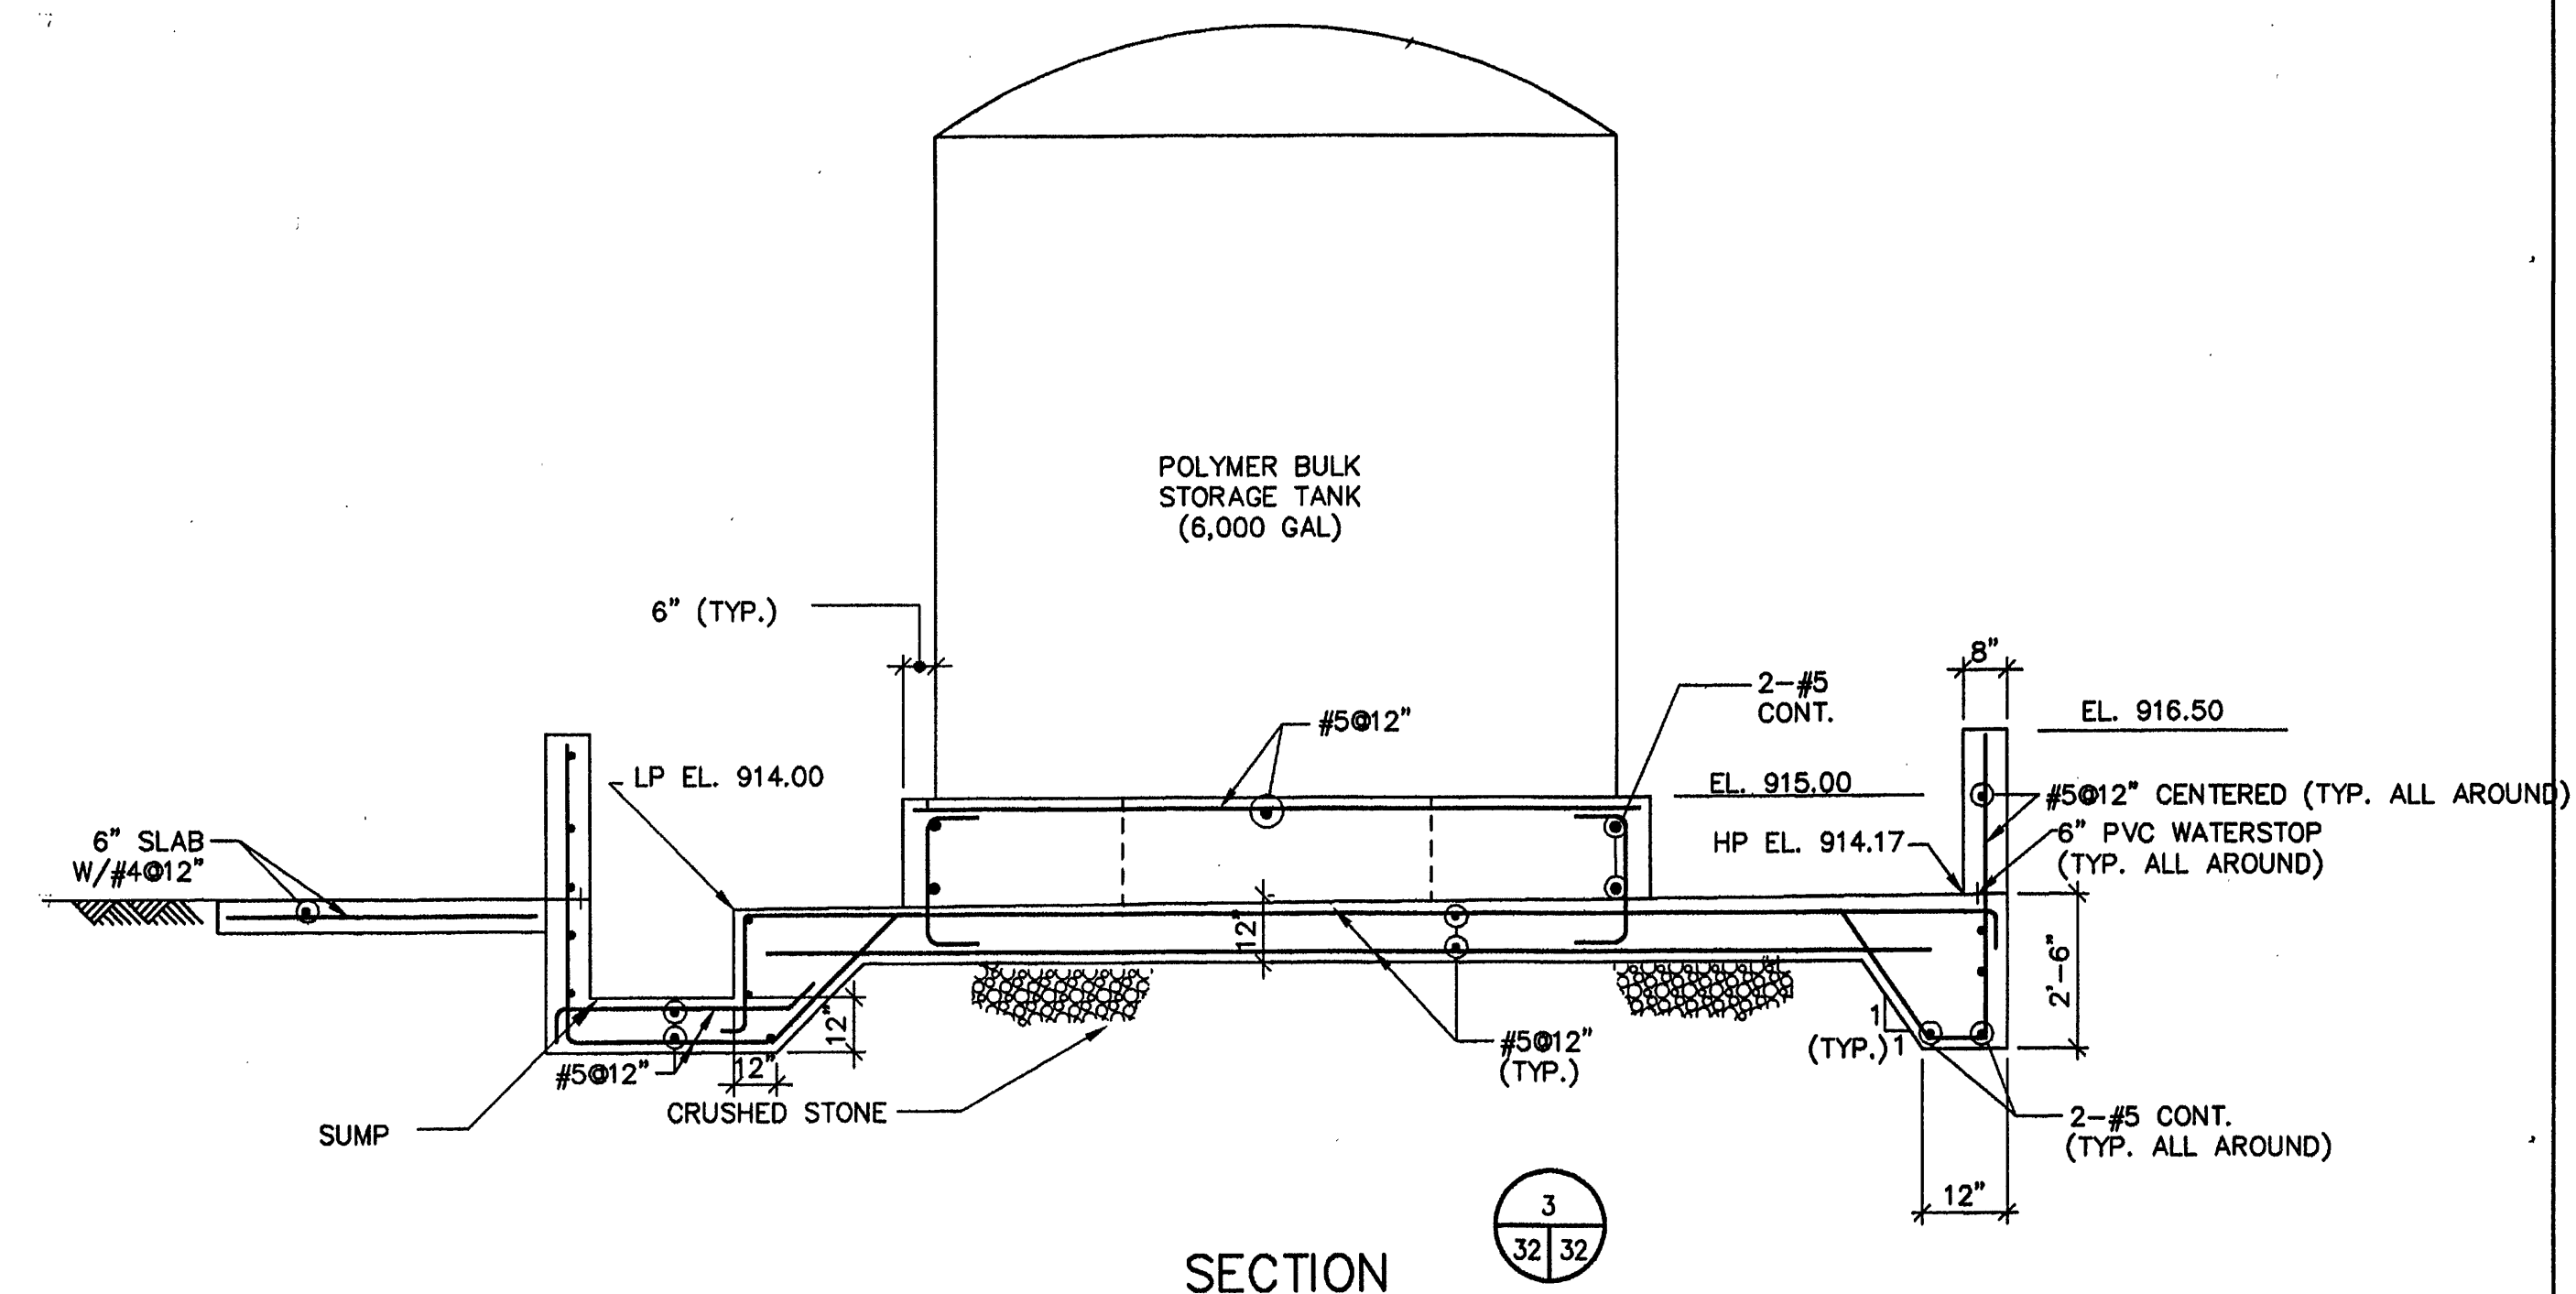

SECTION
32 32

POLYMER CONTAINMENT STRUCTURE

**MALCOLM
PIRNIE**
11832 Rock Landing Drive, Suite 400
Newport News, Virginia 23606

REVISIONS			
NO.	BY	DATE	REMARKS
1	ARB	JAN. 2000	RECORD DRAWING

DES --- EDC ---
OWN --- EDC ---
CKD --- HLC ---



CITY OF ROANOKE, VIRGINIA
**WATER POLLUTION
CONTROL PLANT
UPGRADE AND EXPANSION**

INFL. DISTR. CHAMBER & POLYMER STRUCTURE

PLANS AND SECTIONS

SCALE: 3/8" = 1'-0"

COPYRIGHT © 1997
MALCOLM PIRNIE, INC.
DATE --- MAY 1997 ---
S SHEET 32 OF 44 ---
CAD REF. NO. 0060S369 ---