




4873 0060028592 E:\ACAD\PROJ\00600285\00600373 Scale: 1:1 Date: 05/01/1997 Time: 08:43

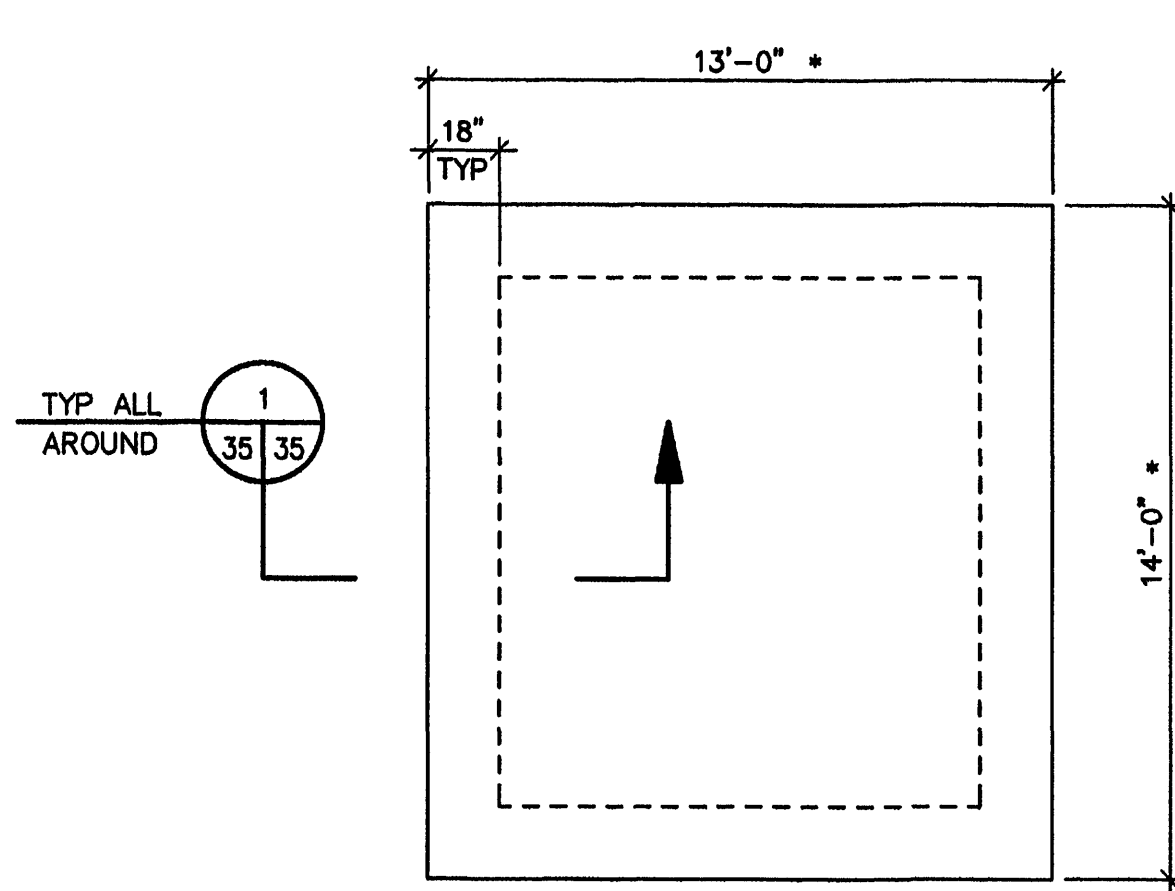


NOTE: ORIENTATION, SEE "E" DWGS.
PLAN
TRANSFORMER PAD (2 REQ'D)
SCALE: 1/4" = 1'-0"

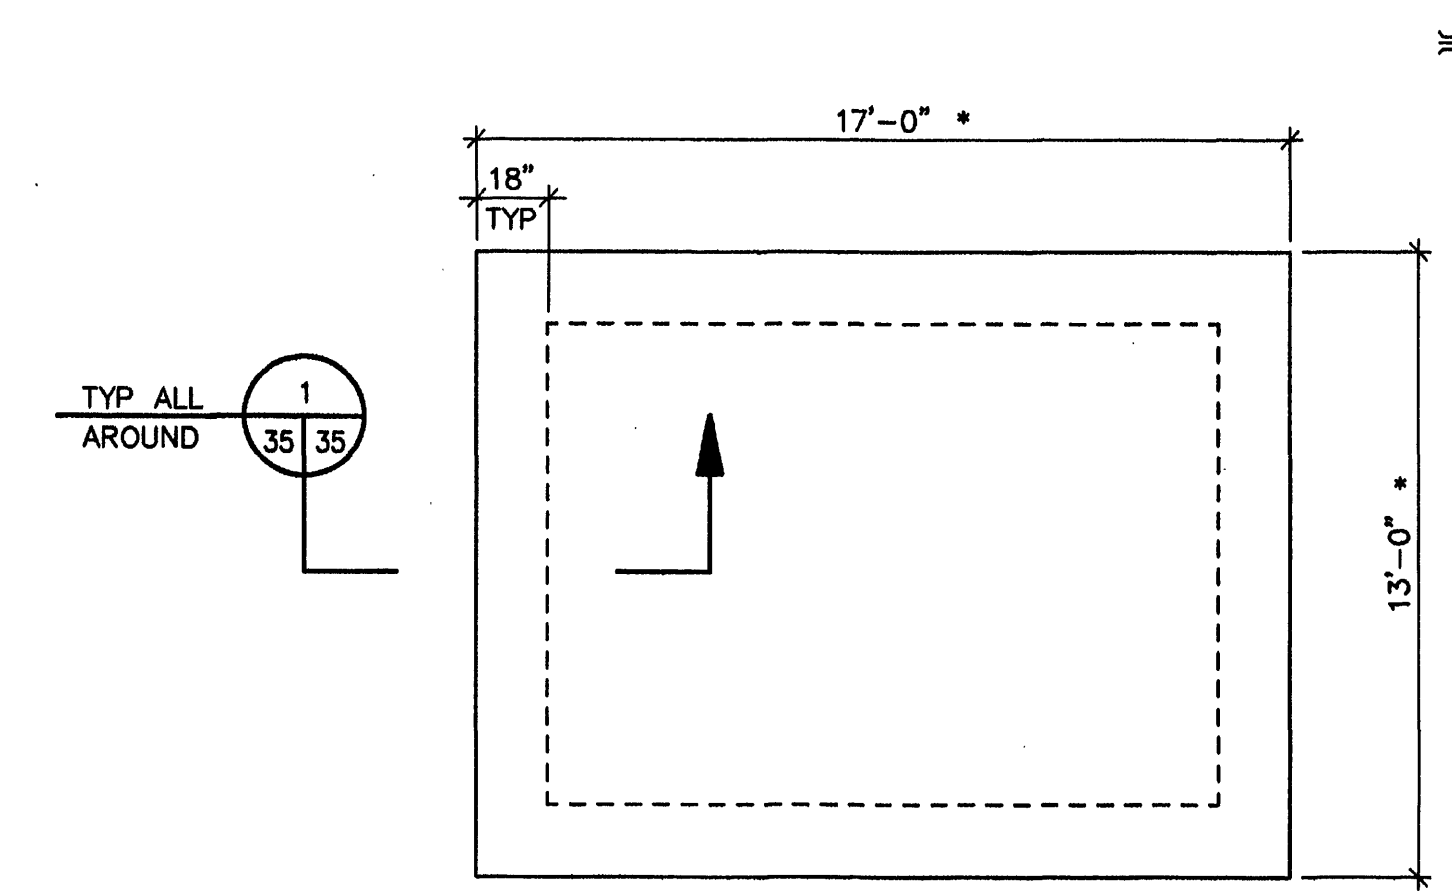


PLAN
SWITCHGEAR SG-2 PAD
SCALE: 1/4" = 1'-0"

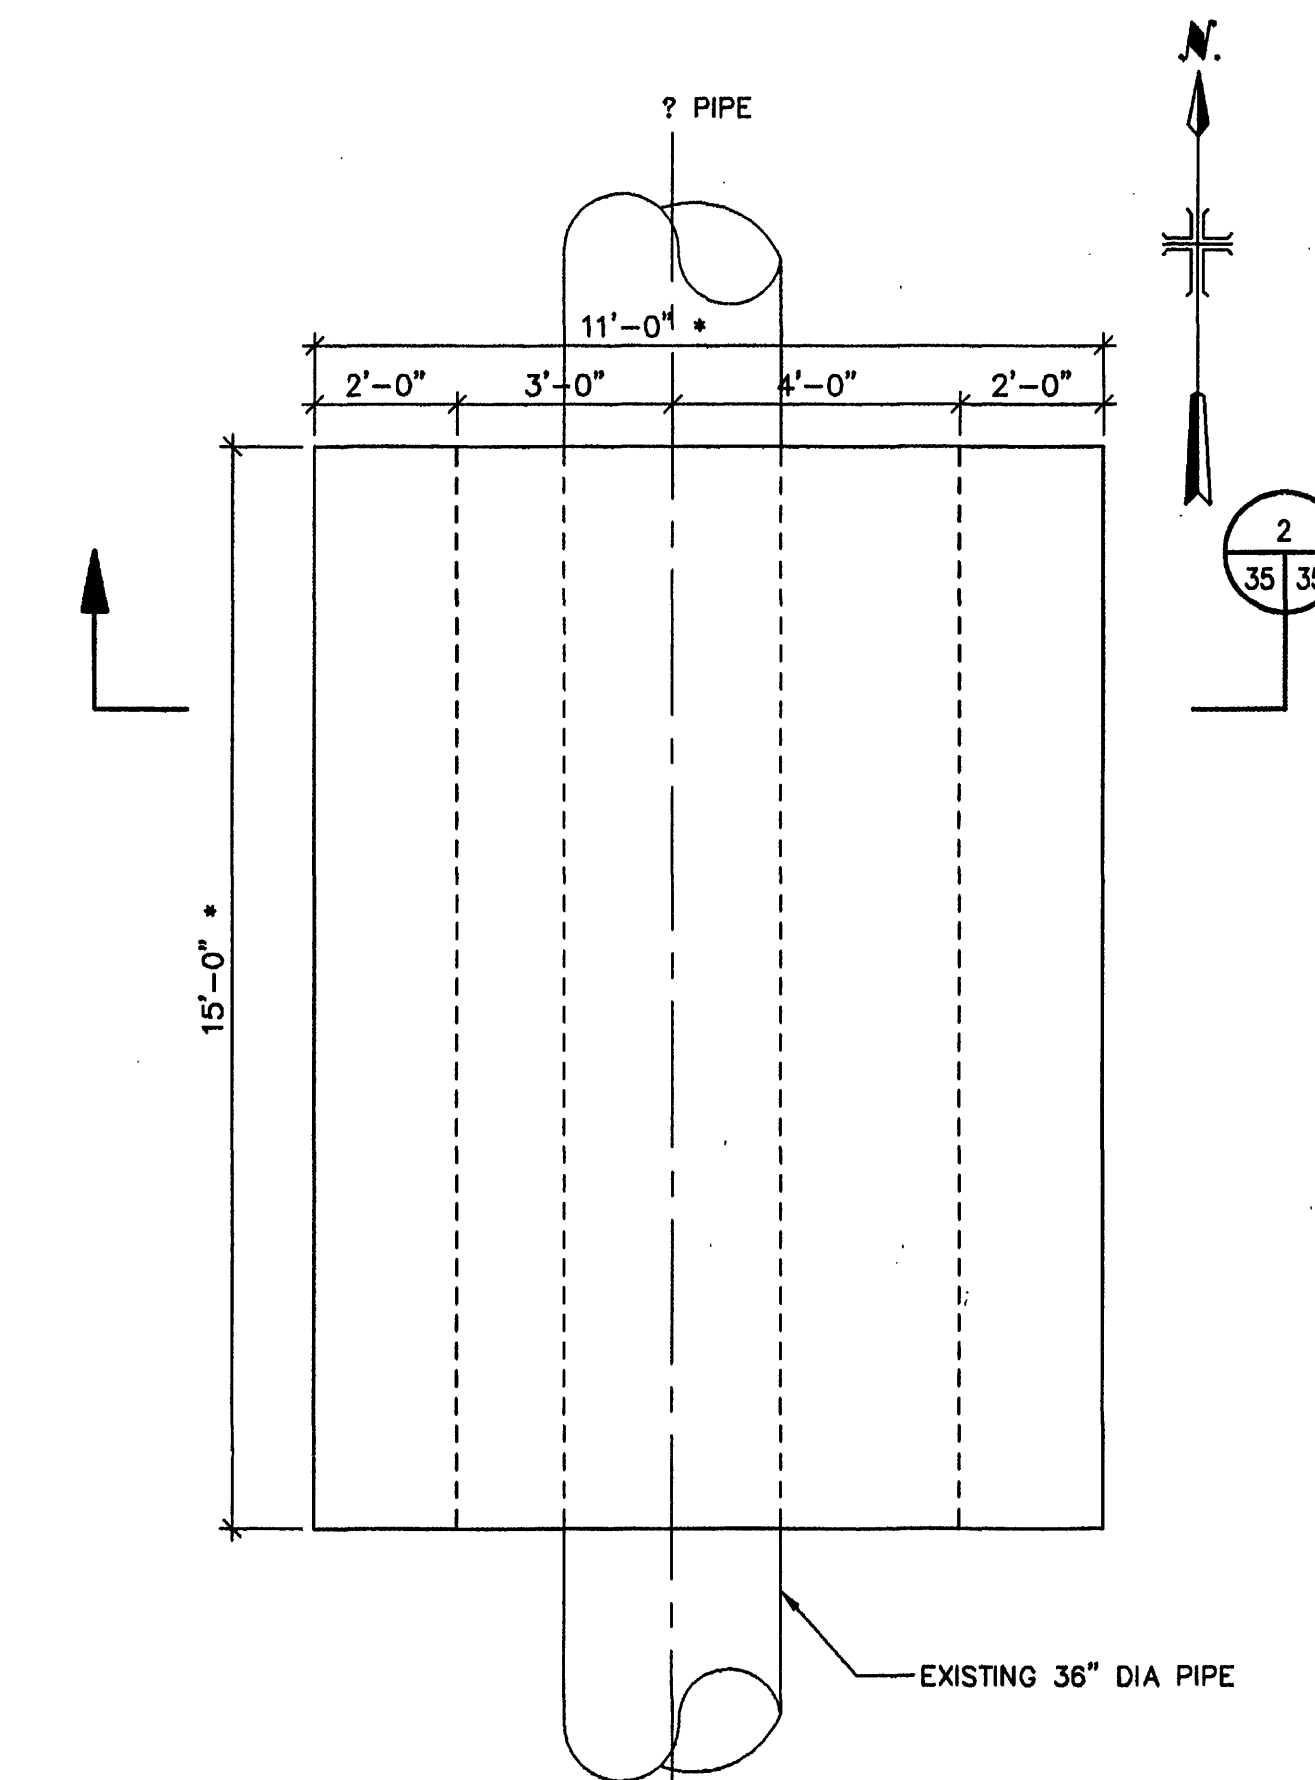


PLAN
SWITCHGEAR SG-3 PAD
SCALE: 3/8" = 1'-0"

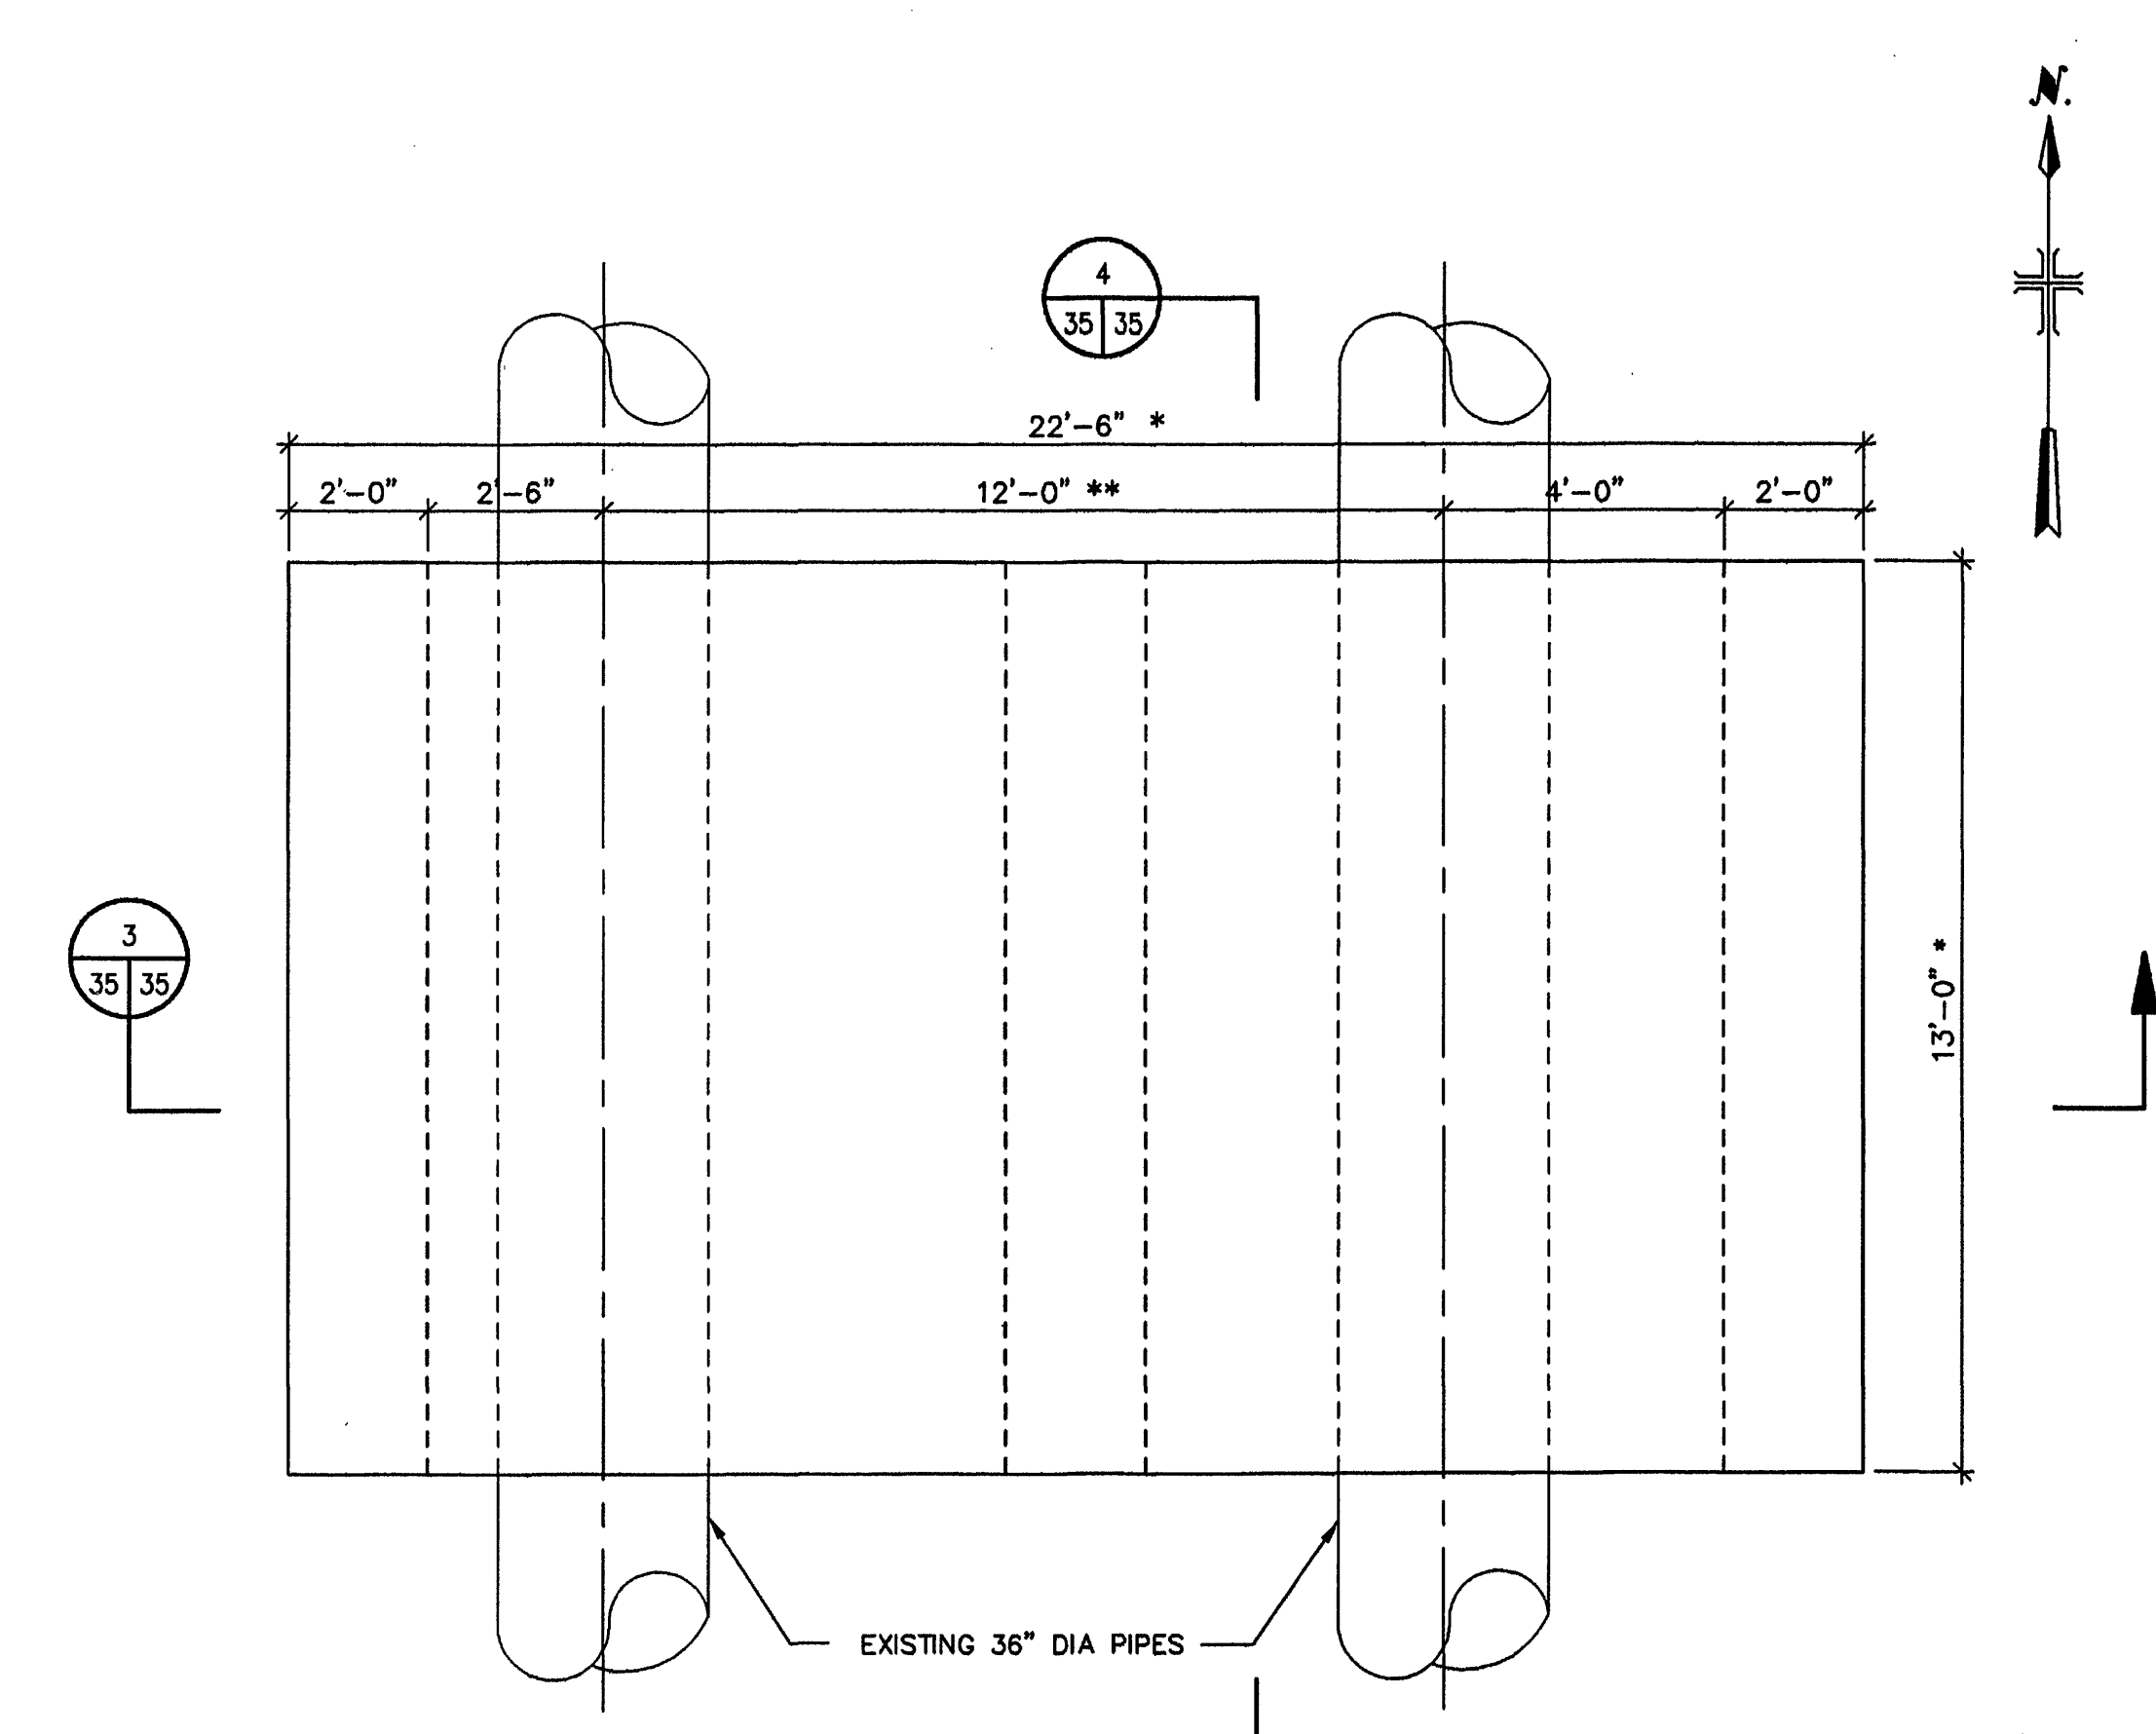


PLAN
PRE-FABRICATED EQUIPMENT ENCLOSURE BUILDING SUPPORT

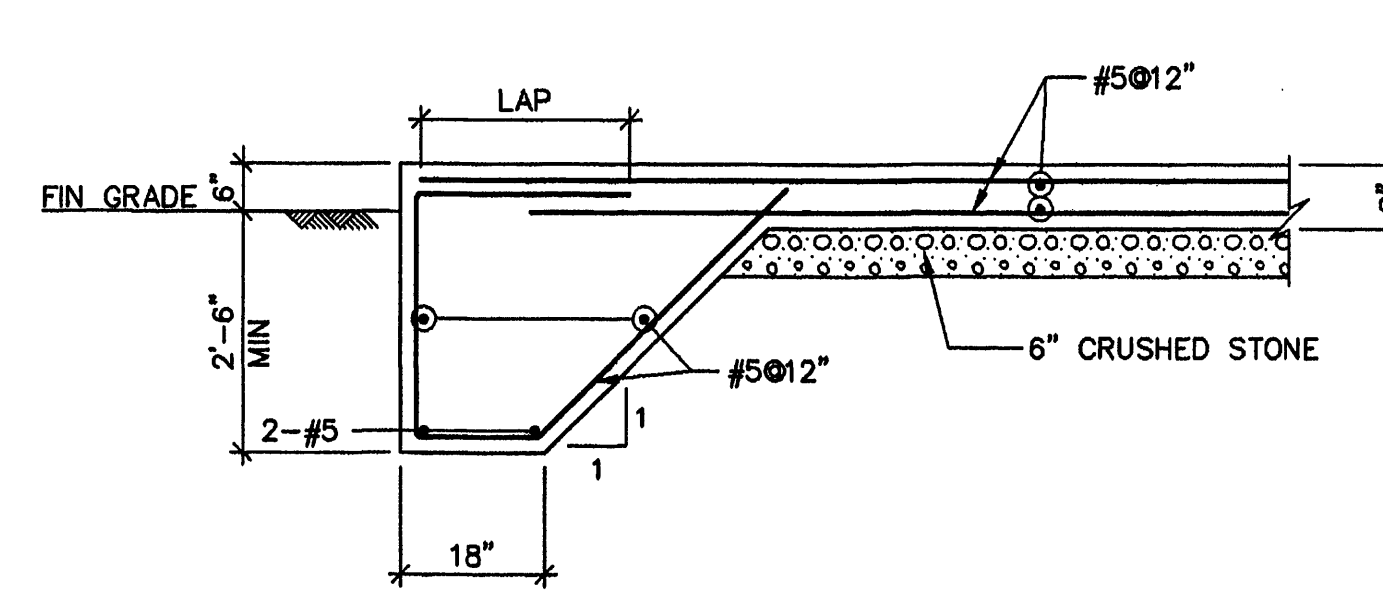


SECTION 1
SCALE: 1/2" = 1'-0"

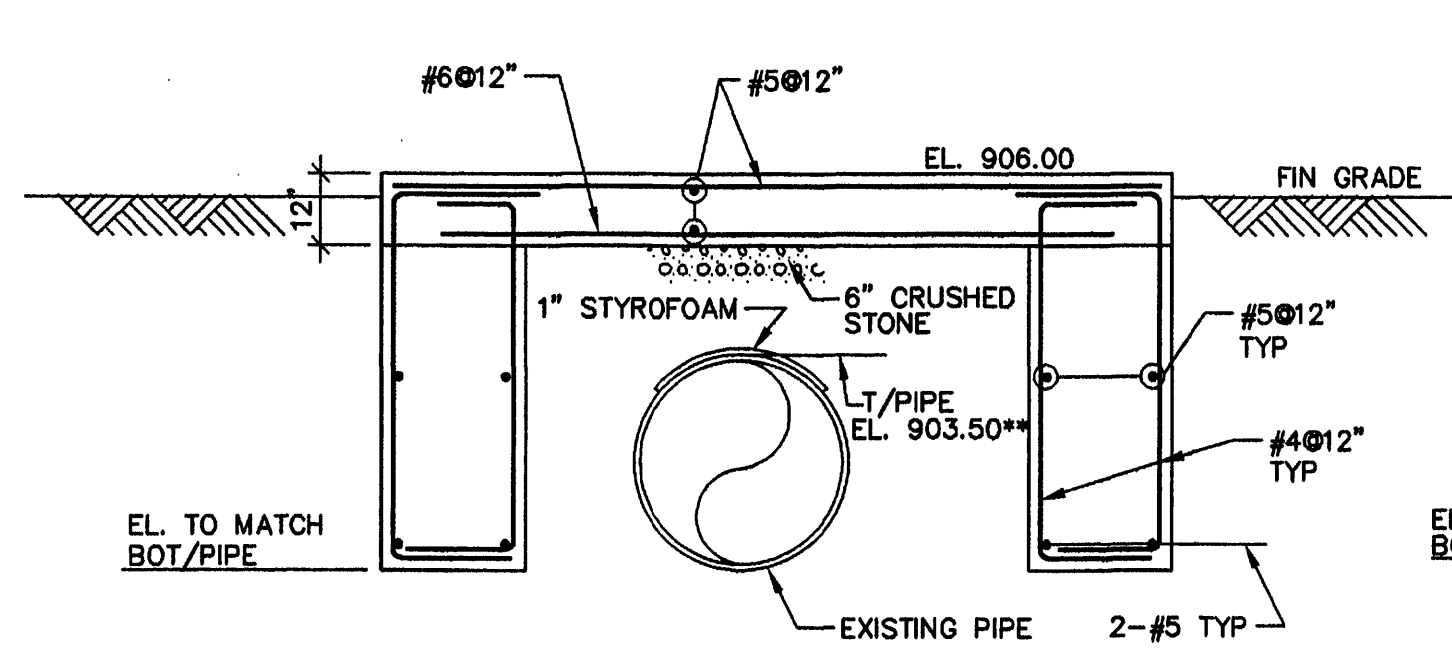

SECTION 2
SCALE: 3/8" = 1'-0"

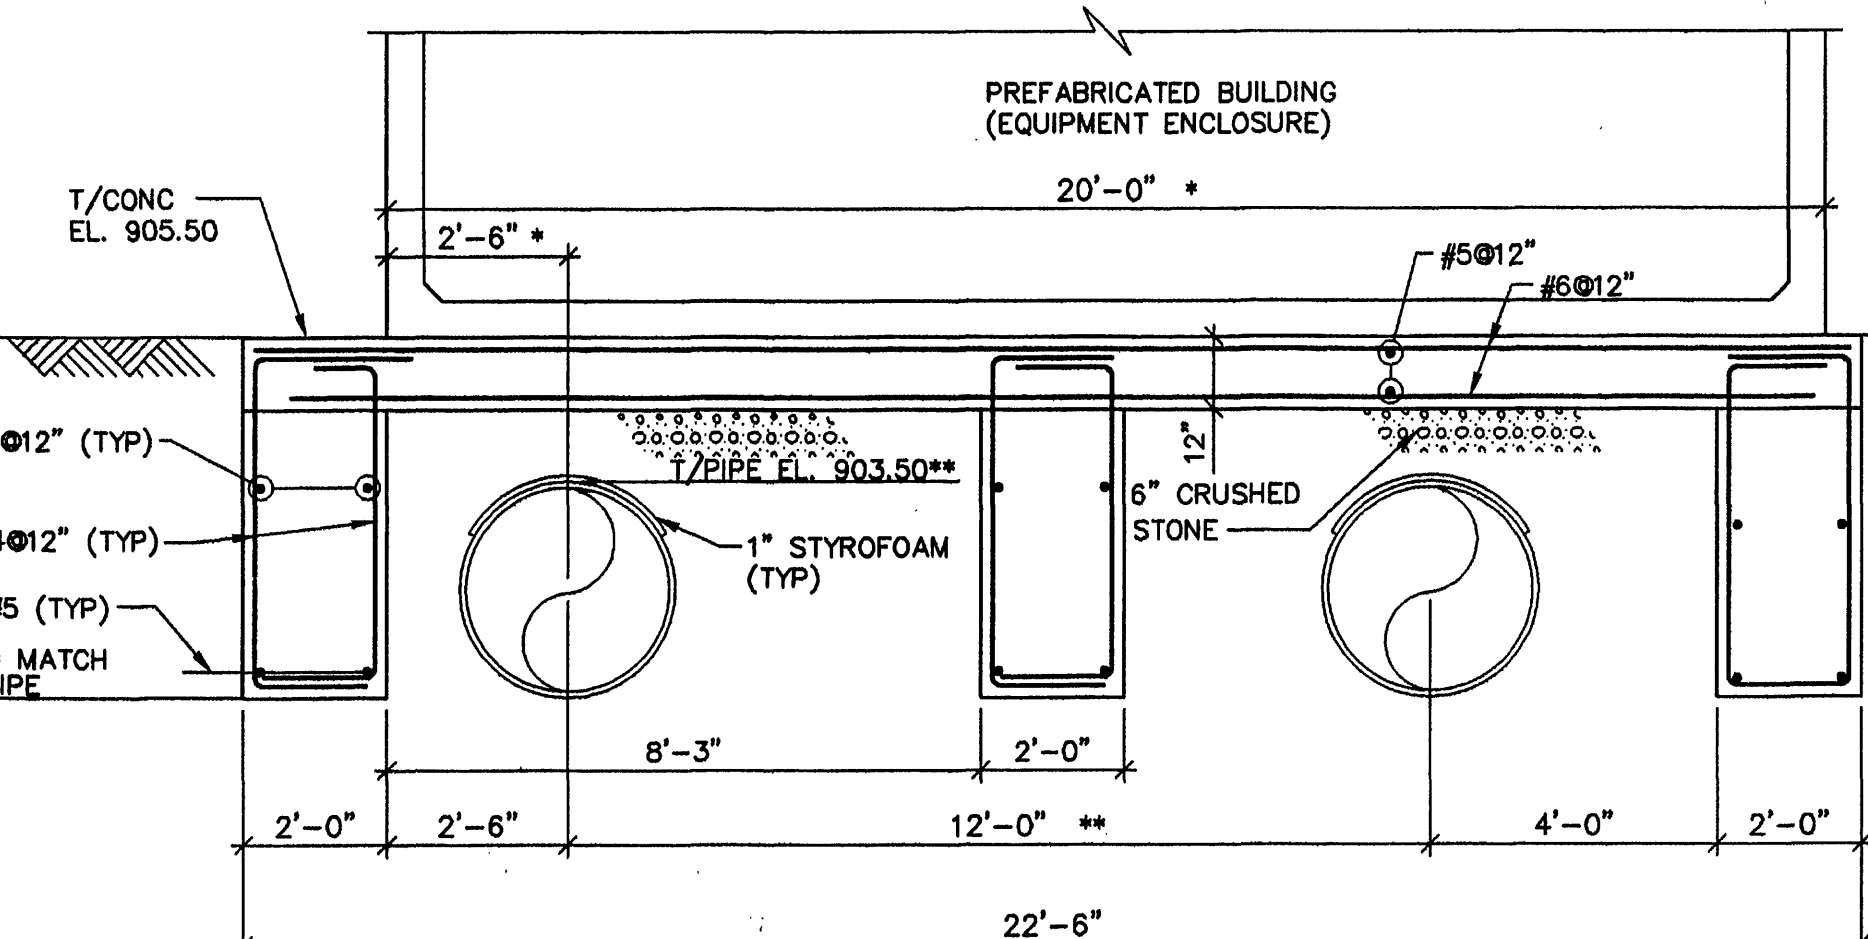

SECTION 3
SCALE: 3/8" = 1'-0"

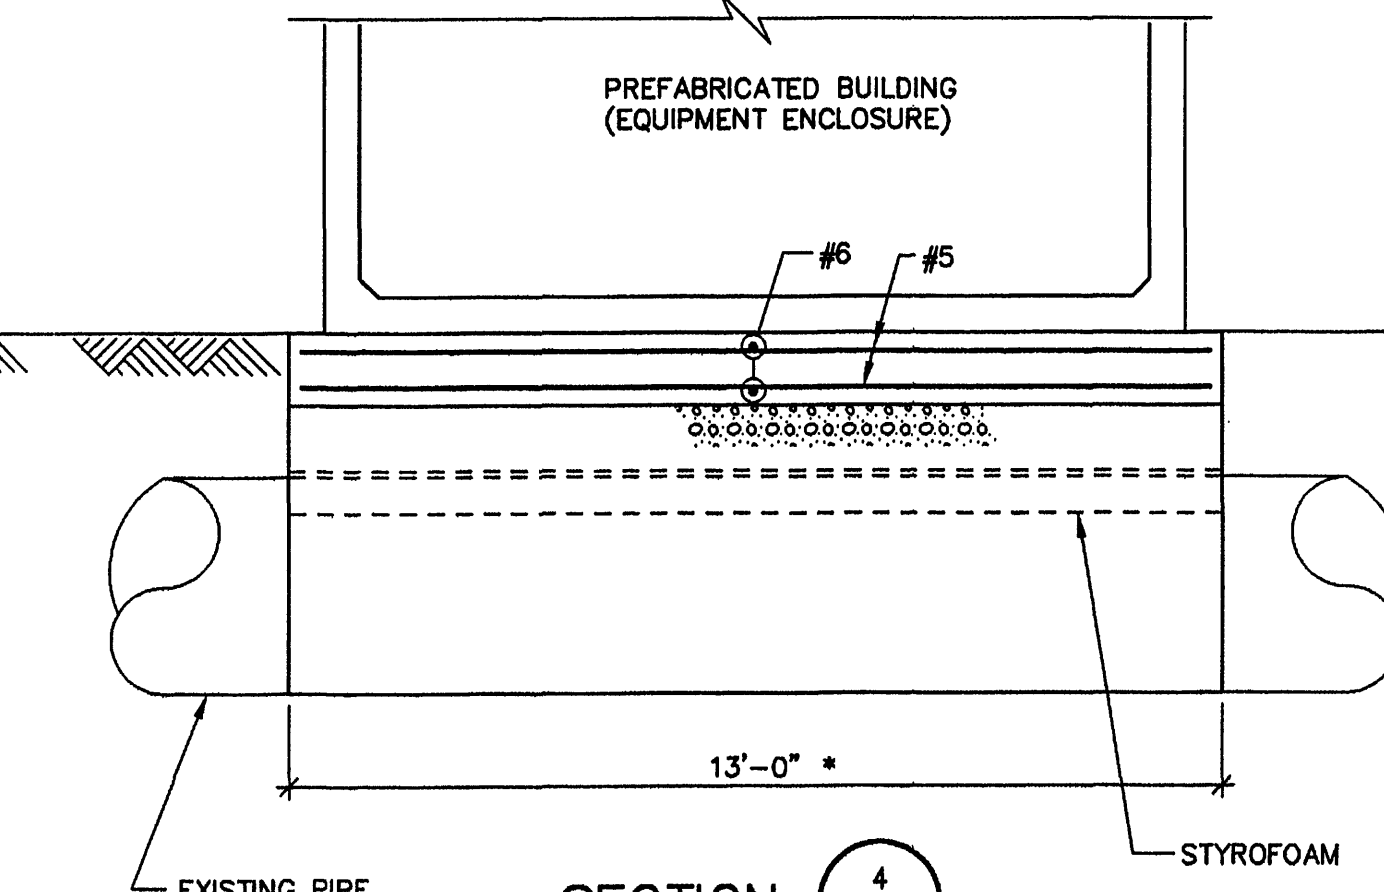

SECTION 4
SCALE: 3/8" = 1'-0"

- NOTES**
1. ALL DIMENSIONS INDICATED SHALL BE VERIFIED WITH EQUIPMENT FURNISHED.
 2. PROVIDE 4" (MIN) HIGH CONC PAD UNDER ALL EQUIPMENT. SEE TYPICAL DETAILS.
 3. * INDICATES DIMENSION TO BE COORDINATED WITH MFR.
 4. ** INDICATES DIMENSION TO BE FIELD VERIFIED.

MALCOLM PIRNIE 11832 Rock Landing Drive, Suite 400 Newport News, Virginia 23606	REVISIONS		DES --- MZ --- DWN --- MZ --- CKD --- DB ---	 CITY OF ROANOKE, VIRGINIA WATER POLLUTION CONTROL PLANT UPGRADE AND EXPANSION	SWITCHGEAR & SUBSTATION PLANS AND SECTIONS SCALE AS NOTED	COPYRIGHT © 1997 MALCOLM PIRNIE, INC. DATE --- MAY 1997 --- S SHEET 35 OF 44 --- CAD REF. NO. 00600373
	NO.	BY DATE				
1	ARB JAN. 2000	RECORD DRAWING				