




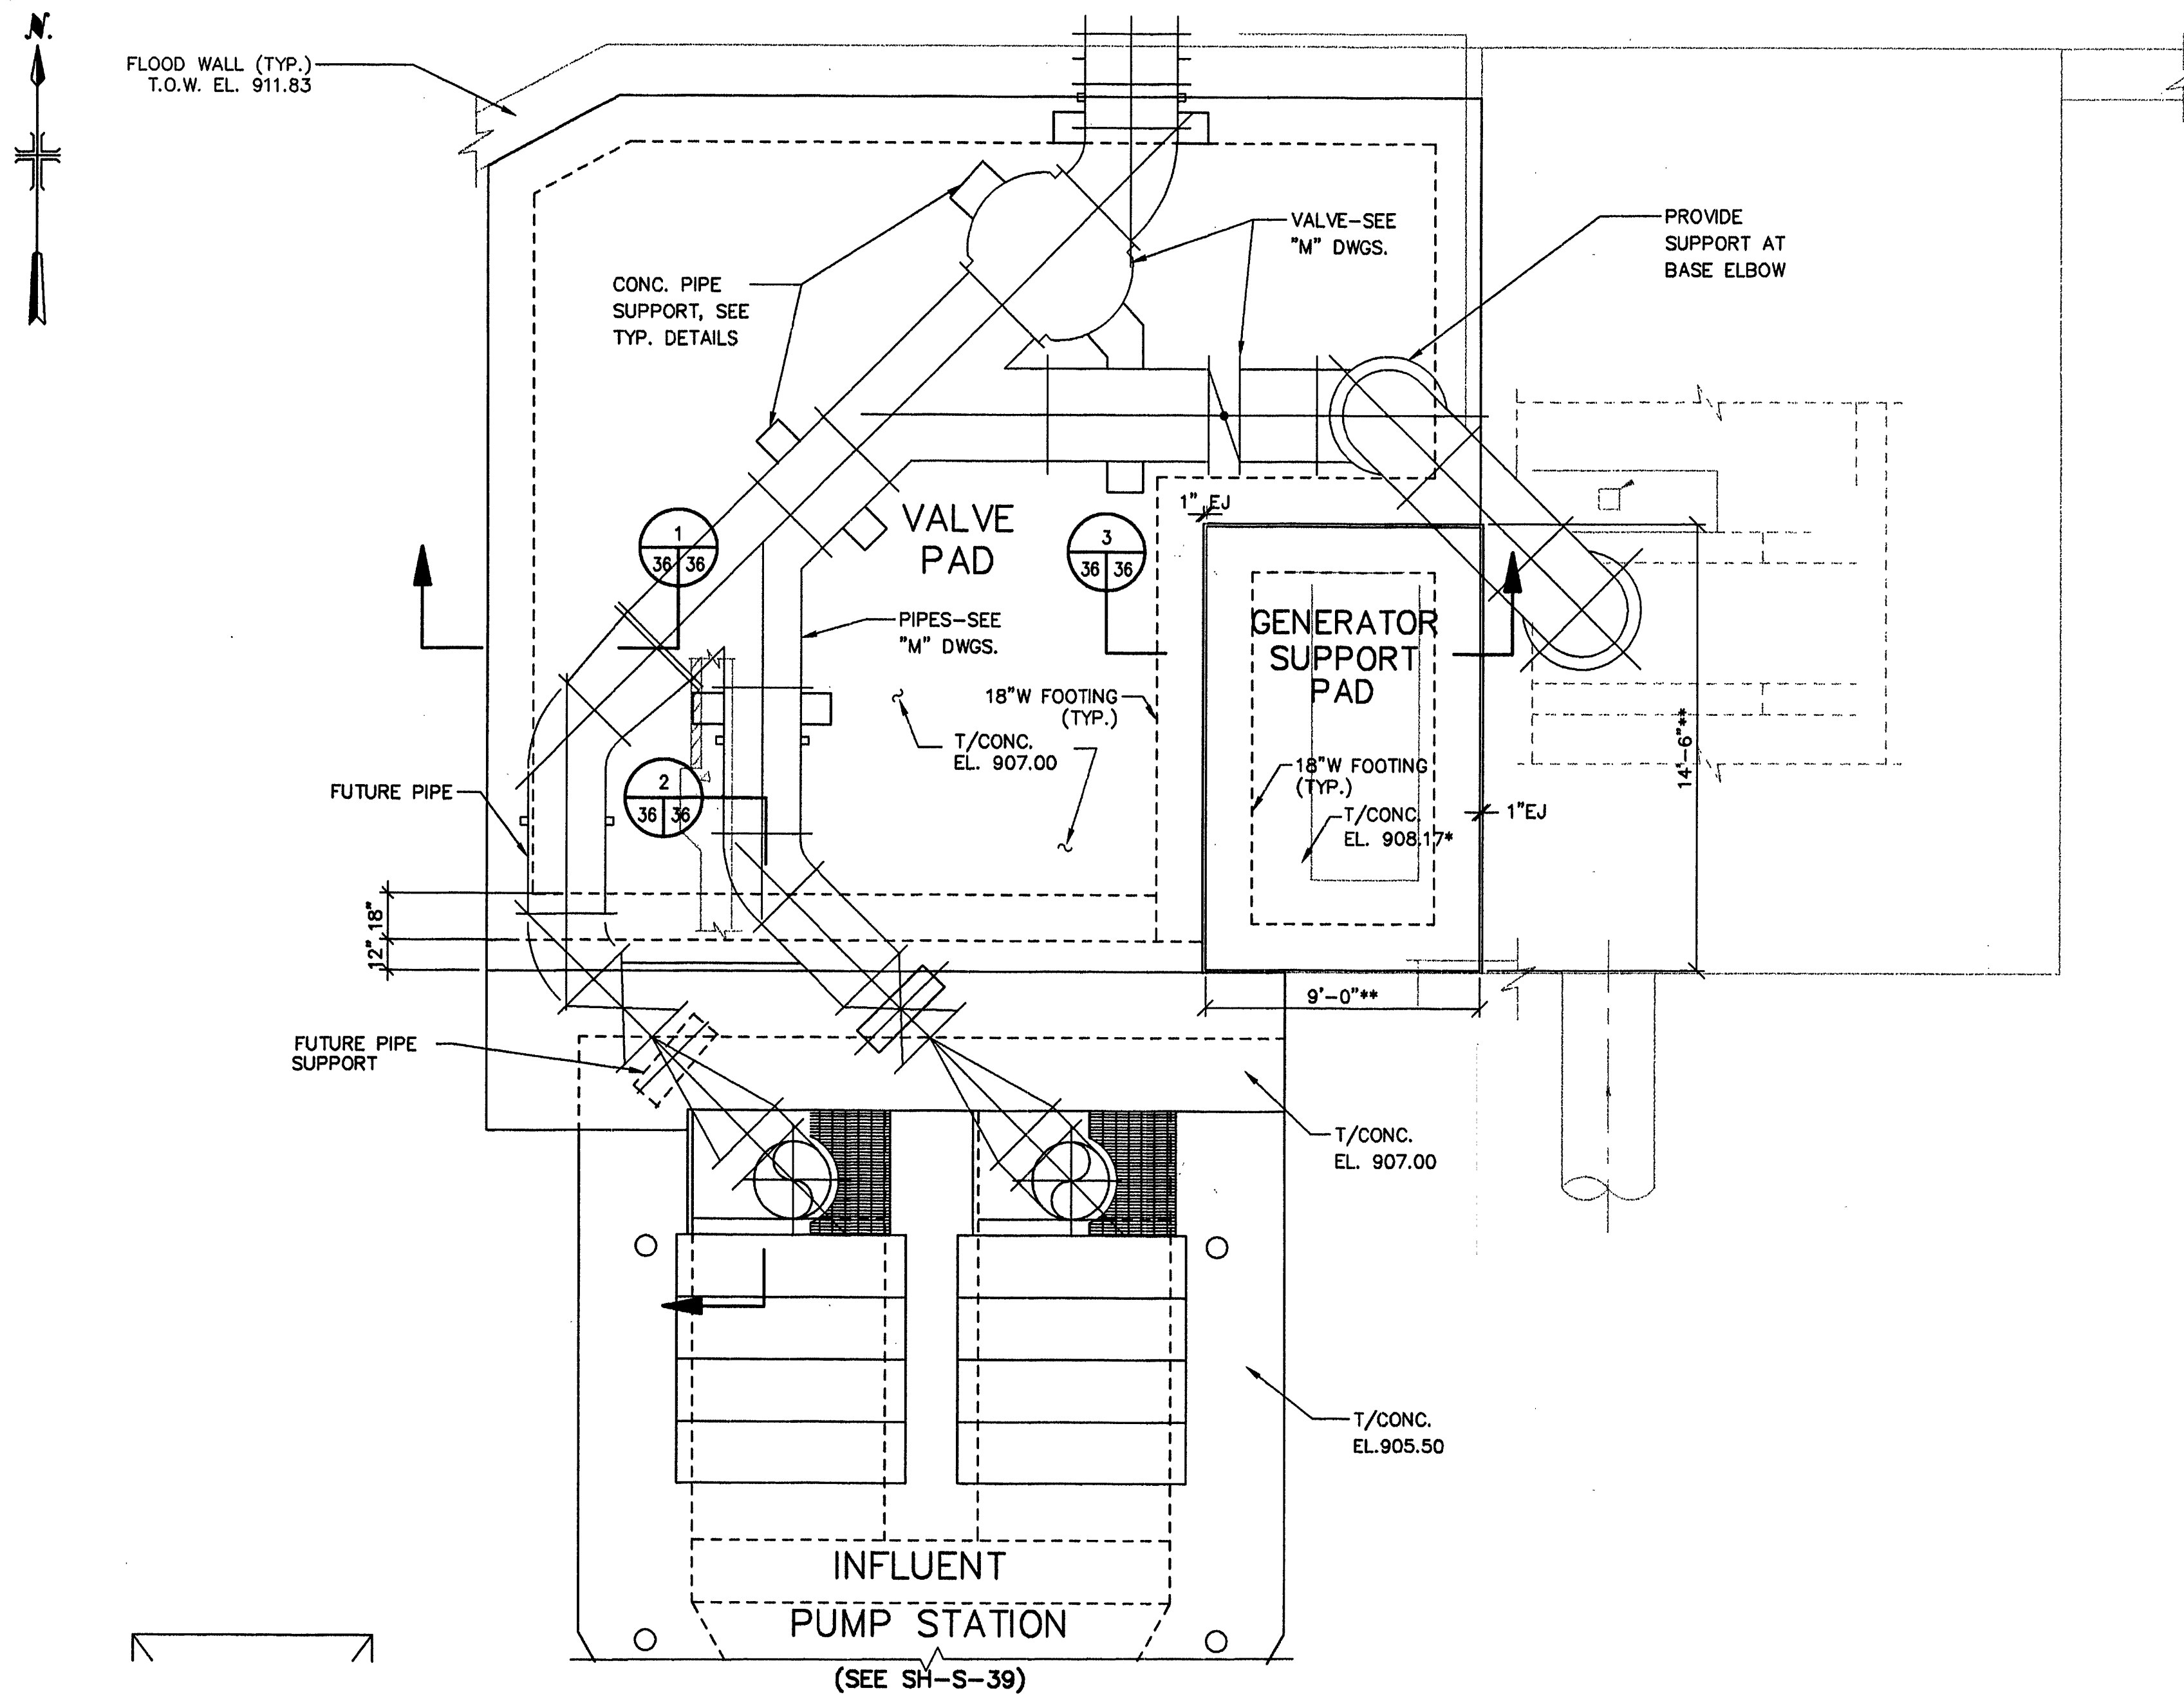


- NOTES:
1. COORDINATE WITH PIPE LAYOUT AND VALVE LOCATIONS.
 2. DESIGN LIVE LOAD=100 PSF OR EQUIPMENT WEIGHT
 3. SLAB THICKNESS = 12"
 4. ** INDICATES DIMENSION TO BE FIELD VERIFIED

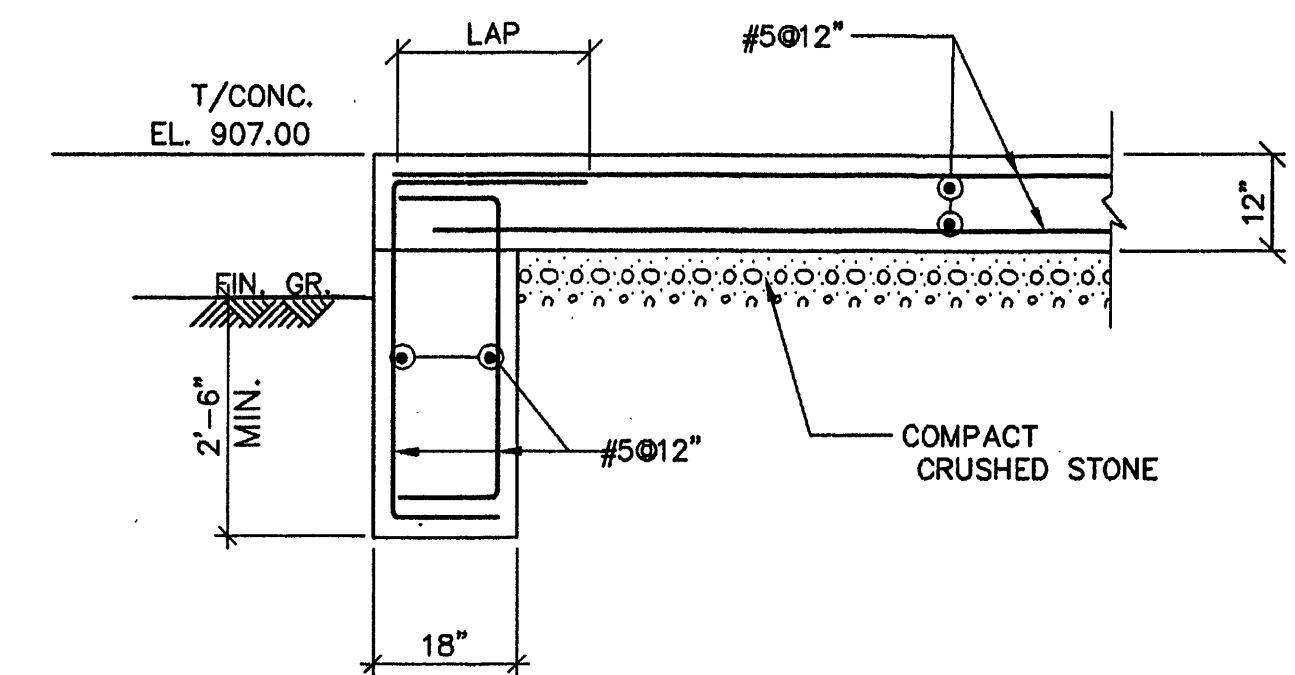

SECTION 1
SCALE: 1/2"=1'-0"

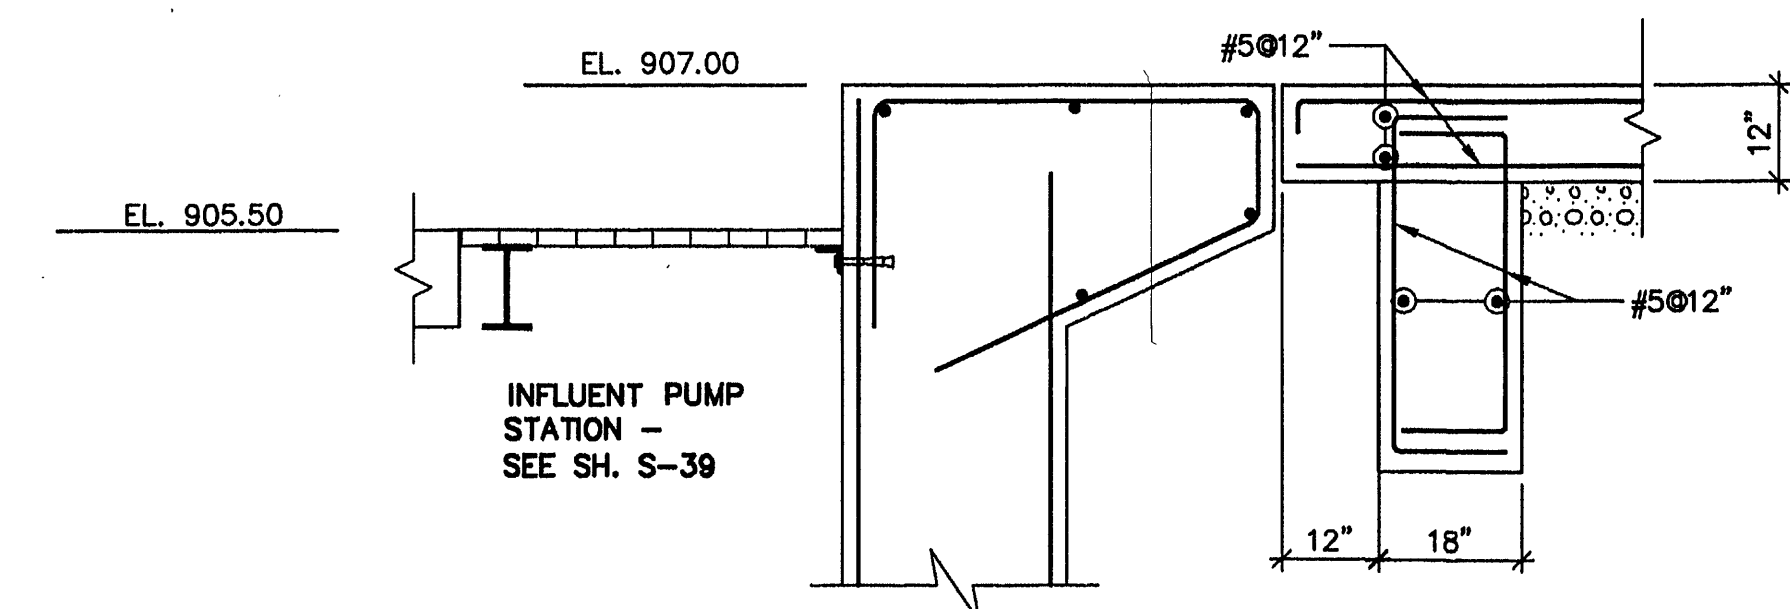

SECTION 2
SCALE: 1/2"=1'-0"

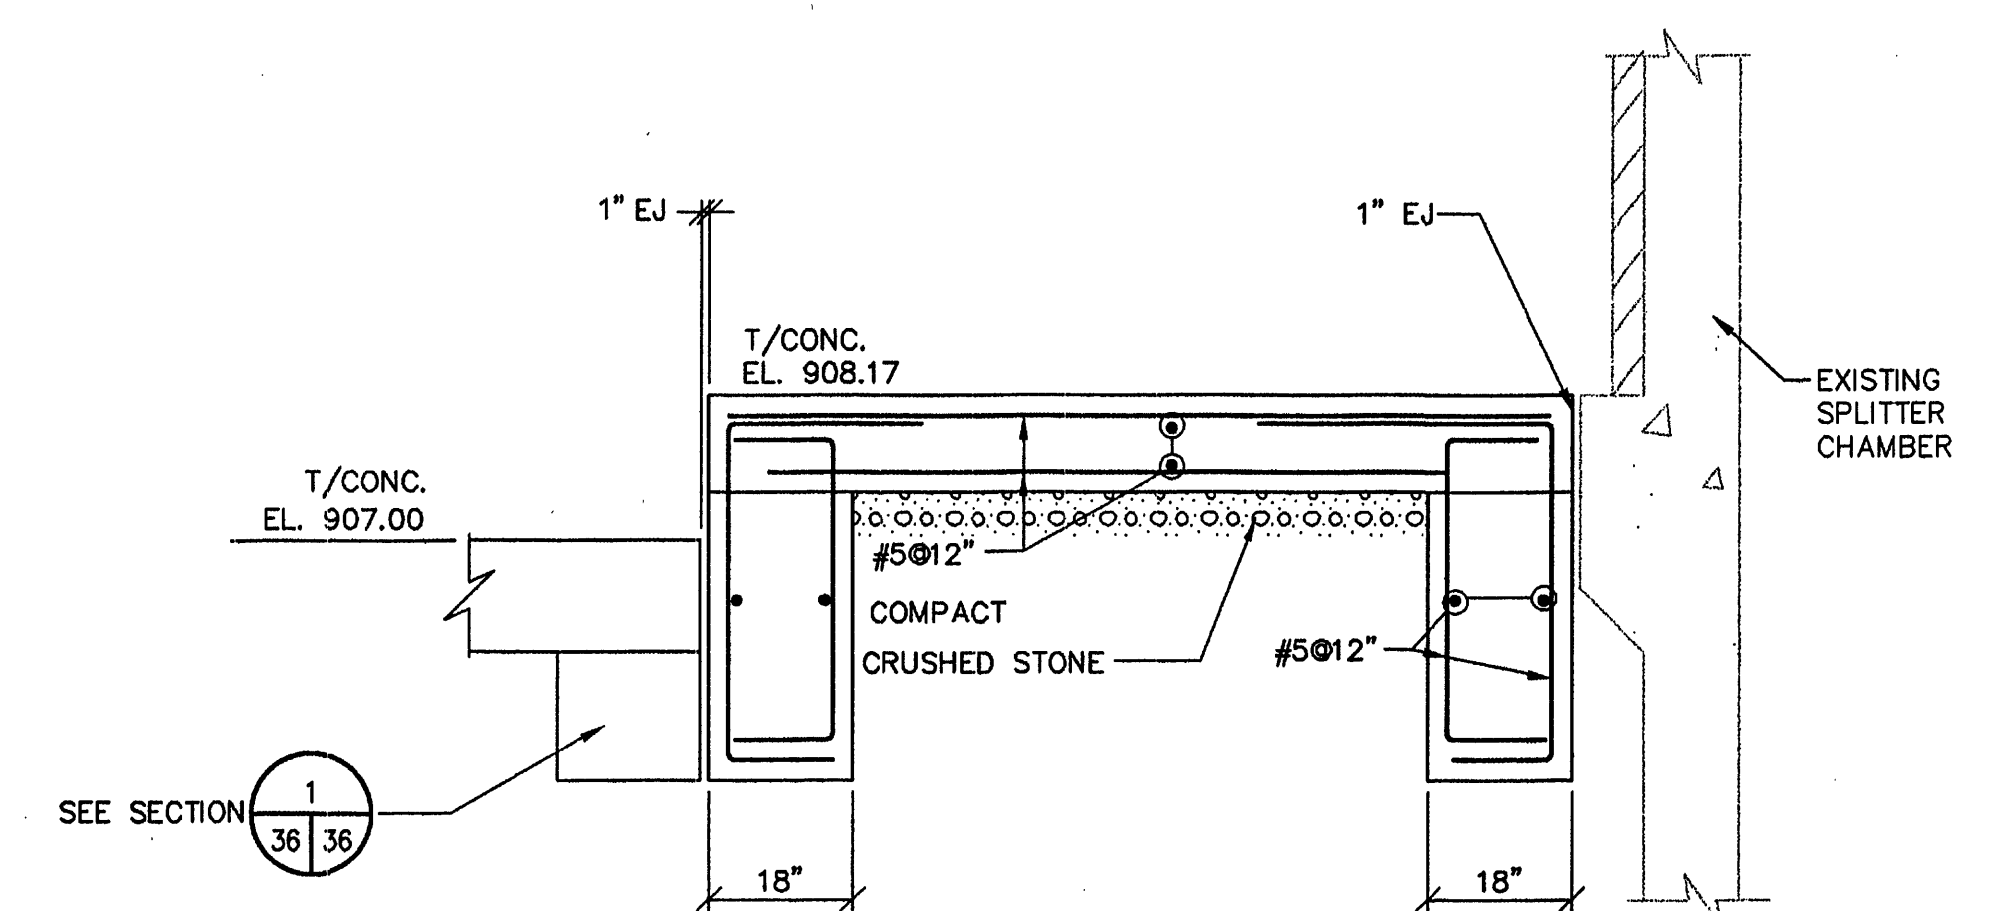

SECTION 3
SCALE: 1/2"=1'-0"

**MALCOLM
PIRNIE**

11832 Rock Landing Drive, Suite 400
Newport News, Virginia 23606

REVISIONS			
NO.	BY	DATE	REMARKS
1	ARB	JAN. 2000	RECORD DRAWING

DES _ EDC _
DWN _ EDC _
CKD _ DB _



CITY OF ROANOKE, VIRGINIA
WATER POLLUTION
CONTROL PLANT
UPGRADE AND EXPANSION

INFLUENT PUMP STATION
VALVE PAD
PLANS AND SECTIONS
SCALE AS NOTED

COPYRIGHT © 1997
MALCOLM PIRNIE, INC.
DATE _ MAY 1997 _
S SHEET 36 OF 44 _
CAD REF. NO. 0060S379 _