



7360 006028505 T:\CAD\PROJ\0060285\00605375 Scale: 1:1 Date: 05/06/1997 Time: 11:16

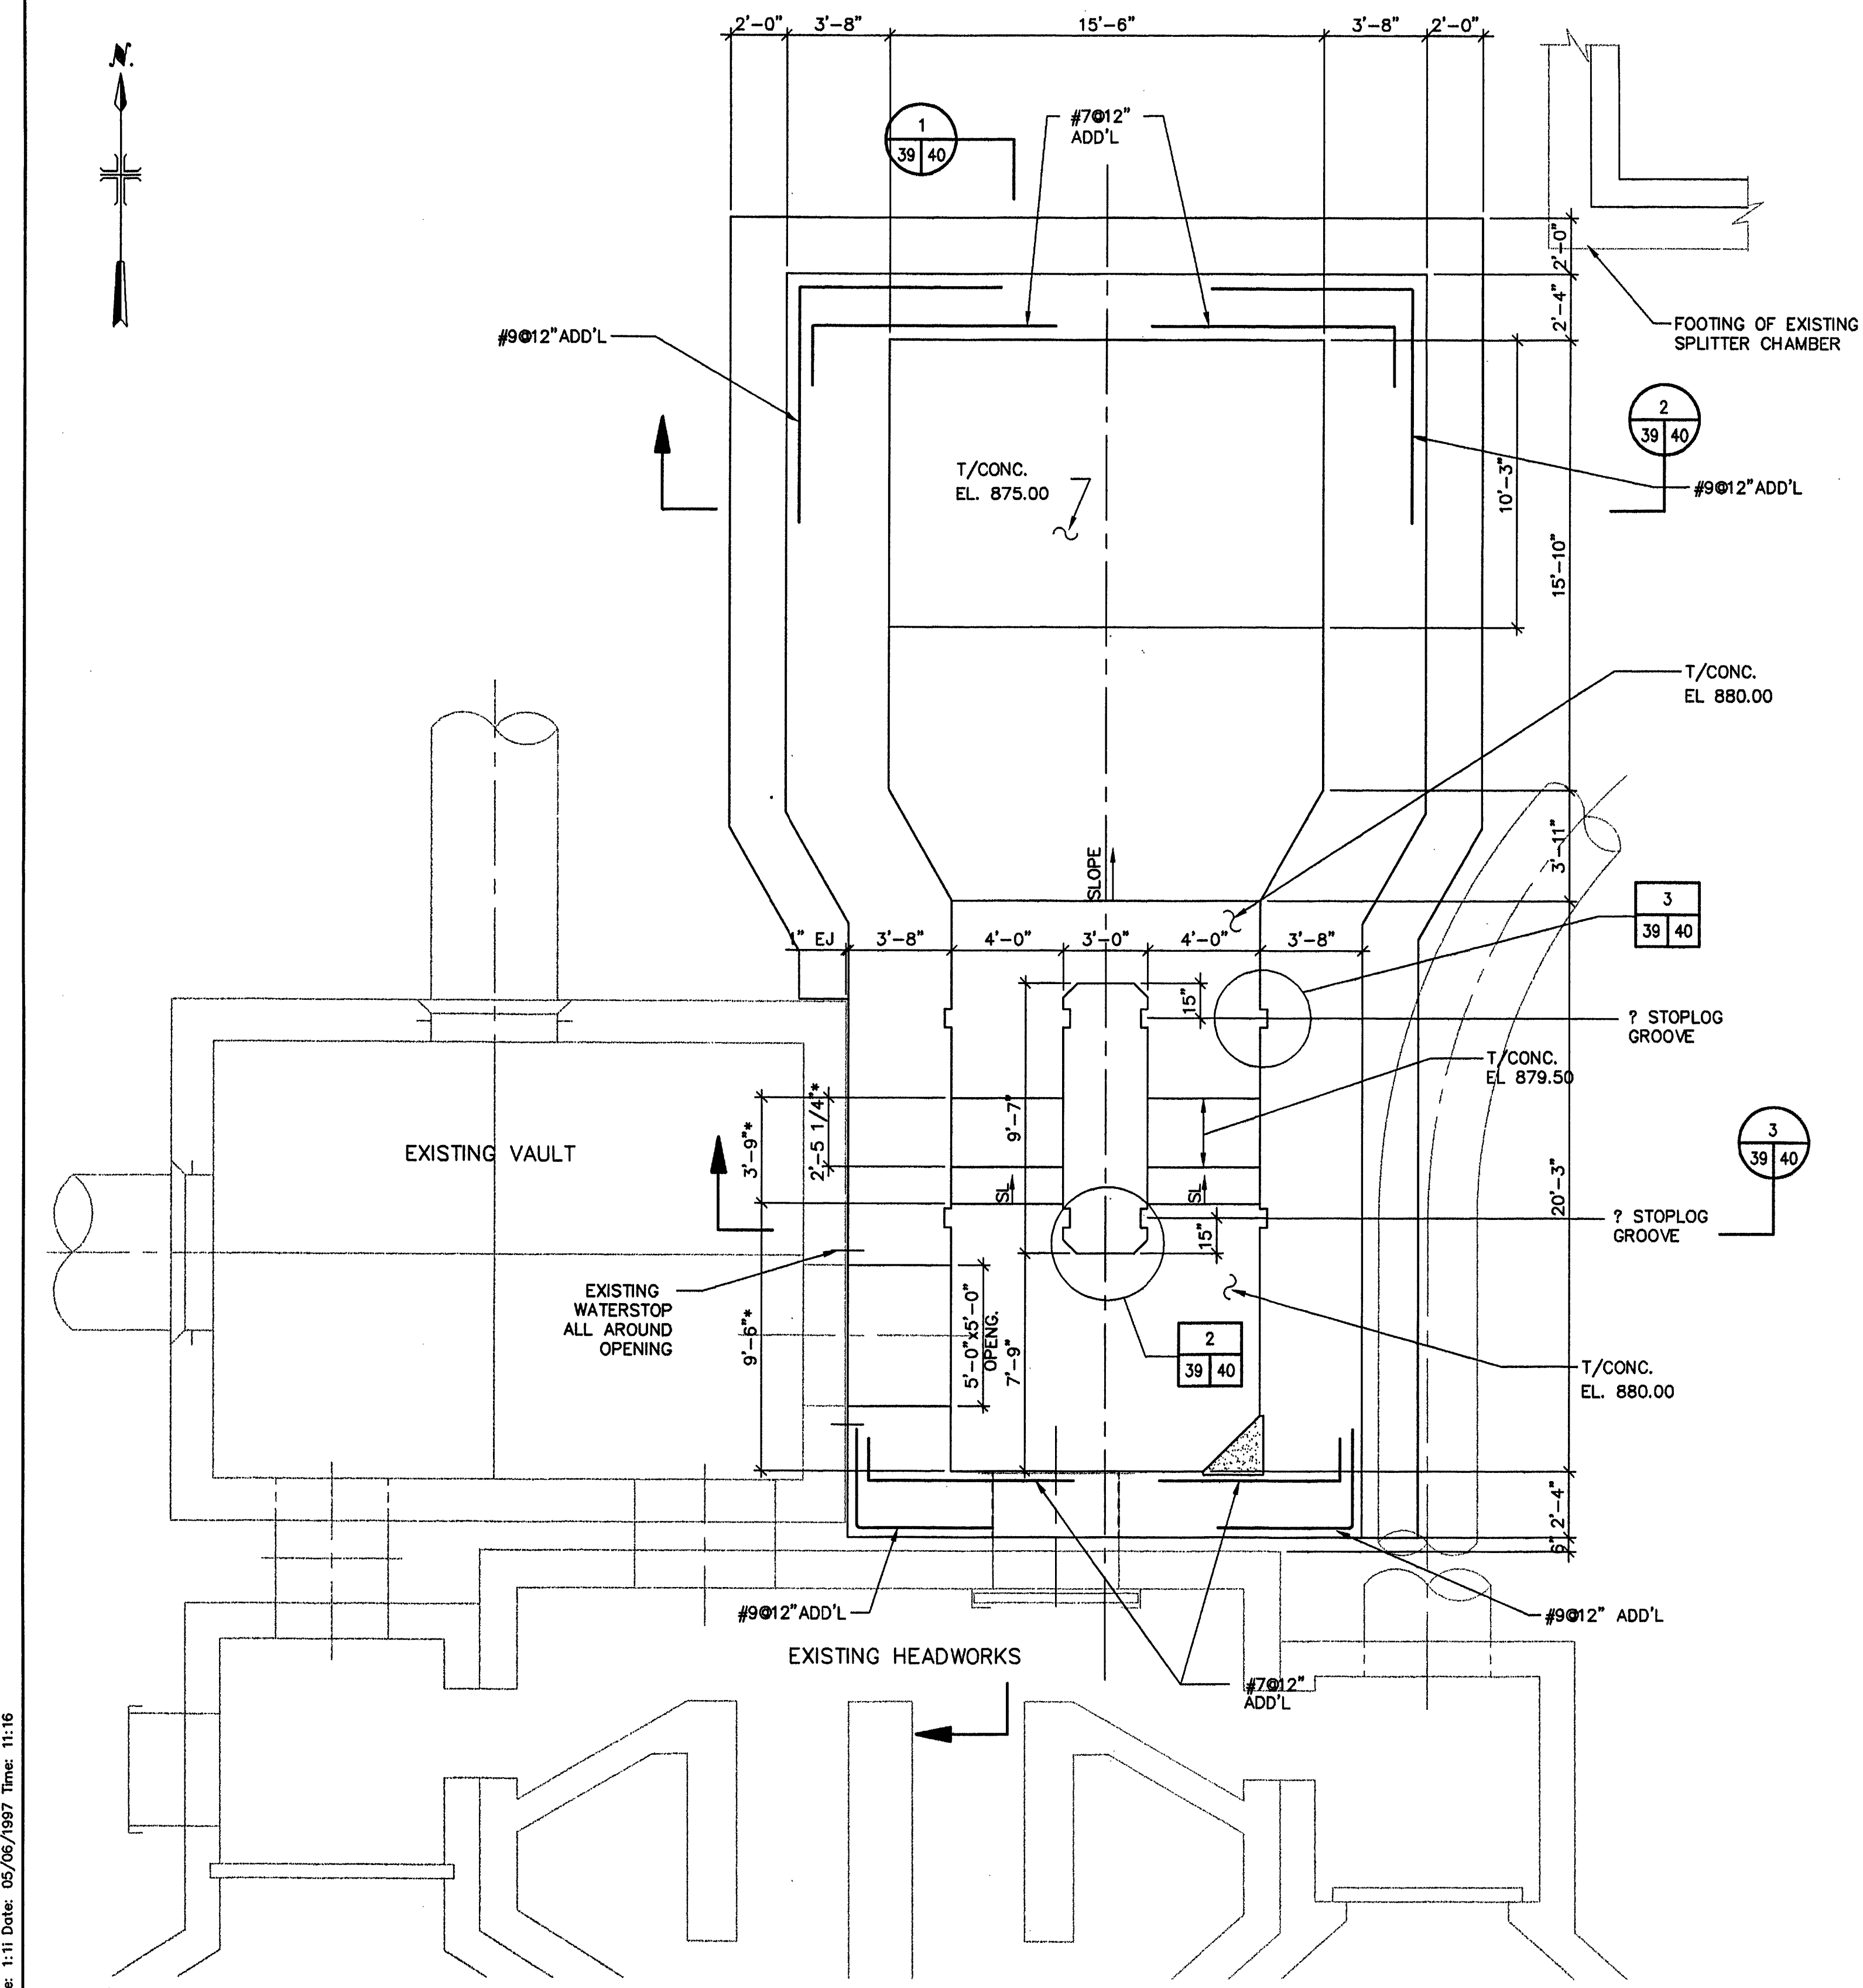

- NOTES: 1.) ALLOWABLE BEARING PRESSURE = 4 KSF
2.) MAT THICKNESS = 4'-0"
3.) MAT REINF : #9@12" TOP & BOT E.W.
4.) PROVIDE ALL NECESSARY SHEETING, SHORING AND/OR UNDERPINNING TO PROTECT ADJACENT EXISTING STRUCTURES.
5.) * INDICATES DIMENSIONS TO BE CO-ORDINATED WITH EQUIPMENT FURNISHED.
- 6.) ADEQUATE DEWATERING MEASURES SHALL BE TAKEN TO PROTECT STRUCTURE FROM FLOATATION DURING CONSTRUCTION.

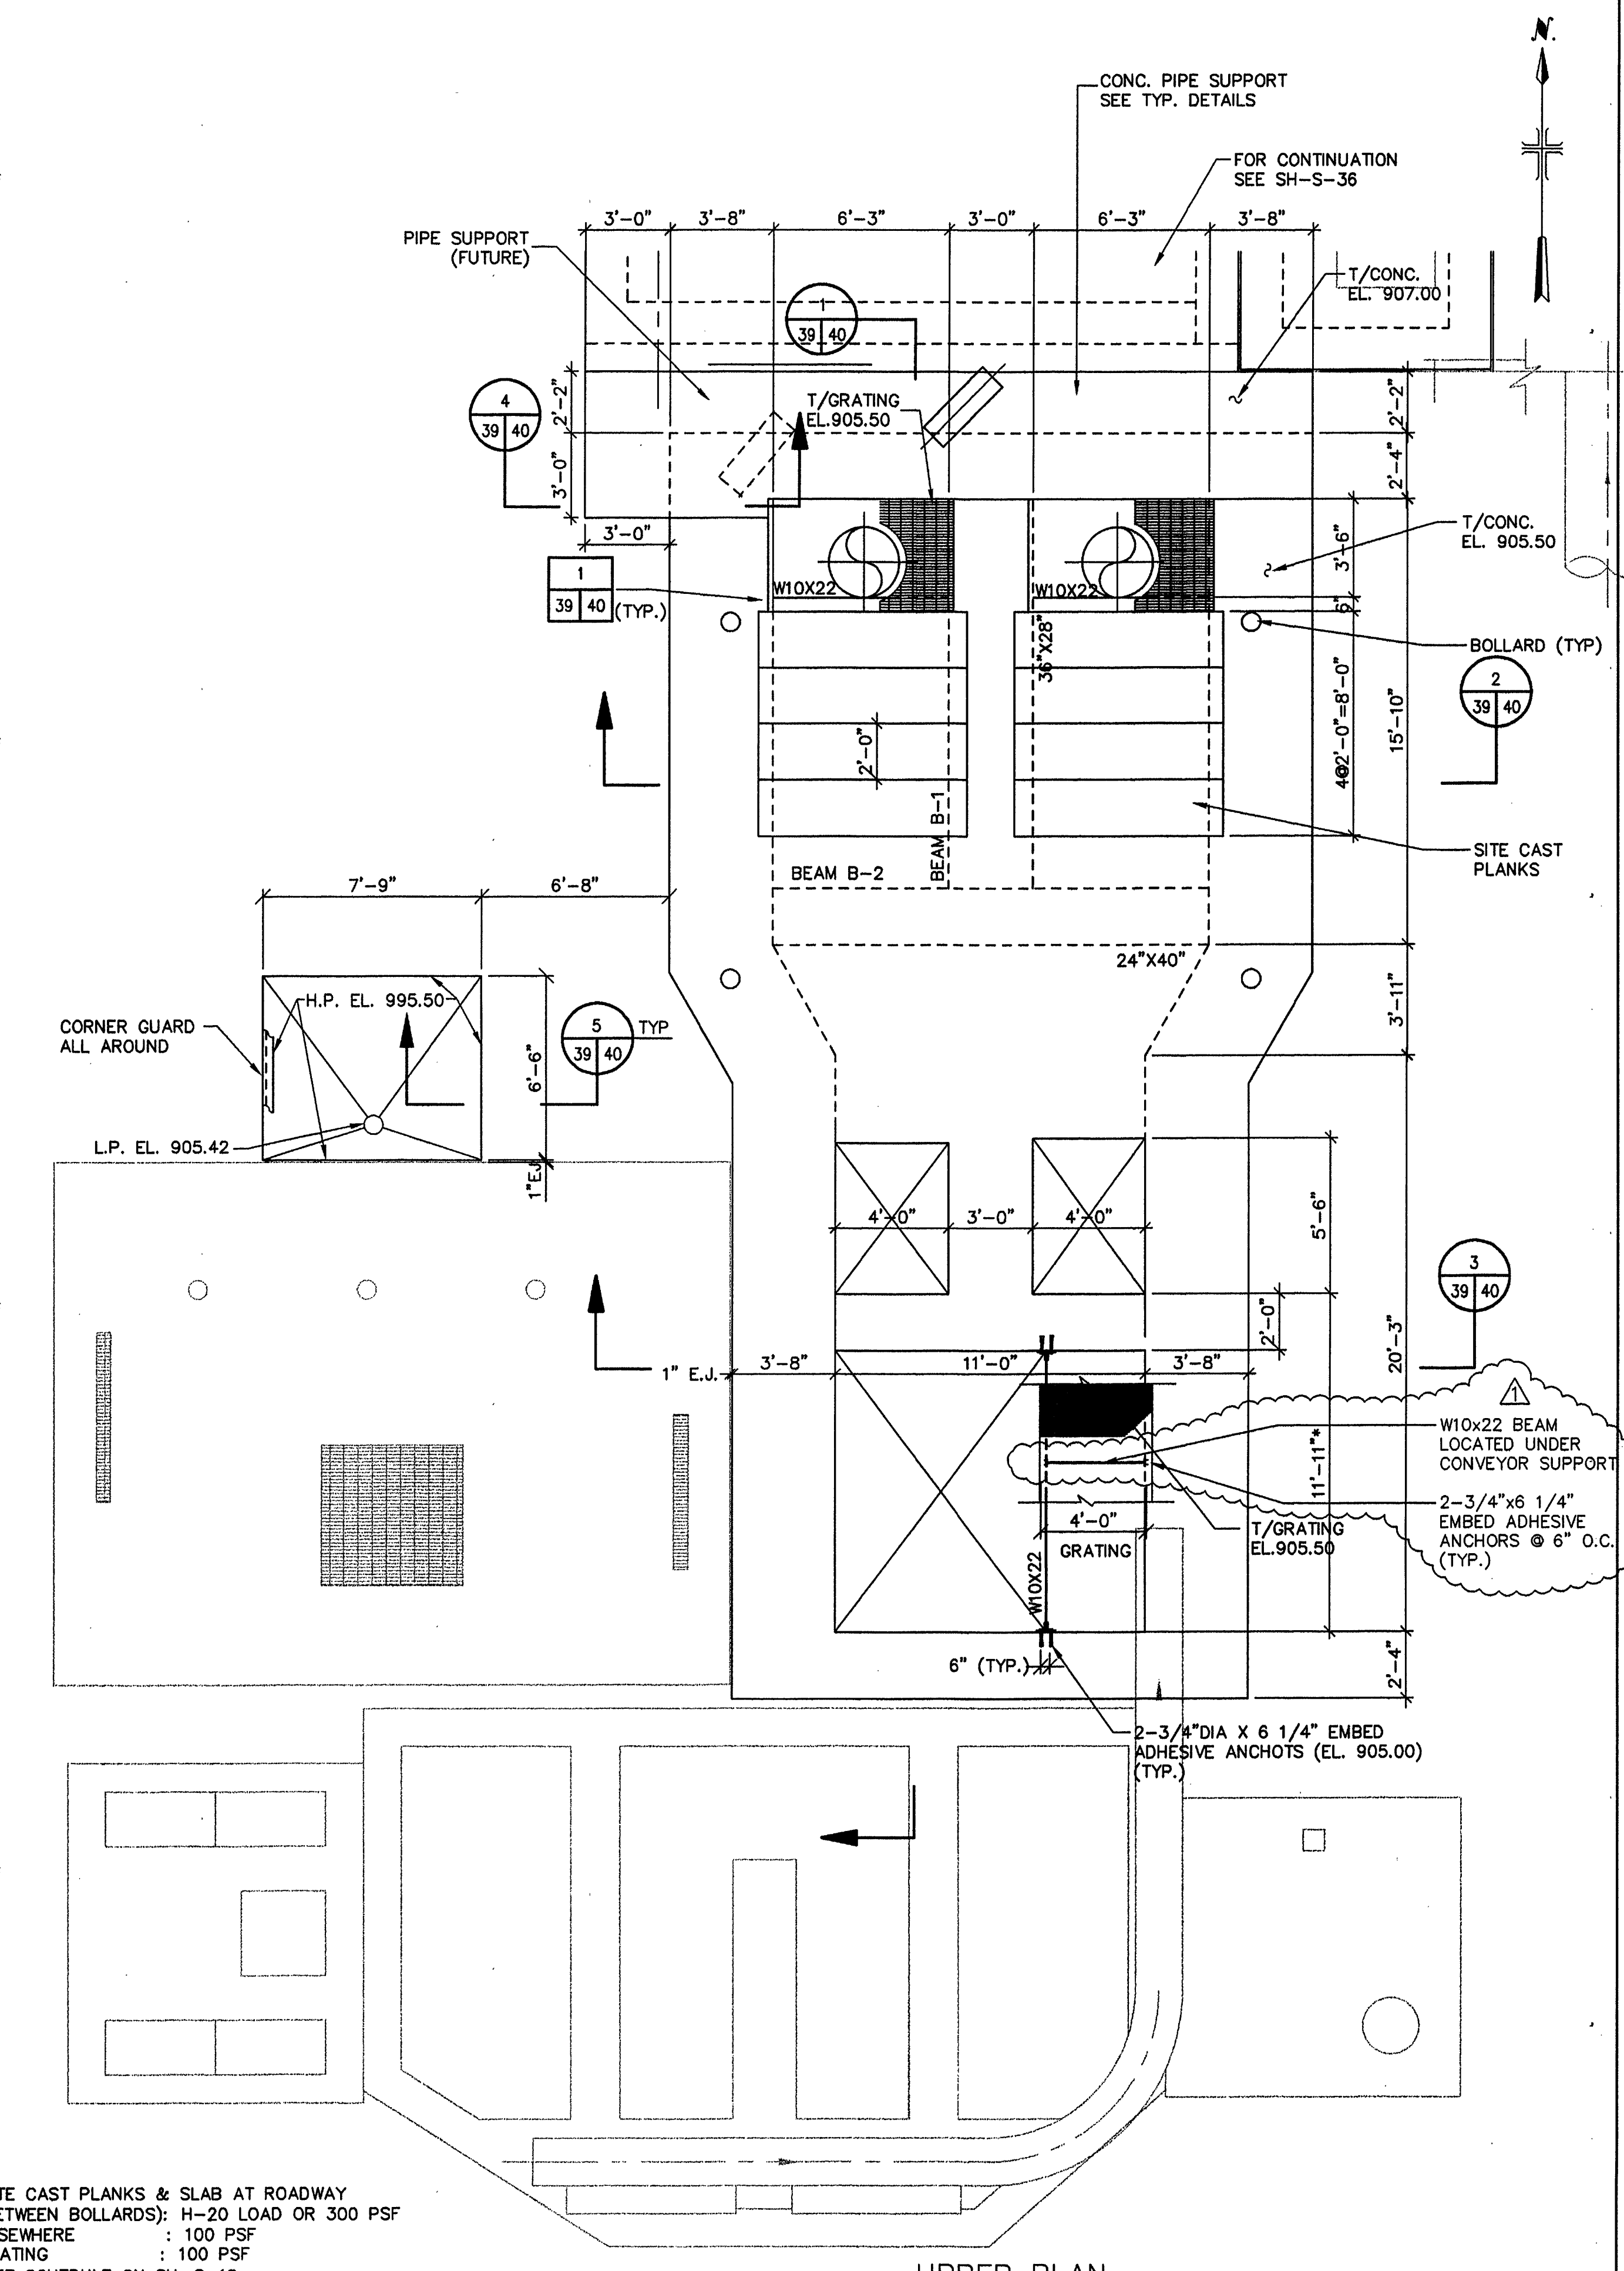

- NOTES: 1.) DESIGN LIVE LOAD: SITE CAST PLANKS & SLAB AT ROADWAY (BETWEEN BOLLARDS): H-20 LOAD OR 300 PSF
ELSEWHERE : 100 PSF
GRATING : 100 PSF
2.) FOR BEAM DETAILS, SEE SCHEDULE ON SH. S-18.
3.) * INDICATES DIMENSIONS TO BE CO-ORDINATED WITH EQUIPMENT FURNISHED.

**MALCOLM
PIRNIE**
11898 Rock Landing Drive, Suite 400
Newport News, Virginia 23606

REVISIONS				DES	DWN	CKD
NO.	BY	DATE	REMARKS			
1	ARB	JAN. 2000	RECORD DRAWING	EDC	CDM	DB



CITY OF ROANOKE, VIRGINIA
WATER POLLUTION
CONTROL PLANT
UPGRADE AND EXPANSION

PLANT INFLUENT PUMP STATION
PLANS
1/4" = 1'-0"

COPYRIGHT © 1997
MALCOLM PIRNIE, INC.
DATE MAY 1997
SHEET 39 OF 44
CAD REF. NO. 00605375