




7360 000028505 1: VACAD YR0010060285 0060371 Scale: 1:48 Date: 05/06/1997 Time: 11:12

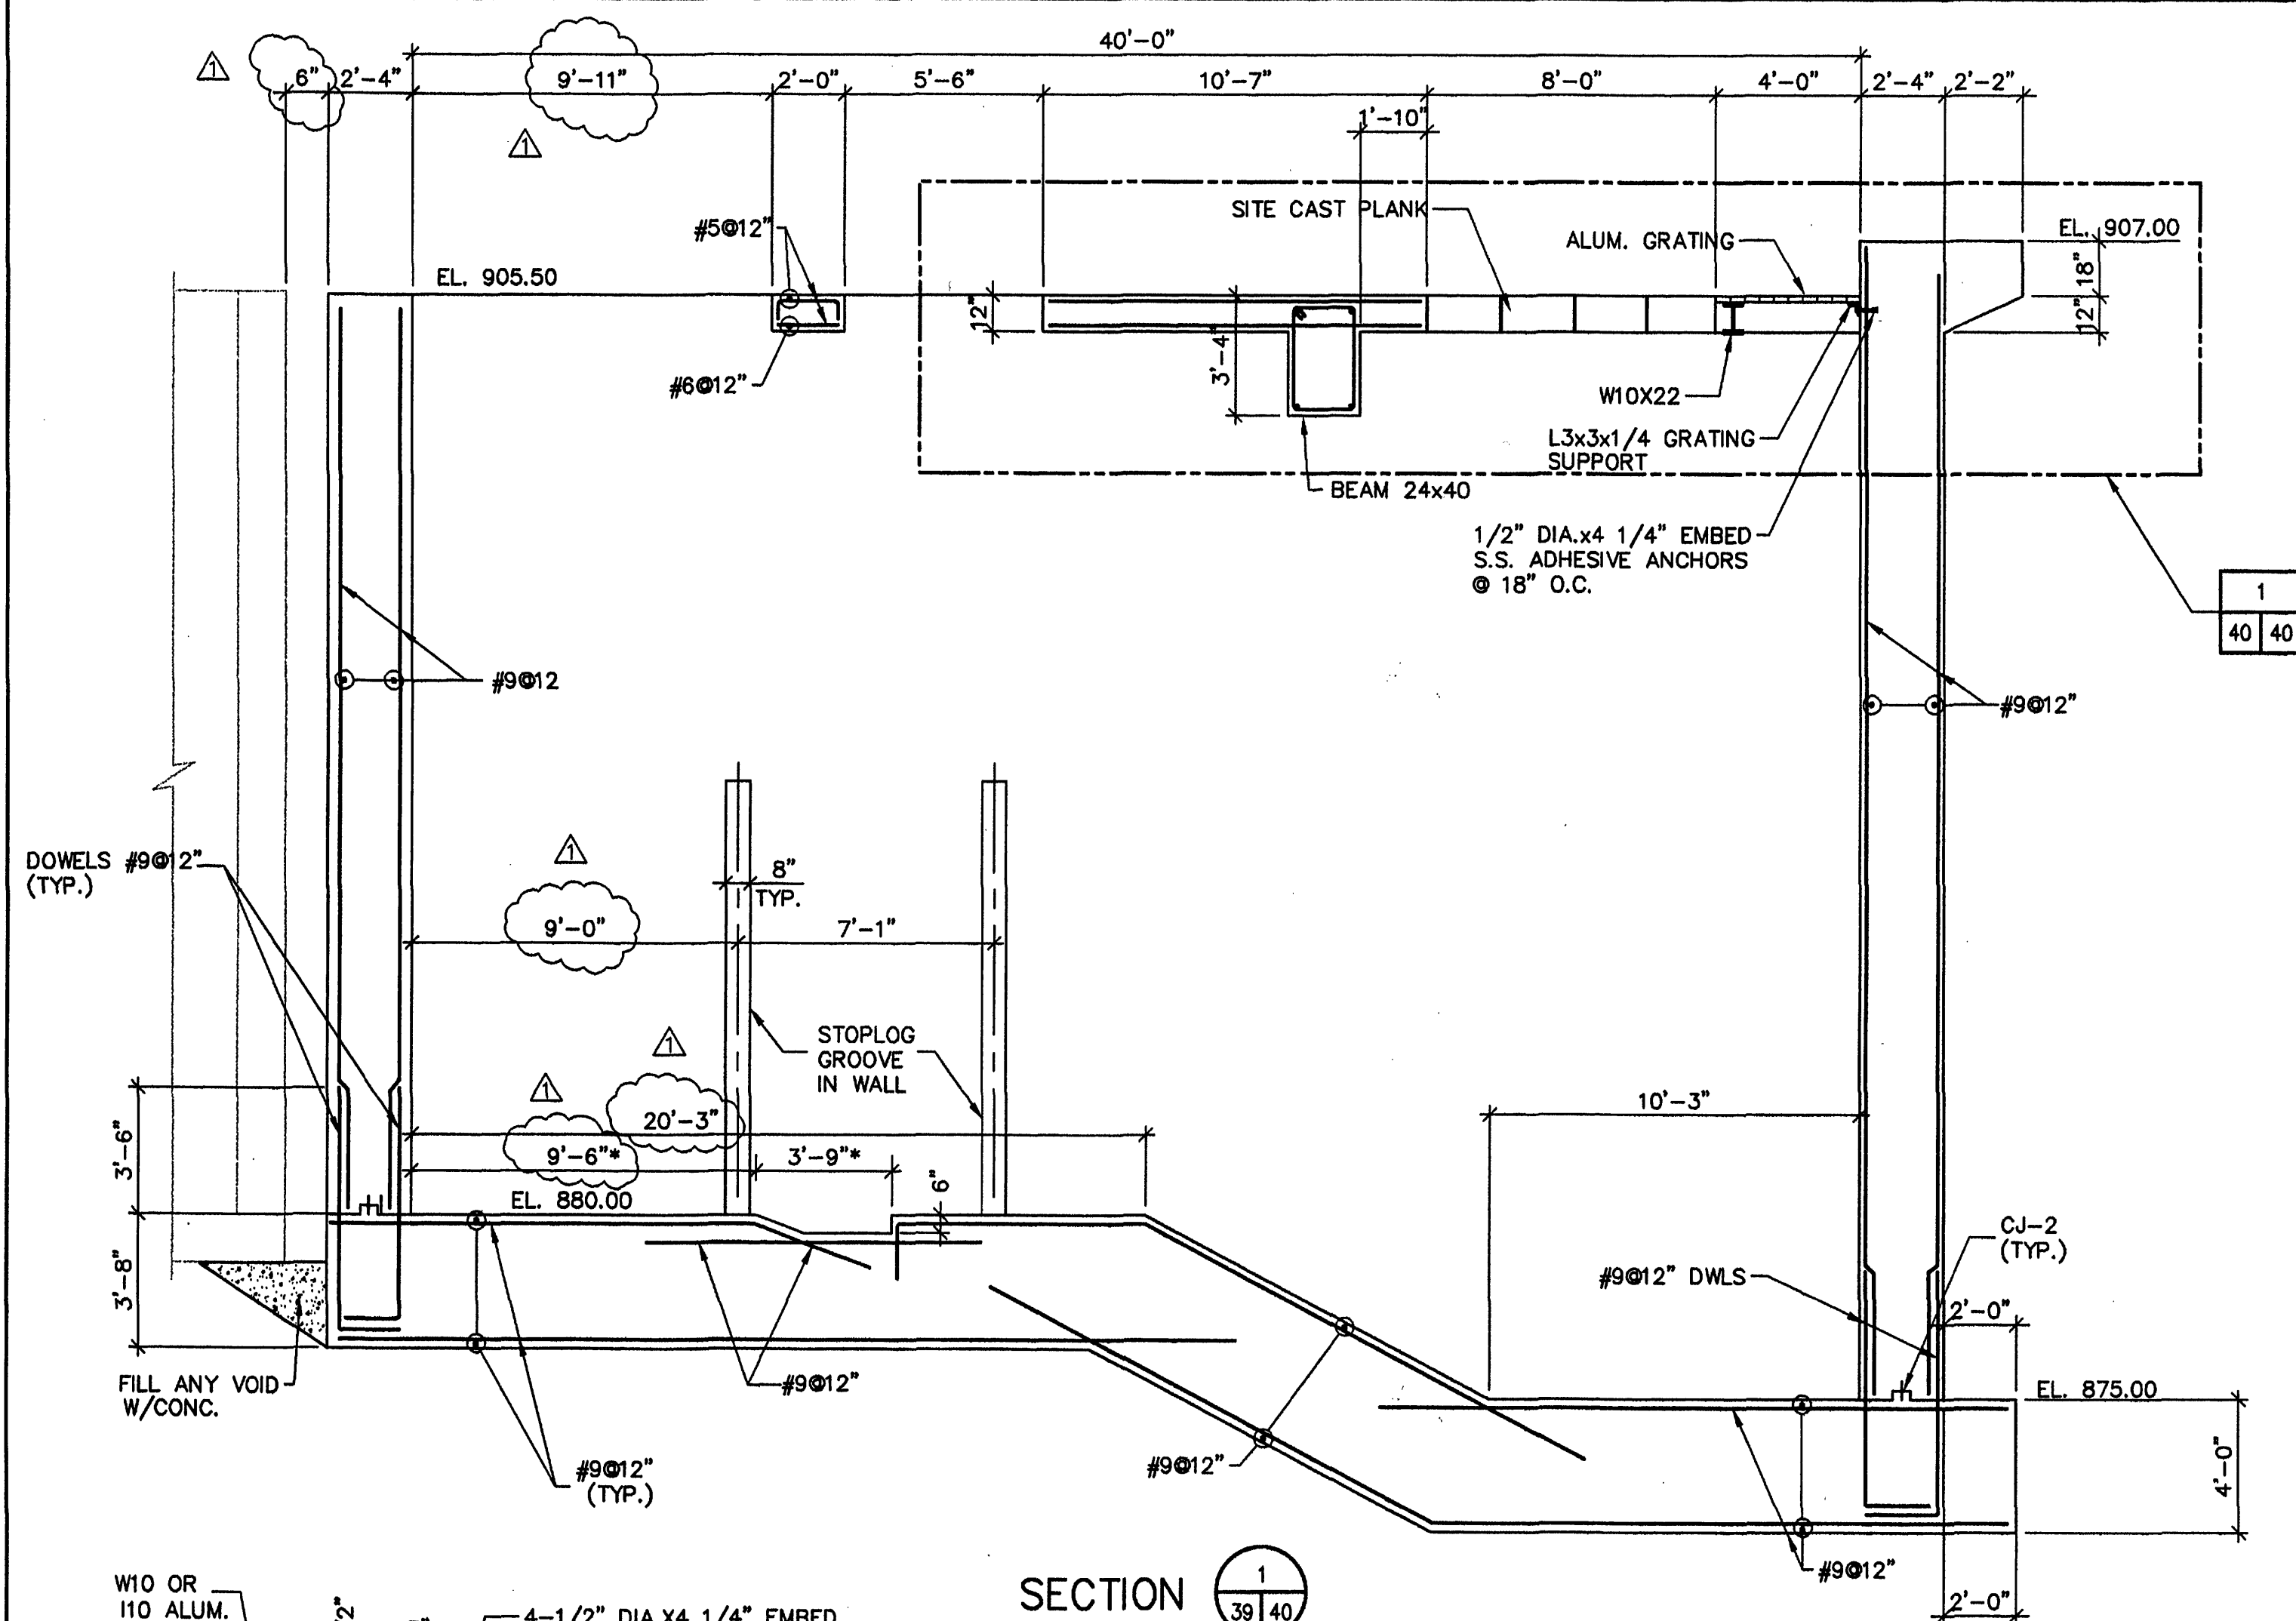


SECTION 1
SCALE: 1/4"=1'-0"

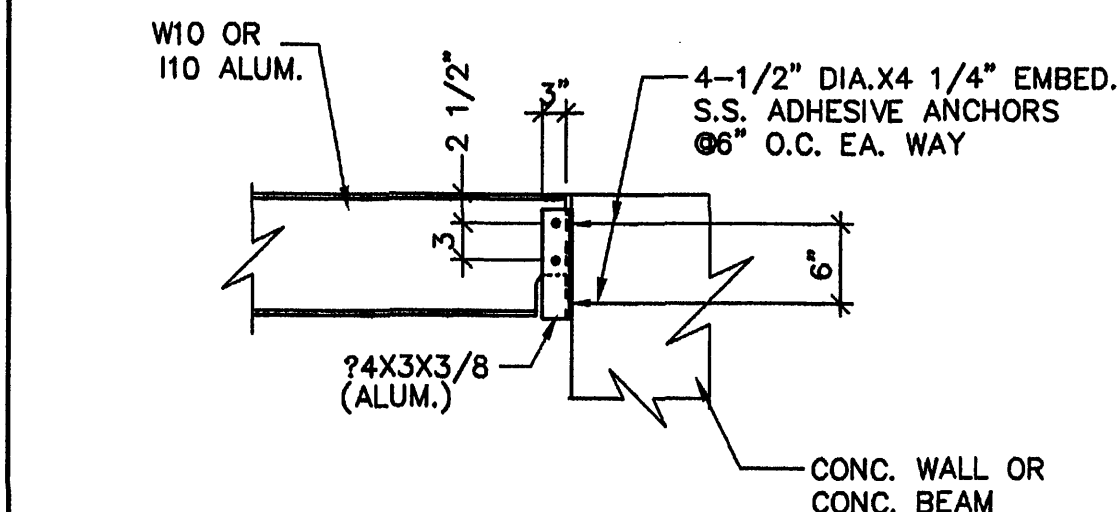


DETAIL 1
SCALE: 3/4"=1'-0"

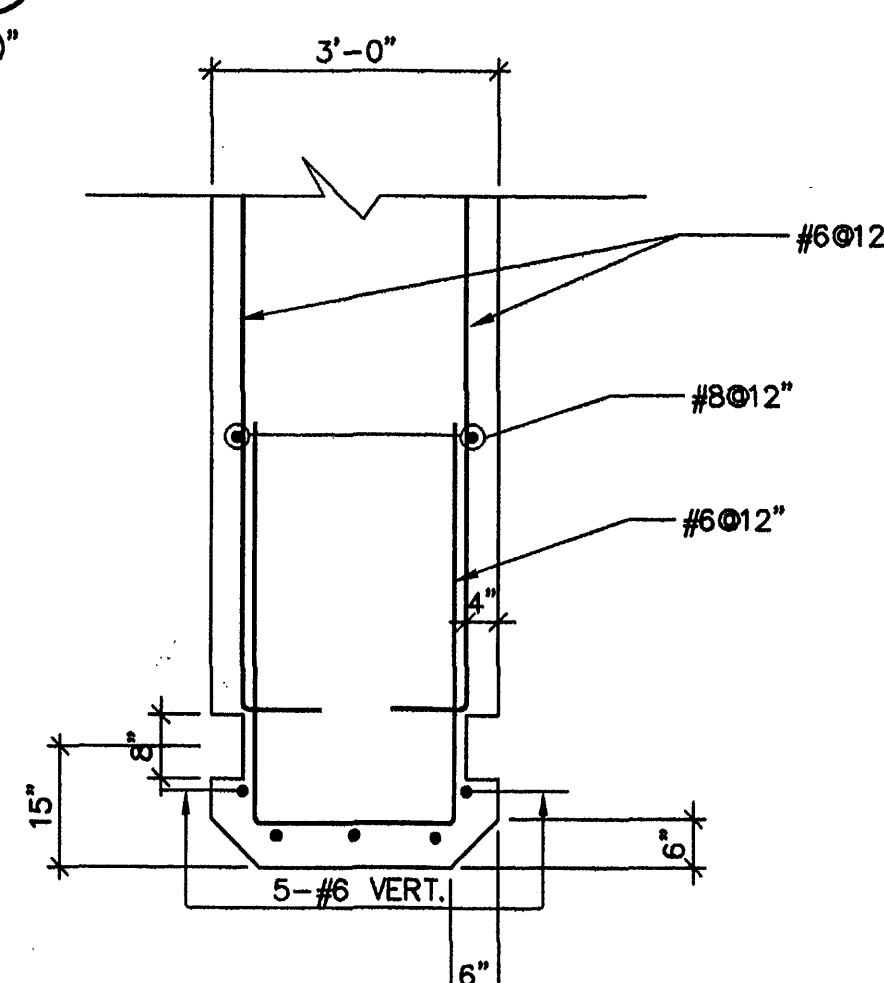


DETAIL 2
SCALE: 3/4"=1'-0"

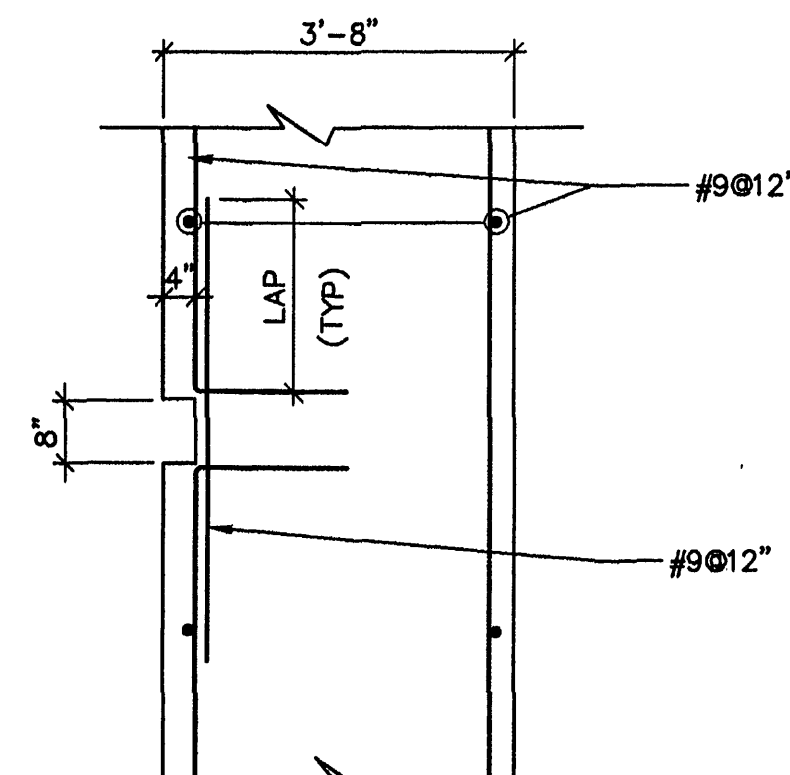


DETAIL 3
SCALE: 1/2"=1'-0"

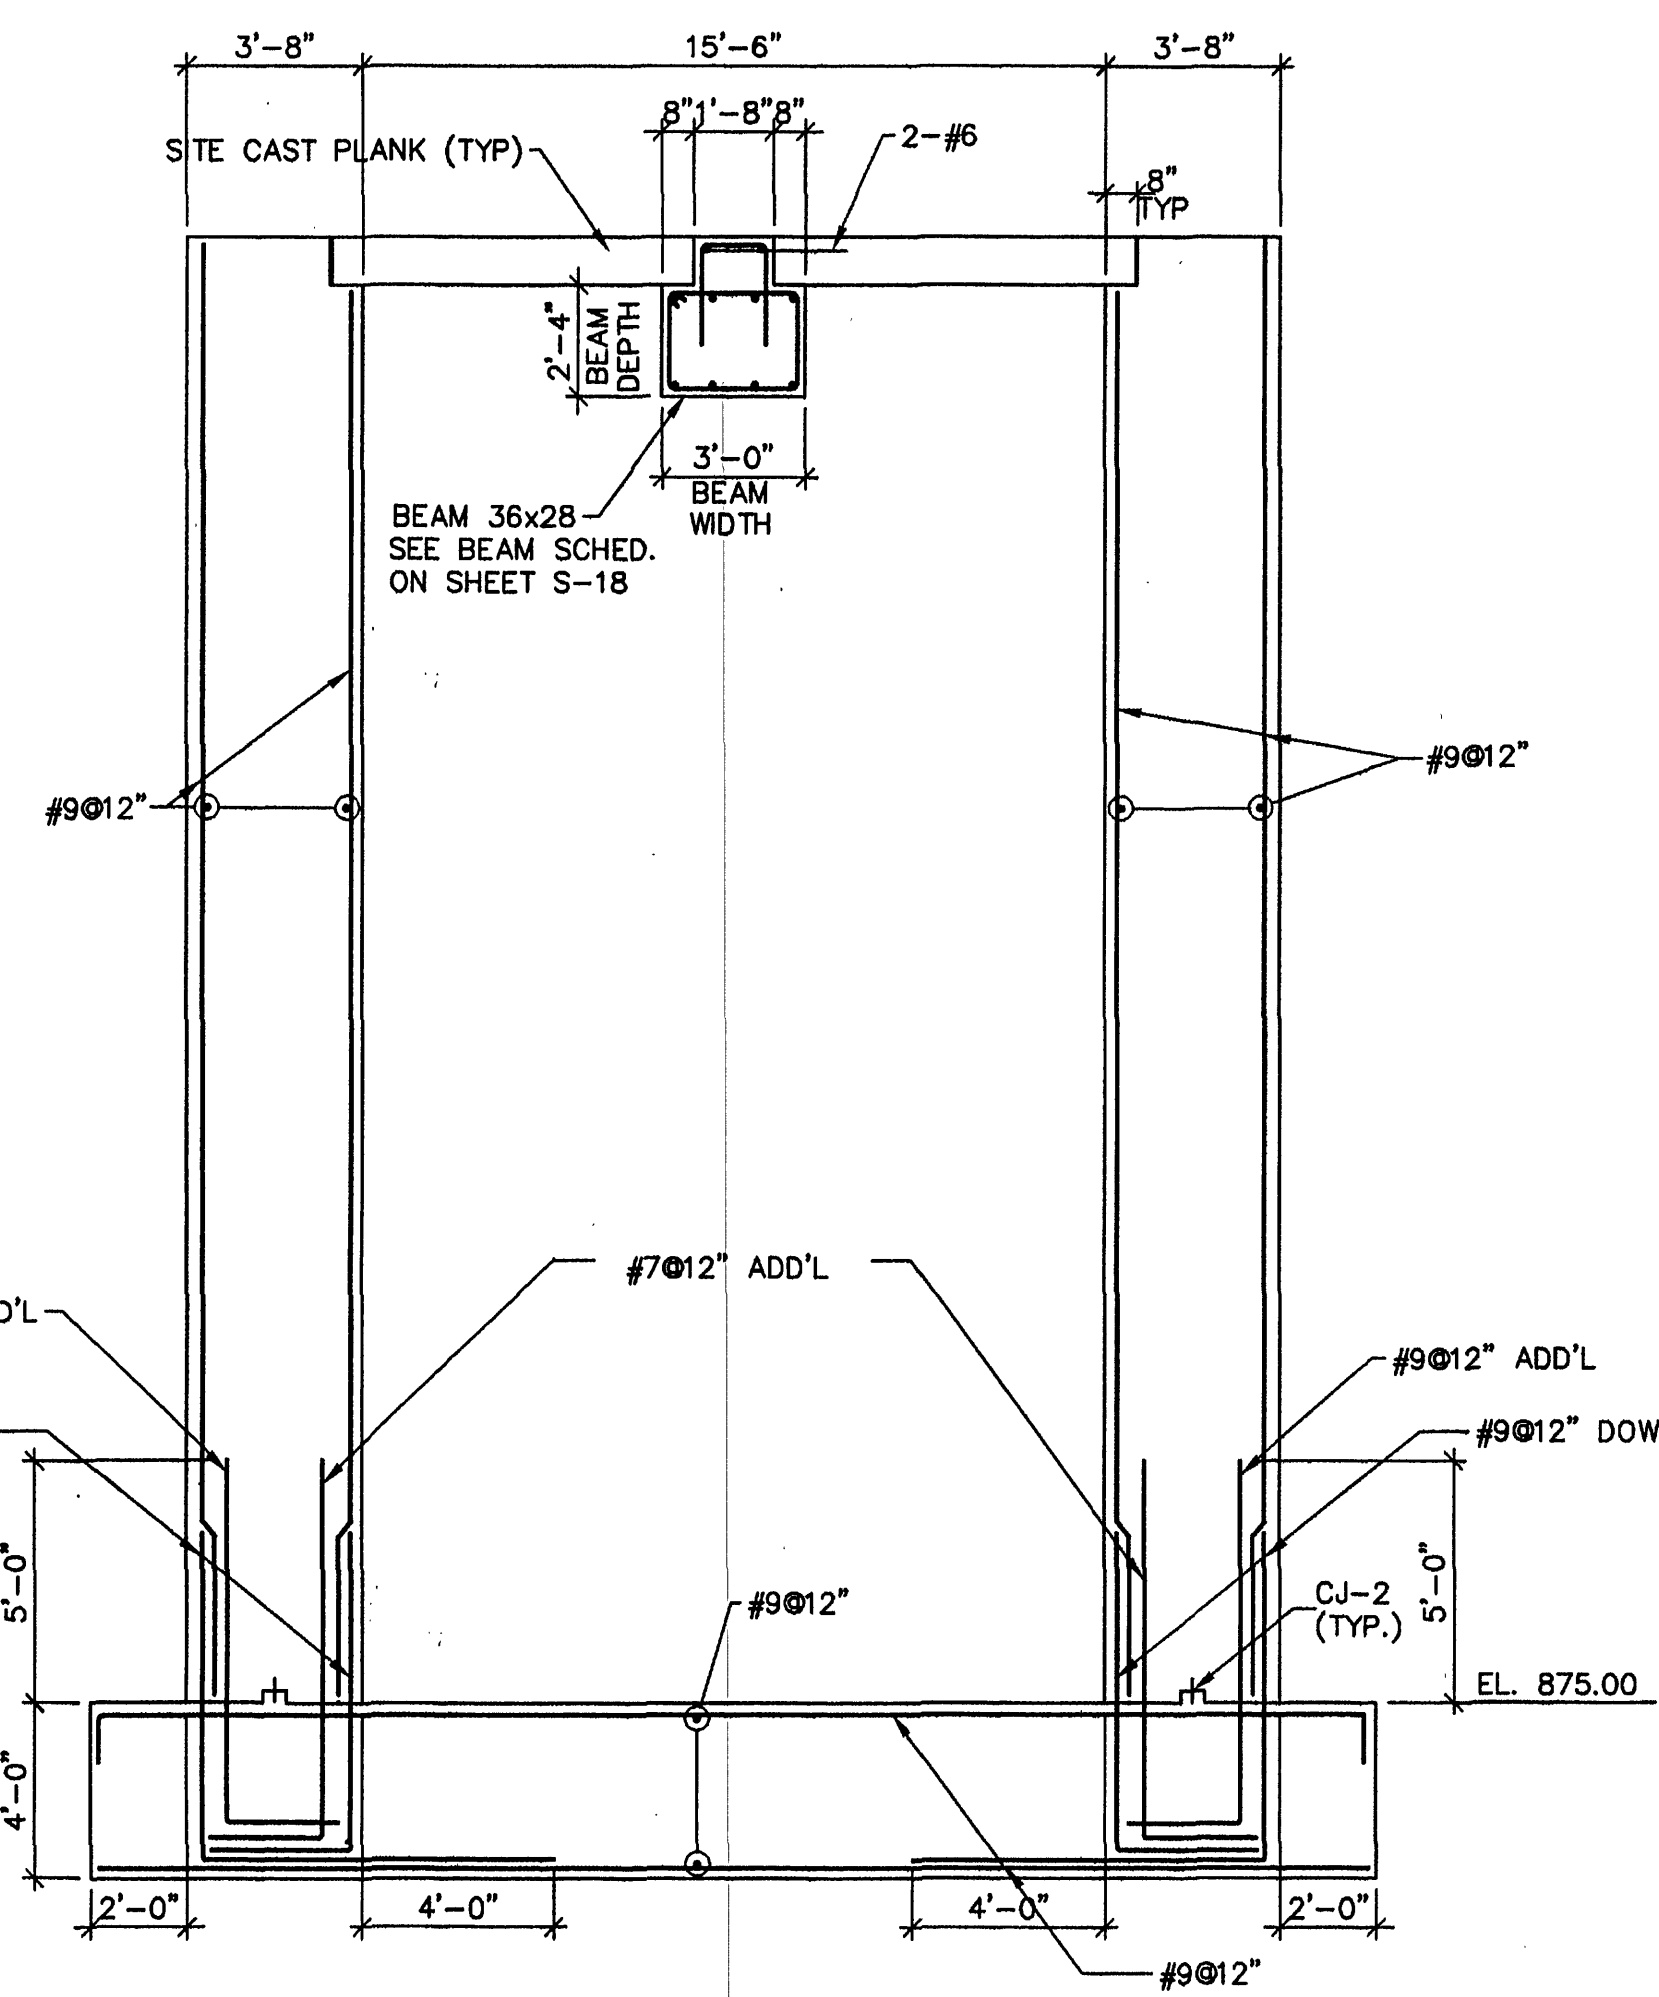


SECTION 2
SCALE: 1/4"=1'-0"

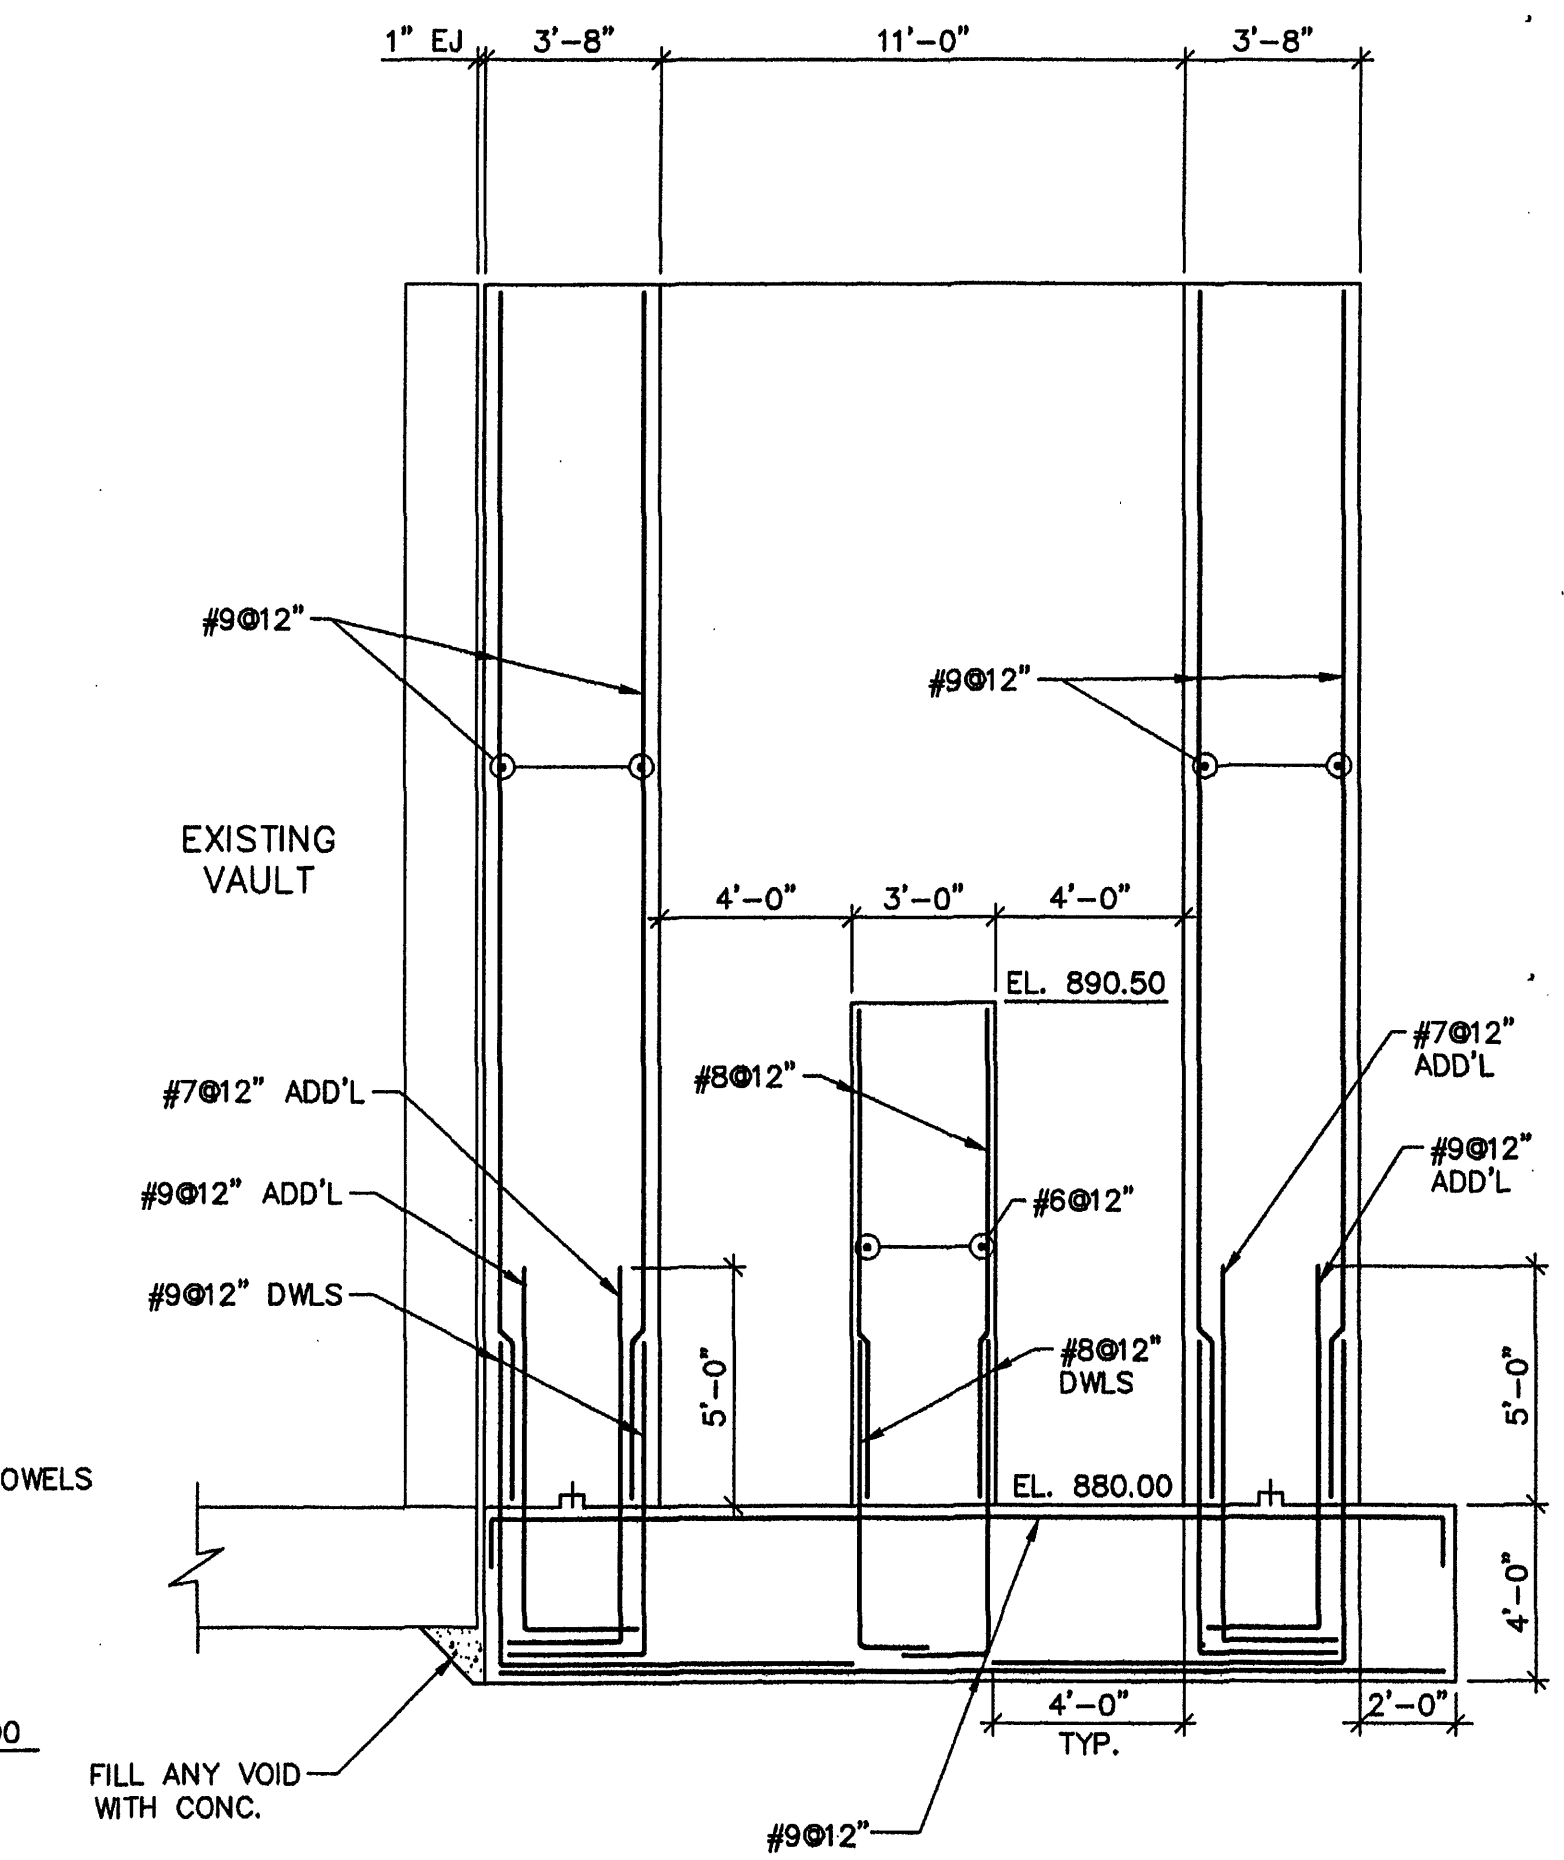


SECTION 3
SCALE: 1/4"=1'-0"

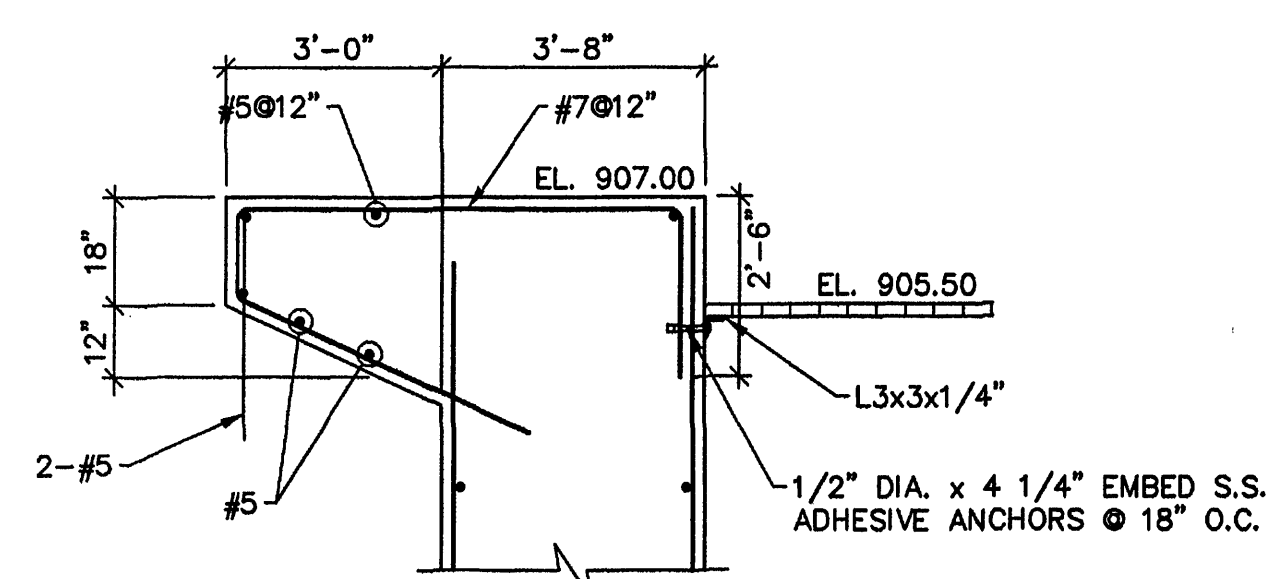

SECTION 4
SCALE: 3/8"=1'-0"

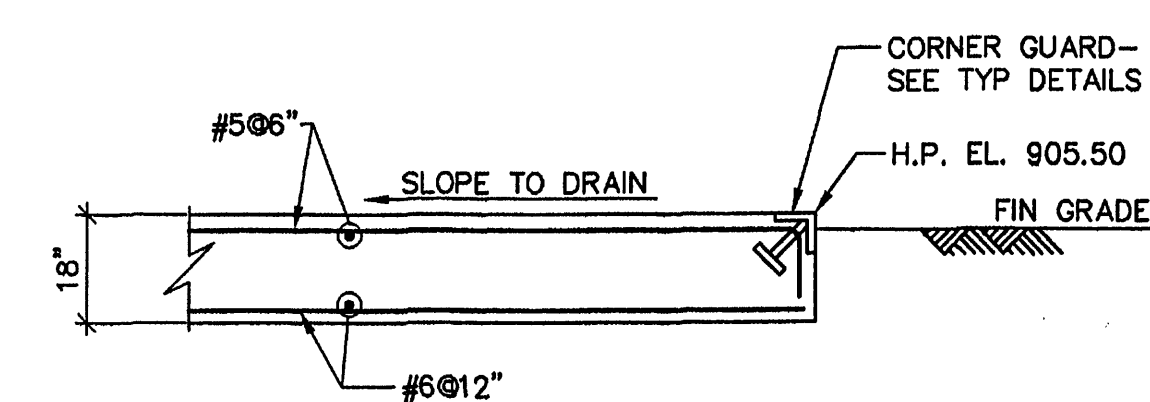

SECTION 5
SCALE: 3/8"=1'-0"

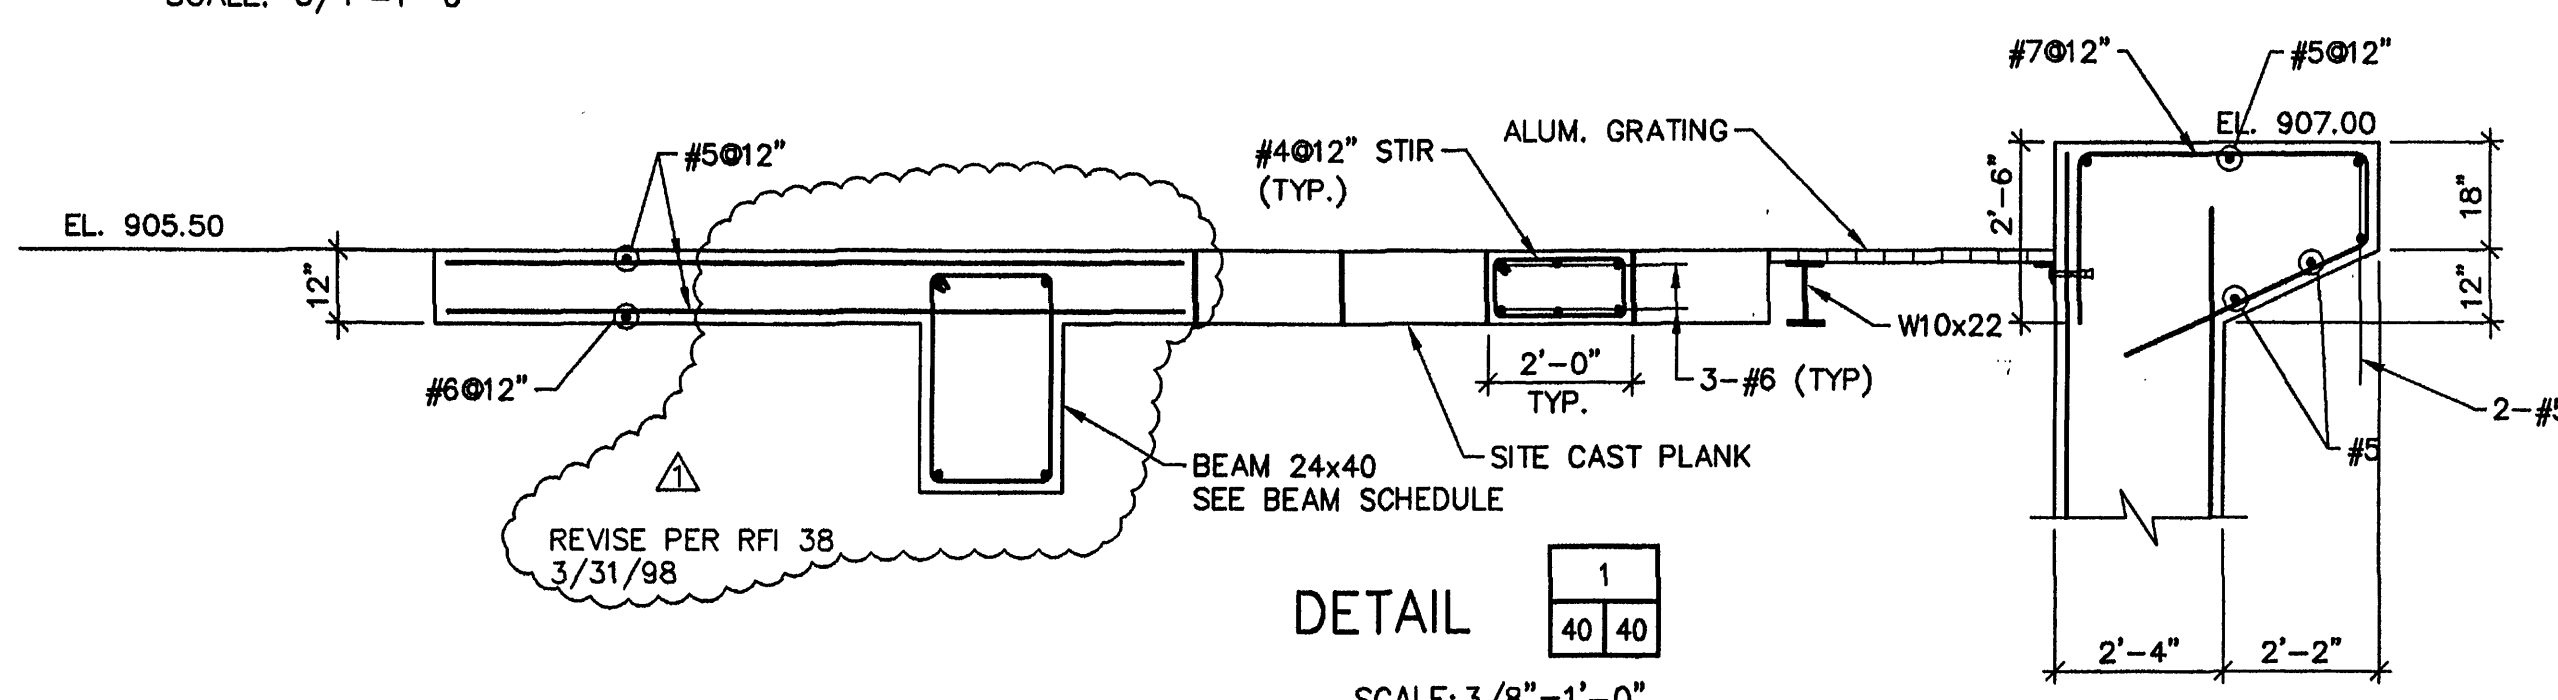

DETAIL 4
SCALE: 3/8"=1'-0"

**MALCOLM
PIRNIE**
11832 Rock Landing Drive, Suite 400
Newport News, Virginia 23606

REVISIONS				REMARKS
NO.	BY	DATE	DESCRIPTION	
1	ARB	JAN. 2000	RECORD DRAWING	

DES -- EDC --
DWN -- EDC --
CKD -- DB --



CITY OF ROANOKE, VIRGINIA
WATER POLLUTION
CONTROL PLANT
UPGRADE AND EXPANSION

INFLUENT PUMP STATION
SECTIONS & DETAILS
SCALE: 1/4" = 1'-0"

COPYRIGHT © 1997
MALCOLM PIRNIE, INC.
DATE -- MAY 1997 --
S SHEET 40 OF 44 --
CAD REF. NO. 0060371