




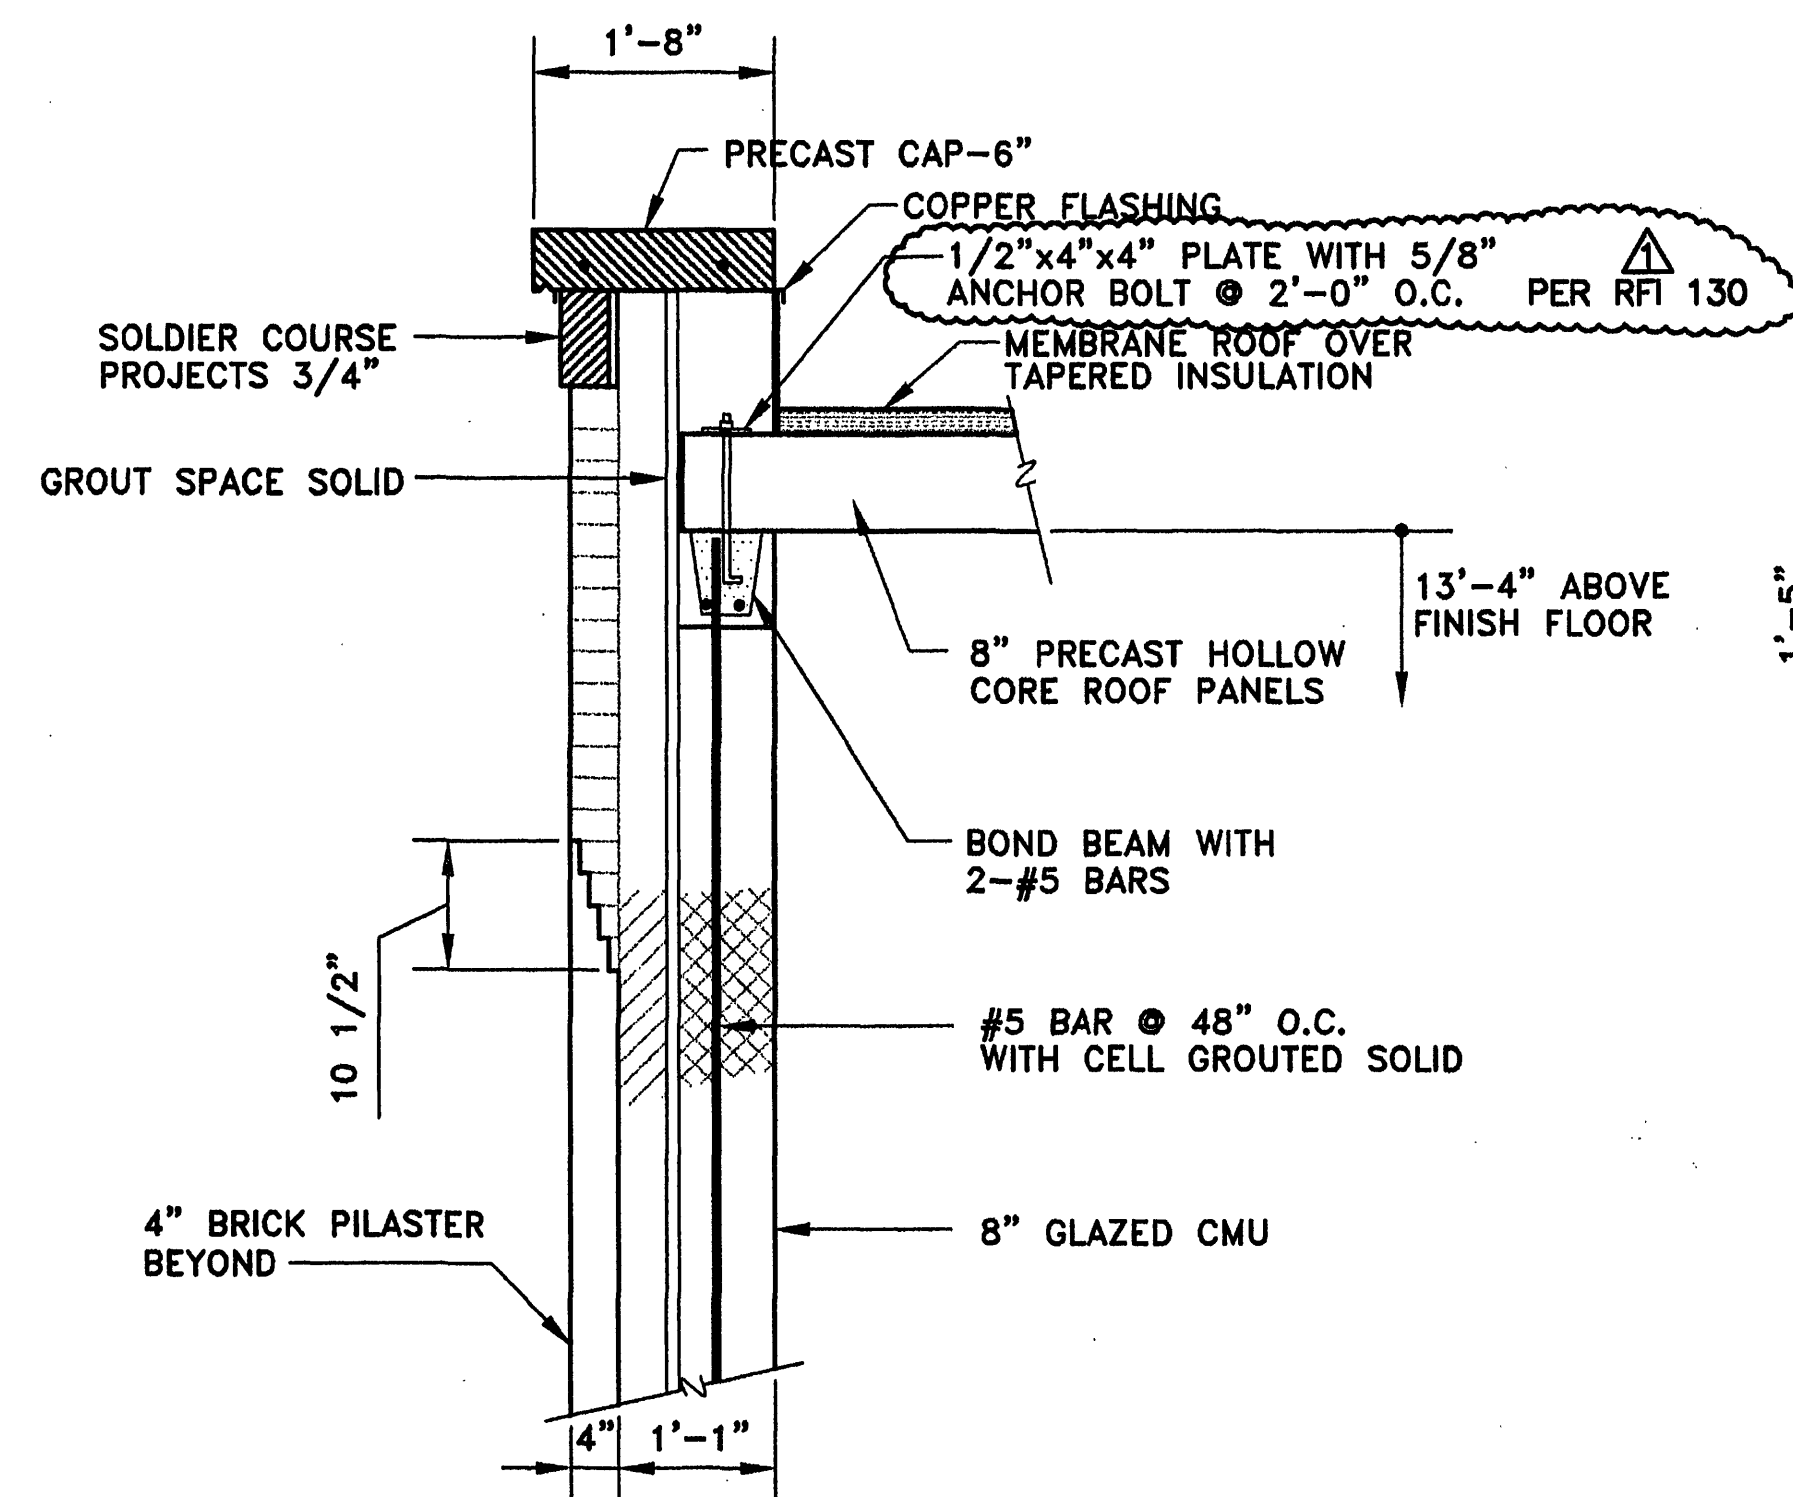


SECTION 1
SCALE: 3/4"=1'-0"

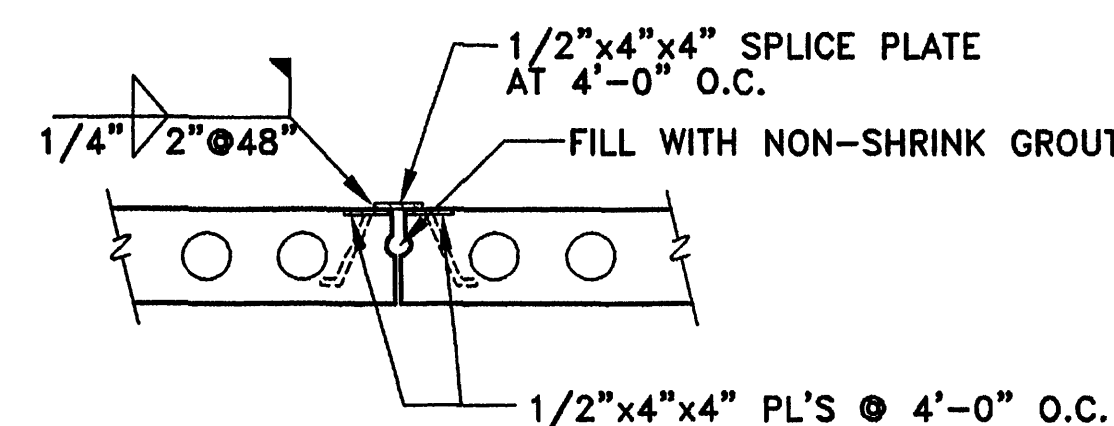


TYPICAL PRECAST HOLLOW CORE ROOF PANEL SIDE CONNECTION
SCALE: 3/4"=1'-0"

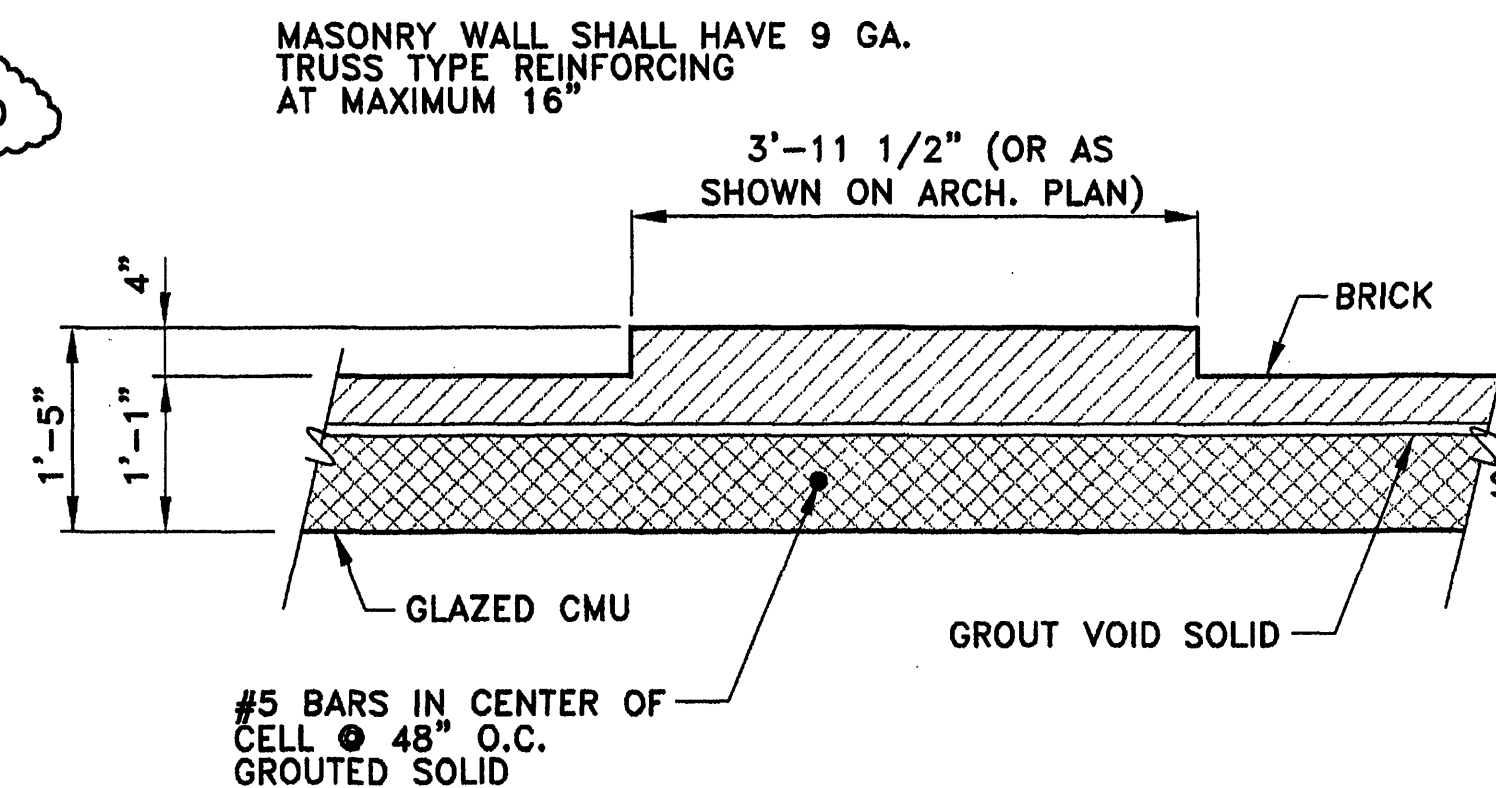

PILASTER DETAIL
SCALE: 3/4"=1'-0"

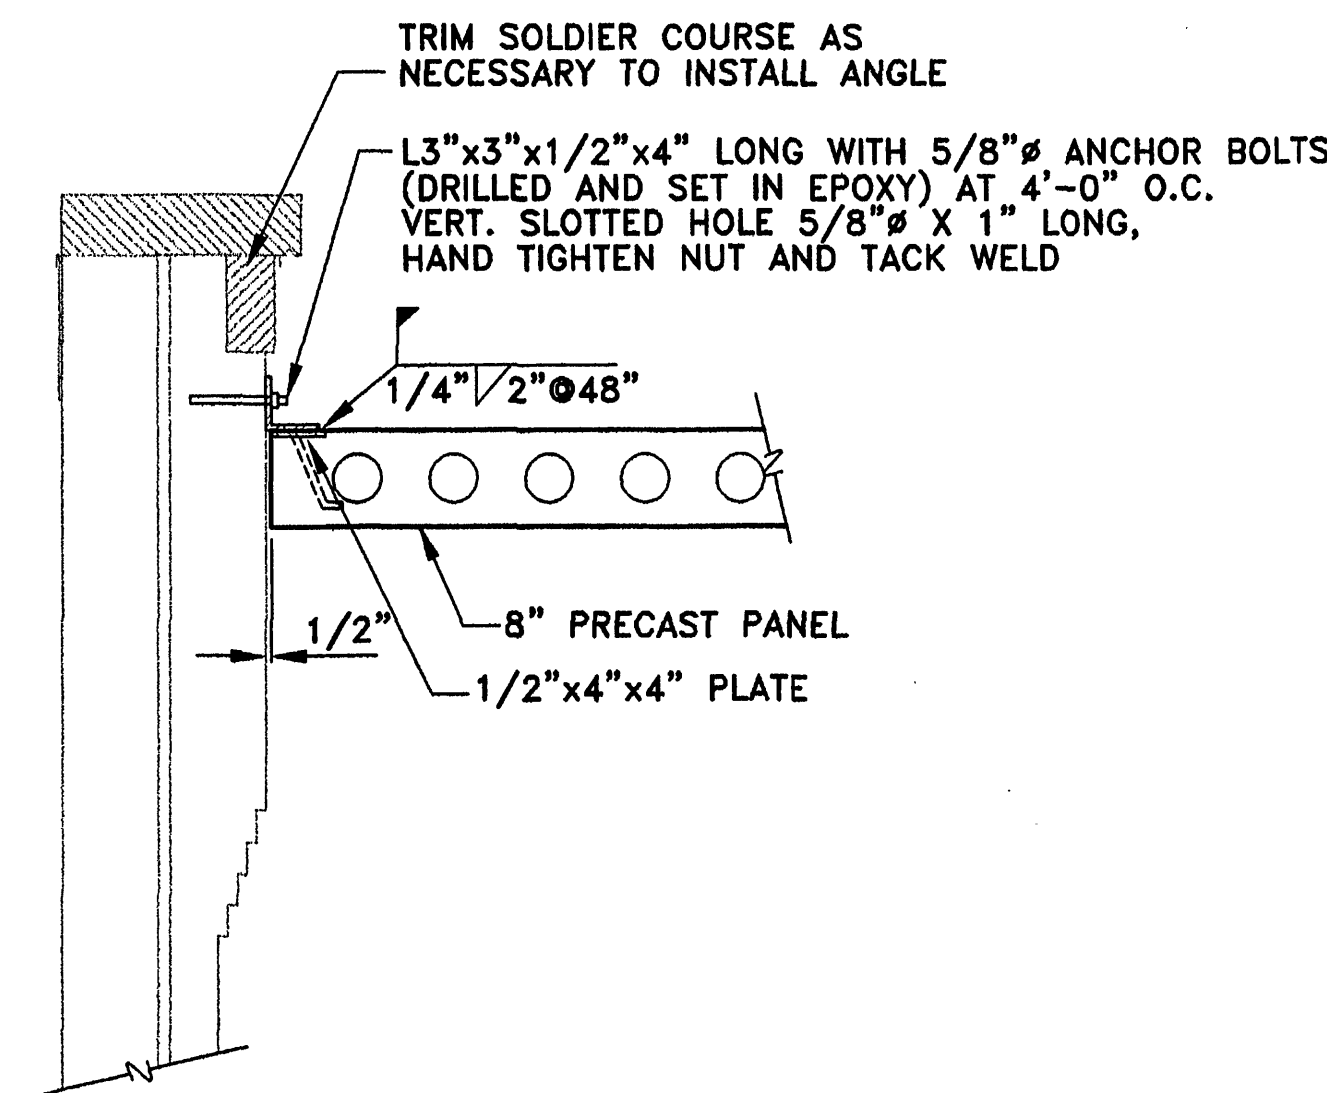


SECTION 4
SCALE: 3/4"=1'-0"

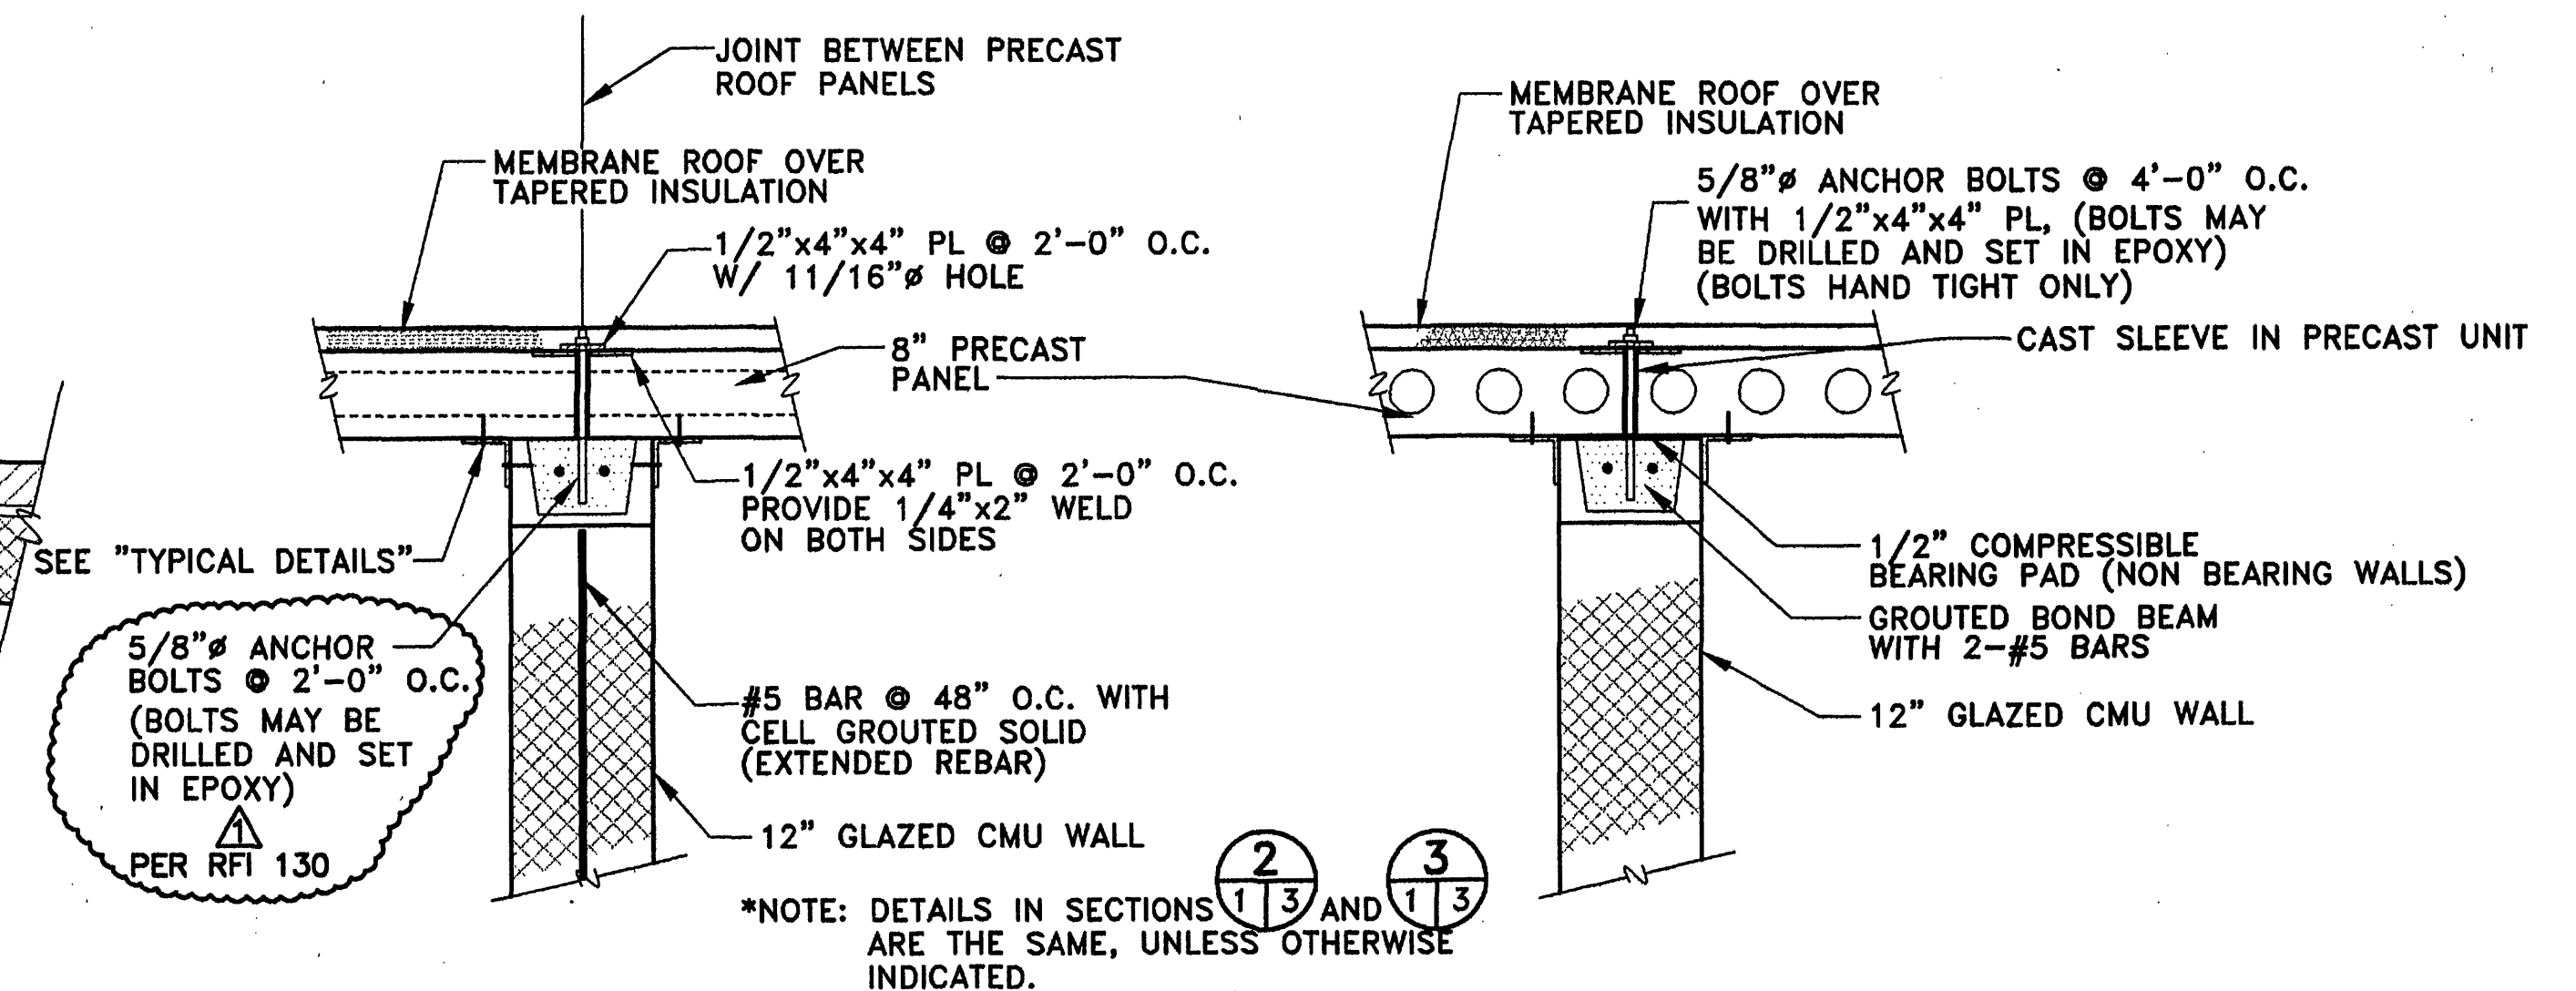


SECTION 2
SCALE: 3/4"=1'-0"


SECTION 3
SCALE: 3/4"=1'-0"

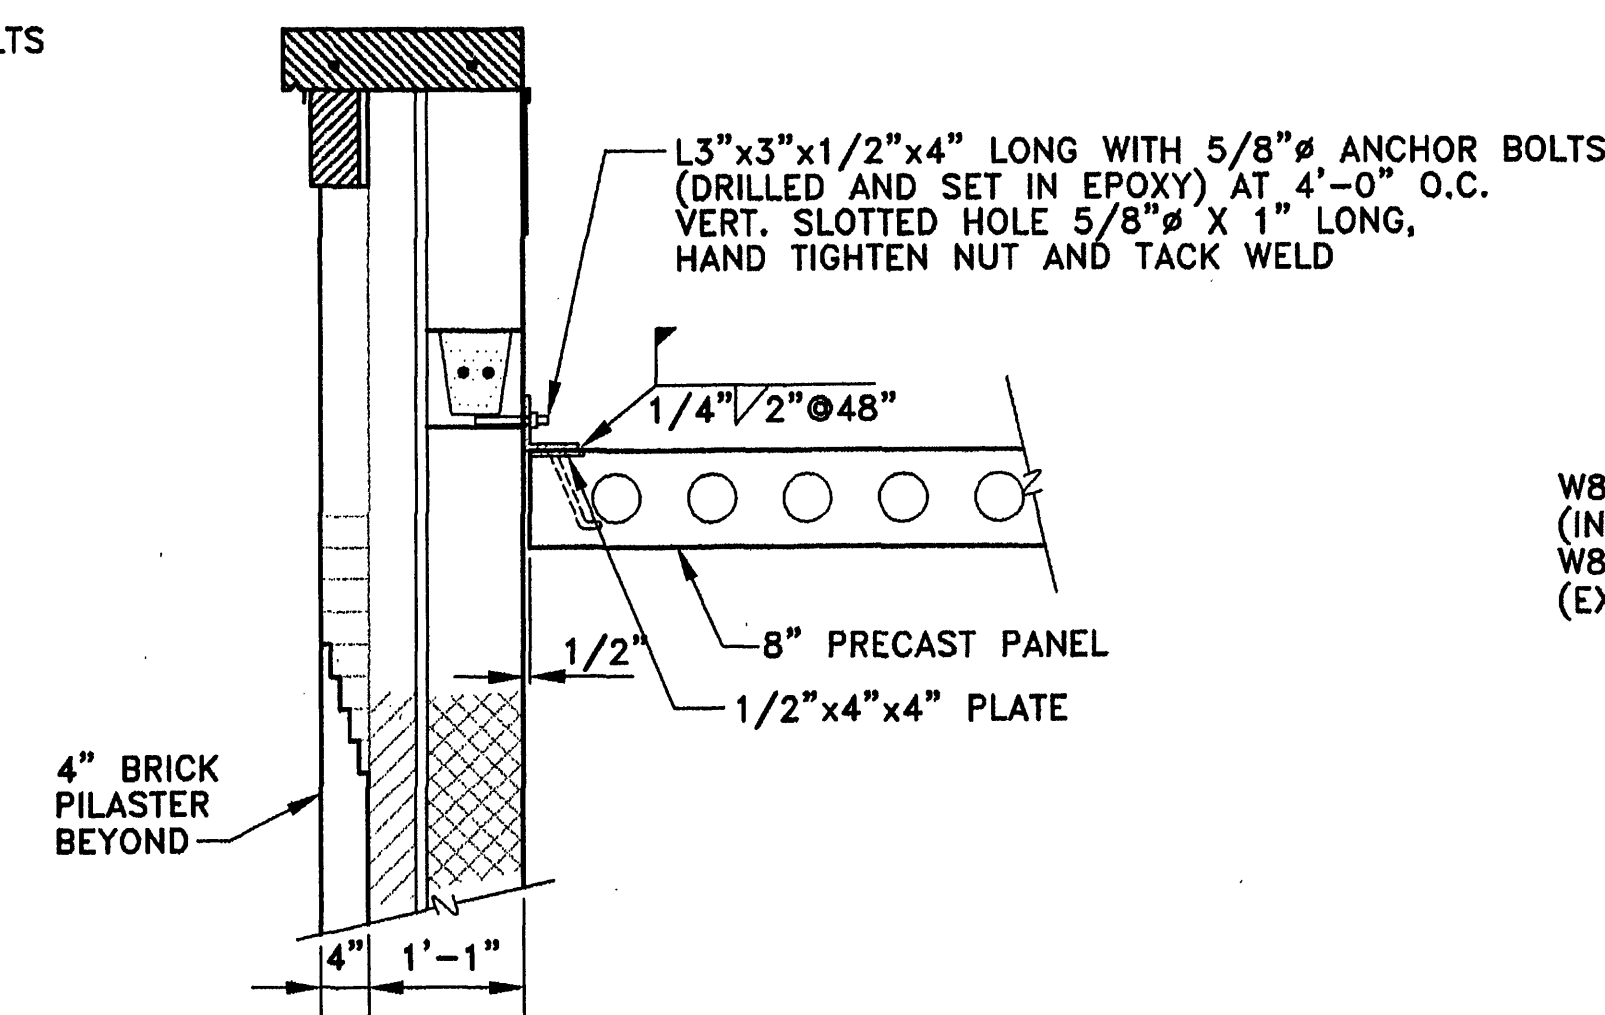


SECTION 5
SCALE: 3/4"=1'-0"

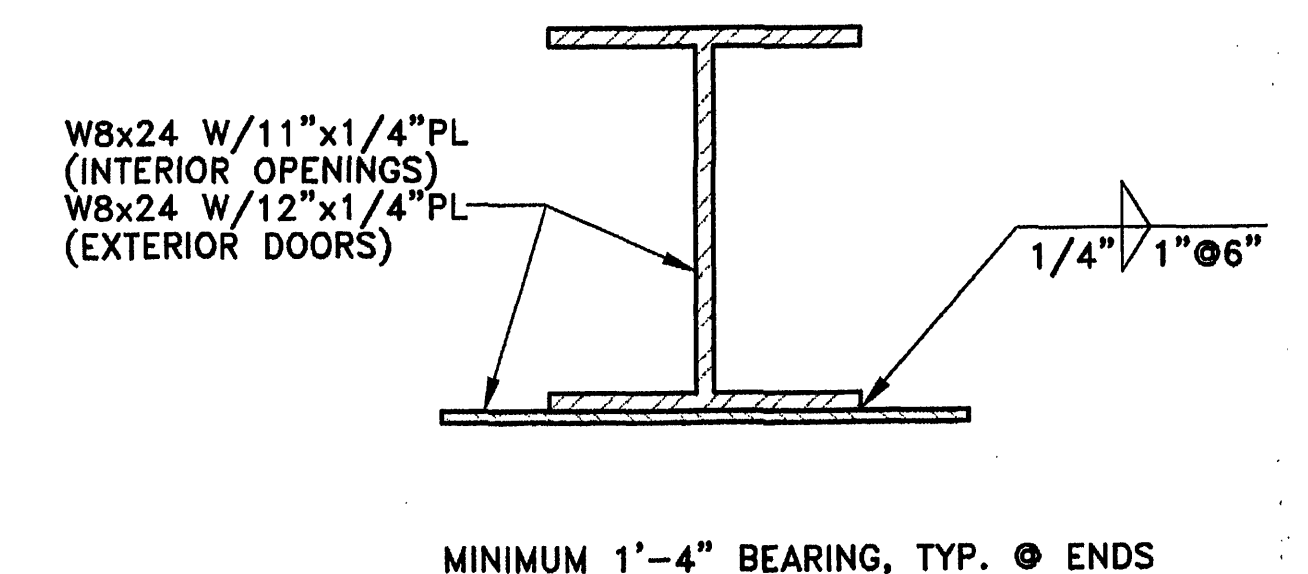

LINTEL DETAIL FOR NEW DOORS IN FILTER BUILDING
SCALE: 3"=1'-0"

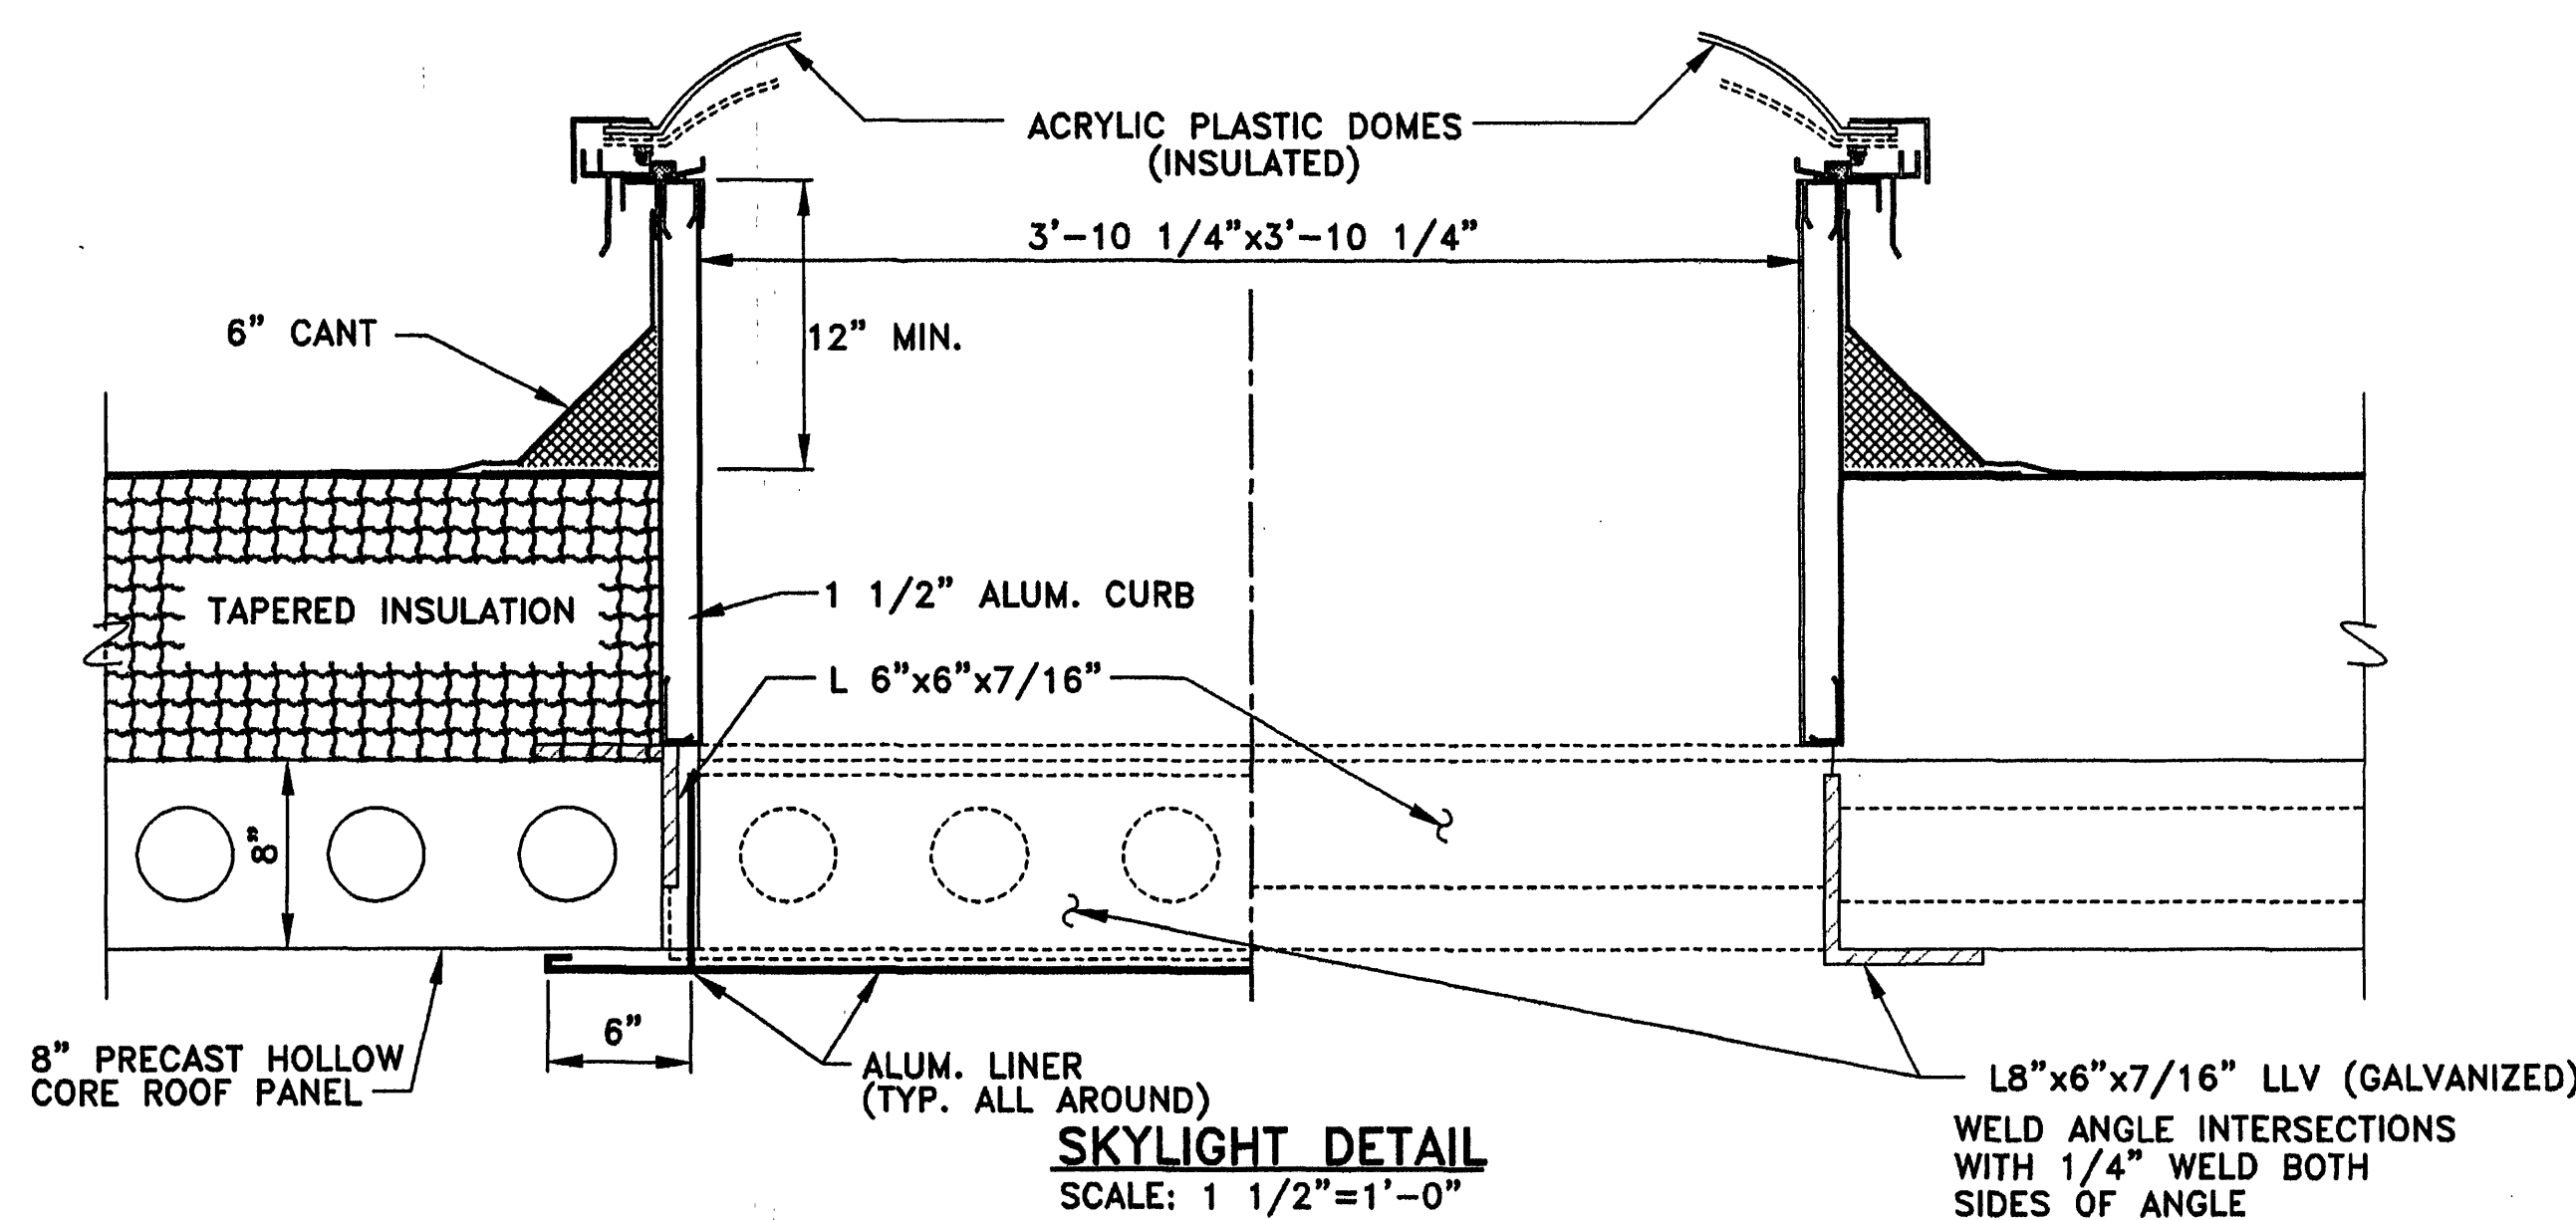


SKYLIGHT DETAIL
SCALE: 1 1/2"=1'-0"

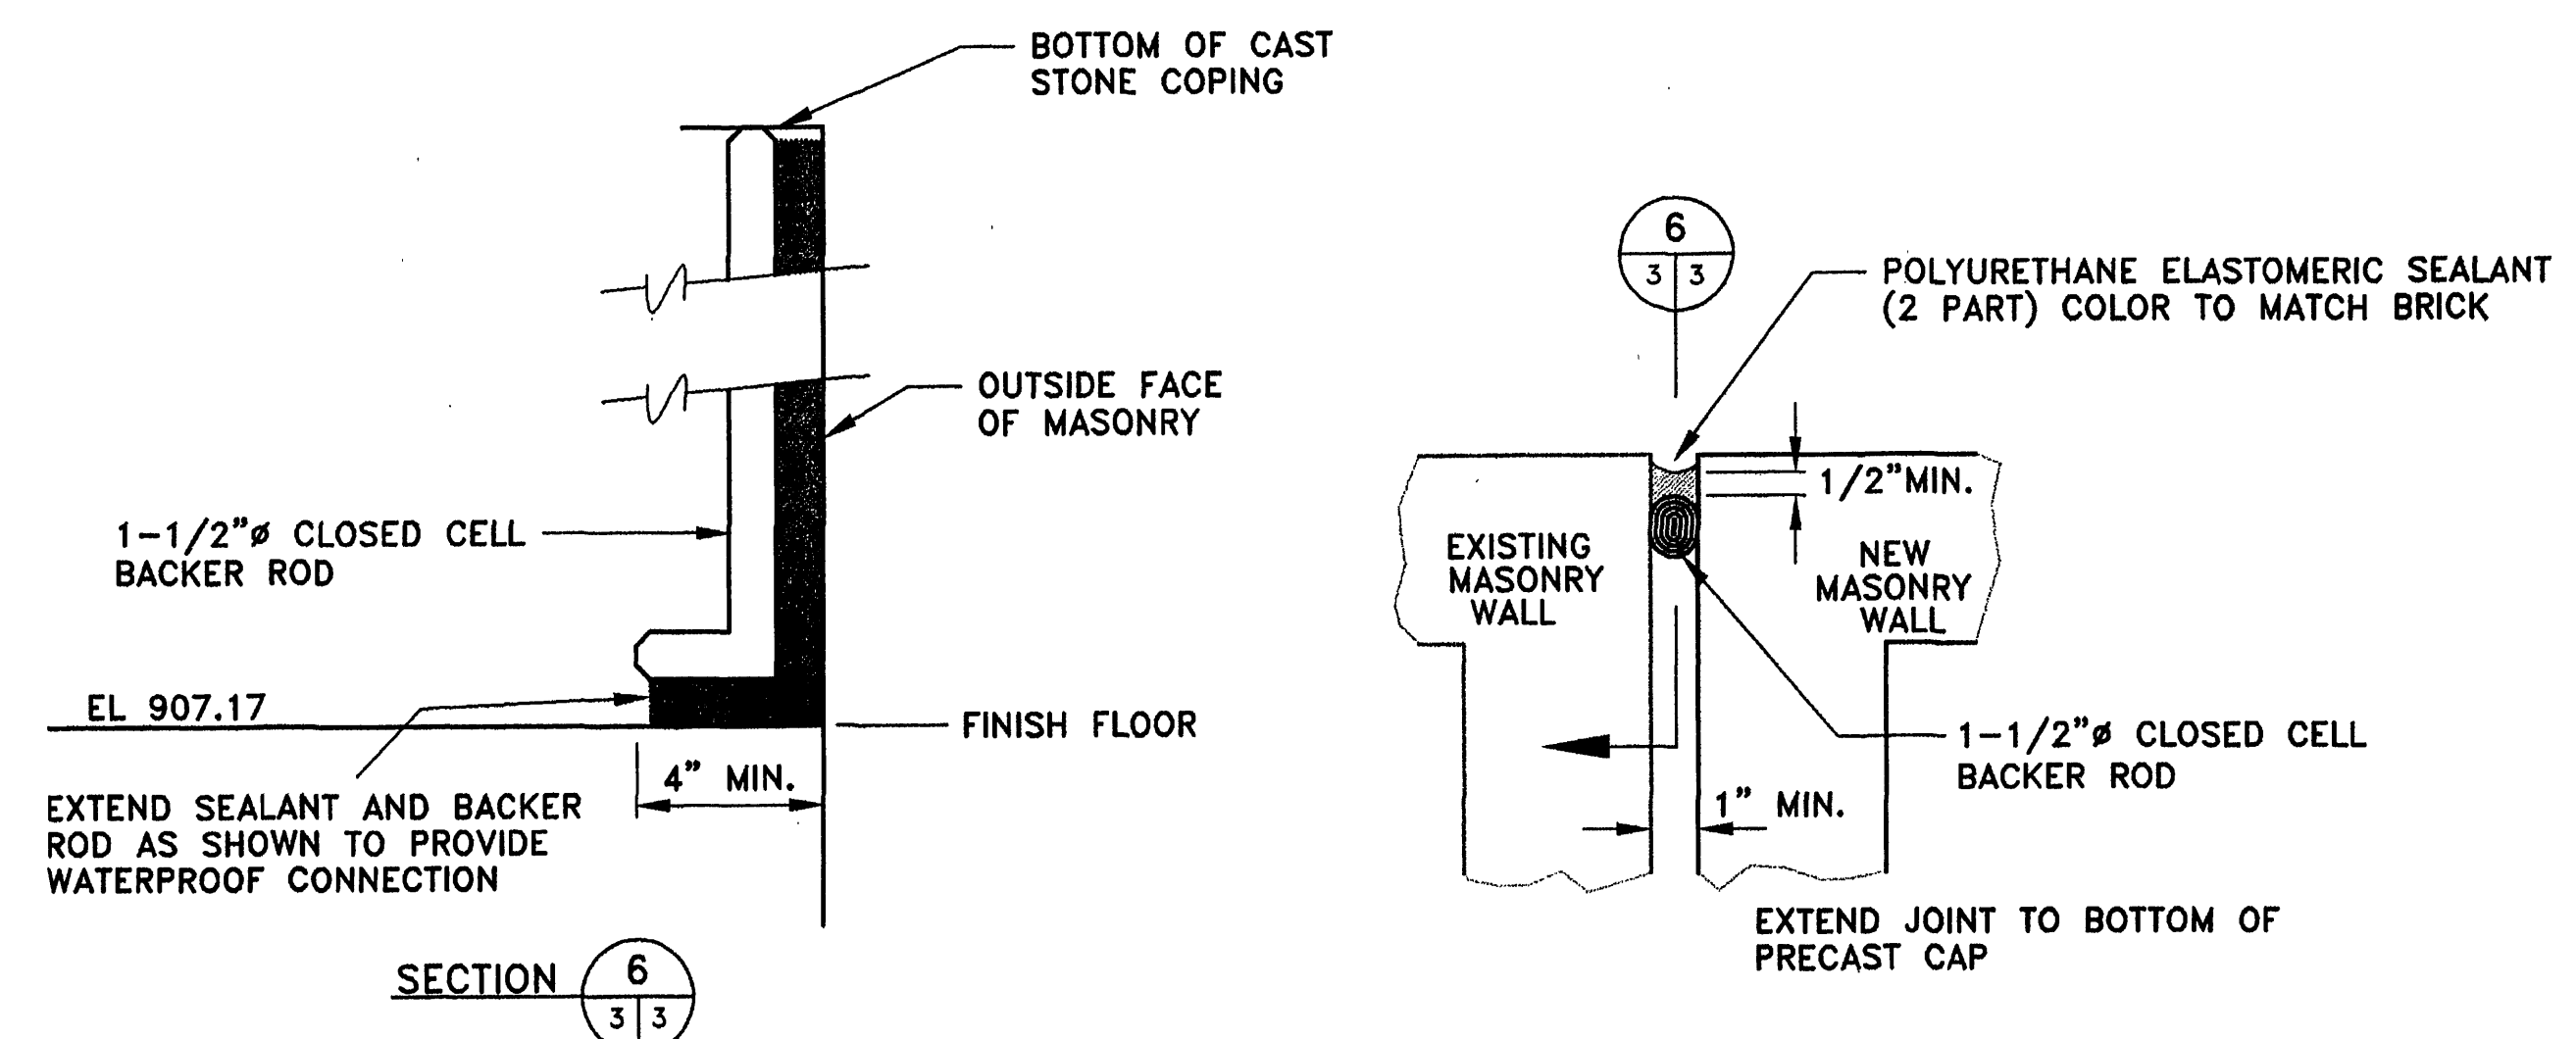

SECTION 6
SCALE: 3"=1'-0"

EXPANSION JOINT DETAIL
SCALE: 3"=1'-0"
(AT ALL LOCATIONS WHERE NEW MASONRY ABUTS EXISTING)

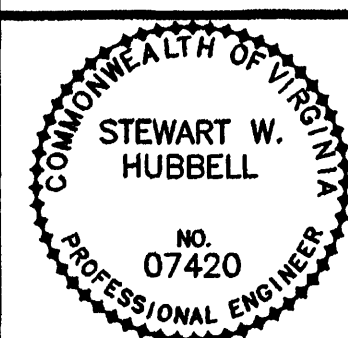

Mattern & Craig, Inc.
CONSULTING ENGINEERS - SURVEYORS
101 FIRST STREET, S.W.
ROANOKE, VIRGINIA 24005
(800) 545-0000
(800) 545-7001 FAX

REVISIONS				REMARKS
NO.	BY	DATE	RECORD	DRAWING
1	ARB	JAN. 2000		

DES. NAB
DWN. LDL/ARB
CKD. SWH



CITY OF ROANOKE, VIRGINIA WATER POLLUTION CONTROL PLANT UPGRADE AND EXPANSION

EFFLUENT FILTERS
BUILDING SECTIONS
AND DETAILS
SCALE: AS SHOWN

DATE MAY, 1997
A SHEET 3 OF 5
CAD REF. NO. A3.DWG