



EFFLUENT FILTER FINISH SCHEDULE						
AREA	FLOOR	BASE	WALLS	CEILING	CLG. HGT.	REMARKS
	CONCRETE QUARRY TILE	GLAZED CMU SOUND DAMPENING BLOCK (PAINTED)	BRICK WALL (EXISTING) - WEST WALL GLAZED CMU SOUND DAMPENING BLOCK (PAINTED)	BRICK WALL (EXISTING) - WEST WALL PRECAST PANELS (PAINTED) BAR JOISTS WITH STEEL DECK		
HALLWAYS					12'-8"	
FILTER ROOMS 9&10					12'-8"	
BLOWER ROOM					12'-8"	TO BOTTOM OF JOISTS
STORAGE ROOM					12'-8"	

MAKE THE JOINTS ON THE GLAZED BLOCK UNIFORM AND MAKE THE COURSES OF THE FACE BRICK MATCH THE EXISTING AS CLOSE AS POSSIBLE.
PER RFI 126

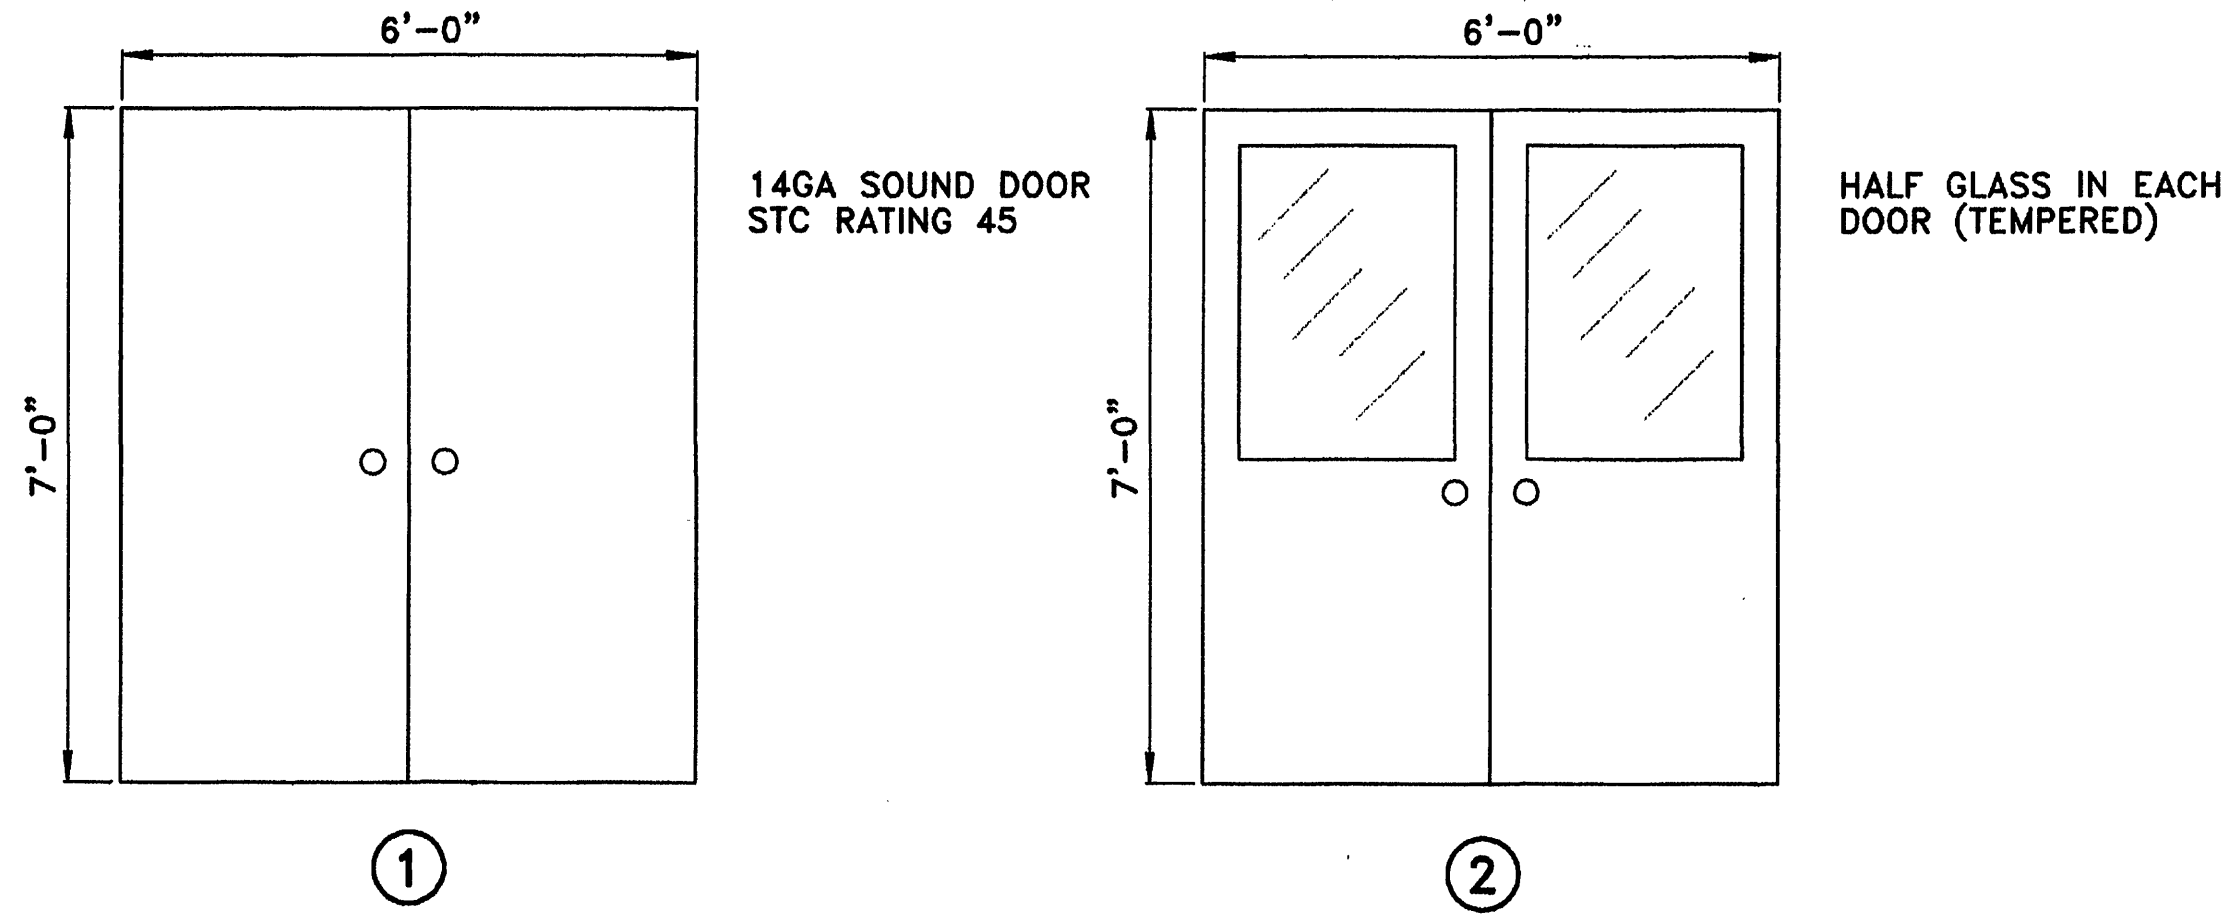

DOOR TYPE ELEVATIONS
NO SCALE

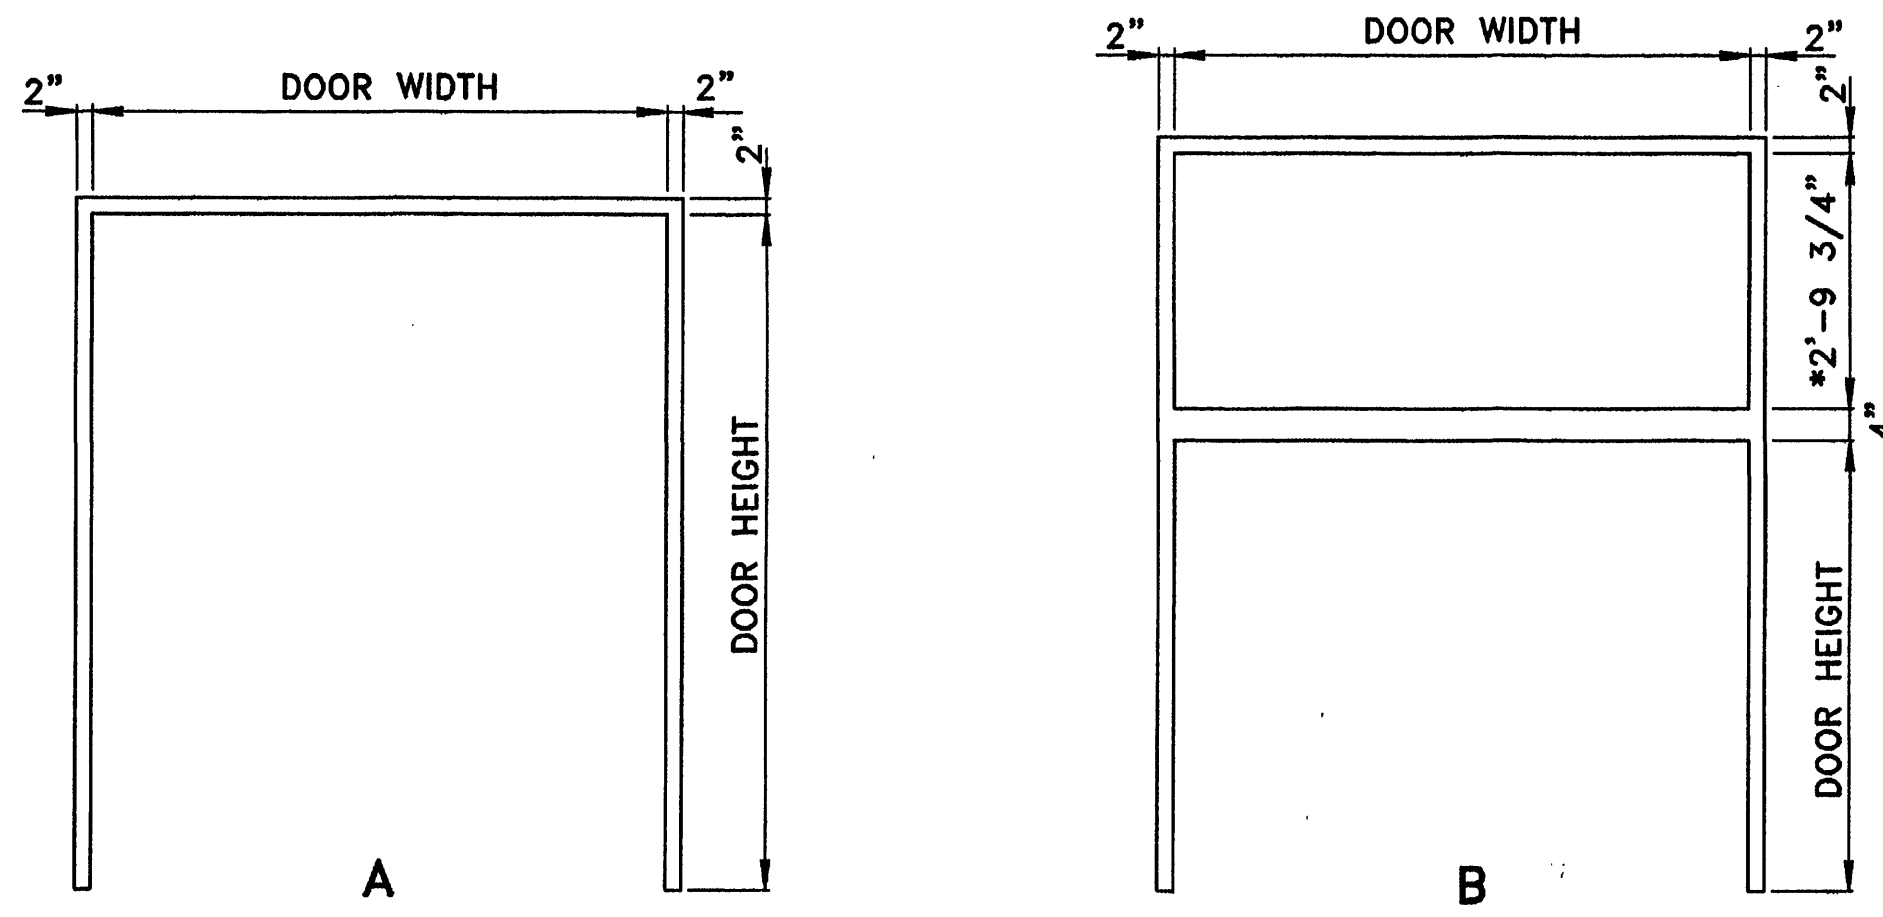


HOLLOW METAL FRAME ELEVATIONS
NO SCALE


* - VERIFY SIZE WITH FAN EQUIPMENT SUPPLIER.

EFFLUENT FILTER DOOR SCHEDULE									
MARK	SIZE	MATL	TYPE	FINISH	FRAME		THRES	HDW SET	REMARKS
					TYPE	FINISH			
1	6070 X 1 3/4	METAL	2	PAINT	B	PAINT	ALUM	1	HOLLOW METAL
2	6070 X 1 3/4	METAL	1	PAINT	A	PAINT	ALUM	1	HOLLOW METAL
3	6070 X 1 3/4	METAL	2	PAINT	A	PAINT	ALUM	1	HOLLOW METAL
4	6070 X 1 3/4	METAL	2	PAINT	B	PAINT	ALUM	1	HOLLOW METAL
5	6070 X 2	METAL	1	PAINT	A	PAINT	ALUM	1	SOUND DOOR STC 45 INSULATED DOOR UNIT


PER RFI 109
12/7/98

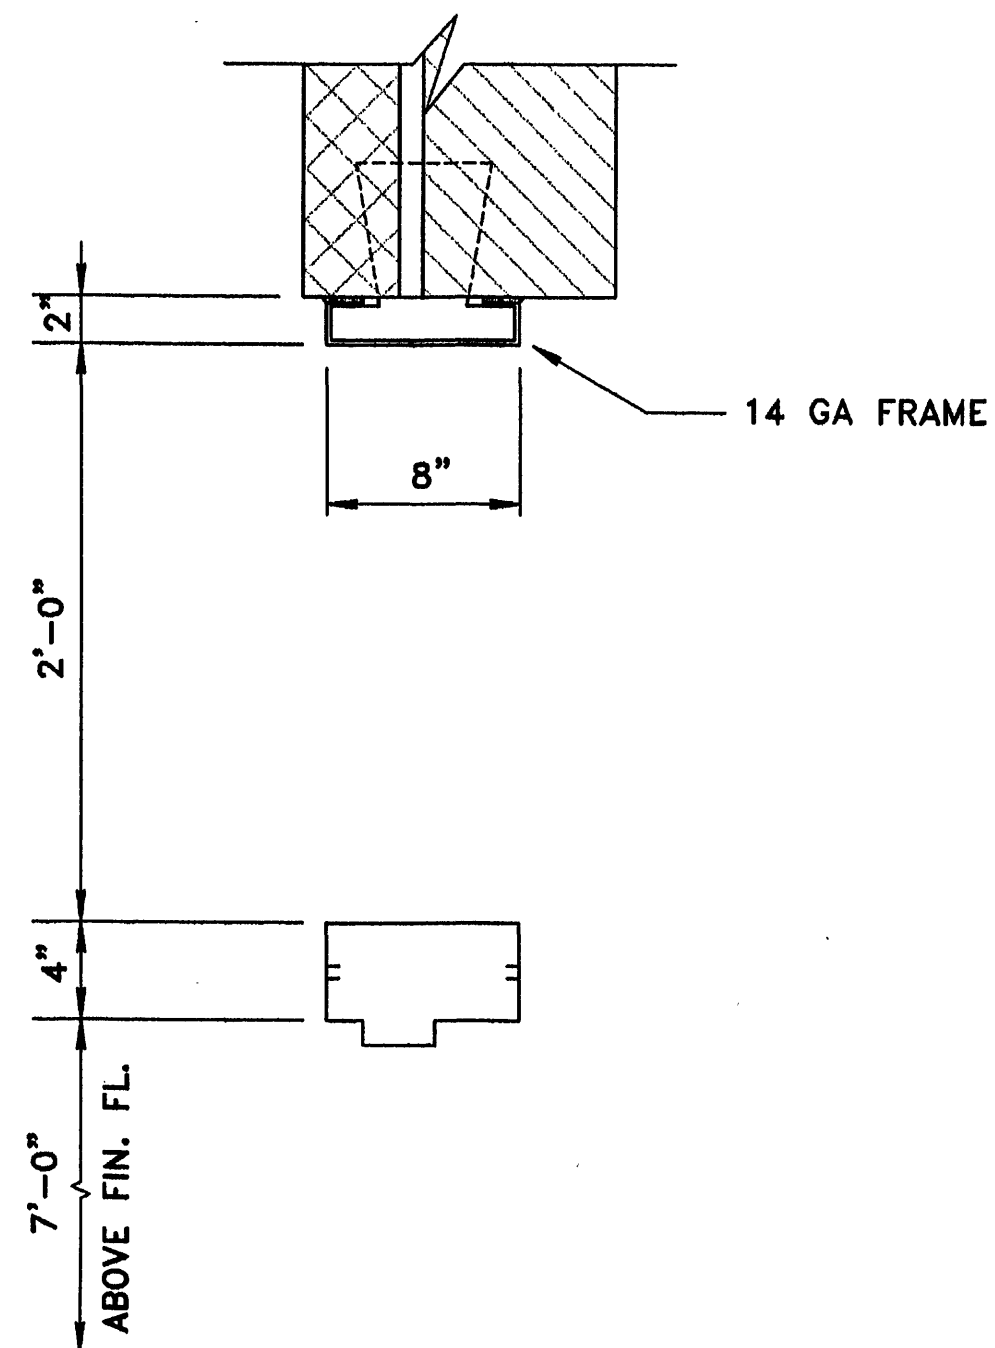

HOLLOW METAL HEAD
AT FILTER BUILDING
SCALE: 1 1/2" = 1'-0"

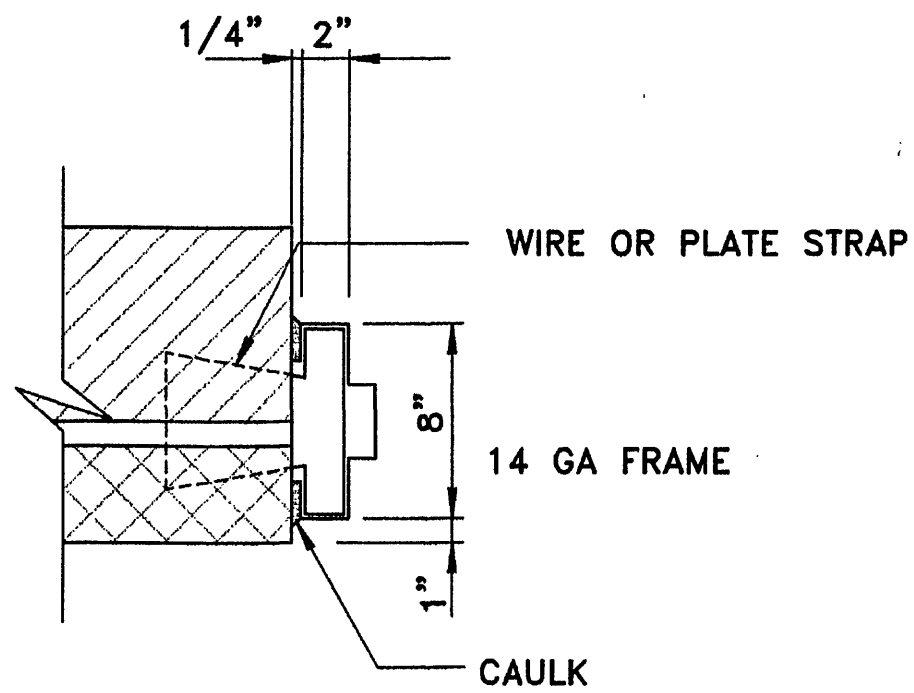

HOLLOW METAL FRAME
AT FILTER BUILDING
SCALE: 1 1/2" = 1'-0"

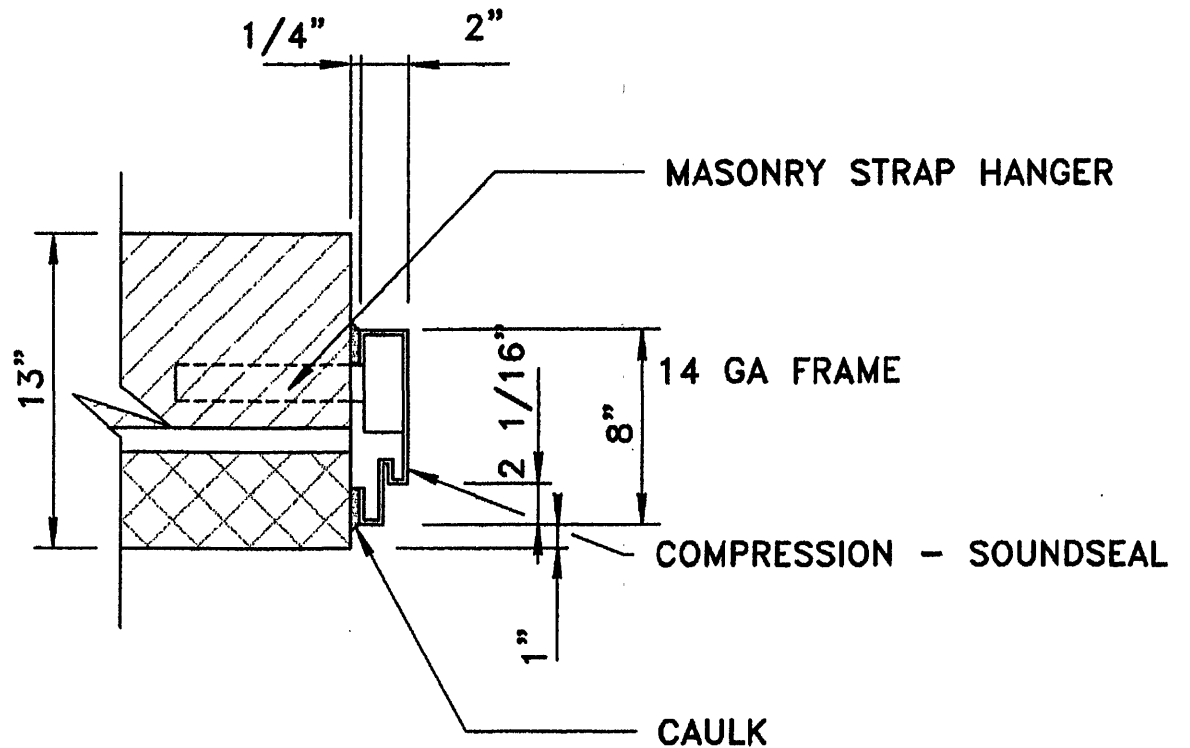

HOLLOW METAL FRAME AT SOUND
DOOR IN BLOWER ROOM
NOTE: HEAD AND JAMB PROFILE AT BLOWER BUILDING THE SAME
SCALE: 1 1/2" = 1'-0"