



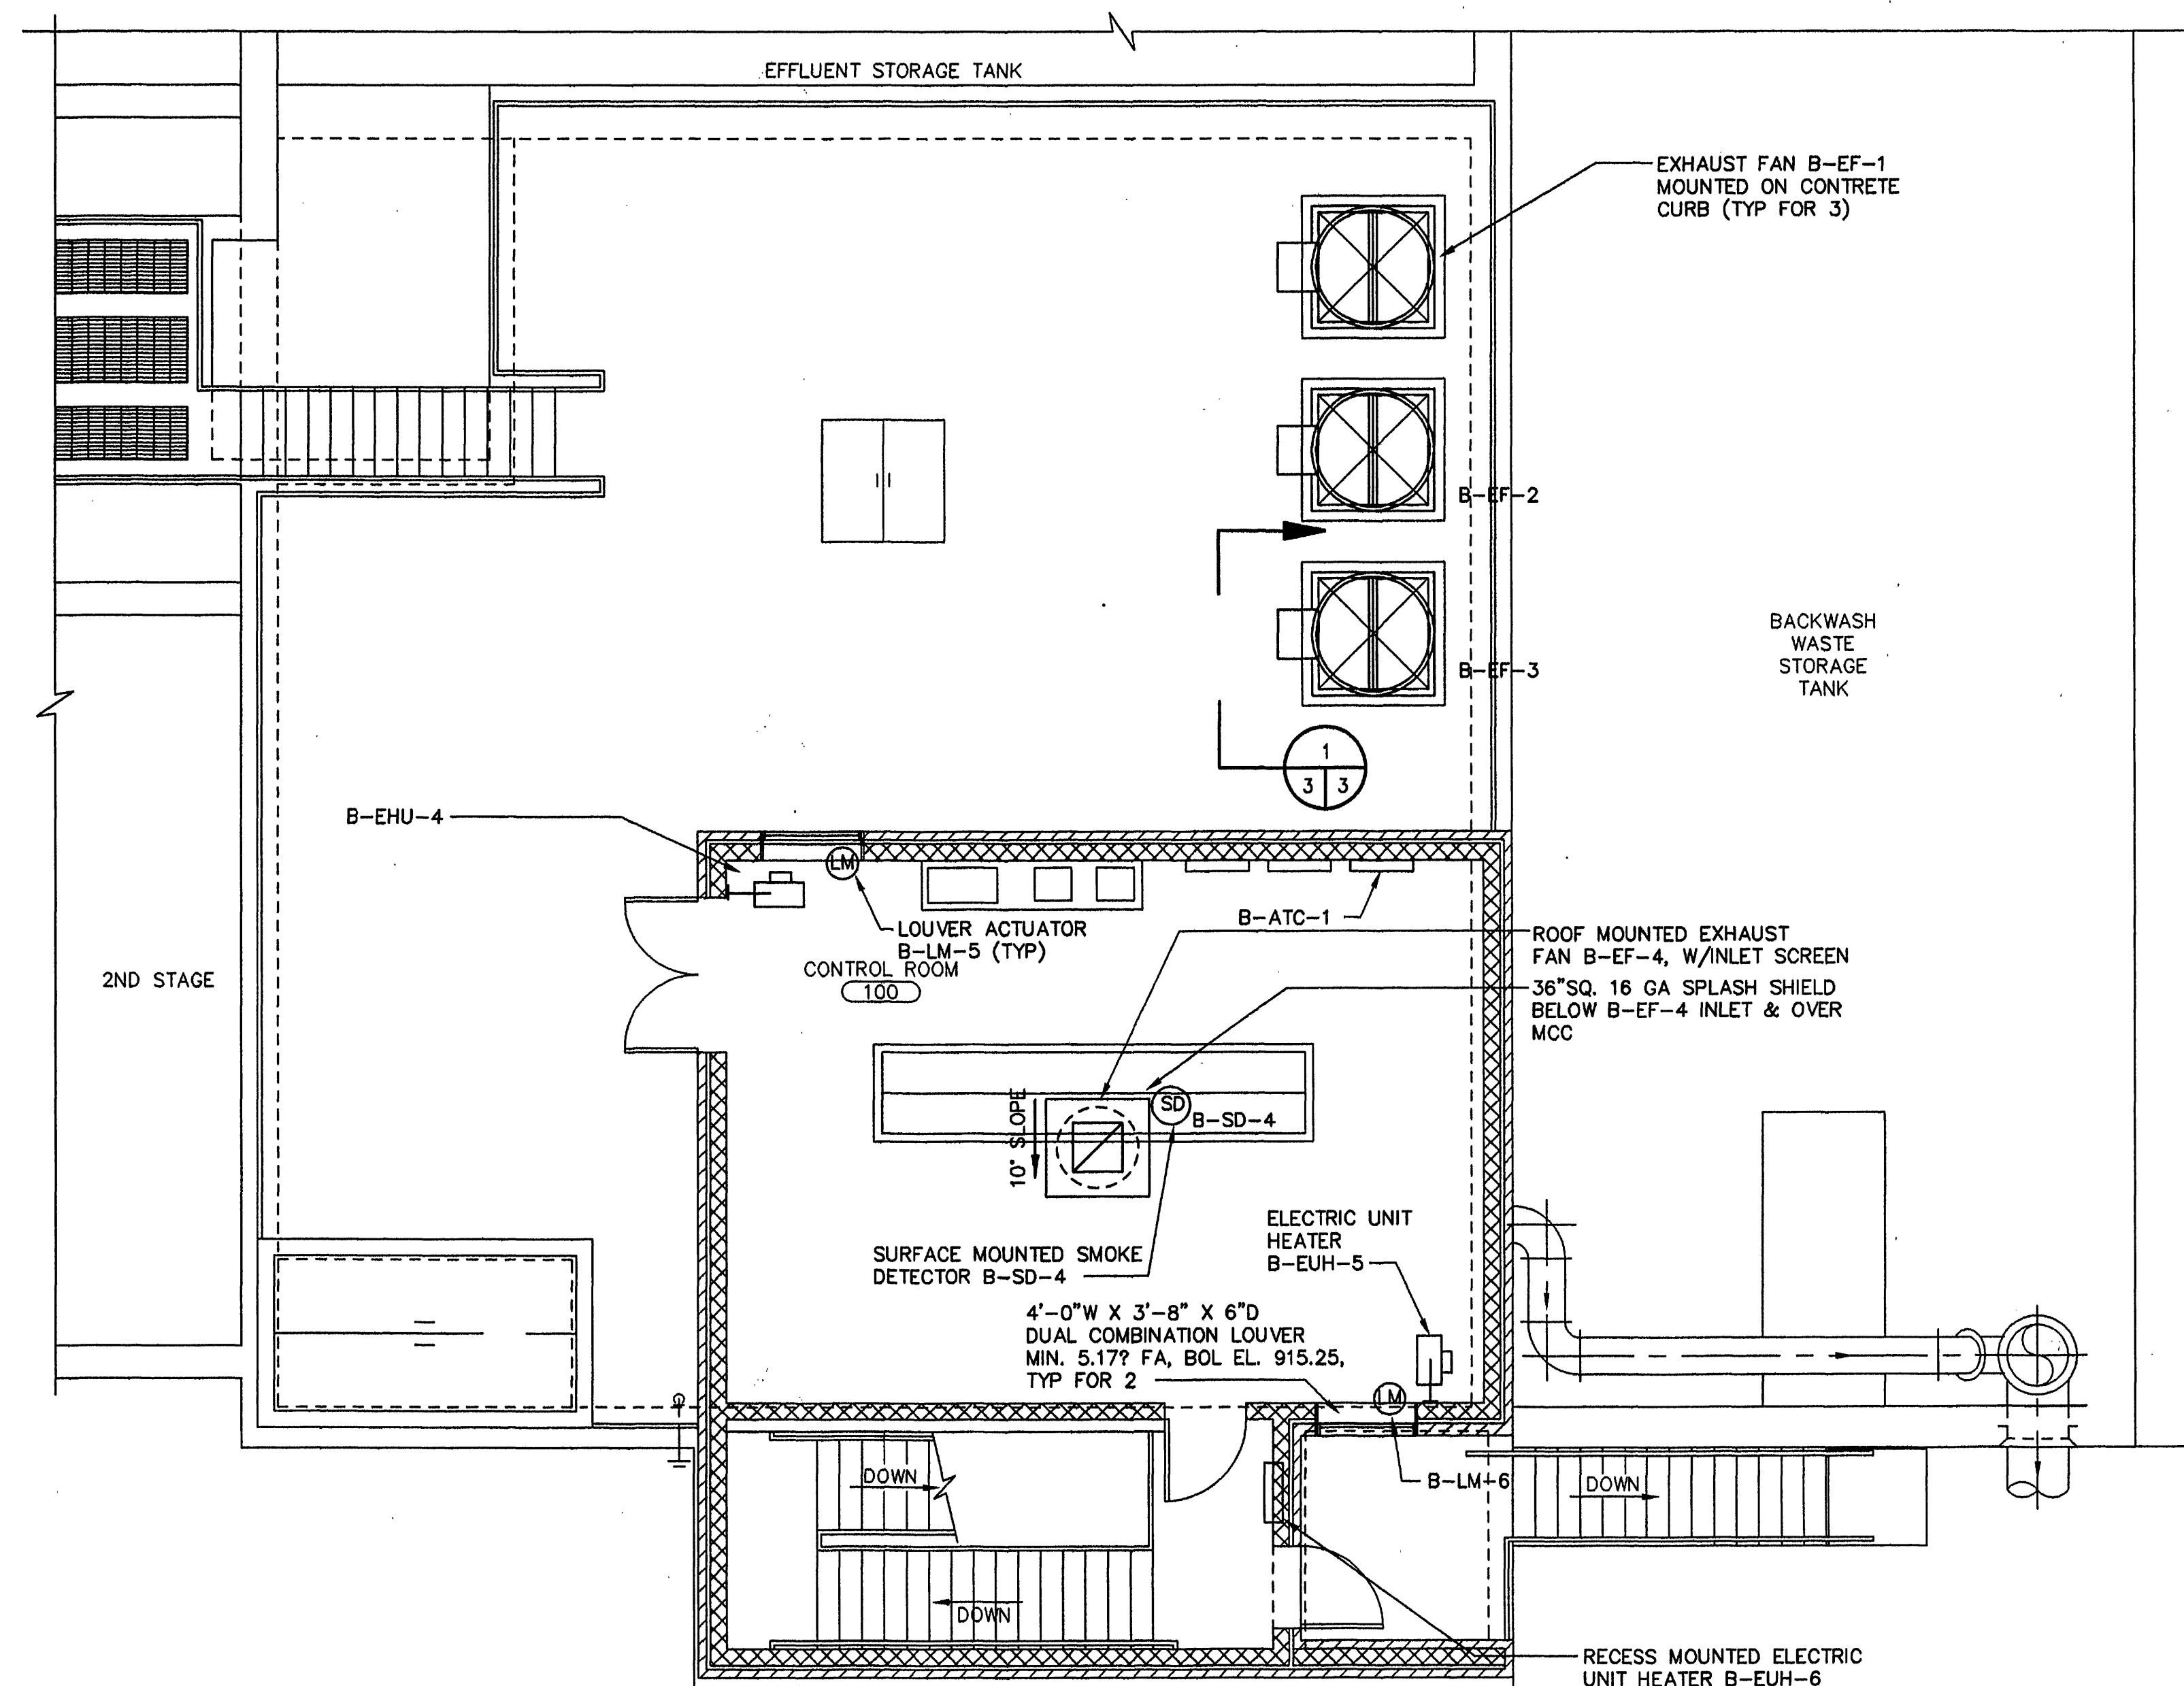

PLAN AT EL. 914.58

SCALE: 3/16" = 1'-0"

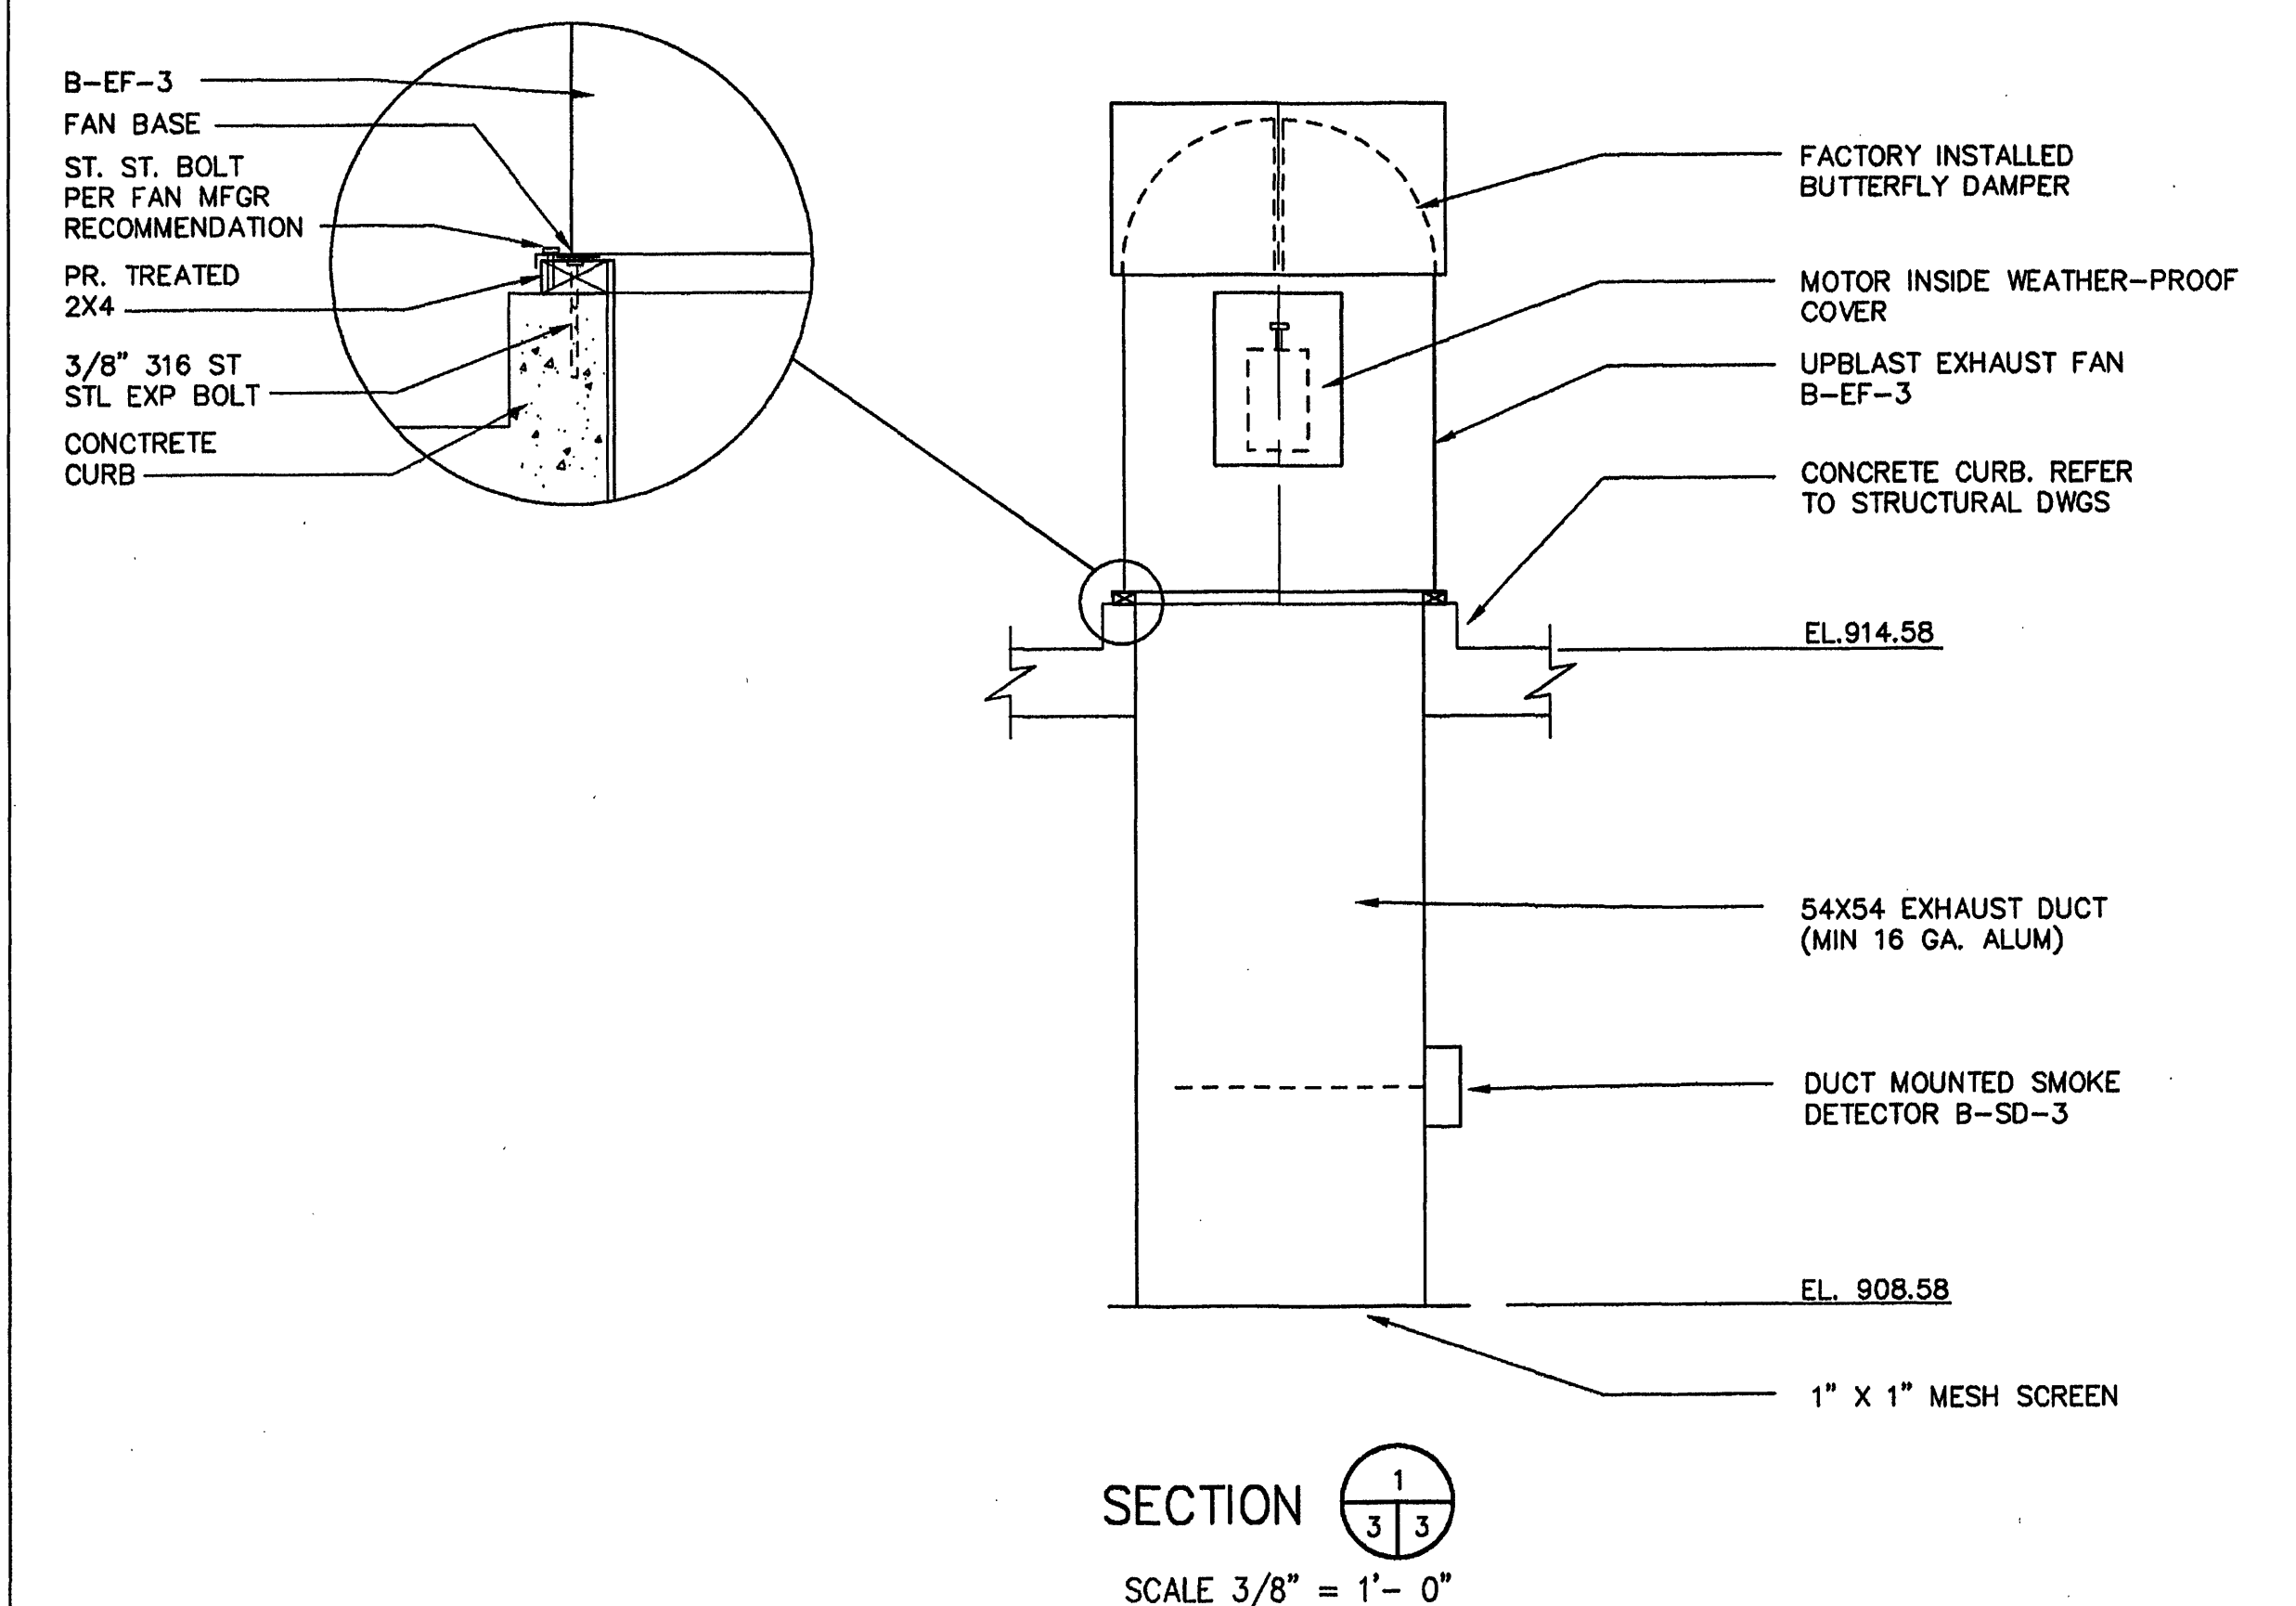

4595 ADMIN I:\ACAD\PROJ\00604502\00604502.dwg 05/01/1997 Time: 10:09

**MALCOLM  
PIRNIE**  
11832 Rock Landing Drive, Suite 400  
Newport News, Virginia 23606

| REVISIONS |     |           |                |
|-----------|-----|-----------|----------------|
| NO.       | BY  | DATE      | REMARKS        |
| 1         | ARB | JAN. 2000 | RECORD DRAWING |
|           |     |           |                |
|           |     |           |                |
|           |     |           |                |
|           |     |           |                |

DES --- JMC  
DWN --- JMC  
CKD --- JMC



CITY OF ROANOKE, VIRGINIA  
WATER POLLUTION  
CONTROL PLANT  
UPGRADE AND EXPANSION

BIOLOGICAL AERATED FILTER  
PLAN AND SECTIONS  
SCALE AS NOTED

COPYRIGHT © 1997  
MALCOLM PIRNIE, INC.  
DATE \_\_\_\_\_ MAY 1997  
H SHEET 3 OF 6  
CAD REF. NO. 00604502