



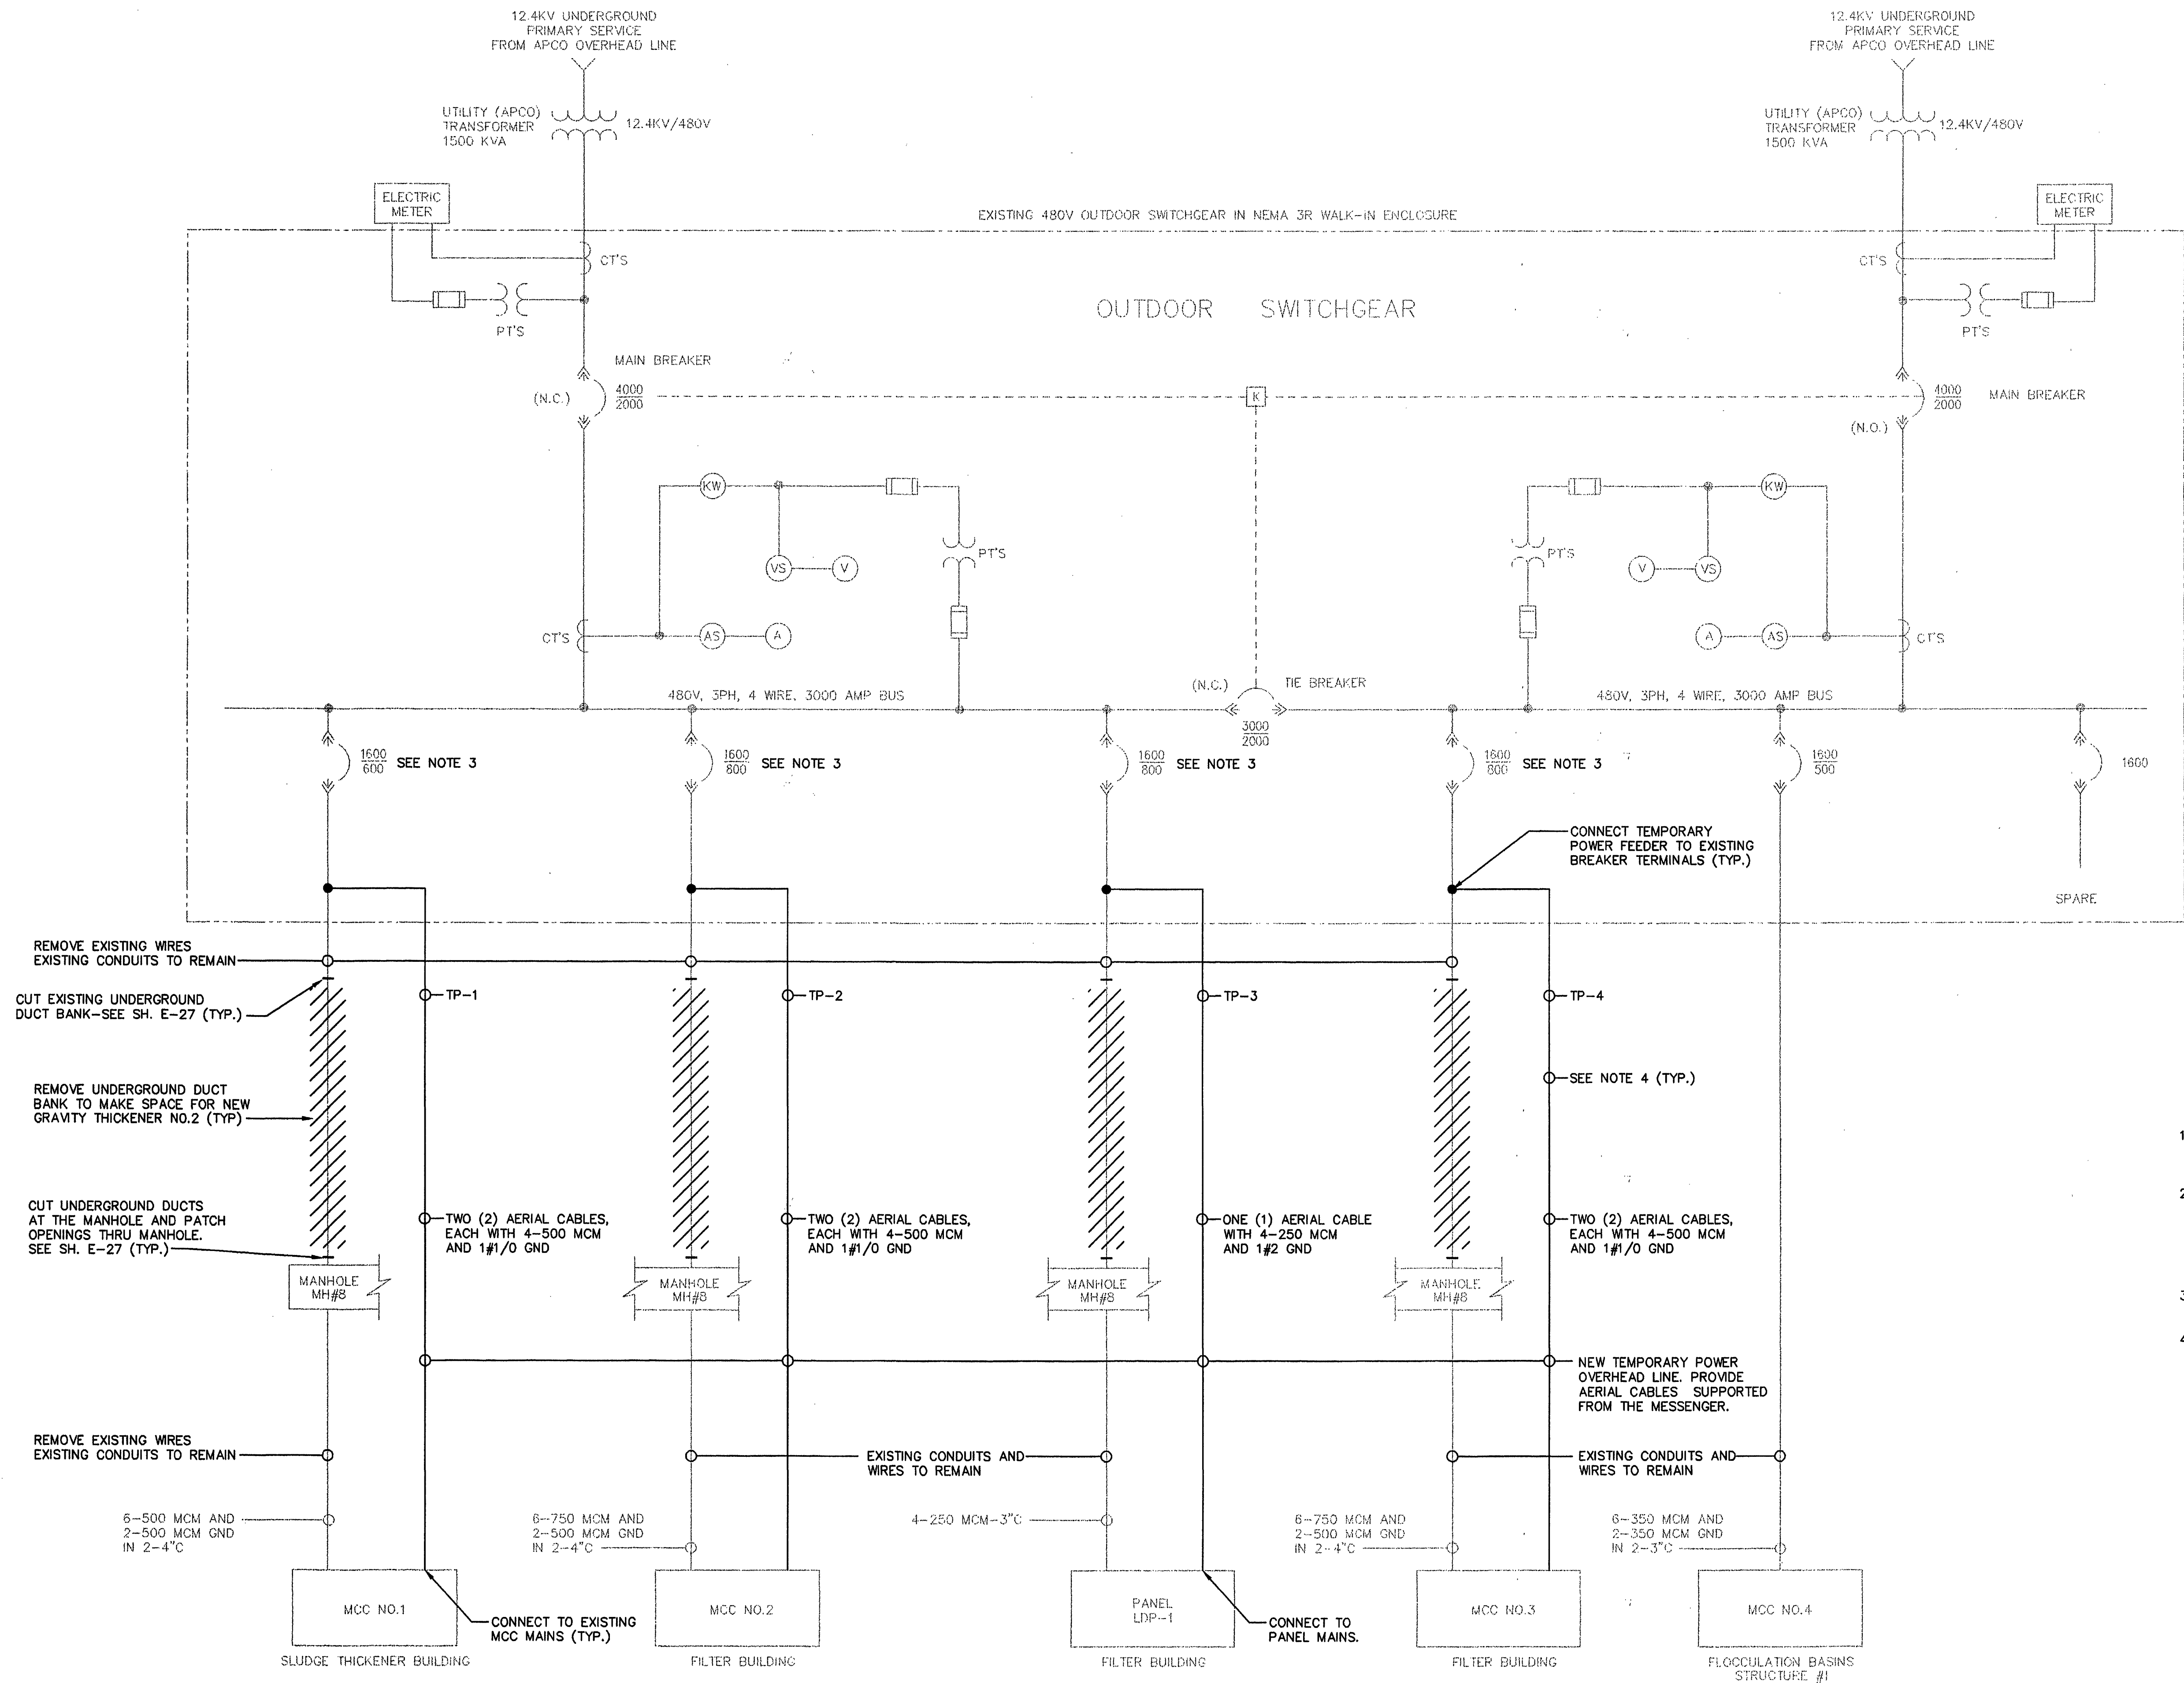

- NOTES:
1. CONTRACTOR SHALL PROVIDE TEMPORARY POWER IN ACCORDANCE WITH THE REQUIREMENTS SPECIFIED IN SECTION 01500. INFORMATION SHOWN ON THIS DRAWING REPRESENTS ONLY ADDITIONAL REQUIREMENTS.
 2. CONTRACTOR SHALL PROVIDE TEMPORARY POWER IN A STAGED SEQUENCE TO MINIMIZE INTERRUPTIONS TO THE TREATMENT PLANT. THE EXACT WORK SEQUENCE SHALL BE ESTABLISHED BY THE CONTRACTOR IN ACCORDANCE WITH THE REQUIREMENTS SPECIFIED. THE STAGING SEQUENCE MUST BE SUBMITTED BY THE CONTRACTOR AND APPROVED BY THE ENGINEER PRIOR TO ANY CONSTRUCTION.
 3. ADJUST EXISTING BREAKER SETTINGS TO MATCH AMPACITY OF TEMPORARY POWER FEEDER.
 4. PROVIDE AERIAL CABLE SUITABLE FOR INSTALLATION IN CABLE TRAYS, CONDUIT AND WITH MESSENGER WIRE. PROVIDE TC TYPE CABLE WITH XHHW INSULATION, PVC JACKET, COPPER CONDUCTOR RATED 600V, 90°C WITH GROUND WIRE. PROVIDE CABLE MANUFACTURED BY HOUSTON WIRE AND CABLE CORP. OR EQUAL.

TEMPORARY POWER - ONE LINE DIAGRAM

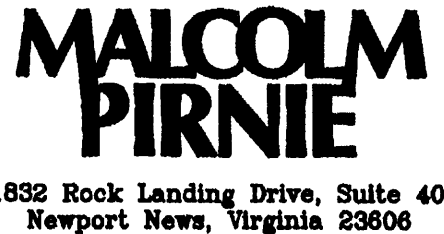

11832 Rock Landing Drive, Suite 400
Newport News, Virginia 23606

REVISIONS			
NO.	BY	DATE	REMARKS
1	ARB	JAN. 2000	RECORD DRAWING

DES - GJM/TK
DWN - GJM
CKD - FAS



CITY OF ROANOKE, VIRGINIA
WATER POLLUTION
CONTROL PLANT
UPGRADE AND EXPANSION

ELECTRICAL
TEMPORARY POWER
ONE LINE DIAGRAM
SCALE: NONE

COPYRIGHT © 1997
MALCOLM PIRNIE, INC.
DATE MAY 1997
E SHEET 3 OF 36
CAD REF. NO. 0060E678