



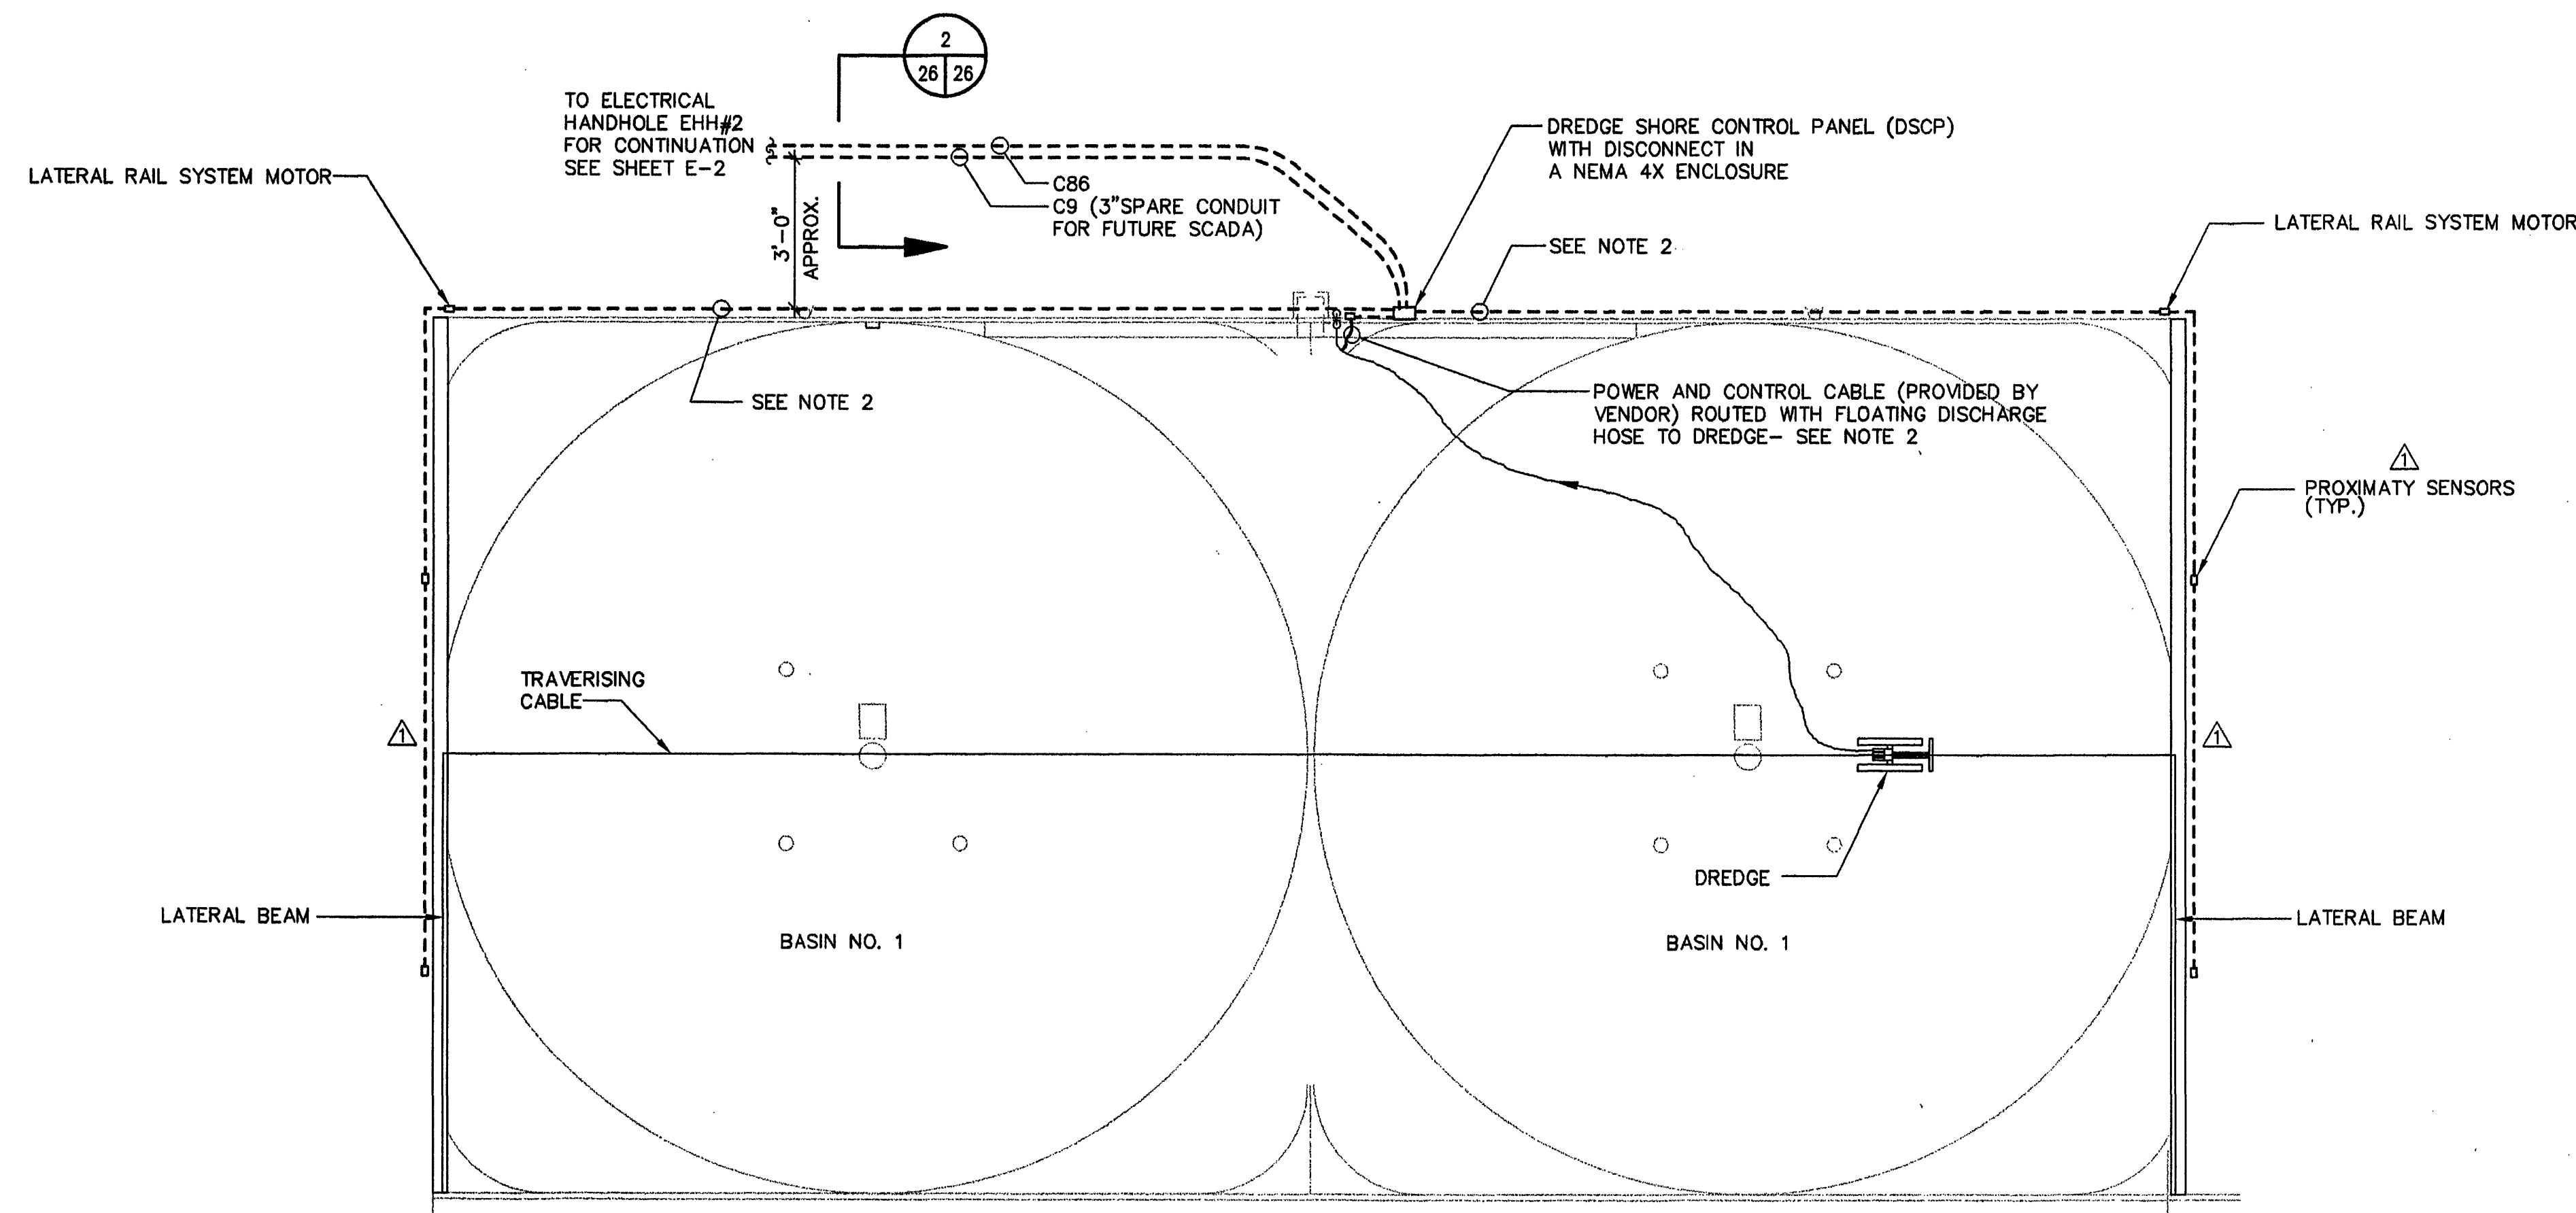


EQUALIZATION BASIN
PARTIAL PLAN
(SCALE: 1"=30'-0")

NOTES:


1. AREA CLASSIFICATION:
a. OUTDOOR AREAS SHALL BE CONSIDERED WET LOCATIONS. ALL EXPOSED CONDUITS SHALL BE RIGID STEEL PVC COATED. ENCLOSURES SHALL MEET NEMA 4X REQUIREMENTS.
2. ALL CONDUITS, WIRES, BOXES, ETC. FROM DREDGE SHORE CONTROL PANEL (DSCP) TO FIELD EQUIPMENT (FLOATING DREDGE HYDRAULIC PUMP ETC.) SHALL BE PROVIDED UNDER SPECIFICATION SECTION 11340.
3. DISCONNECT EXISTING 3#, 480V FEEDER AND RECONNECT NEW FEEDER (C97).

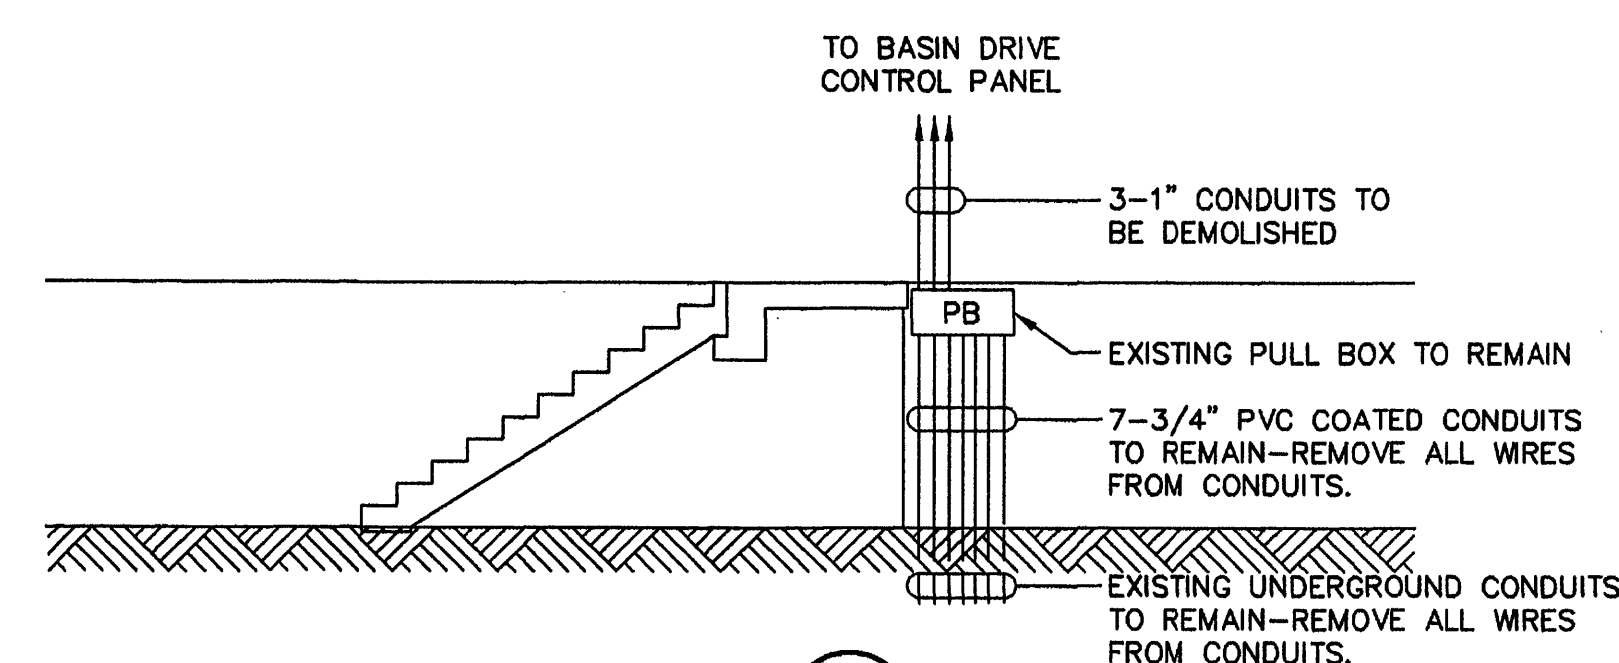

SECTION 1
N.T.S.

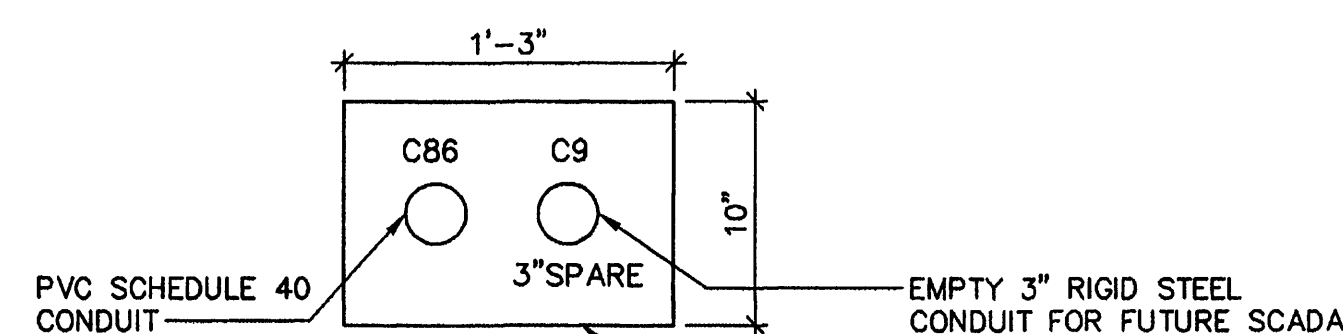

SECTION 2
N.T.S.

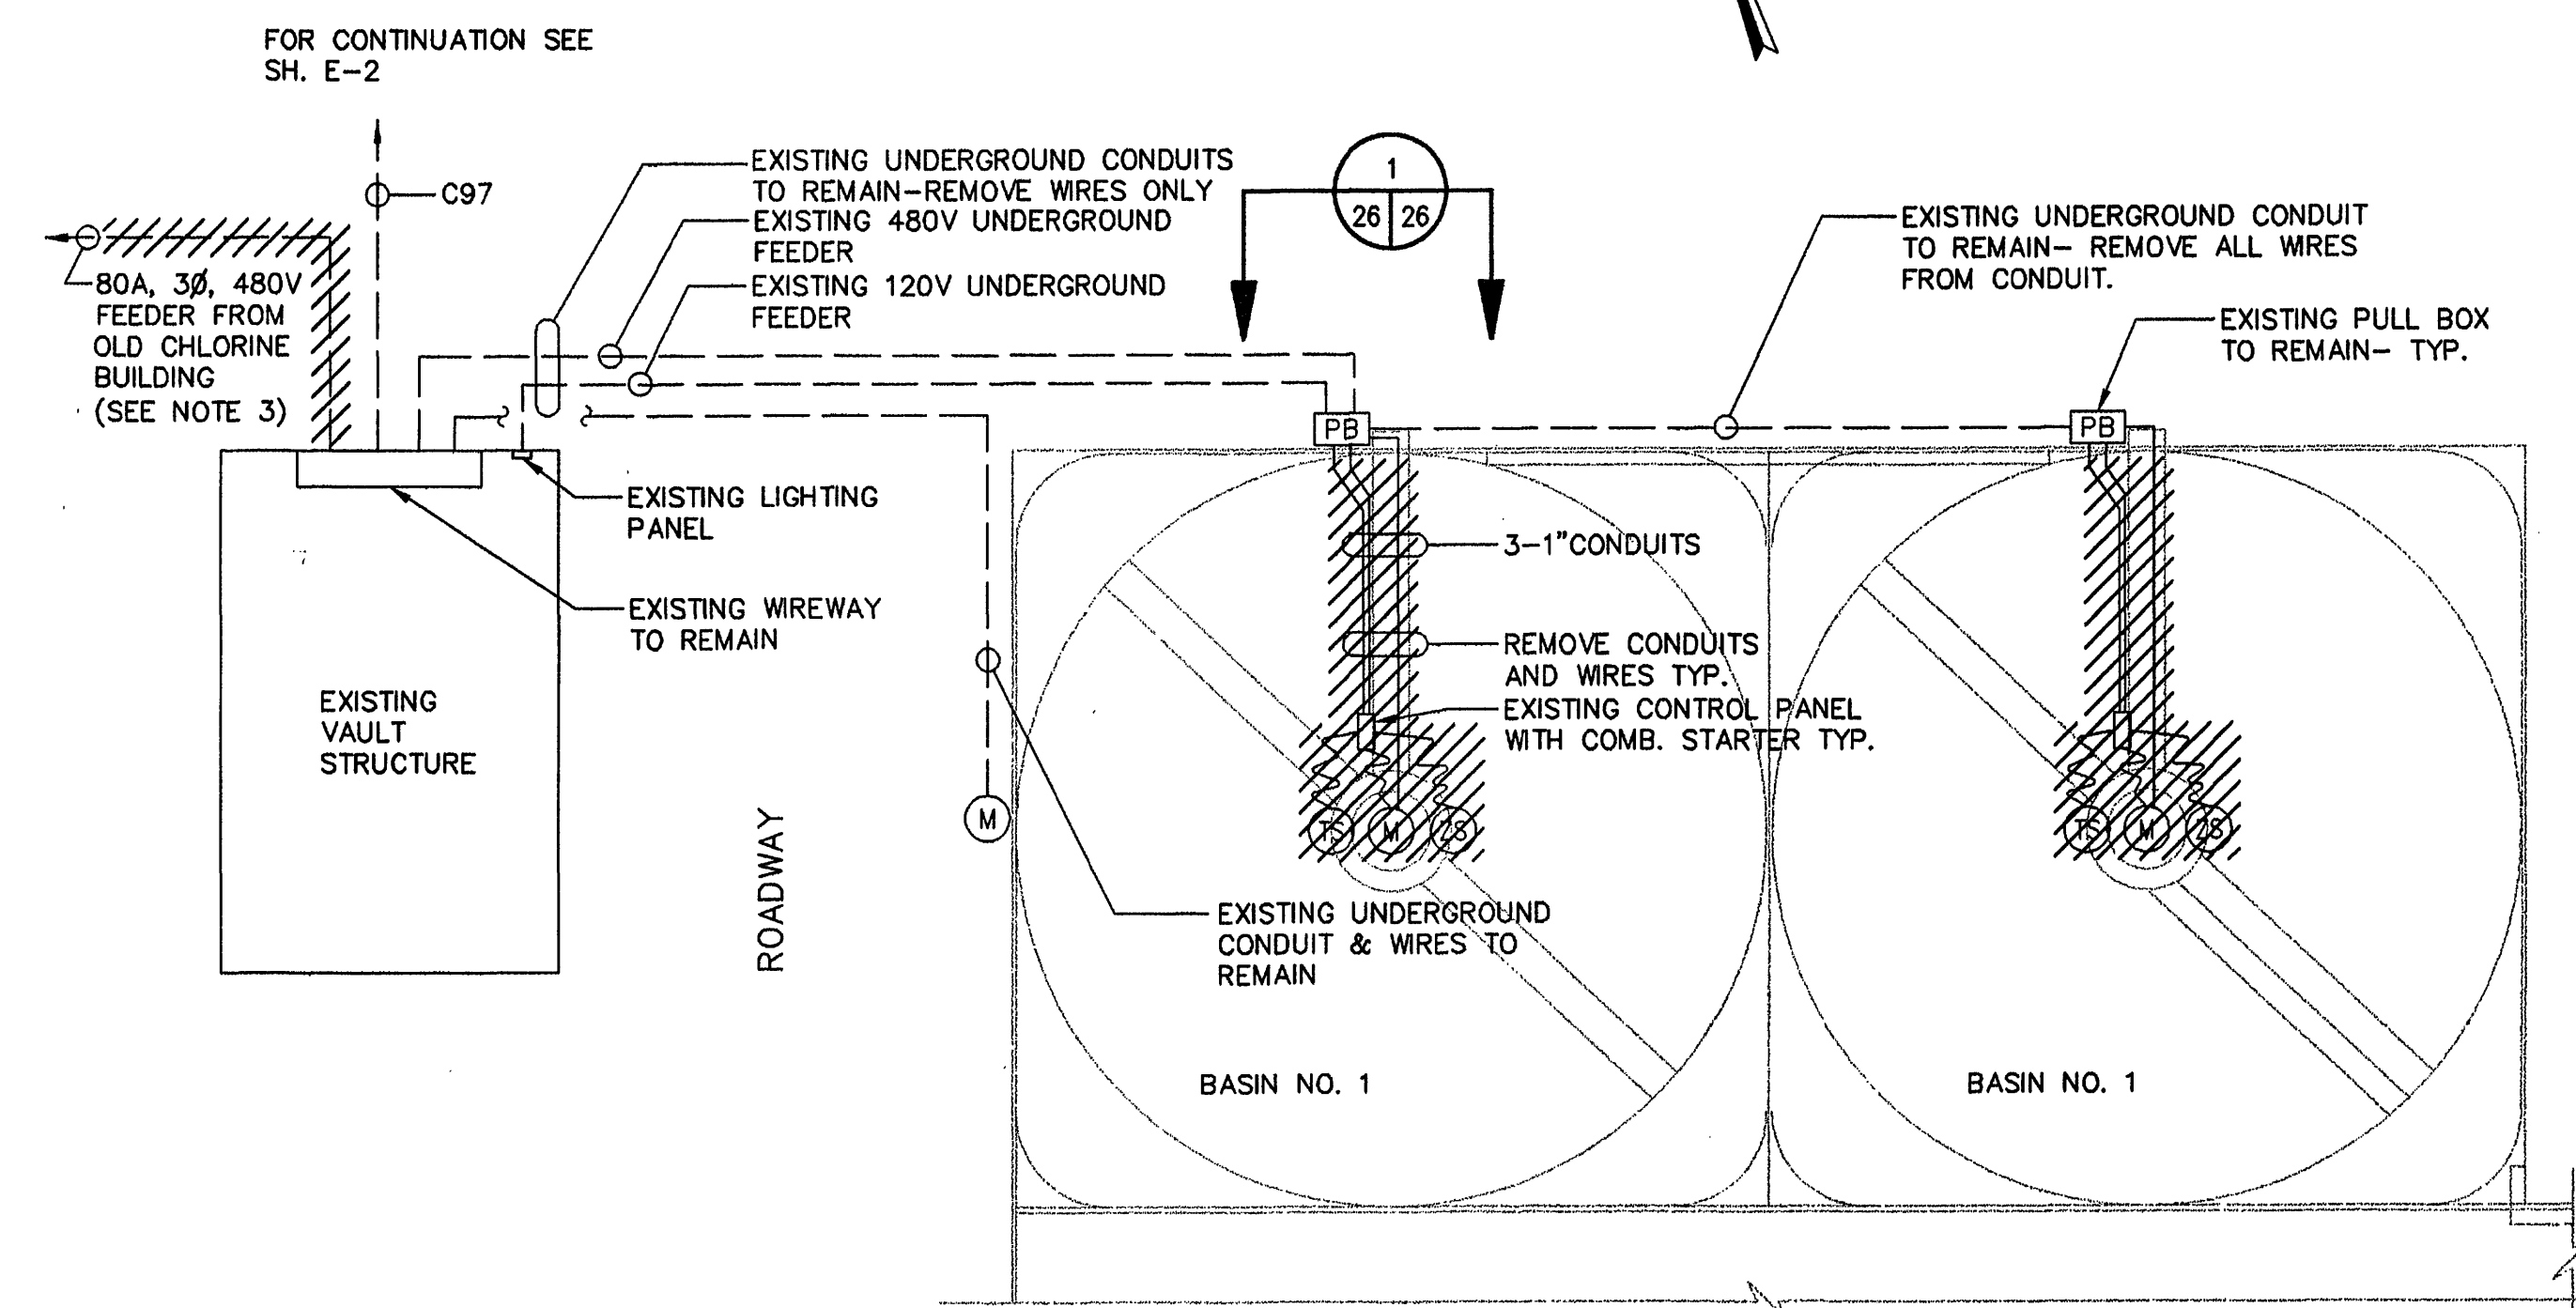

EQUALIZATION BASIN
DEMOLITION PLAN
(N.T.S.)

**MALCOLM
PIRNIE**
11832 Rock Landing Drive, Suite 400
Newport News, Virginia 23606

REVISIONS				
NO.	BY	DATE	REVISIONS	REMARKS
1	ARB	JAN. 2000	RECORD DRAWING	

DES --- GJM ---
DWN --- GJM ---
CKD --- TK ---



CITY OF ROANOKE, VIRGINIA
WATER POLLUTION
CONTROL PLANT
UPGRADE AND EXPANSION

EQUALIZATION BASIN
SLUDGE COLLECTION SYSTEM
POWER LAYOUT
SCALE: AS NOTED

COPYRIGHT © 1997
MALCOLM PIRNIE, INC.
DATE --- MAY 1997 ---
E SHEET 26 OF 34 ---
CAD REF. NO. 0060E703 ---