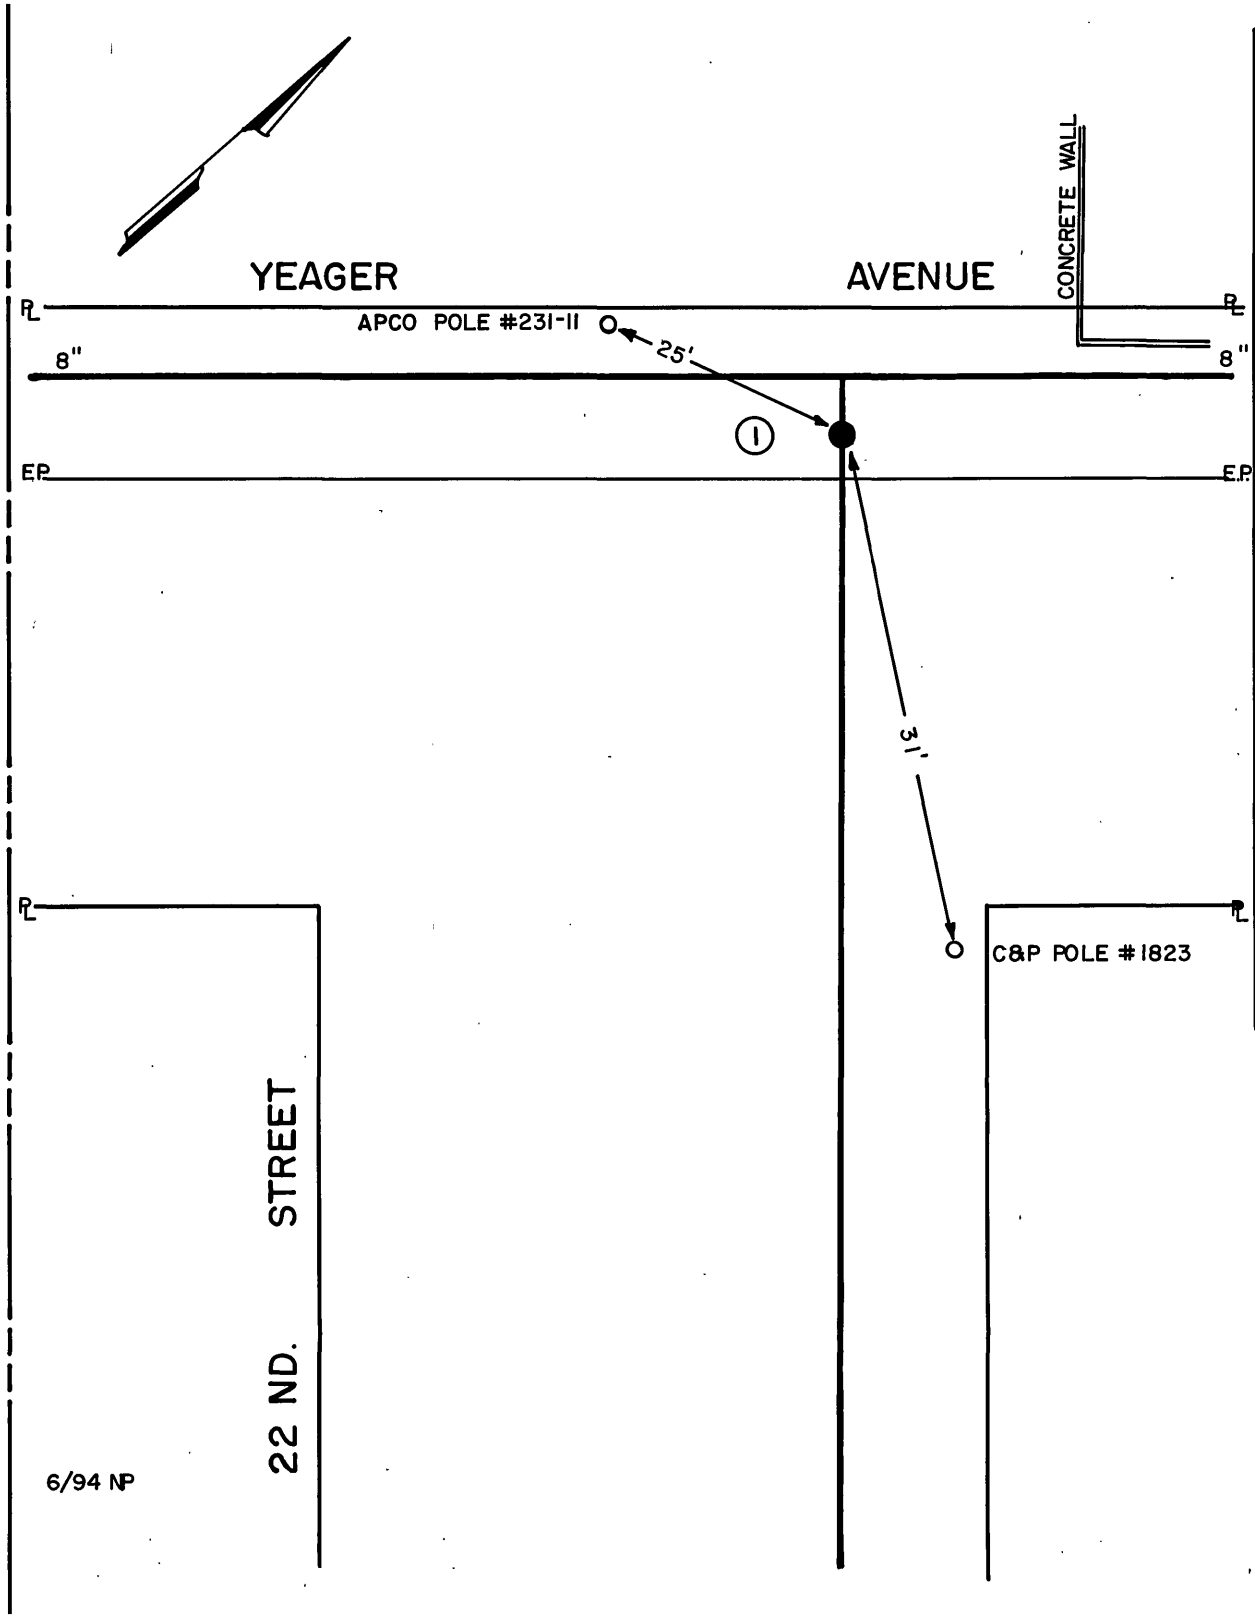

DATE	NO.	SIZE	MAKE	OPEN	TURNS
1991	1	6"	MUELLER	R	21

CITY OF ROANOKE - WATER DEP'T.

VALVE DIAGRAM

YEAGER AVENUE

22 ND STREET

SEC. MAP 334 N.E.

DATE: PAGE NO.