5/9/2017
8:49:50 PM

ul90823(IIA).dgn
Plotted By: localuser

PROJECT MANAGER JAMES. HENEGAR, P.E. (540) 443-9283 (SALEM)
SURVEYED BY VDOT
DESIGN SUPERVISED BY JEFF. BRAGDON, P.E. (540) 786-8025
DESIGNED BY BRADLEY. C. CRAIG, MATTERN. & CRAIG (540) 345-9342

REVISED	STATE	STATE ROUTE	STATE PROJECT	SHEET NO.
01-09-2017 05-10-2017	VA.	U000	U000-128-V12, C-504	23(IIA)

DESIGN FEATURES RELATING TO CONSTRUCTION OR TO REGULATION AND CONTROL OF TRAFFIC MAY BE SUBJECT TO CHANGE AS DEEMED NECESSARY BY THE DEPARTMENT

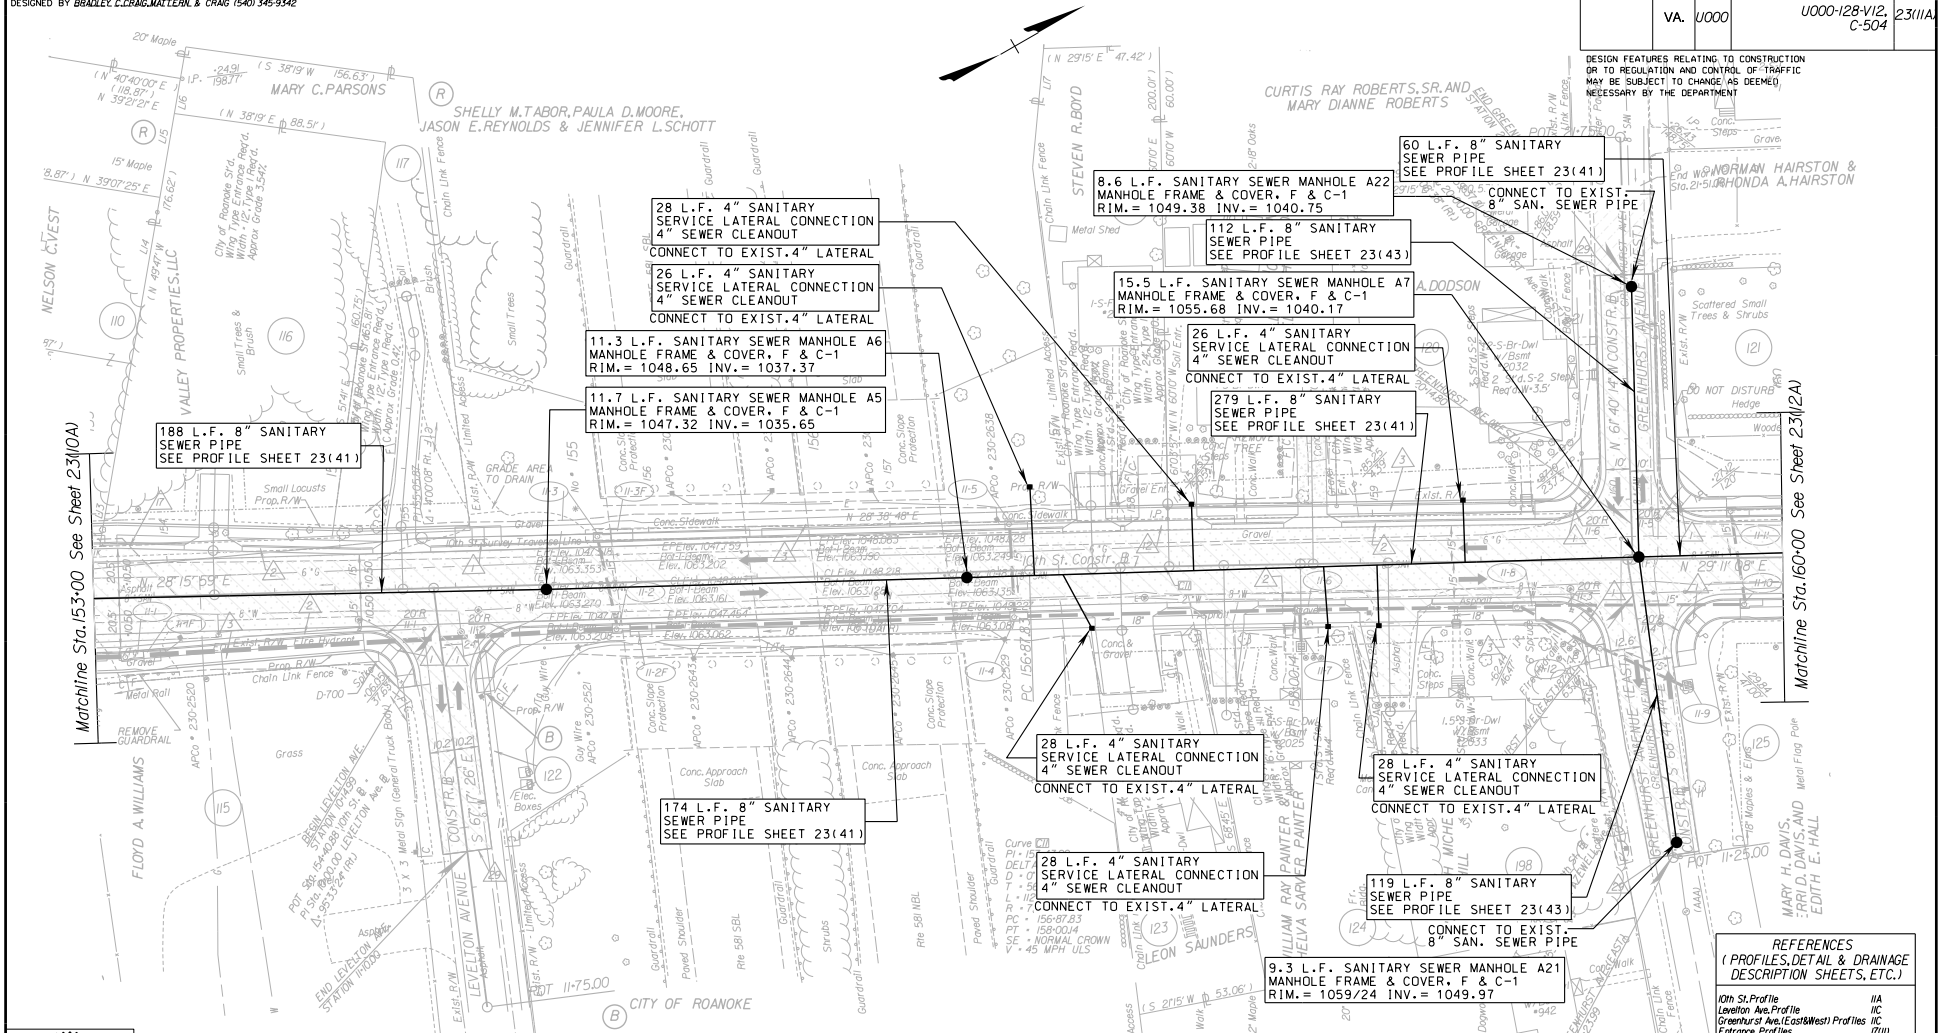

INCIDENTAL LEGEND

1. Std. CG-12B Req'd.
2. Std. CG-6 Req'd.
3. 4' Conc. Sidewalk Req'd.
13. Dual Entrance - See Sheet 2K
17. Std. CD-1 Req'd.
27. Std. CG-12C Req'd.

Note: Figures in parenthesis and dot - dot - dashed lines denote Temporary Easements.

Note: Figures in brackets and dot - dashed lines denote Permanent Easements.

● Denotes Temporary Slope Easement Req'd for Construction.

●● Denotes Temporary Drainage Easement Req'd for Construction.

●●● Denotes Permanent Drainage Easement Req'd for Installation and Maintenance.

●●●● Denotes Temporary Construction Easement Req'd for Entrance.

C Denotes Construction Limits In Cuts

F Denotes Construction Limits In Fills

Denotes Overlaying & Buildup

Denotes Full Depth Pavement

Denotes Demolition of Pavement

REFERENCES
(PROFILES, DETAIL & DRAINAGE DESCRIPTION SHEETS, ETC.)

10th St. Profile	IIA
Levelton Ave. Profile	IIC
Greenhurst Ave. (East&West) Profiles	IIC
Entrance Profiles	IT(11)
Utility Owners	3
Drainage Descriptions	9B
ROW Only Plan Sheet	IC(20)
Construction Alignment Data Sheet	IF(4)-IF(5)
Erosion and Sediment Control	LM(3)
Entr. Const. Alignment Data Sheet	IB(7)

SCALE
0 25' 50'

COMMONWEALTH OF VIRGINIA
BRADLEY C. CRAIG
Lic. No. 023879
PROFESSIONAL ENGINEER

MATTERN & CRAIG, INC
Roanoke, Virginia
(UTILITY ENGINEER)

PROJECT	SHEET NO.
U000-128-V12	23(IIA)