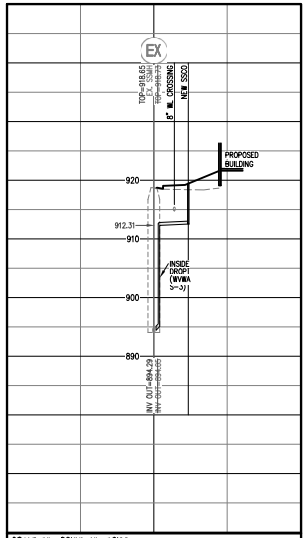

SCALE: 1" = 20'(H), 1" = 10'(V)

SEWER LATERAL PROFILE

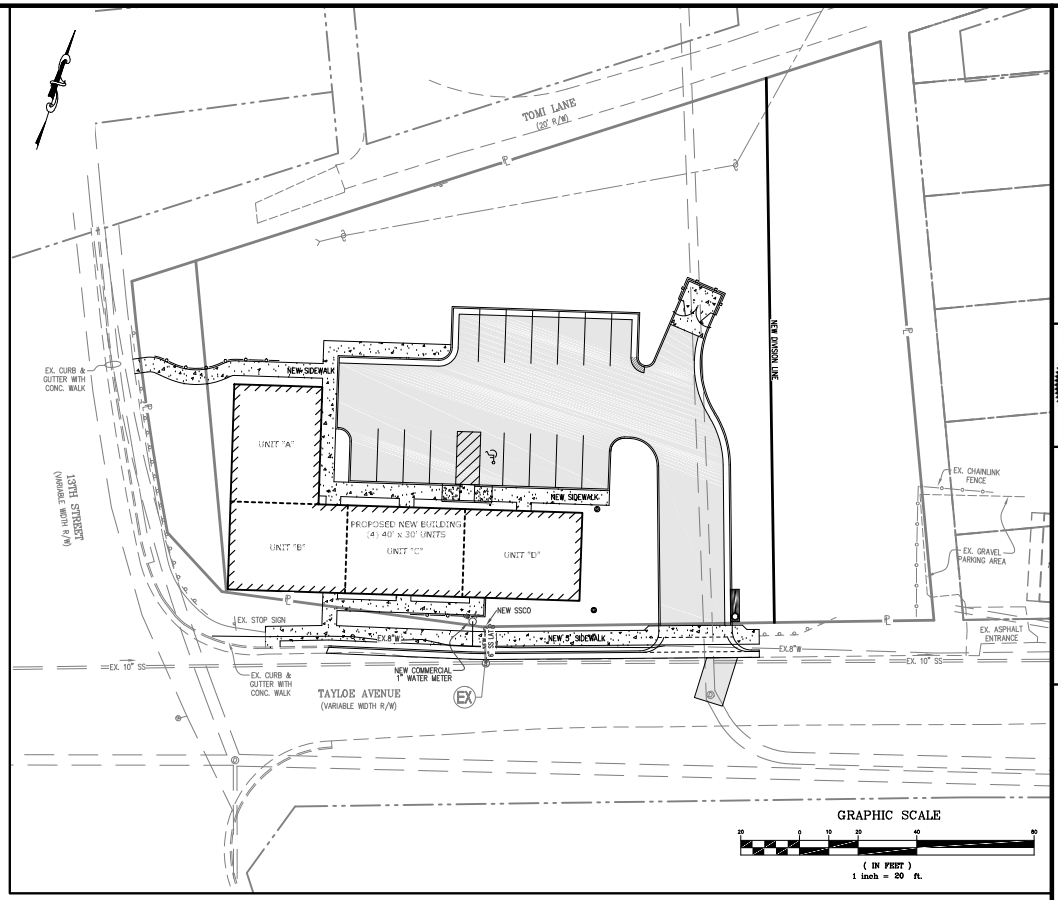

EXISTING SURVEY CONTROL
△ POINT #10000 NORTHING: 36239.46.48292 EASTING: 11070181.11234 ELEVATION: 905.40' DESCRIPTION: MAGNETIC SPIKE NAIL
△ POINT #10001 N 36233.83.49410 E 11070047.14070 ELEVATION: 903.31' DESCRIPTION: MAGNETIC SPIKE NAIL

AS-BUILT

AS-BUILT INFORMATION SHOWN ON THIS PLAN IS THE RESULT OF A FIELD SURVEY PERFORMED BY LUMSDEN ASSOCIATES, P.C.

Lumsden Associates, P.C.
ENGINEERS | SURVEYORS | PLANNERS
4884 BRAMBLETON AVENUE
P.O. BOX 12869
ROANOKE, VIRGINIA 24018
PHONE: (540) 774-4411
FAX: (540) 772-9445
WWW.LUMSDENPC.COM

COMMONWEALTH OF VIRGINIA
HOWARD P. BOGGESS, II
Lic. No. 000920
4/28/22
LANDSCAPE ARCHITECT

WVWA
AS-BUILT PLAN

WATER and SEWER AS-BUILT PLAN
TAYLOE AVENUE COMMERCIAL BUILDING

PREPARED FOR
DUNCAN PROPERTIES & CONSTRUCTION, INC.
SITUATED ALONG TAYLOE AVENUE, SE
CITY OF ROANOKE, VIRGINIA

REVISIONS		
NO.	DATE	DESCRIPTION
1		
2		
3		
4		
5		

DATE: April 28, 2022
SCALE: 1" = 20'
COMMISSION NO. 20-295
SHEET 1 OF 1