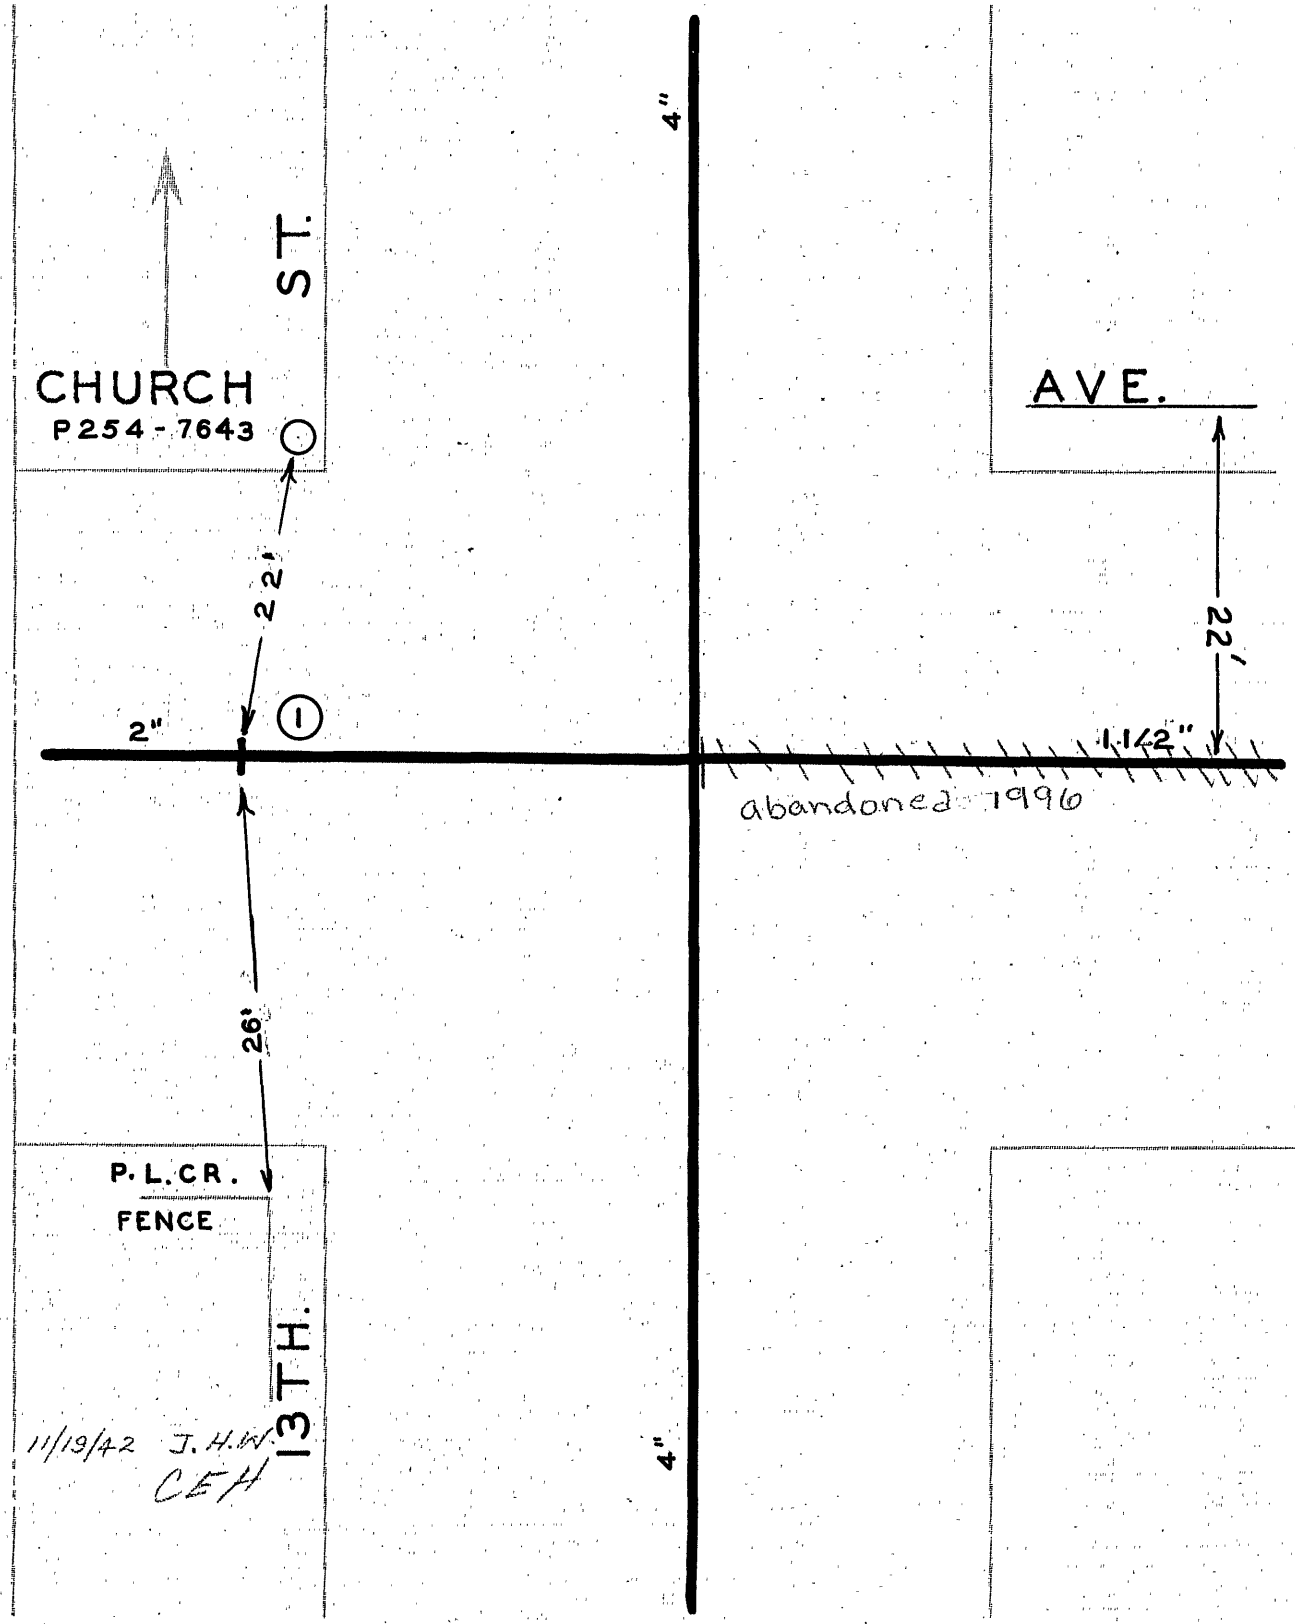

DATE	NO.	SIZE	MAKE	OPEN	TURNS
1937	1	2"		R	7
	1	0	WPL		

CITY OF ROANOKE — WATER DEP'T
VALVE DIAGRAM
CHURCH AVE. & 13TH. ST. S.E.

SEC. MAP 411

DATE PAGE NO. S.E.114