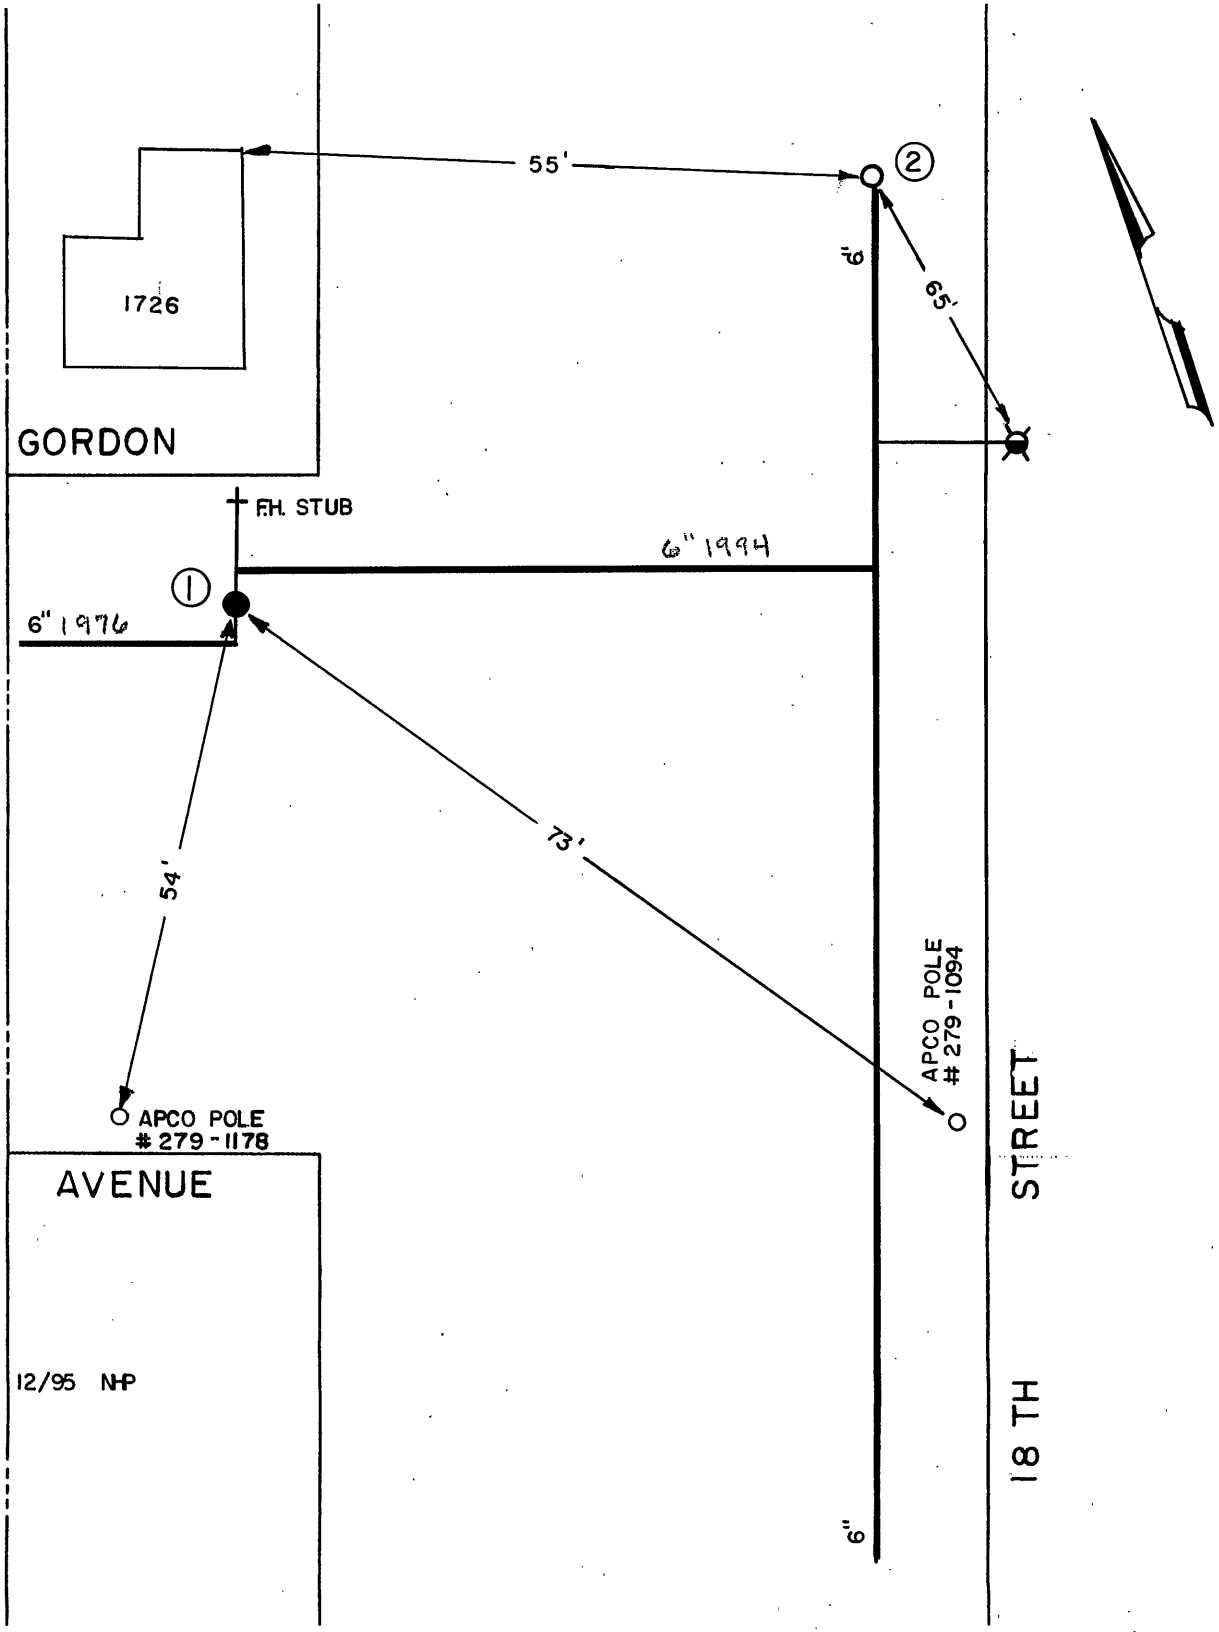

DATE	NO.	SIZE	MAKE	OPEN	TURNS
1994	1	6"	MUELLER	R	21
1994	2	2"	BLOW OFF	L	

CITY OF ROANOKE—WATER DEP'T

VALVE DIAGRAM

GORDON AVENUE

18TH STREET

SEC. MAP 443 S.E.

DATE PAGE NO.