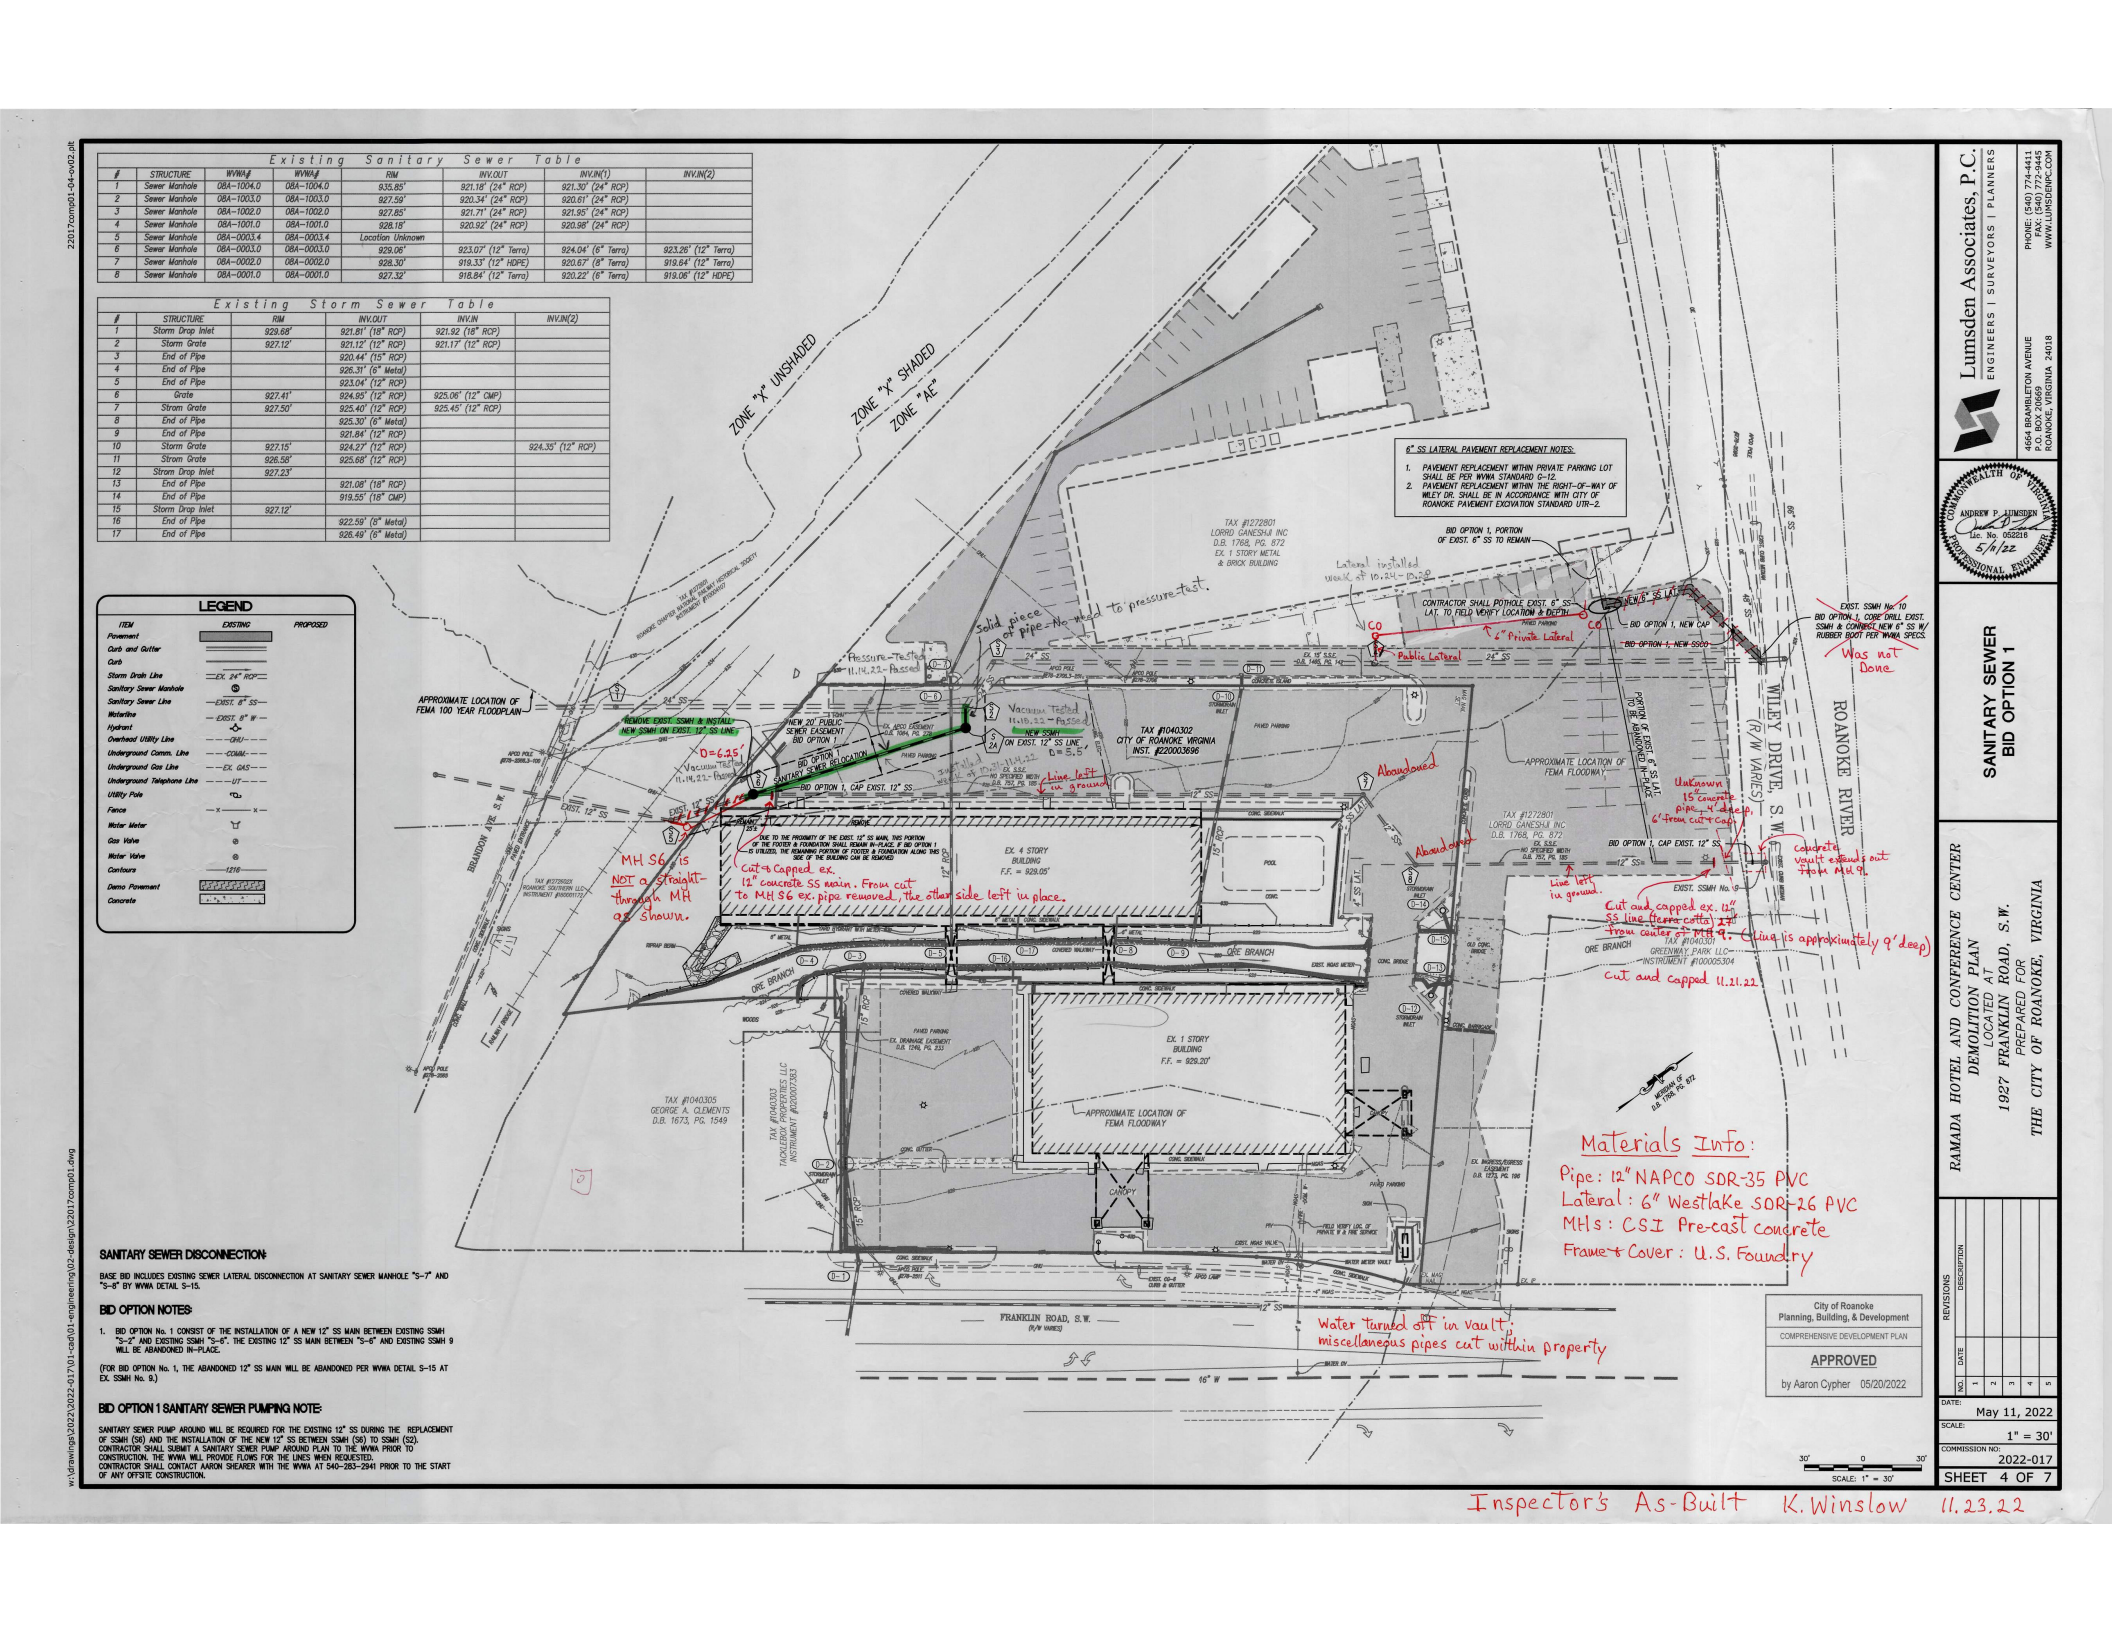
Existing Sanitary Sewer Table
| STRUCTURE | WVWA# | WVWA# | RIM | INV.OUT | INV.IN(1) | INV.IN(2)
1 | Sewer Manhole | 08A-1004.0 | 08A-1004.0 | 935.85' | 921.18' (24" RCP) | 921.30' (24" RCP) |
2 | Sewer Manhole | 08A-1003.0 | 08A-1003.0 | 927.59' | 920.34' (24" RCP) | 920.61' (24" RCP) |
3 | Sewer Manhole | 08A-1002.0 | 08A-1002.0 | 927.85' | 921.71' (24" RCP) | 921.95' (24" RCP) |
4 | Sewer Manhole | 08A-1001.0 | 08A-1001.0 | 928.18' | 920.92' (24" RCP) | 920.98' (24" RCP) |
5 | Sewer Manhole | 08A-0003.4 | 08A-0003.4 | Location Unknown | | |
6 | Sewer Manhole | 08A-0003.0 | 08A-0003.0 | 929.06' | 923.07' (12" Terra) | 924.04' (6" Terra) | 923.26' (12" Terra)
7 | Sewer Manhole | 08A-0002.0 | 08A-0002.0 | 928.30' | 919.33' (12" HDPE) | 920.67' (8" Terra) | 919.64' (12" Terra)
8 | Sewer Manhole | 08A-0001.0 | 08A-0001.0 | 927.32' | 918.84' (12" Terra) | 920.22' (6" Terra) | 919.05' (12" HDPE)
Existing Storm Sewer Table
| STRUCTURE | RIM | INV.OUT | INV.IN | INV.IN(2)
1 | Storm Drop Inlet | 929.68' | 921.81' (18" RCP) | 921.92 (18" RCP) |
2 | Storm Grate | 927.12' | 921.12" (12" RCP) | 921.17" (12" RCP) |
3 | End of Pipe | | 920.44" (15" RCP) | |
4 | End of Pipe | | 926.31' (6" Metal) | |
5 | End of Pipe | | 923.04' (12" RCP) | |
6 | Grate | 927.41' | 924.95" (12" RCP) | 925.06" (12" CMP) |
7 | Strom Grate | 927.50' | 925.40" (12" RCP) | 925.45" (12" RCP) |
8 | End of Pipe | | 925.30" (6" Metal) | |
9 | End of Pipe | | 921.84" (12" RCP) | |
10 | Storm Grate | 927.15' | 924.27" (12" RCP) | | 924.35" (12" RCP)
11 | Strom Grate | 926.58' | 925.68" (12" RCP) | |
12 | Storm Drop Inlet | 927.23' | | |
13 | End of Pipe | | 921.08" (18" RCP) | |
14 | End of Pipe | | 919.55" (18" CMP) | |
15 | Storm Drop Inlet | 927.12' | | |
16 | End of Pipe | | 922.59' (8" Metal) | |
17 | End of Pipe | | 926.49' (6" Metal) | |
LEGEND
ITEM | EXISTING | PROPOSED
Pavement
Curb and Gutter
Curb
Storm Drain Line — EX. 24" RCP —
Sanitary Sewer Manhole
Sanitary Sewer Line — EXIST. 8" SS —
Waterline — EXIST. 8" W —
Hydrant
Overhead Utility Line — OHU —
Underground Comm. Line — COMM —
Underground Gas Line — EX. GAS —
Underground Telephone Line — UT —
Utility Pole
Fence — X — X —
Water Meter
Gas Valve
Water Valve
Contours — 1210 —
Demo Pavement
Concrete
ZONE "X" UNSHADED
ZONE "X" SHADED
ZONE "AE"
APPROXIMATE LOCATION OF FEMA 100 YEAR FLOODPLAIN
6" SS LATERAL PAVEMENT REPLACEMENT NOTES:
1. PAVEMENT REPLACEMENT WITHIN PRIVATE PARKING LOT SHALL BE PER WVWA STANDARD G-12.
2. PAVEMENT REPLACEMENT WITHIN THE RIGHT-OF-WAY OF WILEY DR. SHALL BE IN ACCORDANCE WITH CITY OF ROANOKE PAVEMENT EXCAVATION STANDARD UTR-2.
TAX #1272801 LORRD GANESHJI INC D.B. 1768, PG. 872 EX. 1 STORY METAL & BRICK BUILDING
TAX #1040302 CITY OF ROANOKE VIRGINIA INST. #200003696
TAX #1272801 LORRD GANESHJI INC D.B. 1768, PG. 872
TAX #1040301 GREENWAY PARK LLC INSTRUMENT #100005304
TAX #1040305 GEORGE A. CLEMENTS D.B. 1673, PG. 1549
TAX #1272803 ROANOKE SOUTHERN LLC INSTRUMENT #100011172
EX. 4 STORY BUILDING F.F. = 929.05'
EX. 1 STORY BUILDING F.F. = 929.20'
BID OPTION 1, PORTION OF EXIST. 6" SS TO REMAIN
BID OPTION 1, NEW CAP
BID OPTION 1, NEW SSCO
BID OPTION 1, CAP EXIST. 12" SS
BID OPTION 1, NEW 20' PUBLIC SEWER EASEMENT
BID OPTION 1, SANITARY SEWER RELOCATION
REMOVE EXIST. SSMH & INSTALL NEW SSMH ON EXIST. 12" SS LINE
NEW SSMH ON EXIST. 12" SS LINE
EXIST. SSMH No. 10
EXIST. SSMH No. 9
EXIST. 6" SS LAT. TO BE REMOVED IN-PLACE
EXIST. 12" SS
EXIST. 15" SS
EXIST. 24" SS
