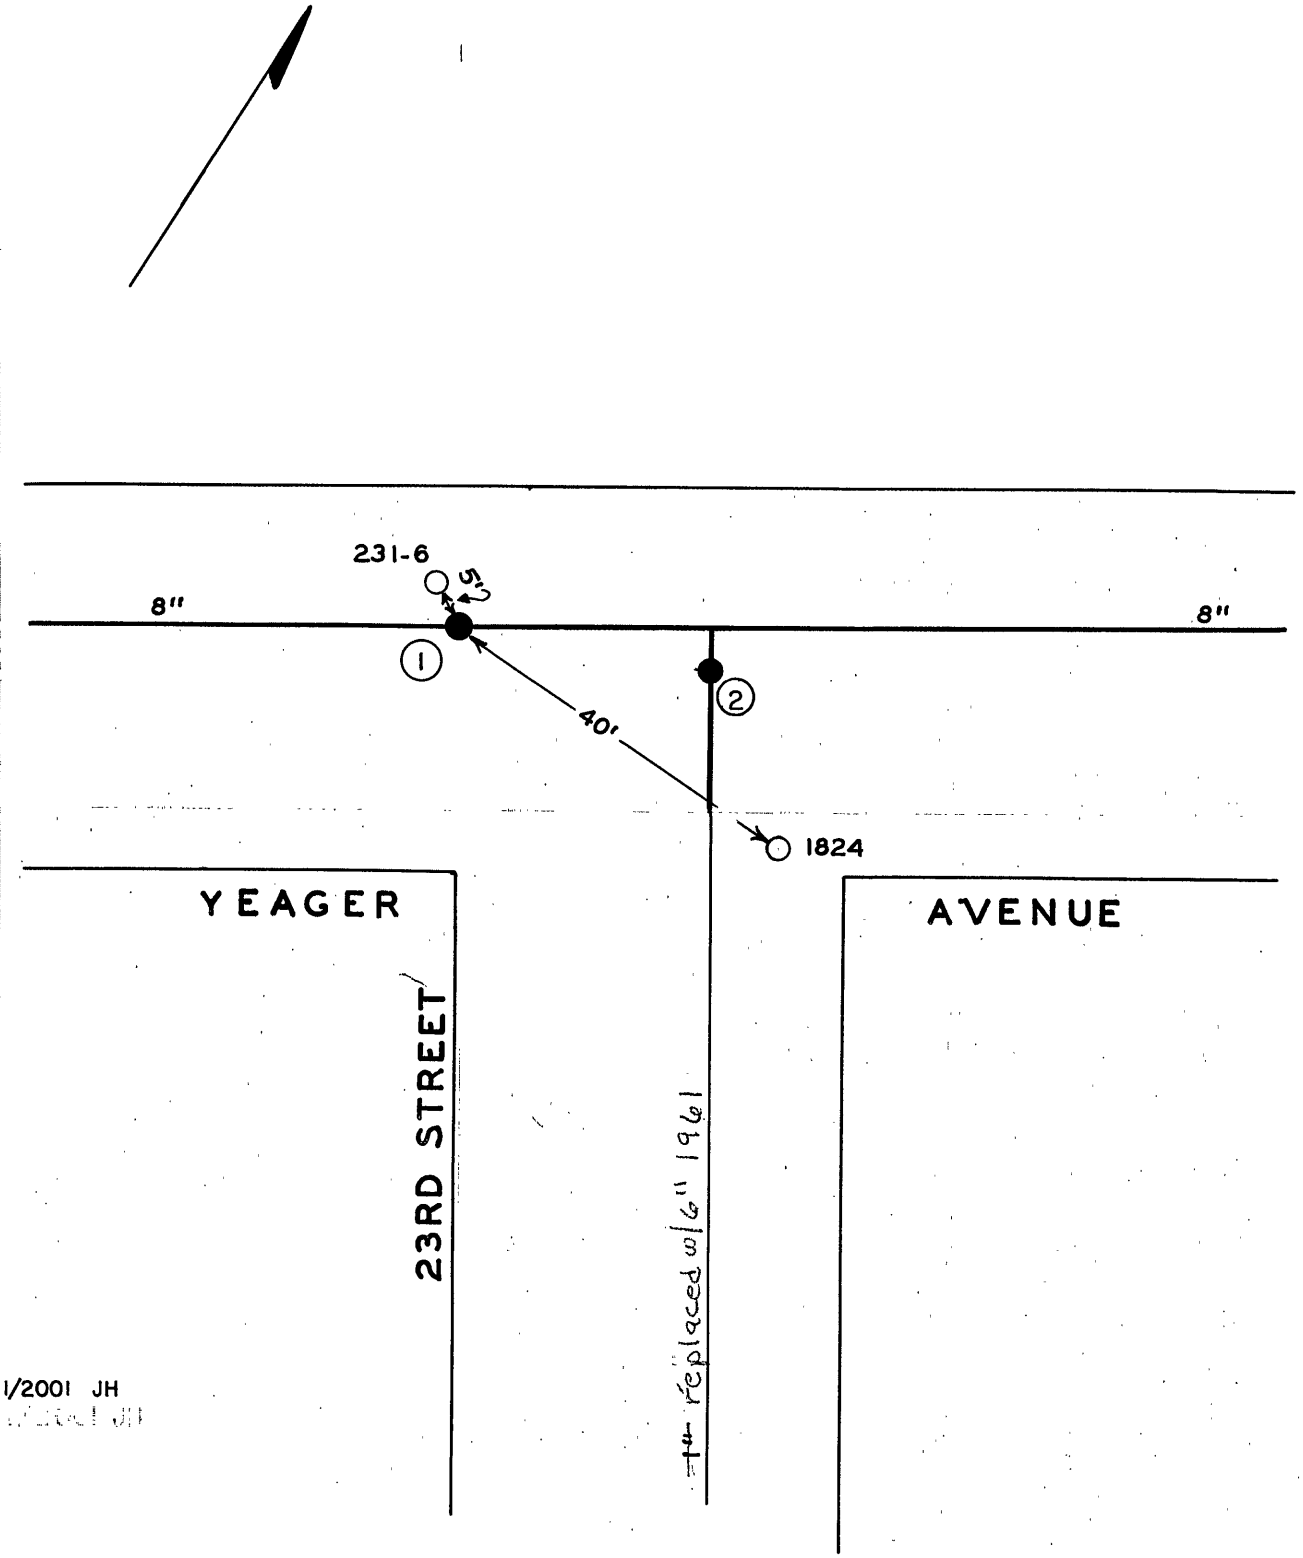

DATE	NO.	SIZE	MAKE	OPEN	TURNS
8-61	1	8"	DARLING	R	
1996	2	6		R	
	1	0	W.P.L.		

CITY OF ROANOKE — WATER DEPT.

VALVE DIAGRAM

YAEGER AVENUE

& 23RD STREET N.E.

SEC. MAP 334

DATE PAGE NO.

"IMPERIALITE" TRACING CLOTH
K & E CO., N.Y.