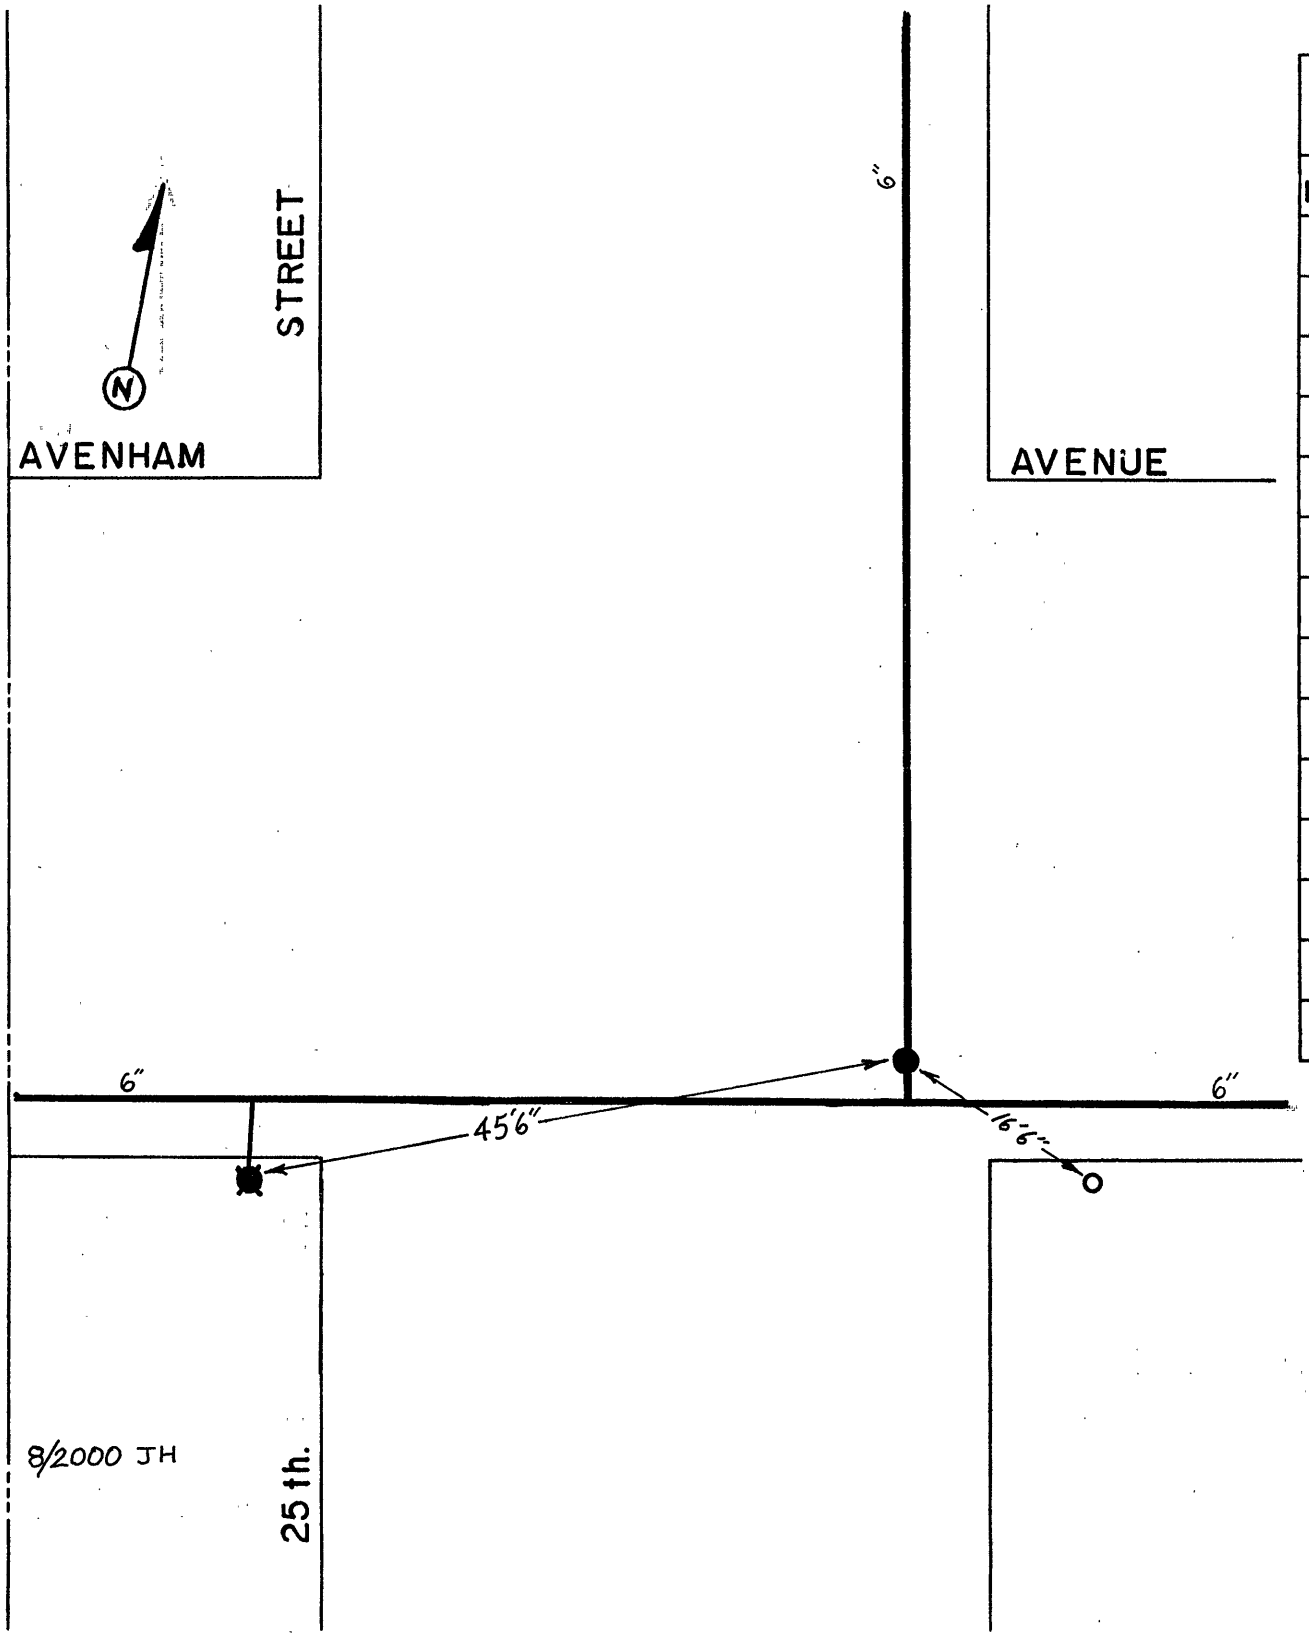

DATE	NO.	SIZE	MAKE	OPEN	TURNS
1982	1	6	MUELLER	R	21

CITY OF ROANOKE—WATER DEP'T

VALVE DIAGRAM

AVENHAM AVENUE &

25 th. STREET

SEC. MAP 105 S.W.

DATE PAGE NO.