Point Table

Point #	Elevation	Northing	Easting	Description
S1	1111.80	3656921.46	11059742.12	EX MANHOLE
S2	1110.70	3656888.71	11059762.45	SANITARY SEWER MANHOLE INV 1099.0
W1	1101.14	3656977.46	11059885.11	COMMERCIAL METER VAULT
W2	1101.03	3656956.09	11059884.66	WATER METER

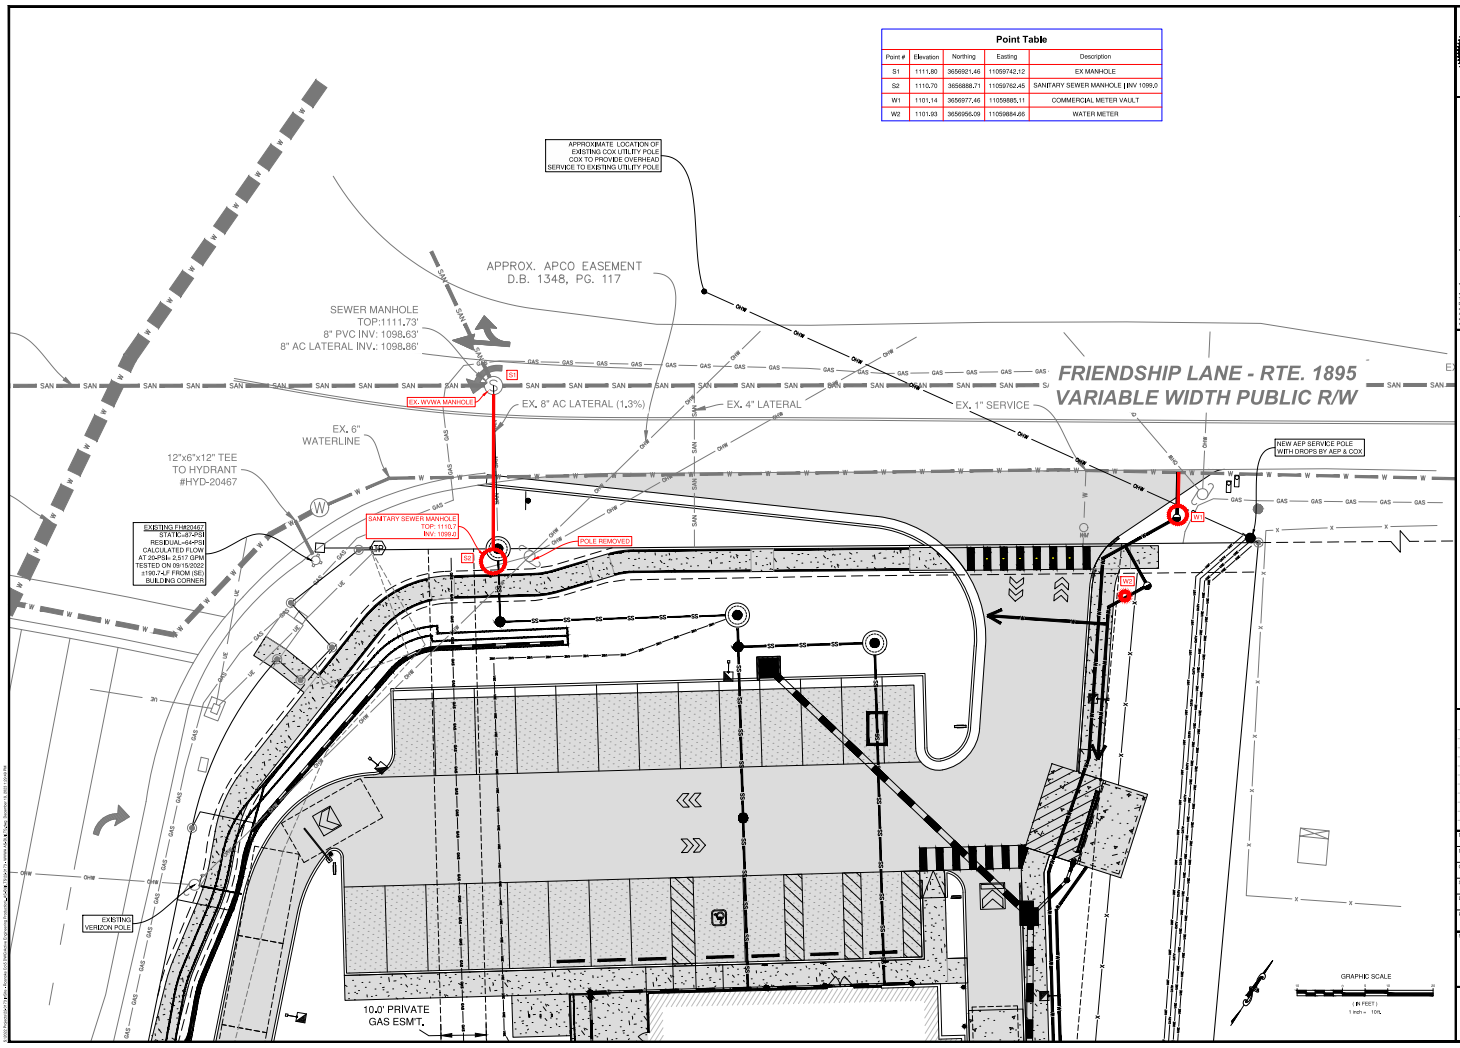

STATE OF VIRGINIA
JACK D. ELLINWOOD
Lic. No. 001107
12/18/2023
LICENSED PROFESSIONAL ENGINEER

parker DESIGN GROUP
CIVIL ENGINEERS • SURVEYORS
PLANNERS • LANDSCAPE ARCHITECTS
2122 Carolina Ave. SW
Roanoke, VA 24014
Ph: 540-387-4153
Fax: 540-389-5767
1915-B W. Cary Street
Richmond, VA 23220
Phone: 804-358-2947
Fax: 804-359-9645
www.parkerdg.com

These documents are the property of Parker Design Group(PDG) and may not be reproduced or used without the express permission of PDG. Any reproduction or unauthorized use without authorization of PDG will be at the risk of the individual or party utilizing said document.

WVWA AS-BUILT PLANS PREPARED FOR ROANOKE, VA (7515 FRIENDSHIP) LLC
COFFEE SHOP & DRIVE-THROUGH

7515 FRIENDSHIP LANE (027.06-05-06.00-0000)
ROANOKE COUNTY, VIRGINIA

REVISIONS

DESIGNED BY:	JDE / JMD
DRAWN BY:	JMD
CHECKED BY:	JDE
SCALE:	1" = 10'
DATE:	DECEMBER 18, 2023
PROJECT NUMBER:	22-0173
SHEET TITLE:	WVWA AS-BUILTS

AB1

01 OF 01