
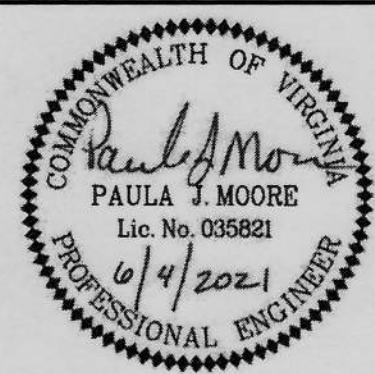
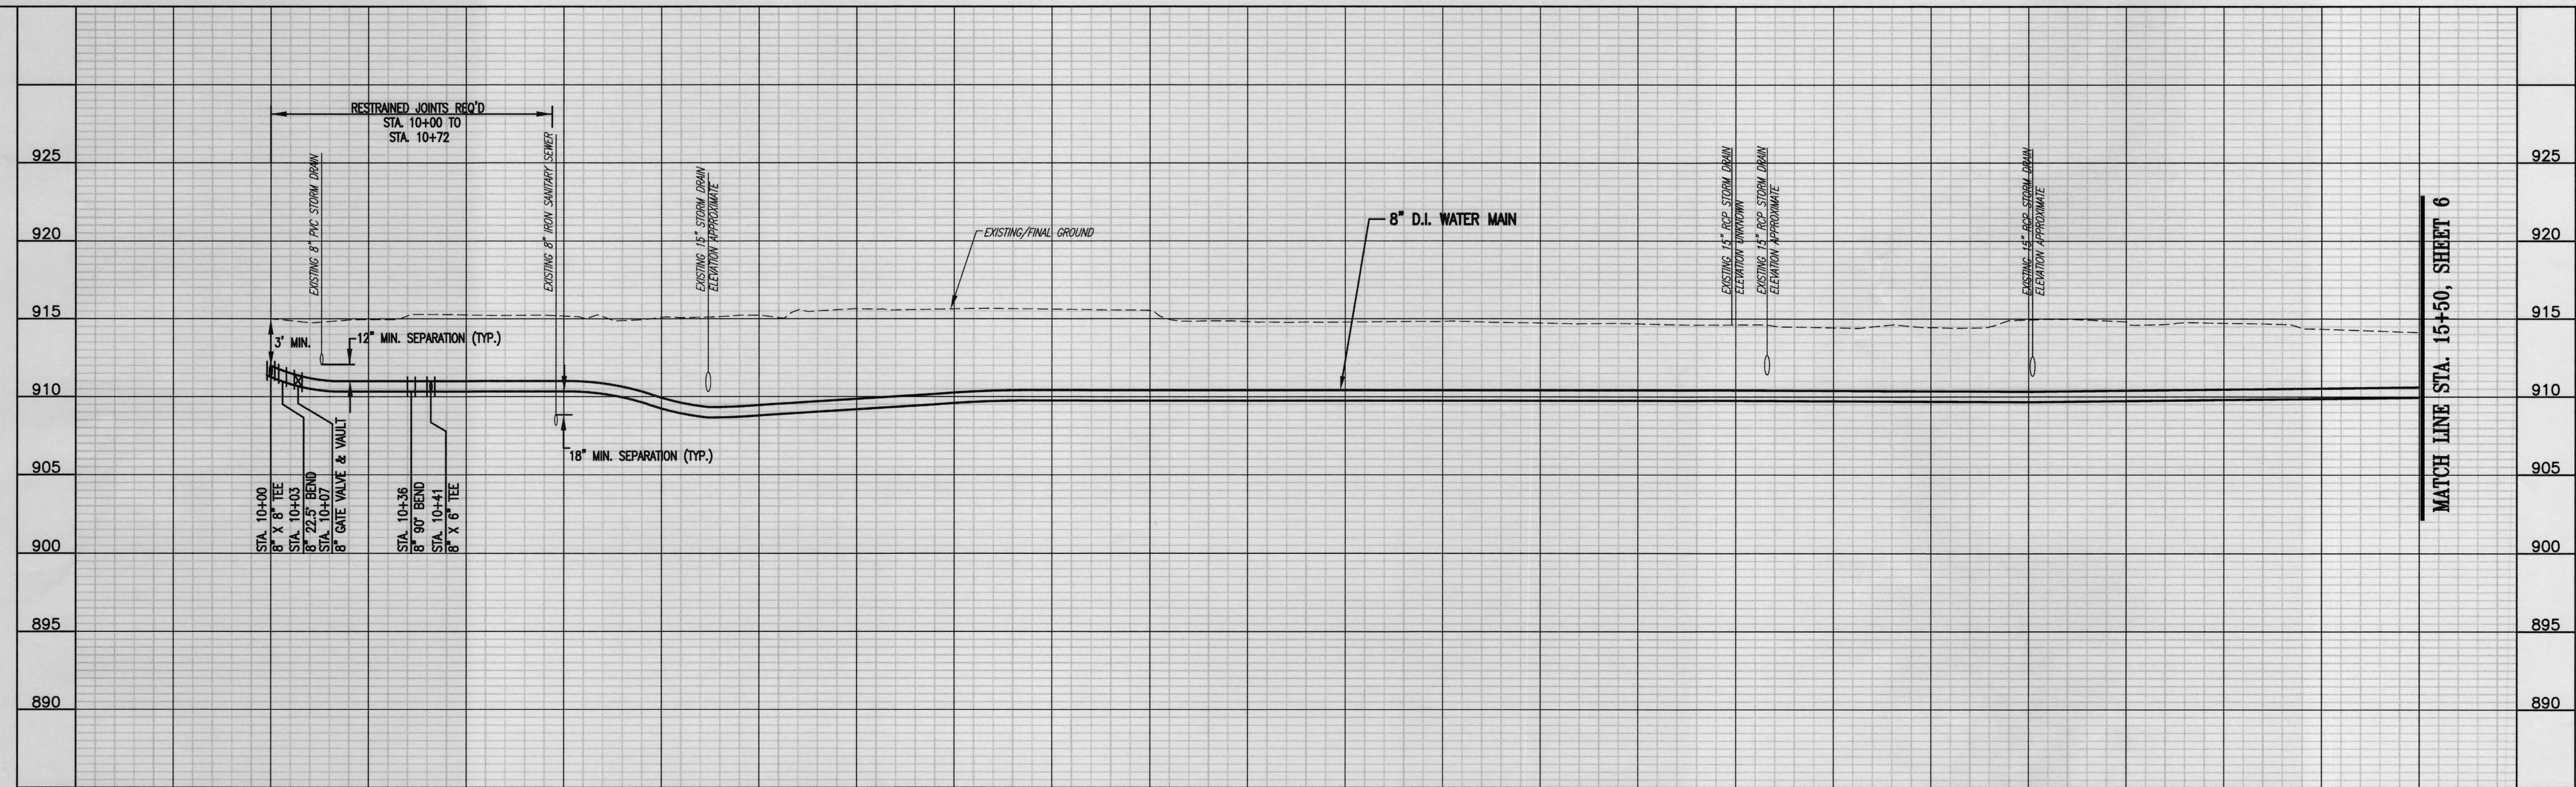


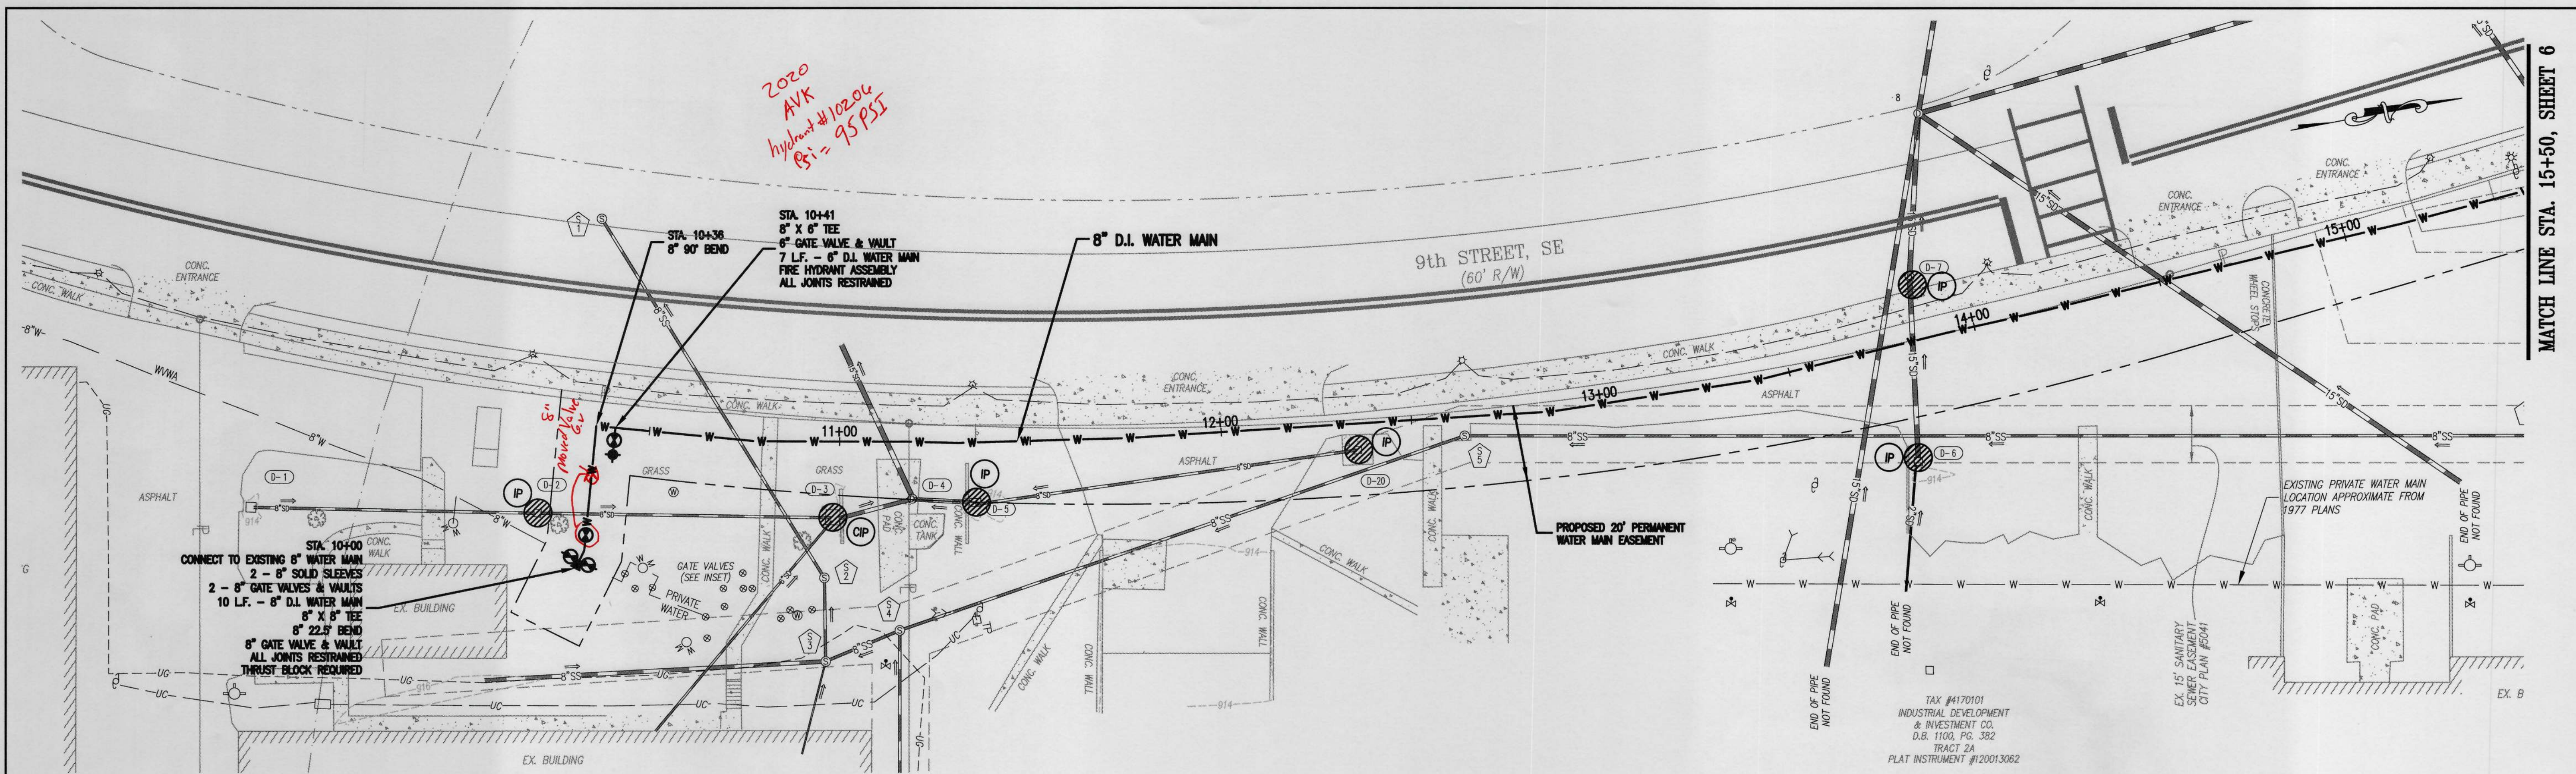

WESTERN VIRGINIA WATER AUTHORITY
601 South Jefferson Street, Suite 300
Roanoke, Virginia 24011

DES: PJM
DRAWN: JES
CHECK: PJM
DATE: 6/04/21

SCALE: AS SHOWN
HORIZ: 1" = 20'
VERT: 1" = 5'

WESTERN VIRGINIA WATER AUTHORITY
9TH STREET, SE
WATER MAIN EXTENSION

8" WATER MAIN PLAN - PROFILE
STA. 10+00 TO STA. 15+50

DRAWING
C1.09

SHEET
9

REV	DATE	DESCRIPTION