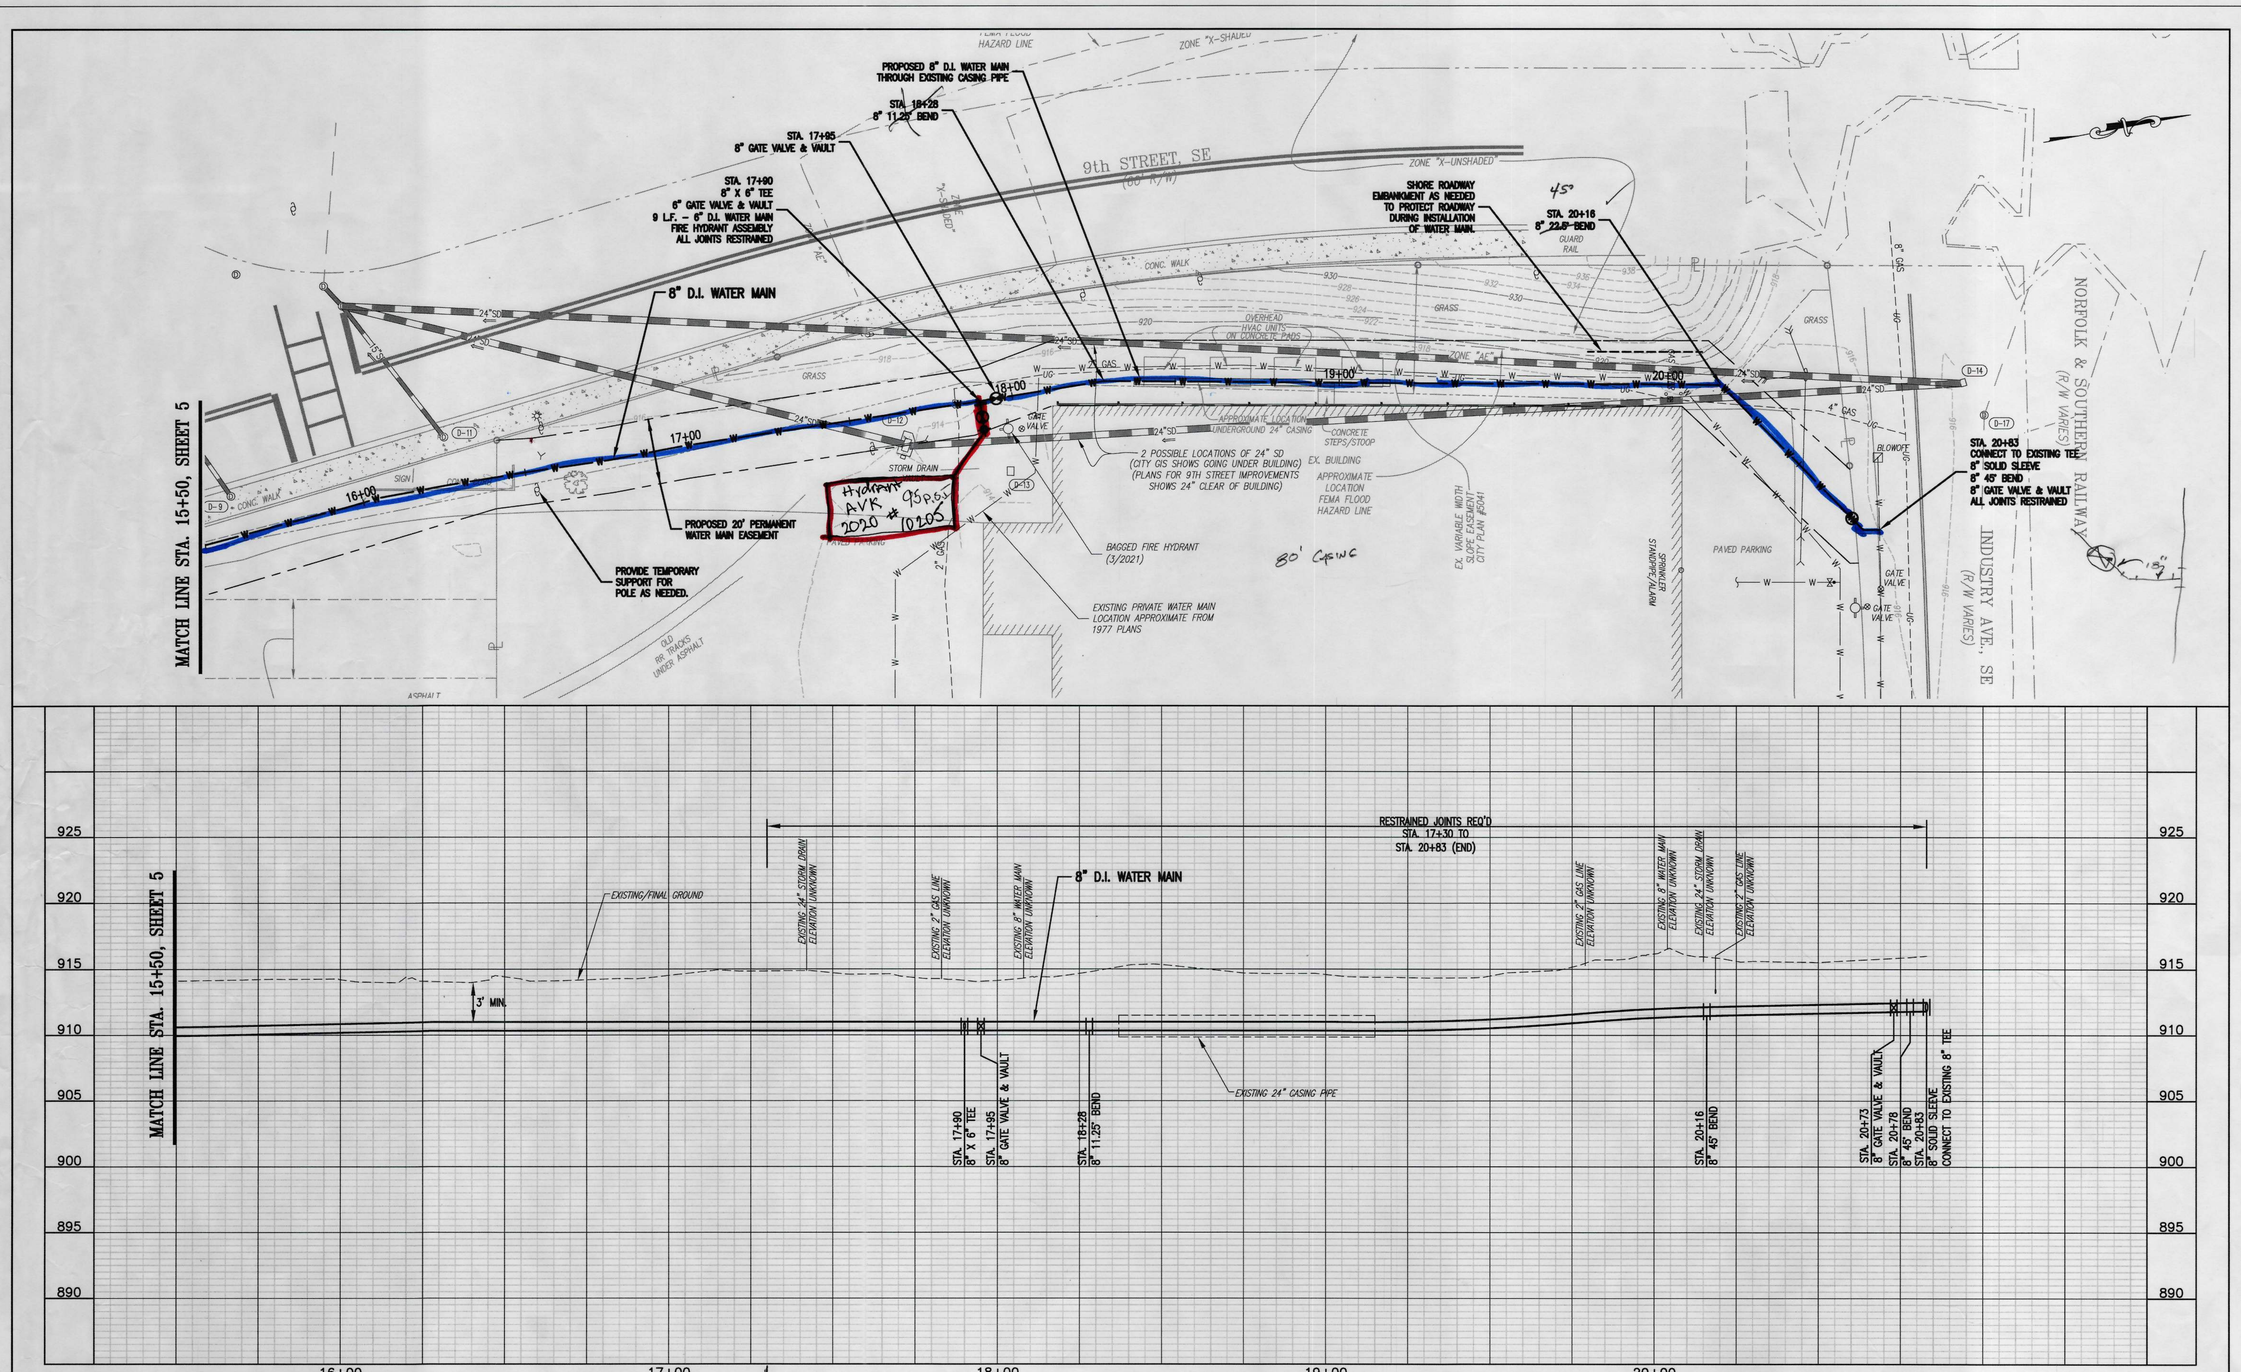

GRAPHIC SCALES

(IN FEET)
HORIZ. 1 inch = 20 feet

(IN FEET)
VERT: 1 inch = 5 feet

COMMONWEALTH OF VIRGINIA
PAULA J. MOORE
Lic. No. 035821
6/4/2021
PROFESSIONAL ENGINEER

WRA
Whitman, Requardt & Associates, LLP
1700 Kraft Dr, Suite 1200, Blacksburg, VA 24060

WESTERN VIRGINIA WATER AUTHORITY
601 South Jefferson Street, Suite 300
Roanoke, Virginia 24011

DES: PJM	SCALE: AS SHOWN
DRAWN: JES	HORIZ: 1" = 20'
CHECK: PJM	VERT: 1" = 5'
DATE: 6/04/21	

WESTERN VIRGINIA WATER AUTHORITY
9TH STREET, SE
WATER MAIN EXTENSION

8" WATER MAIN PLAN – PROFILE
STA. 15+50 TO STA. 20+83

REV	DATE	DESCRIPTION

DRAWING	SHEET
C1.10	10