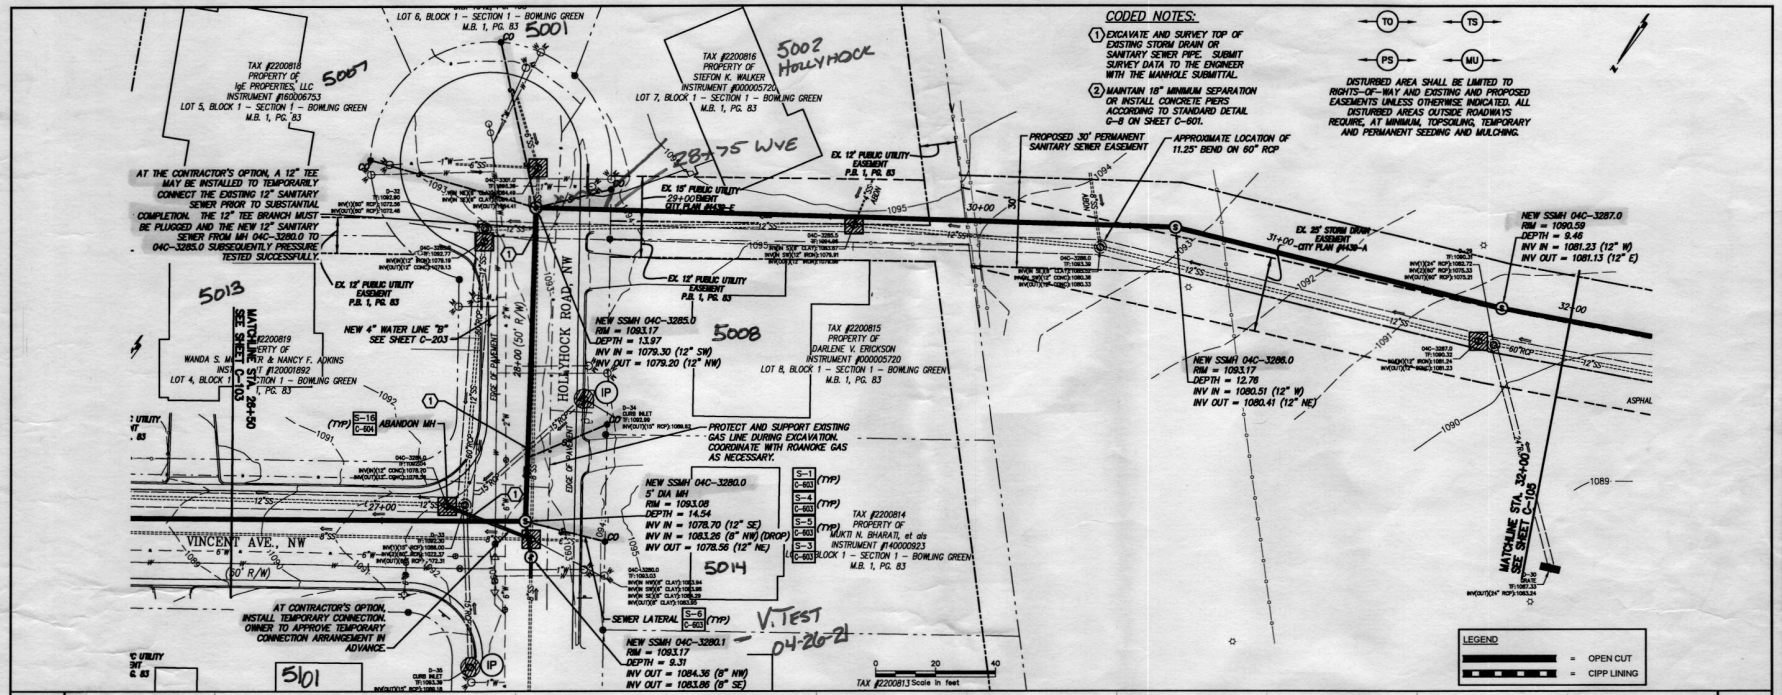

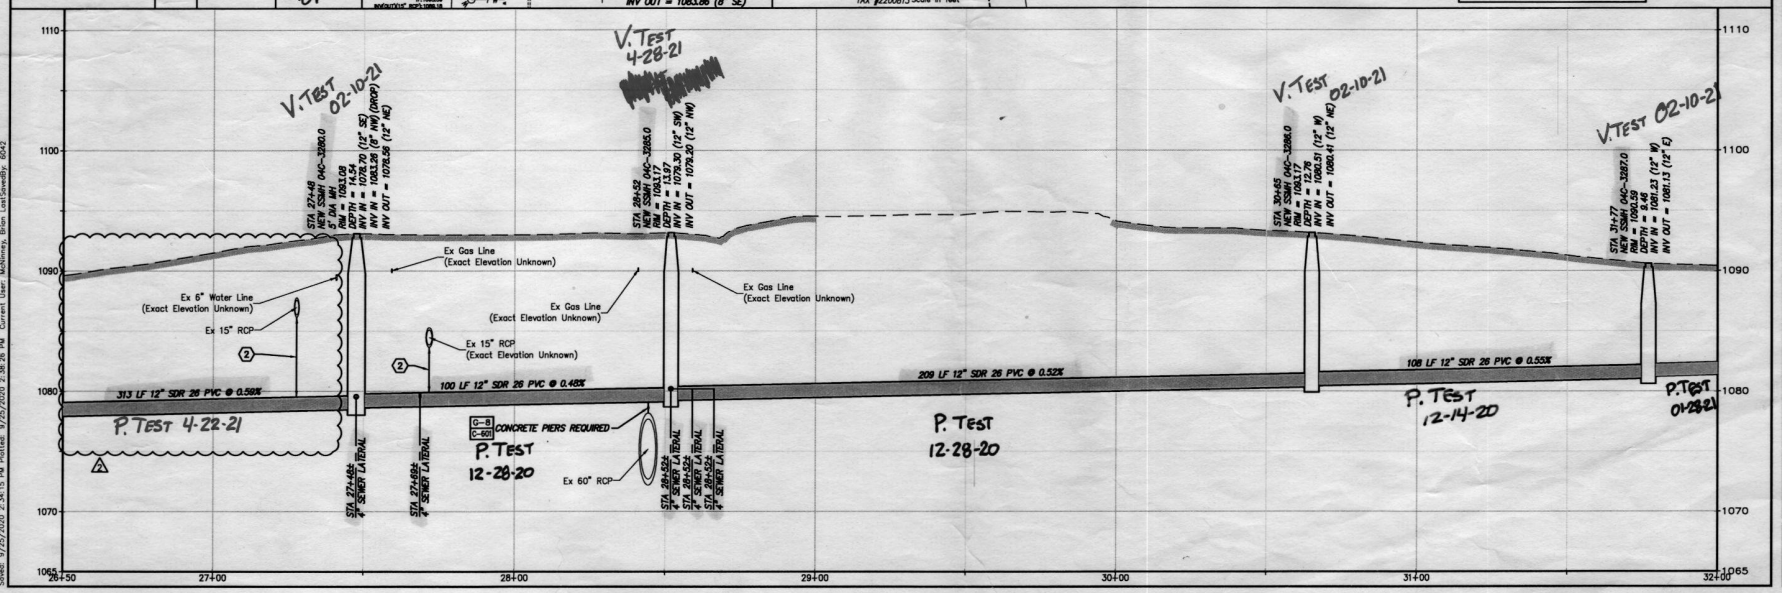

Drawing Copyright © 2020

CHA
1341 Research Center Drive, Suite 2100
Blacksburg, VA 24060
540.552.5548 • www.chacompanies.com

WESTERN VIRGINIA WATER AUTHORITY

COMMONWEALTH OF VIRGINIA
DOUGLAS B. HUDGINS
Lic. No. 034694
04/25/20
PROFESSIONAL ENGINEER

IT IS A VIOLATION OF LAW FOR ANY PERSON, UNLESS THEY ARE ACTING UNDER THE DIRECTION OF A LICENSED PROFESSIONAL ENGINEER, TO ALTER IN ANY WAY AN ENGINEERING DOCUMENT BEARING THE SEAL OF A LICENSED PROFESSIONAL ENGINEER. IF THIS DOCUMENT IS ALTERED, THE ALTERING ENGINEER SHALL STAMP THE DOCUMENT AND INDICATE THE NATURE OF THE ALTERATION, SIGN AND DATE THE ALTERATION. THE SEAL, SIGNATURE AND DATE FOLLOWED BY THEIR DESIGNATION, OR THE SEAL OF EACH ENGINEER, ARE REQUIRED UNLESS EXEMPTED BY THE ALBEMARLE.

WESTERN VIRGINIA WATER AUTHORITY

AIRPORT ROAD TO PALM VALLEY ROAD SANITARY SEWER REPLACEMENT

No.	Submittal / Revision	App'd.	By	Date
1	REV #1	EES	BJM	09/25/20
	BID SET	EES	BJM	6/25/20

SANITARY SEWER PLAN & PROFILE

Designed By:	Drawn By:	Checked By:
EES	BJM	DBH
Issue Date:	Project No:	Scale:
6/17/20	35613	AS NOTED

Drawing No.:
C-104

File: V:\PROJECTS\ANY\VS\35613\CADD_ACAD\C-104_35613.DWG
Saved: 9/25/2020 2:34:15 PM Plotted: 9/25/2020 2:38:26 PM Current User: McKinney, Brian Last Saved By: 6042