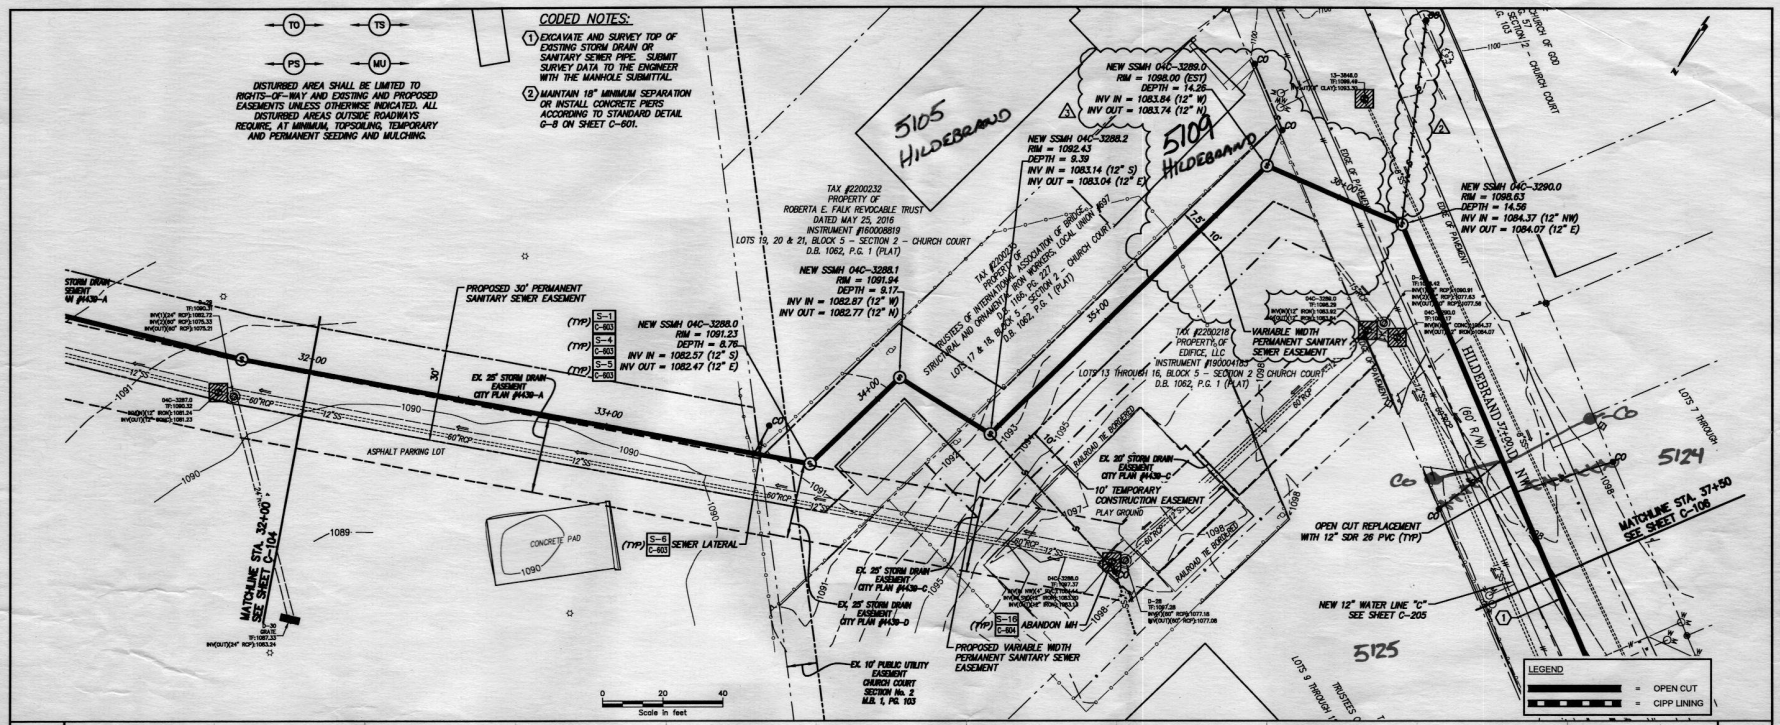

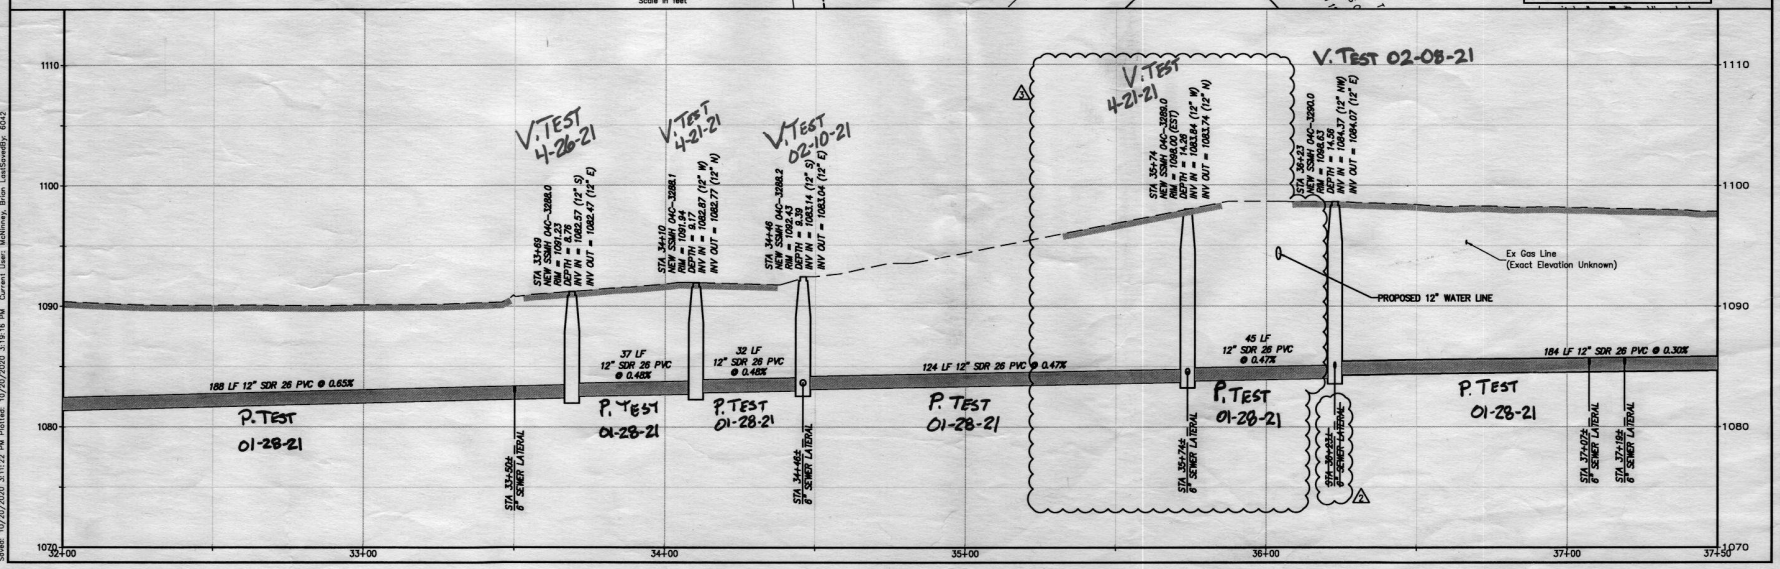

Drawing Copyright © 2020

CHA
1341 Research Center Drive, Suite 2100
Blacksburg, VA 24060
540.552.5548 • www.champarales.com

WESTERN VIRGINIA WATER AUTHORITY

COMMONWEALTH OF VIRGINIA
DOUGLAS B. HUDGINS
Lic. No. 034694
04/25/20
PROFESSIONAL ENGINEER

IT IS A VIOLATION OF LAW FOR ANY PERSON, UNLESS THEY ARE ACTING UNDER THE DIRECTION OF A LICENSED PROFESSIONAL ENGINEER, ARCHITECT, LANDSCAPE ARCHITECT OR LAND SURVEYOR, TO ALTER AN ITEM IN ANY WAY. IF AN ITEM BEARING THE STAMP OF A LICENSED PROFESSIONAL ENGINEER, ARCHITECT, LANDSCAPE ARCHITECT OR LAND SURVEYOR IS ALTERED, THE ALTERING ENGINEER, ARCHITECT, LANDSCAPE ARCHITECT OR LAND SURVEYOR SHALL STAMP THE DOCUMENT OR DOCUMENTS AND SHALL ADD THE WORDS "ALTERED BY" FOLLOWED BY HIS SIGNATURE, THE DATE OF SUCH ALTERATION, AND A SPECIFIC DESCRIPTION OF THE ALTERATION.

WESTERN VIRGINIA WATER AUTHORITY

AIRPORT ROAD TO PALM VALLEY ROAD SANITARY SEWER REPLACEMENT

No.	Submittal / Revision	App'd.	By	Date
2	REV #2	EES	BJM	10/20/20
1	REV #1	EES	BJM	09/25/20
	BID SET	EES	BJM	6/25/20

SANITARY SEWER PLAN & PROFILE

Designed By:	Drawn By:	Checked By:
EES	BJM	DBH
Issue Date:	Project No:	Scale:
6/17/20	35613	AS NOTED

Drawing No.:
C-105

File: V:\PROJECTS\ANY\K6\35613\CADD_ACAD\C-105_35613.DWG
Saved: 10/20/2020 3:11:22 PM Plotted: 10/20/2020 3:19:16 PM Current User: McKinney, Brian LastSavedBy: 6042

DONE