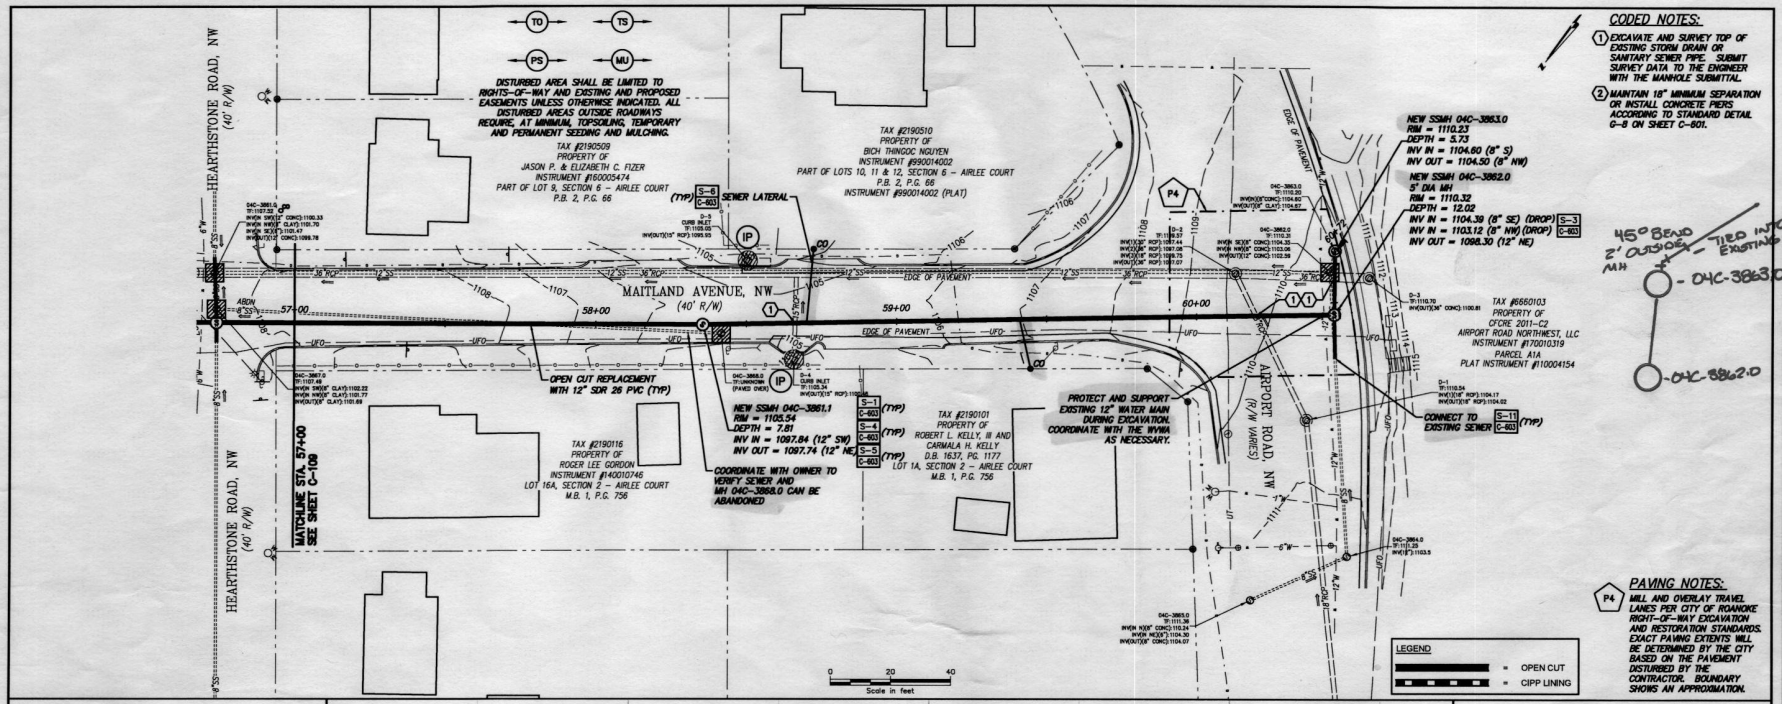

CODED NOTES:

1. EXCAVATE AND SURVEY TOP OF EXISTING STORM DRAIN OR SANITARY SEWER PIPE. SUBMIT SURVEY DATA TO THE ENGINEER WITH THE MANHOLE SUBMITTAL.
2. MAINTAIN 18" MINIMUM SEPARATION OR INSTALL CONCRETE PIERS ACCORDING TO STANDARD DETAIL G-8 ON SHEET C-601.

45° BEND 2' OUTSIDE EX. MH — TIED INTO EXISTING

- 04C-3863.0
- 04C-3862.0

PAVING NOTES:

P4 MILL AND OVERLAY TRAVEL LANES PER CITY OF ROANOKE RIGHT-OF-WAY EXCAVATION AND RESTORATION STANDARDS. EXACT PAVING EXTENTS WILL BE DETERMINED BY THE CITY BASED ON THE PAVEMENT DISTURBED BY THE CONTRACTOR. BOUNDARY SHOWS AN APPROXIMATION.

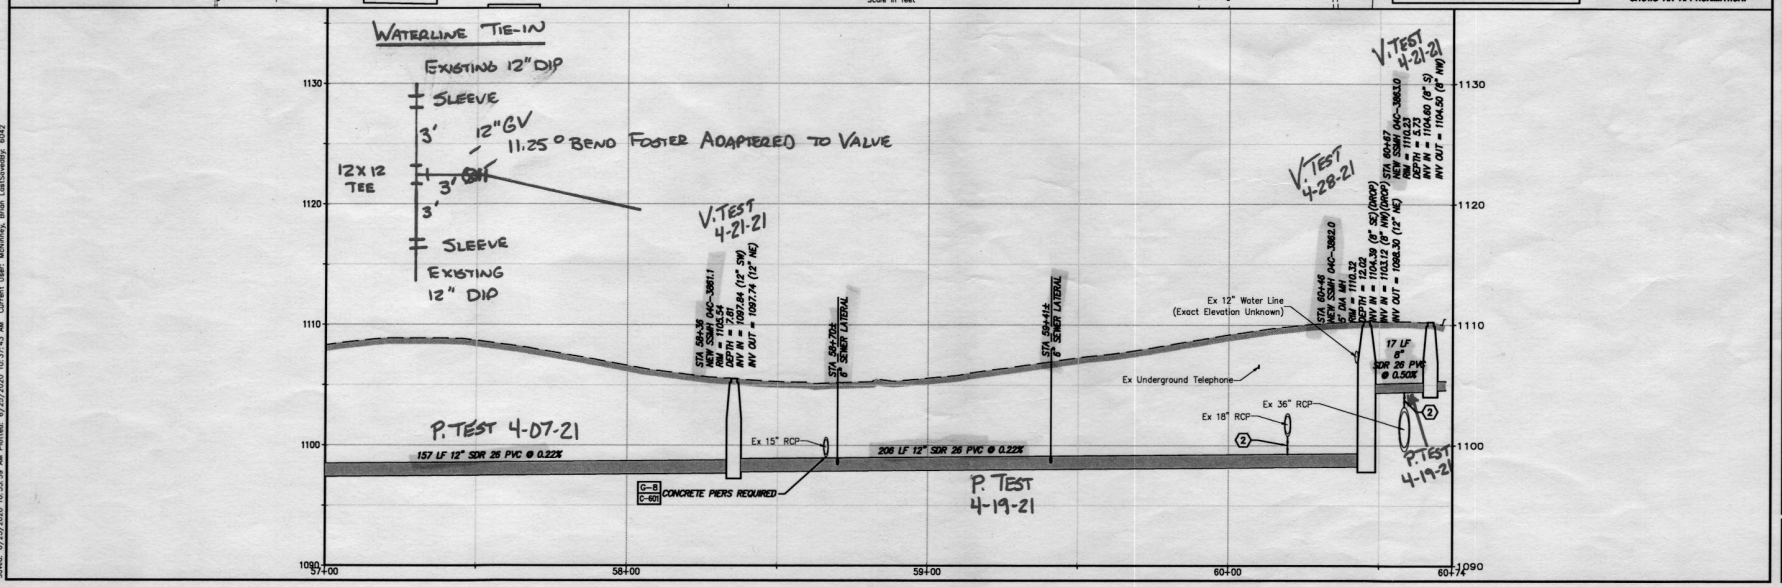

Drawing Copyright © 2020

CHA
1341 Research Center Drive, Suite 2100
Blacksburg, VA 24060
540.552.5368 • www.chapmanpace.com

WESTERN VIRGINIA WATER AUTHORITY

COMMONWEALTH OF VIRGINIA
DOUGLAS B. HUDGINS
Lic. No. 054694
04/29/12
PROFESSIONAL ENGINEER

IT IS A VIOLATION OF LAW FOR ANY PERSON, UNLESS THEY ARE ACTING UNDER THE DIRECTION OF A LICENSED PROFESSIONAL ENGINEER, ARCHITECT, LANDSCAPE ARCHITECT OR LAND SURVEYOR, TO ALTER AN ITEM IN ANY WAY. IF AN ITEM BEARING THE SEAL OF A PROFESSIONAL ENGINEER, ARCHITECT, LANDSCAPE ARCHITECT OR LAND SURVEYOR SHALL STAMP THE DOCUMENT AND INCLUDE THE NOTATION "ALTERED BY" FOLLOWED BY THE SIGNATURE AND THE DATE OF SUCH ALTERATION, AND A SPECIFIC DESCRIPTION OF THE ALTERATION.

WESTERN VIRGINIA WATER AUTHORITY

AIRPORT ROAD TO PALM VALLEY ROAD SANITARY SEWER REPLACEMENT

No.	Submittal / Revision	App'd	By	Date
	BID SET	EES	BJM	6/25/20

SANITARY SEWER PLAN & PROFILE

Designed By:	Drawn By:	Checked By:
EES	BJM	DBH
Issue Date:	Project No:	Scale:
6/17/20	35613	AS NOTED

Drawing No.:

C-110

File: V:\PROJECTS\AHV\35613\CADD_ACAD\C-109_35613.DWG
Saved: 6/25/2020 10:33:59 AM Plotted: 6/25/2020 10:33:42 AM Current User: McKinney, Brian LastSavedBy: 8042