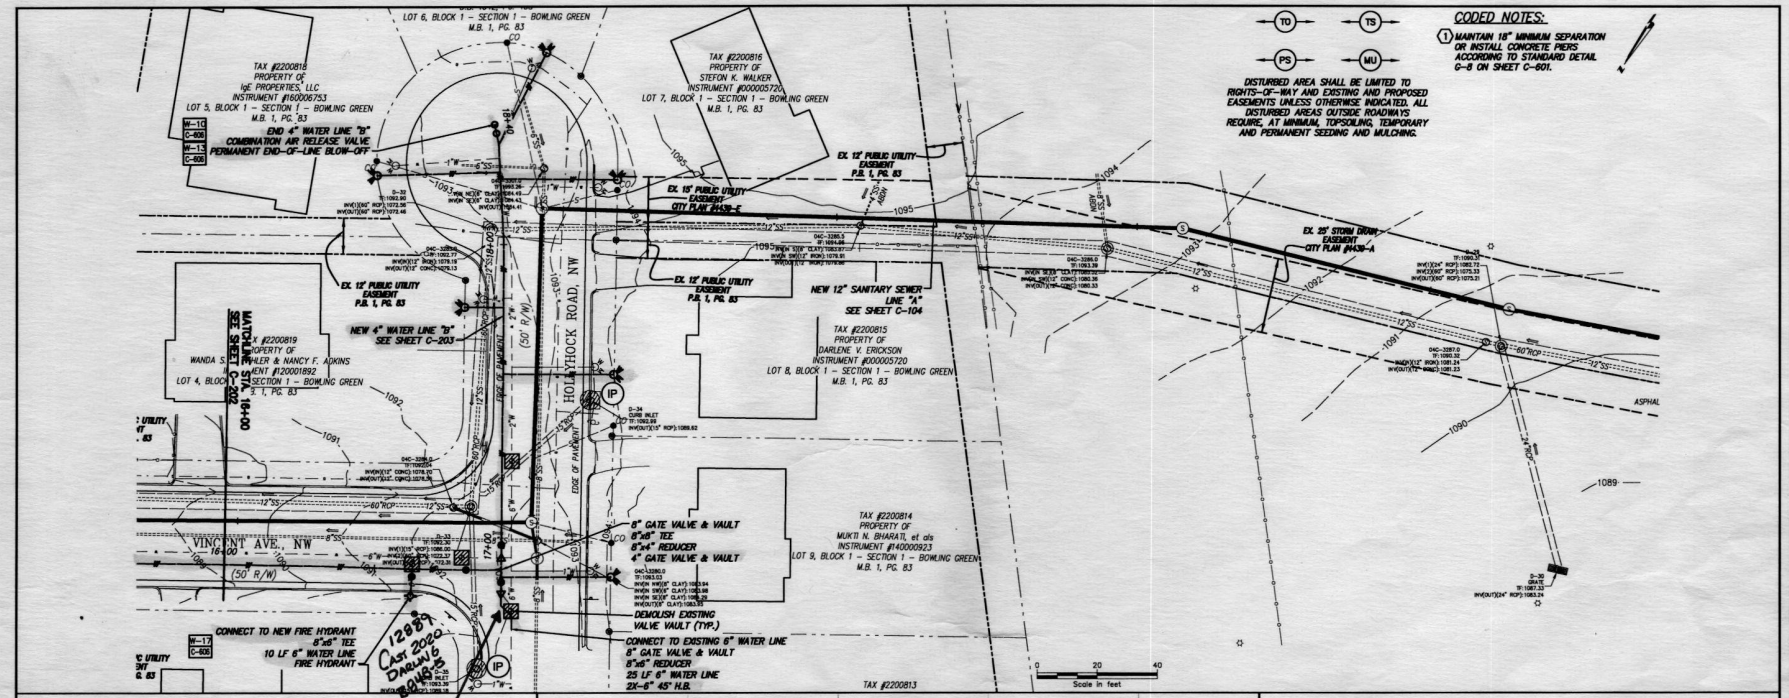

CODED NOTES:

1. MAINTAIN 18" MINIMUM SEPARATION OR INSTALL CONCRETE PIERS ACCORDING TO STANDARD DETAIL G-9 ON SHEET C-601.

TO TS PS MU

DISTURBED AREA SHALL BE LIMITED TO RIGHTS-OF-WAY AND EXISTING AND PROPOSED EASEMENTS UNLESS OTHERWISE INDICATED. ALL DISTURBED AREAS OUTSIDE ROADWAYS REQUIRE, AT MINIMUM, TOPSOILING, TEMPORARY AND PERMANENT SEEDING AND MULCHING.

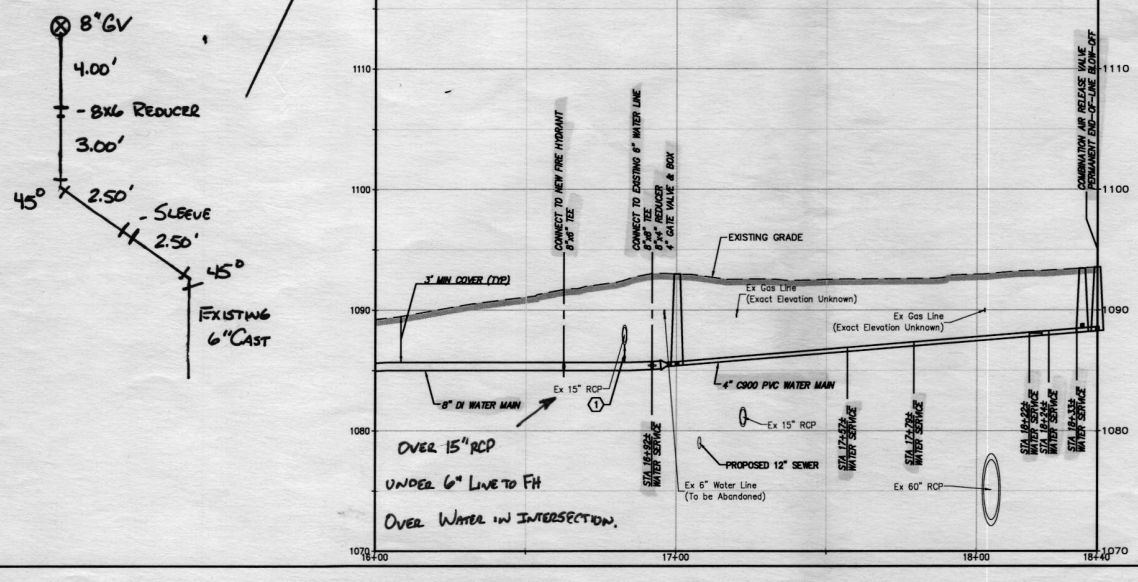

OVER 15" RCP
UNDER 6" LINE TO FH
OVER WATER IN INTERSECTION.

Drawing Copyright © 2020

CHA
1341 Research Center Drive, Suite 2100
Blacksburg, VA 24060
540.552.5048 • www.chacompanies.com

WESTERN VIRGINIA WATER AUTHORITY

COMMONWEALTH OF VIRGINIA
DOUGLAS B. HUDGINS
Lic. No. 036694
06/15/20
PROFESSIONAL ENGINEER

IT IS A VIOLATION OF LAW FOR ANY PERSON, UNLESS THEY ARE ACTING UNDER THE DIRECTION OF A PROFESSIONAL ENGINEER, TO ALTER AN ITEM IN ANY WAY. IF AN ITEM BEARING THE SEAL OF A LICENSED PROFESSIONAL ENGINEER IS ALTERED, THE ALTERING ENGINEER SHALL ATTACH A DESCRIPTION OF THE ALTERATION TO THE SURVEYOR SHALL STAMP THE DOCUMENT AND INCLUDE THE NOTATION "ALTERED BY" FOLLOWED BY THEIR SIGNATURE, THE DATE OF SUCH ALTERATION, AND A SPECIFIC DESCRIPTION OF THE ALTERATION.

WESTERN VIRGINIA WATER AUTHORITY

AIRPORT ROAD TO PALM VALLEY ROAD SANITARY SEWER REPLACEMENT

No.	Submittal / Revision	App'd.	By	Date
	BID SET		EES	BJM	6/25/20

WATER PLAN & PROFILE

Designed By:	Drawn By:	Checked By:
EES	BJM	DBH
Issue Date:	Project No:	Scale:
6/17/20	35613	AS NOTED

Drawing No.:
C-203

File: V:\PROJECTS\ANY\VS\35613\CADD_ACAD\C-20X_35613.DWG
Sheet: 6/25/2020 10:34:10 AM Plotted: 6/25/2020 10:39:35 AM Current User: McKinney, Brian LastSavedBy: 8042