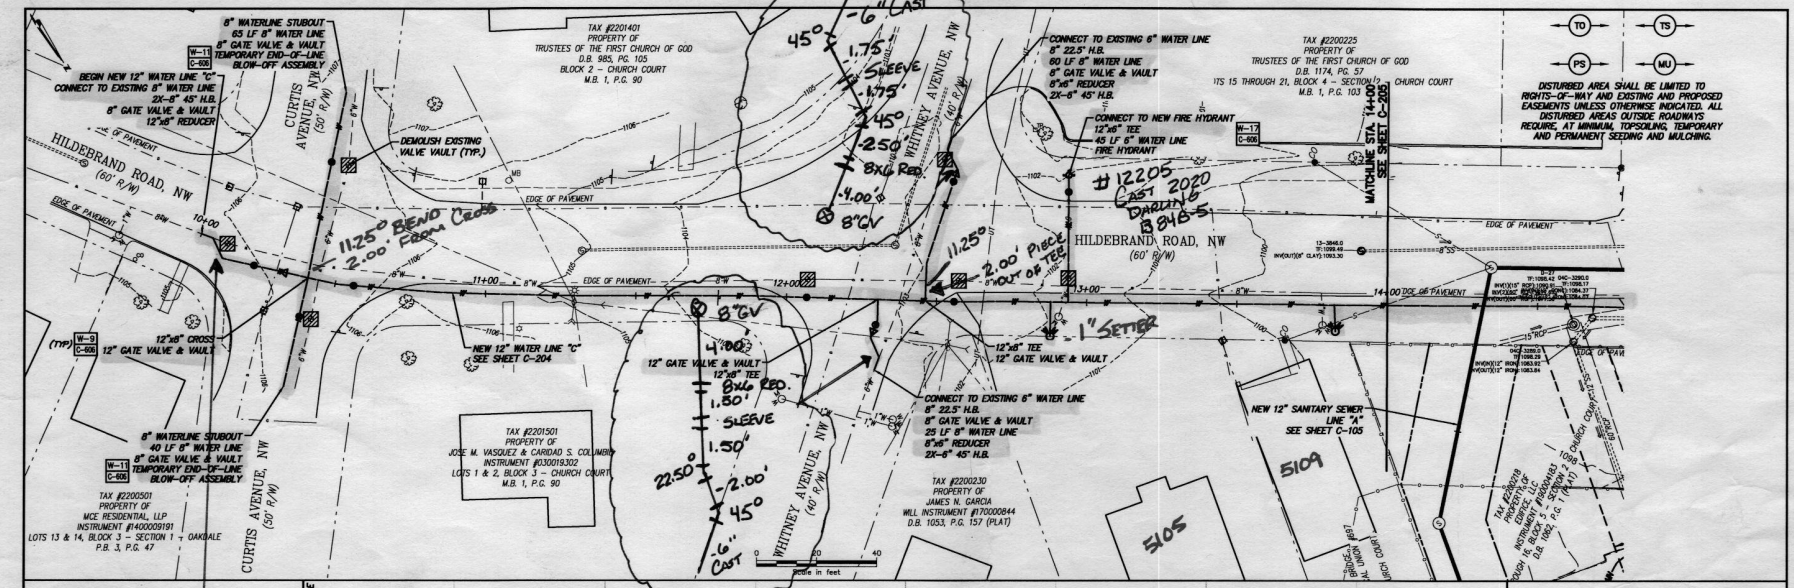

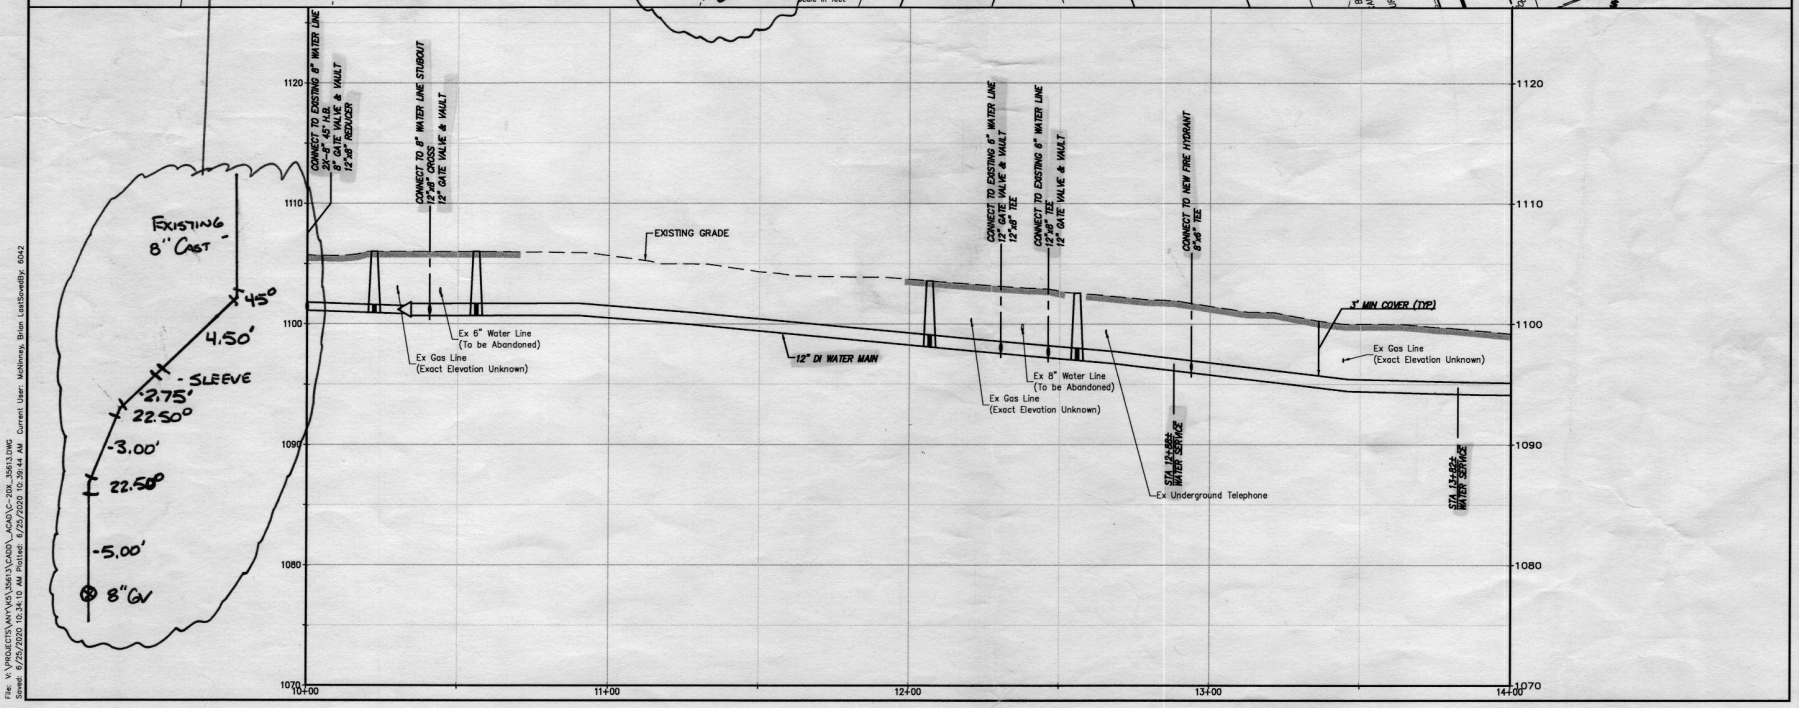

Drawing Copyright © 2020

CHA
1341 Research Center Drive, Suite 2100
Blacksburg, VA 24060
540.552.3548 • www.chacompanies.com

WESTERN VIRGINIA
WATER AUTHORITY

COMMONWEALTH OF VIRGINIA
DOUGLAS B. HUDGINS
Lic. No. 034694
06/15/20
PROFESSIONAL ENGINEER

IT IS A VIOLATION OF LAW FOR ANY PERSON, UNLESS THEY ARE ACTING UNDER THE DIRECTION OF A LICENSED PROFESSIONAL ENGINEER, TO ALTER AN ITEM IN ANY WAY. IF AN ITEM BEARING THE SEAL OF A LICENSED PROFESSIONAL IS ALTERED, THE ALTERING ENGINEER SHALL ATTACH A DESCRIPTIVE DESIGNATION, THE ENGINEER'S SEAL, STAMP THE DOCUMENT AND INCLUDE THE NOTATION "ALTERED BY" FOLLOWED BY THEIR SIGNATURE, THE DATE OF SUCH ALTERATION, AND A SPECIFIC DESCRIPTION OF THE ALTERATION.

WESTERN VIRGINIA
WATER AUTHORITY

AIRPORT ROAD TO
PALM VALLEY ROAD
SANITARY SEWER
REPLACEMENT

No.	Submittal / Revision	App'd.	By	Date
	BID SET	EES	BJM	6/25/20

WATER PLAN &
PROFILE

Designed By:	Drawn By:	Checked By:
EES	BJM	DBH
Issue Date:	Project No:	Scale:
6/17/20	35613	AS NOTED

Drawing No.:
C-204

File: V:\PROJECTS\ANY\V45\35613\CADD_ACAD\C-204_35613.DWG
Saved: 6/25/2020 10:34:10 AM Plotted: 6/25/2020 10:39:44 AM Current User: McKinney, Brian LastSavedBy: 6042