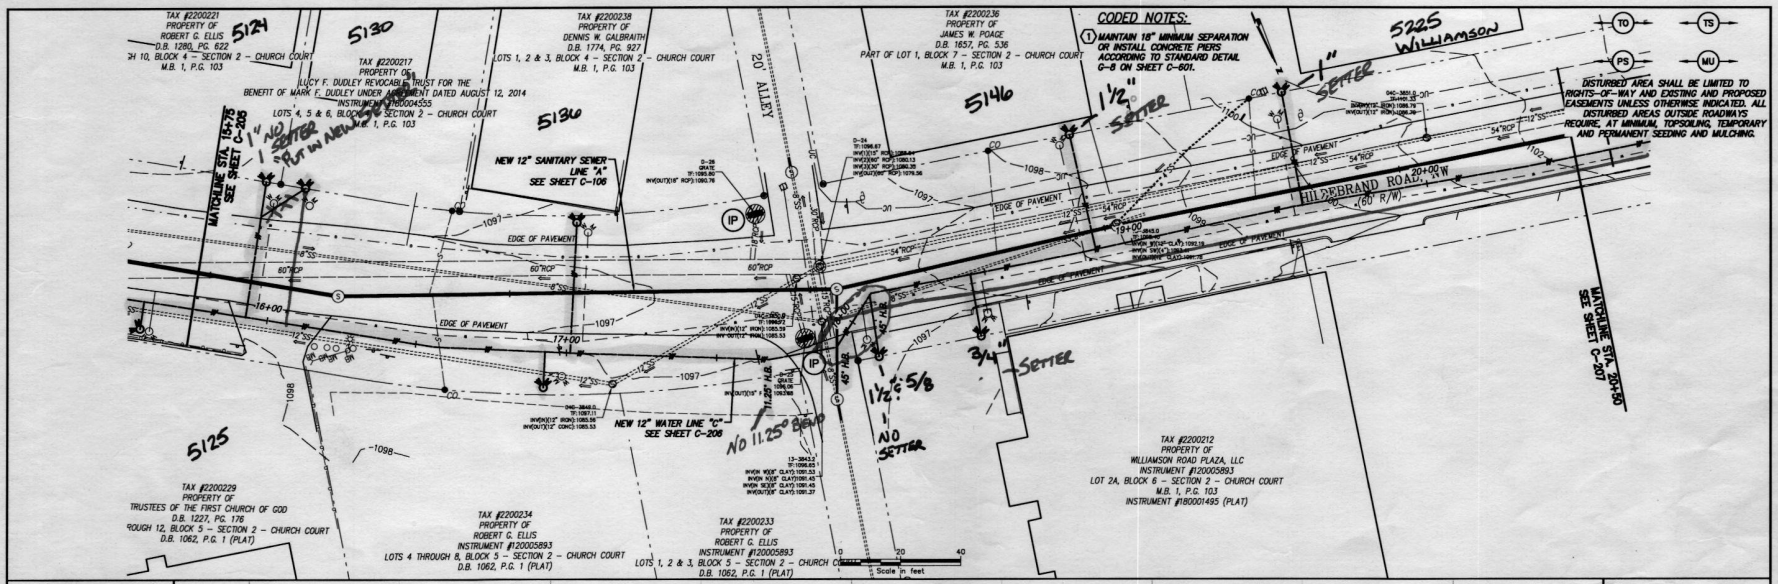

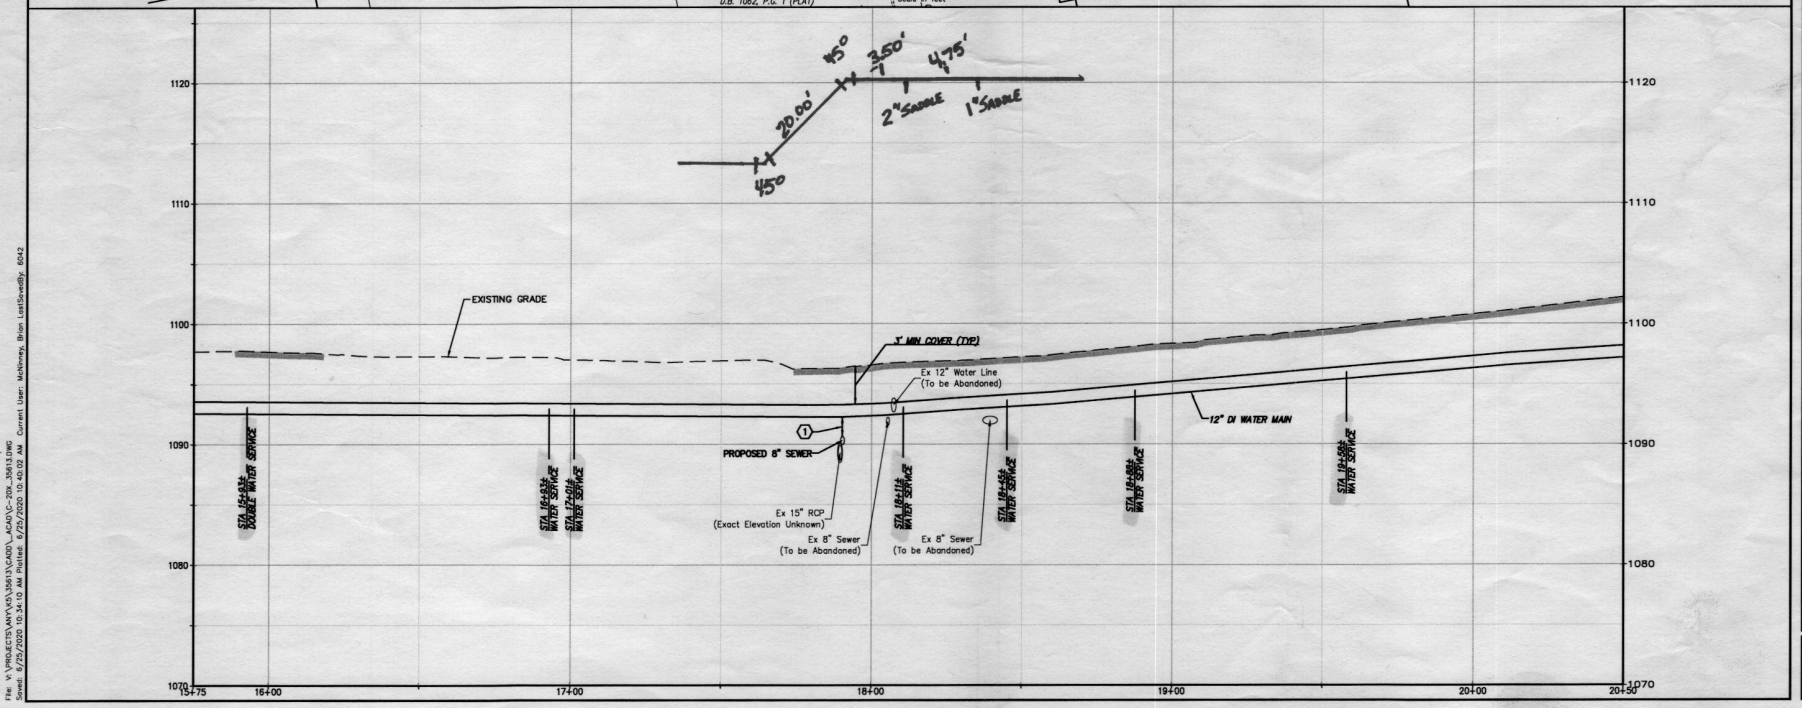

Drawing Copyright © 2020

CHA
1341 Research Center Drive, Suite 2100
Blacksburg, VA 24060
540.552.5548 • www.chaengineries.com

WESTERN VIRGINIA WATER AUTHORITY

COMMONWEALTH OF VIRGINIA
DOUGLAS B. HUDGINS
Lic. No. 034694
06/25/20
PROFESSIONAL ENGINEER

IT IS A VIOLATION OF LAW FOR ANY PERSON, UNLESS THEY ARE ACTING UNDER THE DIRECTION OF A PROFESSIONAL ENGINEER, ARCHITECT, LANDSCAPE ARCHITECT OR LAND SURVEYOR TO ALTER AN ITEM IN ANY WAY. IF AN ITEM BEARING THE STAMP OF A PROFESSIONAL ENGINEER IS ALTERED, AN ENGINEER, ARCHITECT, LANDSCAPE ARCHITECT OR LAND SURVEYOR SHALL STAMP THE DOCUMENT AND INCLUDE THE NOTATION "ALTERED BY" FOLLOWED BY THEIR SIGNATURE, THE DATE OF SUCH ALTERATION, AND A SPECIFIC DESCRIPTION OF THE ALTERATION.

WESTERN VIRGINIA WATER AUTHORITY

AIRPORT ROAD TO PALM VALLEY ROAD SANITARY SEWER REPLACEMENT

No.	Submittal / Revision	App'd.	By	Date
	BID SET	EES	BJM	6/25/20

WATER PLAN & PROFILE

Designed By:	Drawn By:	Checked By:
EES	BJM	DBH
Issue Date: 6/17/20	Project No: 35613	Scale: AS NOTED

Drawing No.:
C-206

File: V:\PROJECTS\ANY\X5\35613\CADD_ACAD\C-206_35613.DWG
Saved: 6/25/2020 10:34:10 AM Plotted: 6/25/2020 10:40:02 AM Current User: McKinney, Brian LastSavedBy: 6042