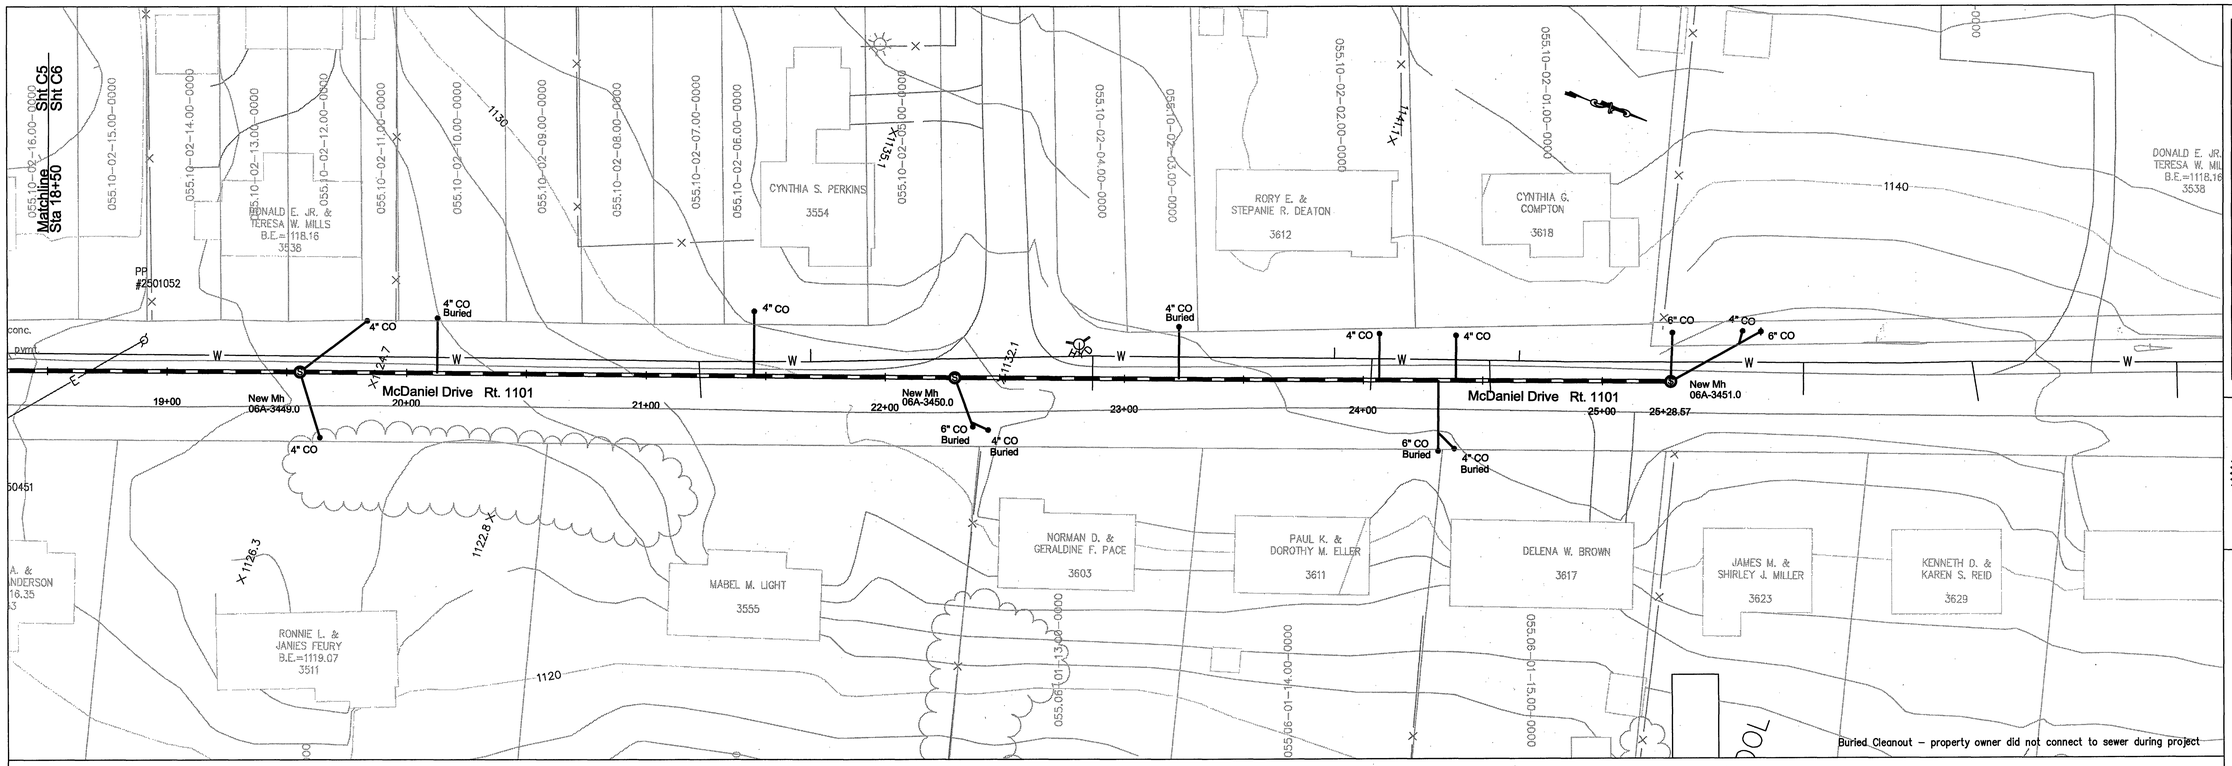

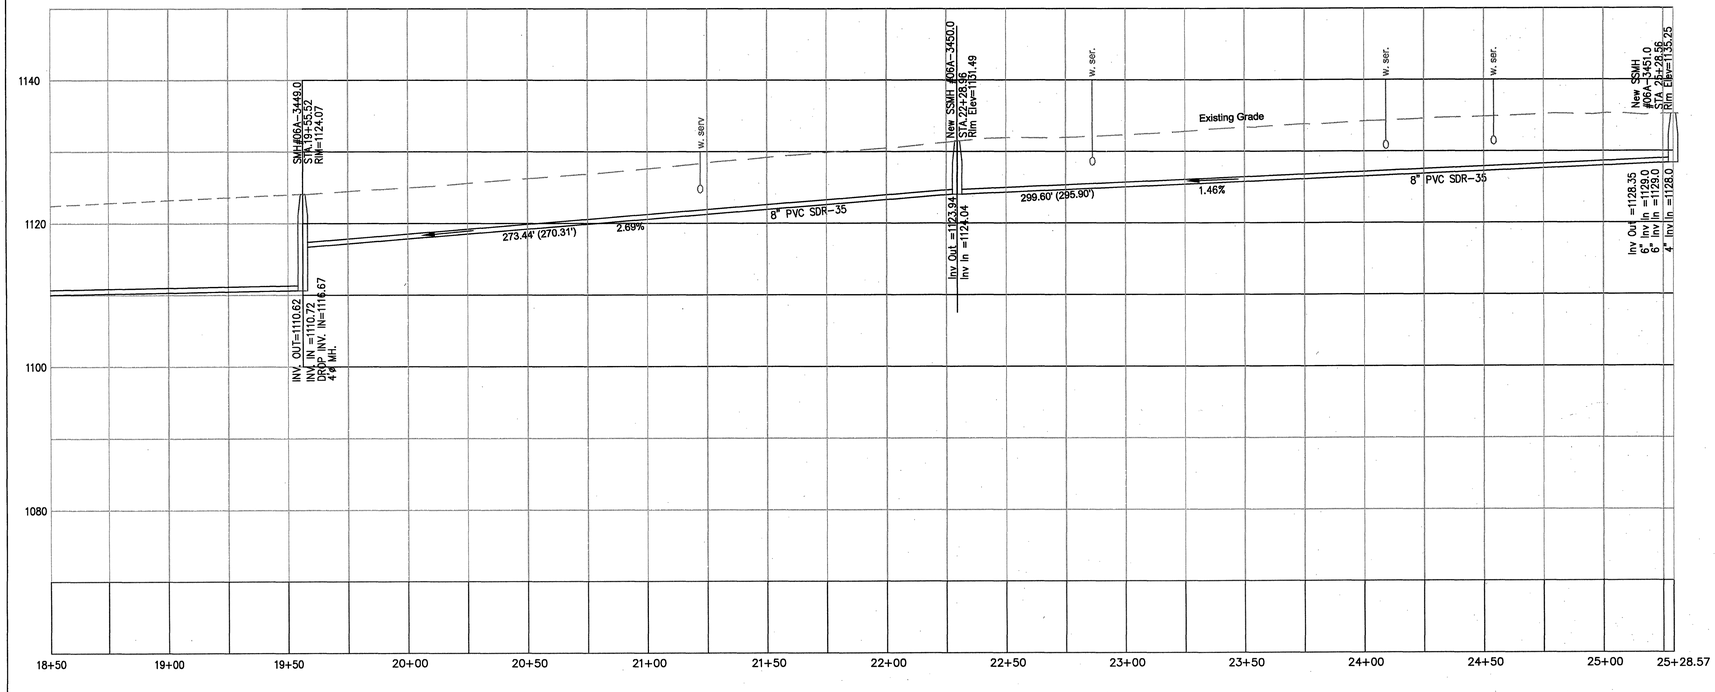

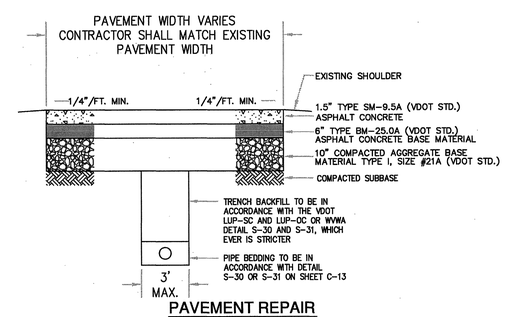

PAVEMENT REPAIR
McDANIEL DRIVE

NO SCALE

NOTES:

1. CUT AREAS ON MCDANIEL DRIVE TO BE REPAIRED USING STONE AND PATCHED WITH BM-25. ENTIRE WIDTH OF ROADWAY TO BE OVERLAID WITH SM-9.5A.
2. CONTRACTOR SHALL MATCH EXISTING ROAD GRADE AND CROSS SLOPE WHERE TIE-IN WITH EXISTING PAVEMENT OCCURS IN ORDER TO PROVIDE A SMOOTH TRANSITION FROM EXISTING PAVEMENT TO NEW PAVEMENT.

SCALE:
Vertical - 1" = 10'
Horizontal - 1" = 30'

GRAPHIC SCALE

30 0 15 30 60 120

(IN FEET)
1 inch = 30 ft.

ASBUILT

WESTERN VIRGINIA WATER AUTHORITY
ENGINEERING SERVICES
601 S JEFFERSON ST, SUITE 300
ROANOKE, VA 24011
540-853-5700

COMMONWEALTH OF VIRGINIA
Cassandra Altice
No. 035867
PROFESSIONAL ENGINEER

ANDREW LEWIS PLACE SANITARY SEWER EXTENSION

CIVIL/SITEWORK PLAN

Rev	Description	Date	By

Designed: CDA
Drawn: CDA
Checked: CDA
Approved: JGR
Date: 02 MAR 2009
Project:

C6
Sheet 6 of 16