


Buried Cleanout – property owner did not connect to sewer during project

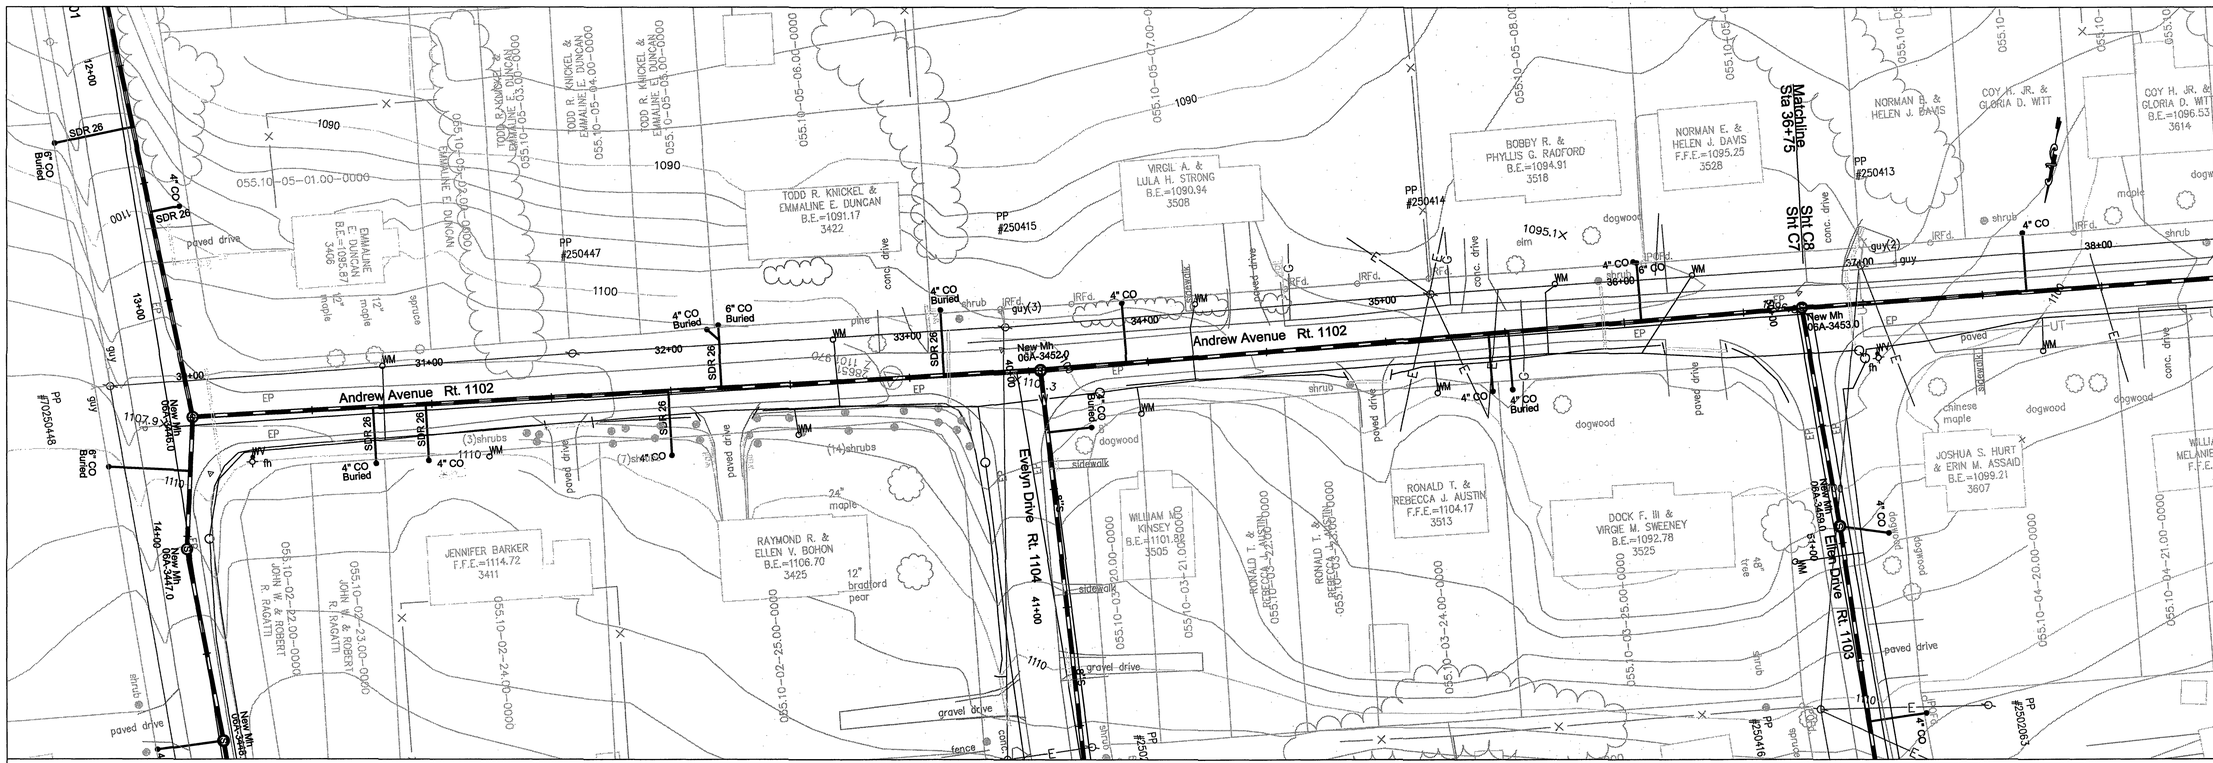


SCALE:
Vertical - 1" = 10'
Horizontal - 1" = 30'

GRAPHIC SCALE
30 0 15 30 60 120
( IN FEET )
1 inch = 30 ft.

ASBUILT

WESTERN VIRGINIA WATER AUTHORITY
ENGINEERING SERVICES
601 S JEFFERSON ST, SUITE 300
ROANOKE, VA 24011
540-853-5700

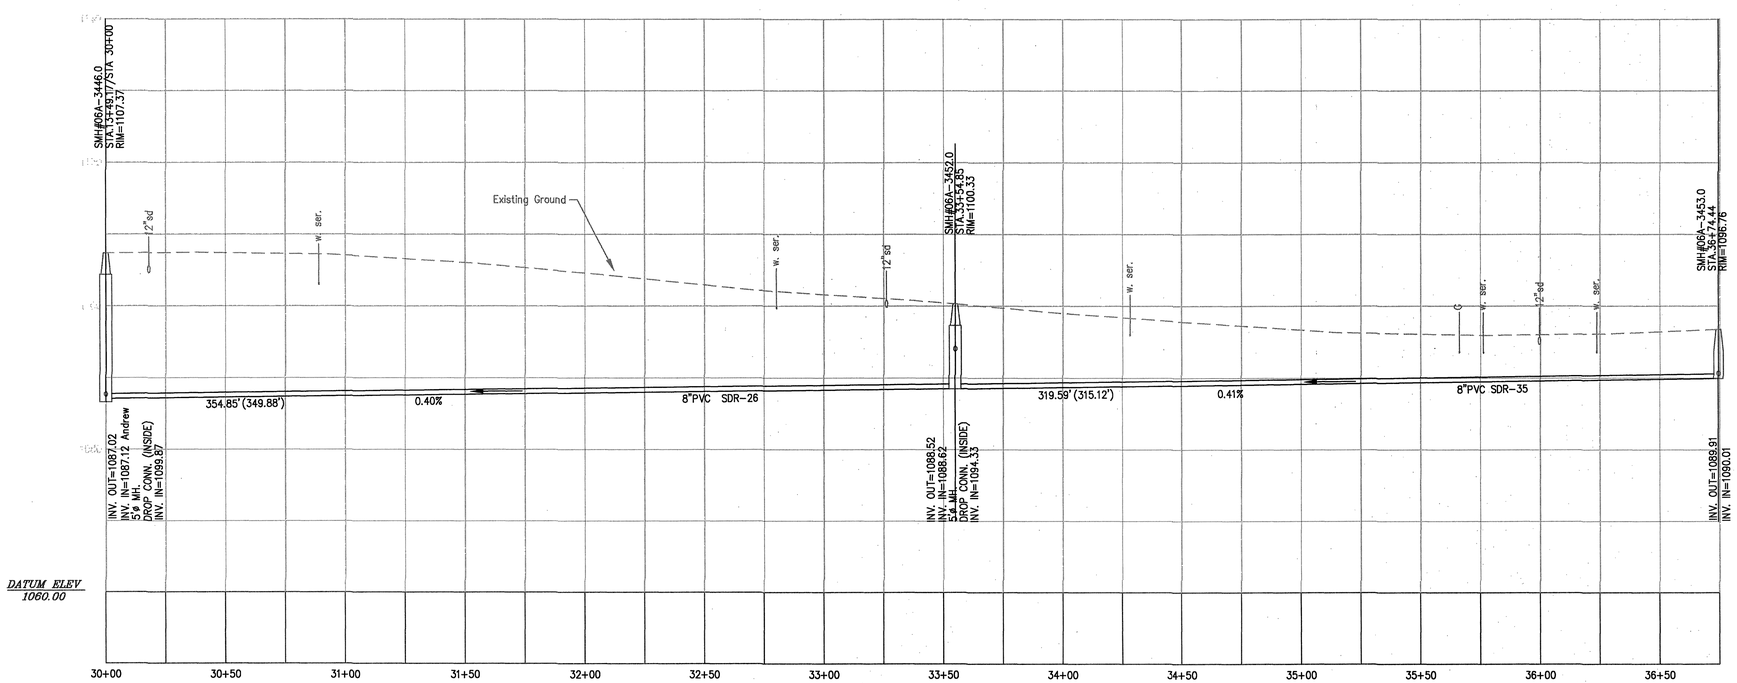COMMONWEALTH OF VIRGINIA
Cassandra Altice
No. 035867
PROFESSIONAL ENGINEER

ANDREW LEWIS PLACE
SANITARY SEWER EXTENSION

CIVIL/SITEWORK
PLAN

| Rev | Description | Date | By |
|---|---|---|---|
| | | | |

Designed: CDA
Drawn: CDA
Checked: CDA
Approved: JGR
Date: 02 MAR 2009
Project:

C7
Sheet 7 of 16