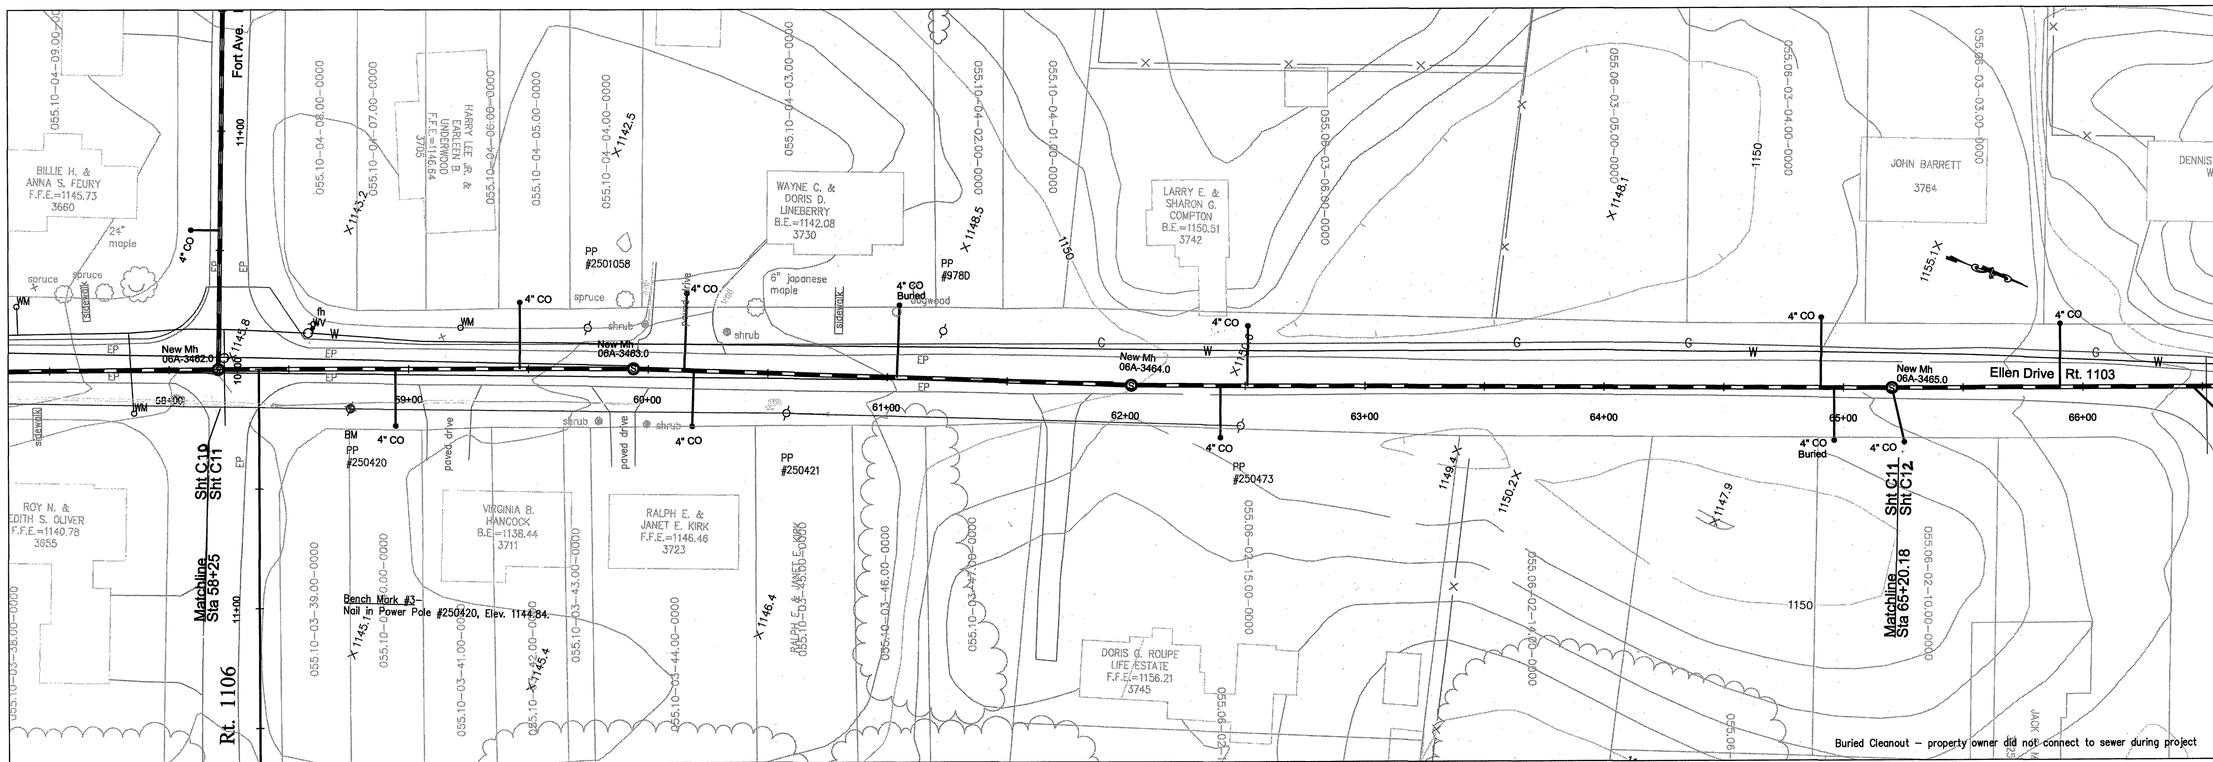

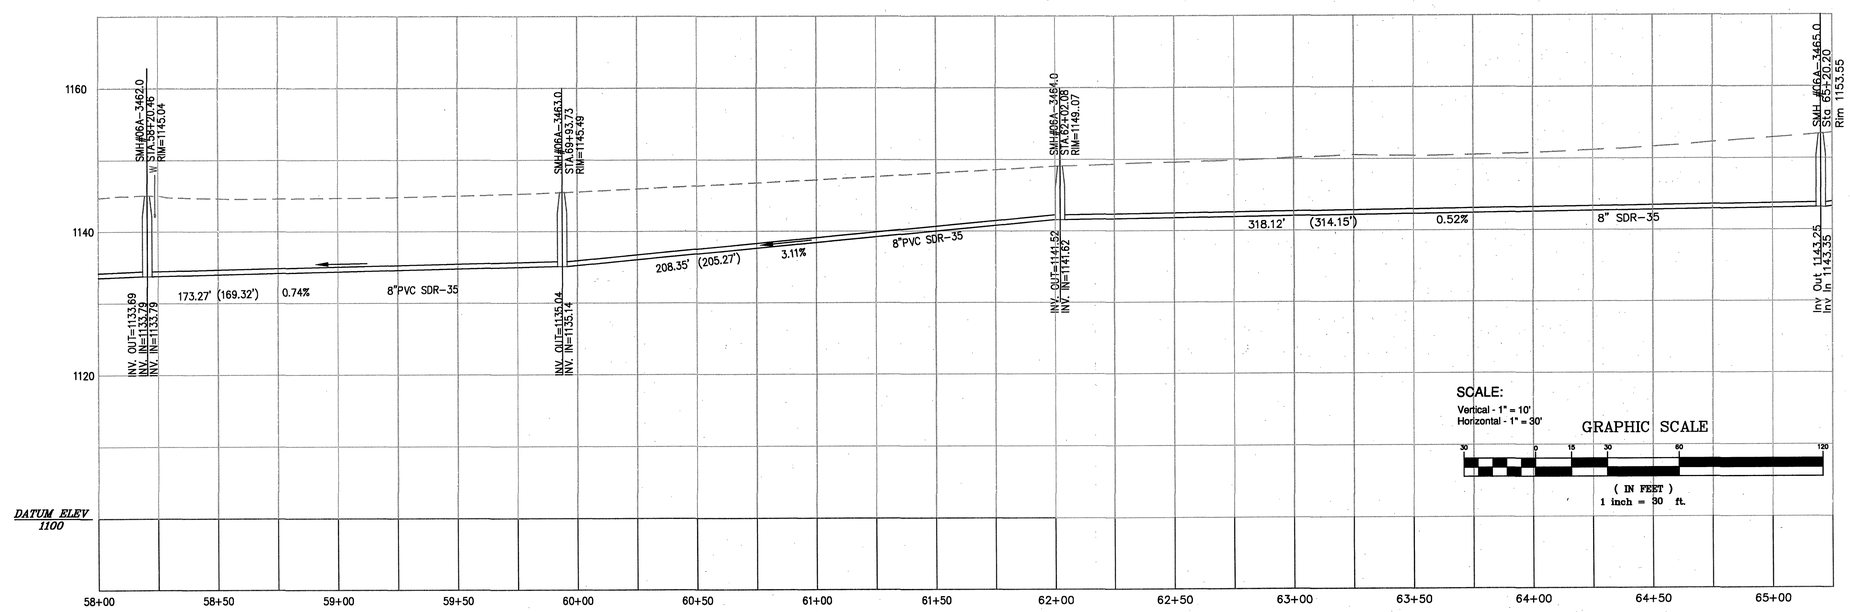

ASBUILT

WESTERN VIRGINIA WATER AUTHORITY
ENGINEERING SERVICES
601 S JEFFERSON ST, SUITE 300
ROANOKE, VA 24011
540-853-5700

COMMONWEALTH OF VIRGINIA
Cassandra Altice
No. 035867
PROFESSIONAL ENGINEER

ANDREW LEWIS PLACE SANITARY SEWER EXTENSION

CIVIL/SITEWORK PLAN

Rev	Description	Date	By

Designed: CDA
Drawn: CDA
Checked: CDA
Approved: JGR
Date: 02 MAR 2009
Project:

C11
Sheet 11 of 16