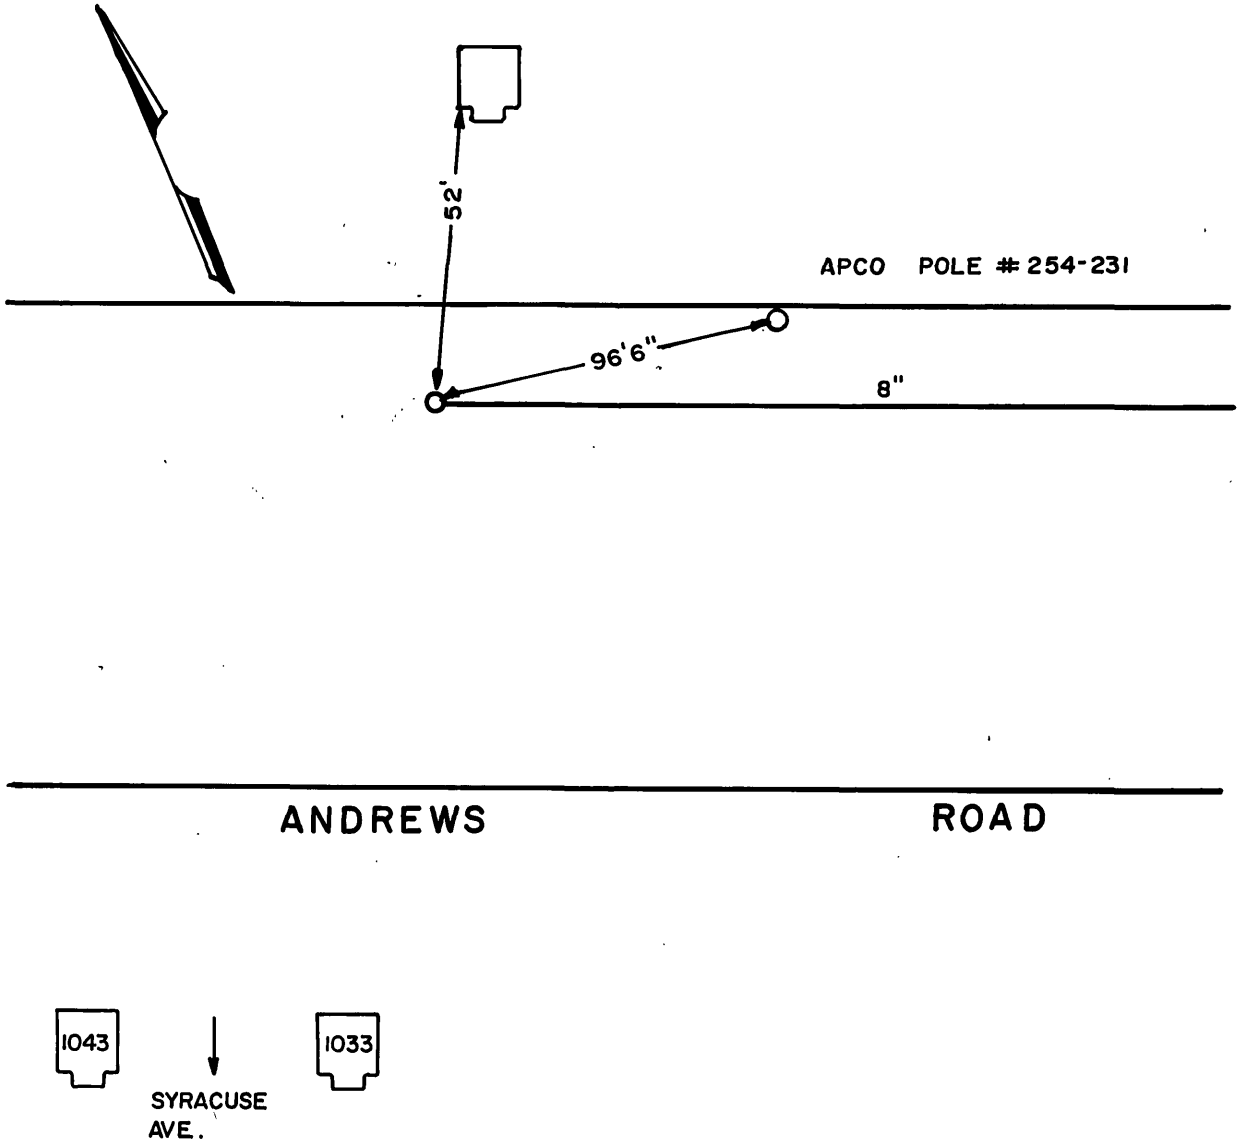


| DATE | NO. | SIZE | MAKE | OPEN | TURNS |
|---|---|---|---|---|---|
| 1990 | 1 | 2" | BLOWOFF | | |
| | | | | | |
| | | | | | |
CITY OF ROANOKE—WATER DEP'T

VALVE DIAGRAM

ANDREWS ROAD,

1000 BLOCK N.W.

SEC. MAP 213, 205, 223

DATE PAGE NO.