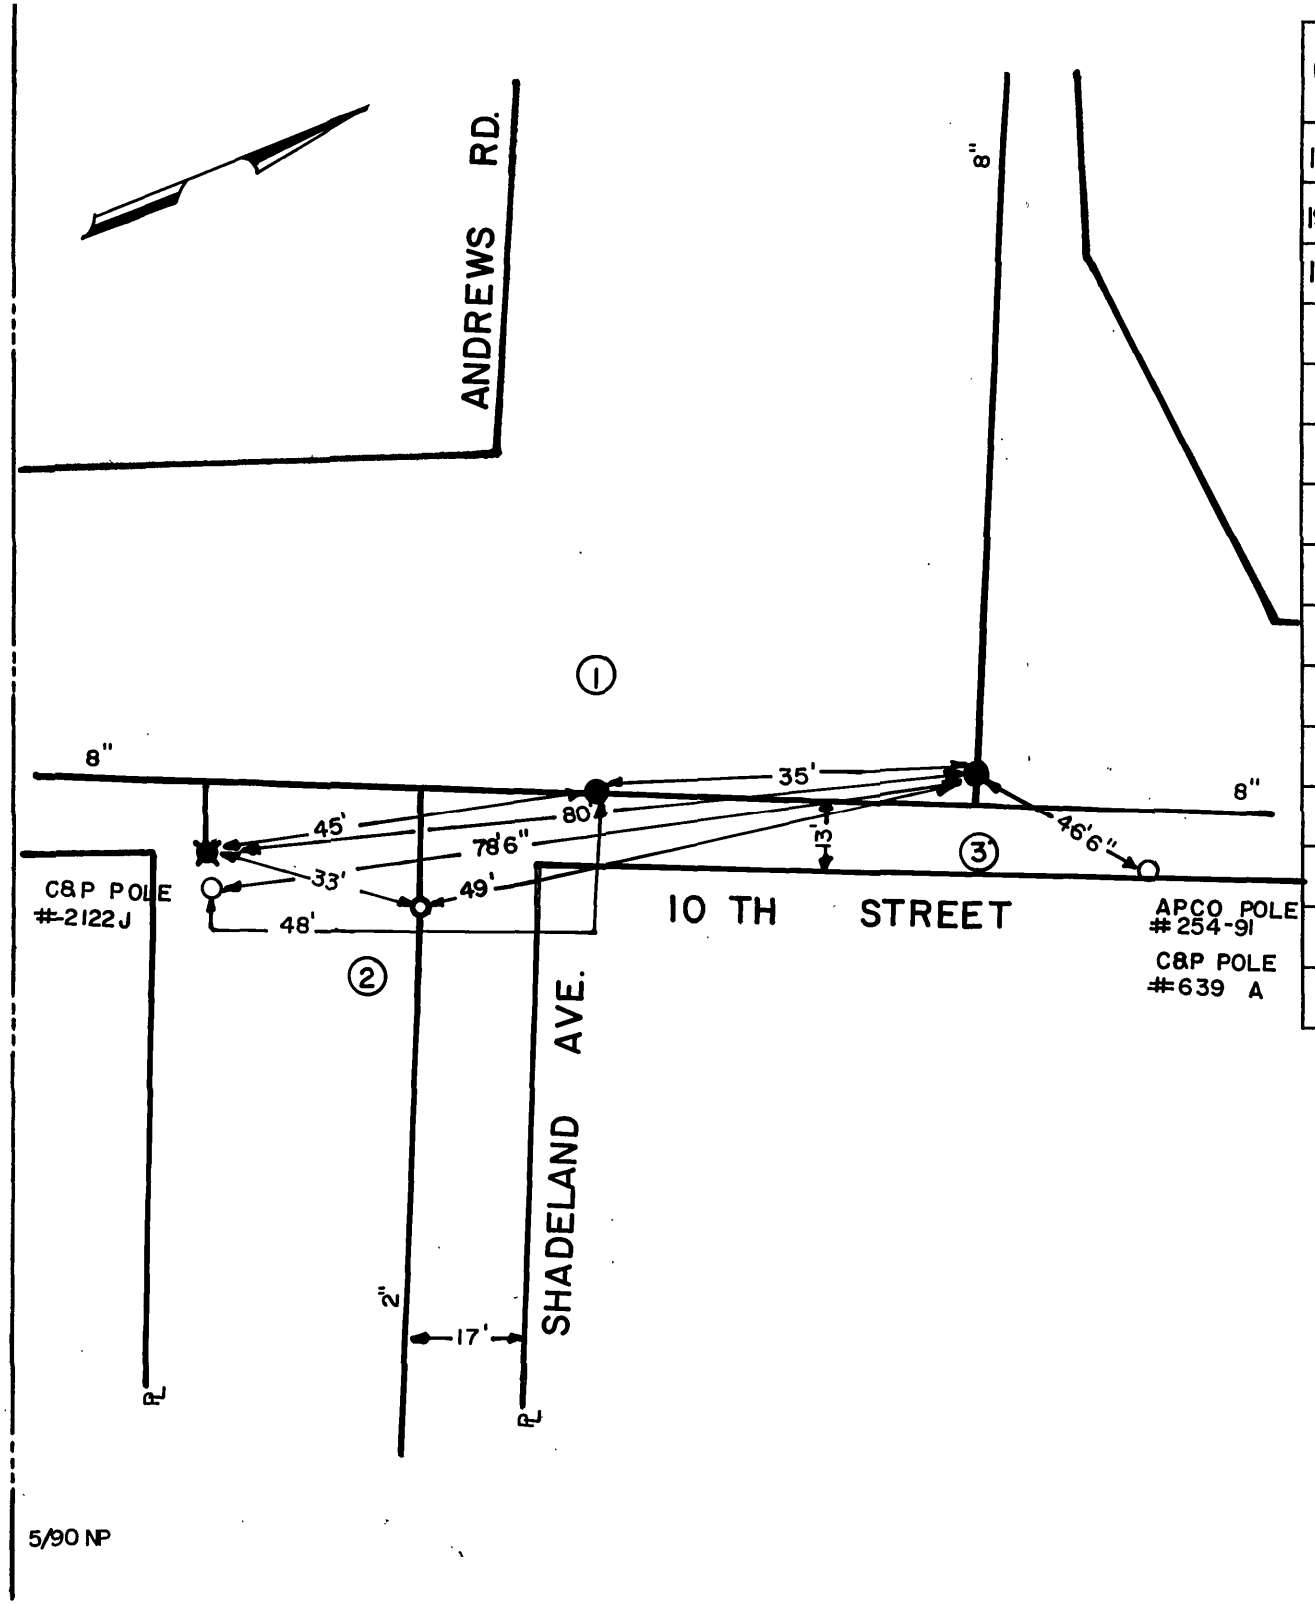

DATE	NO.	SIZE	MAKE	OPEN	TURNS
1940	1	8"		R	27
1940	2	2"		R	7
1990	3	8"			
	2	0	EPL		

CITY OF ROANOKE—WATER DEP'T

VALVE DIAGRAM

ANDREWS ROAD,

SHADELAND AVENUE, 8

10 TH STREET N.W.

SEC. MAP 205, 213, 223

DATE PAGE NO.