Comm. No. 17485

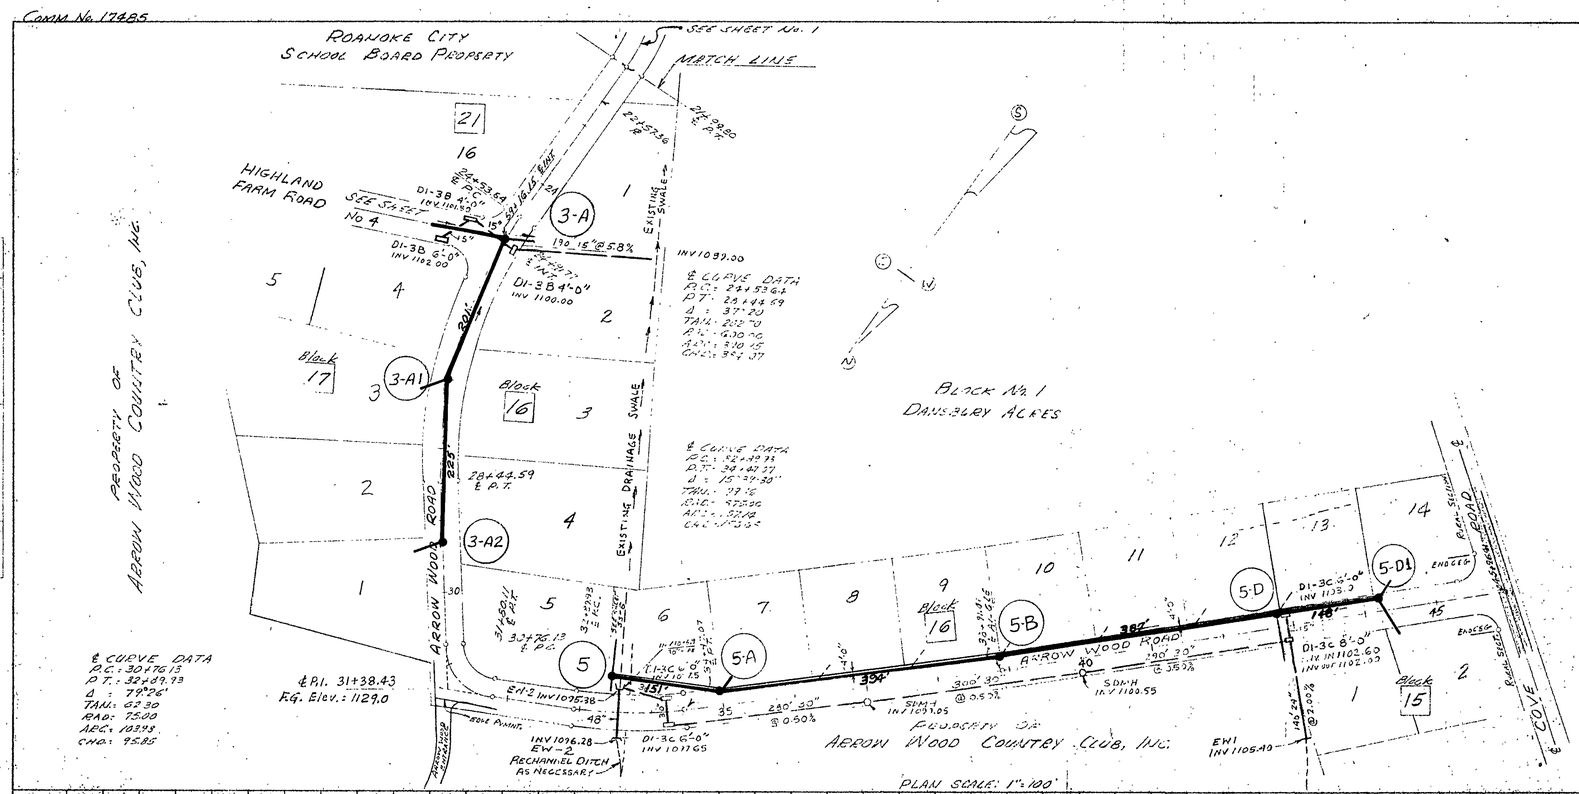

AS BUILT

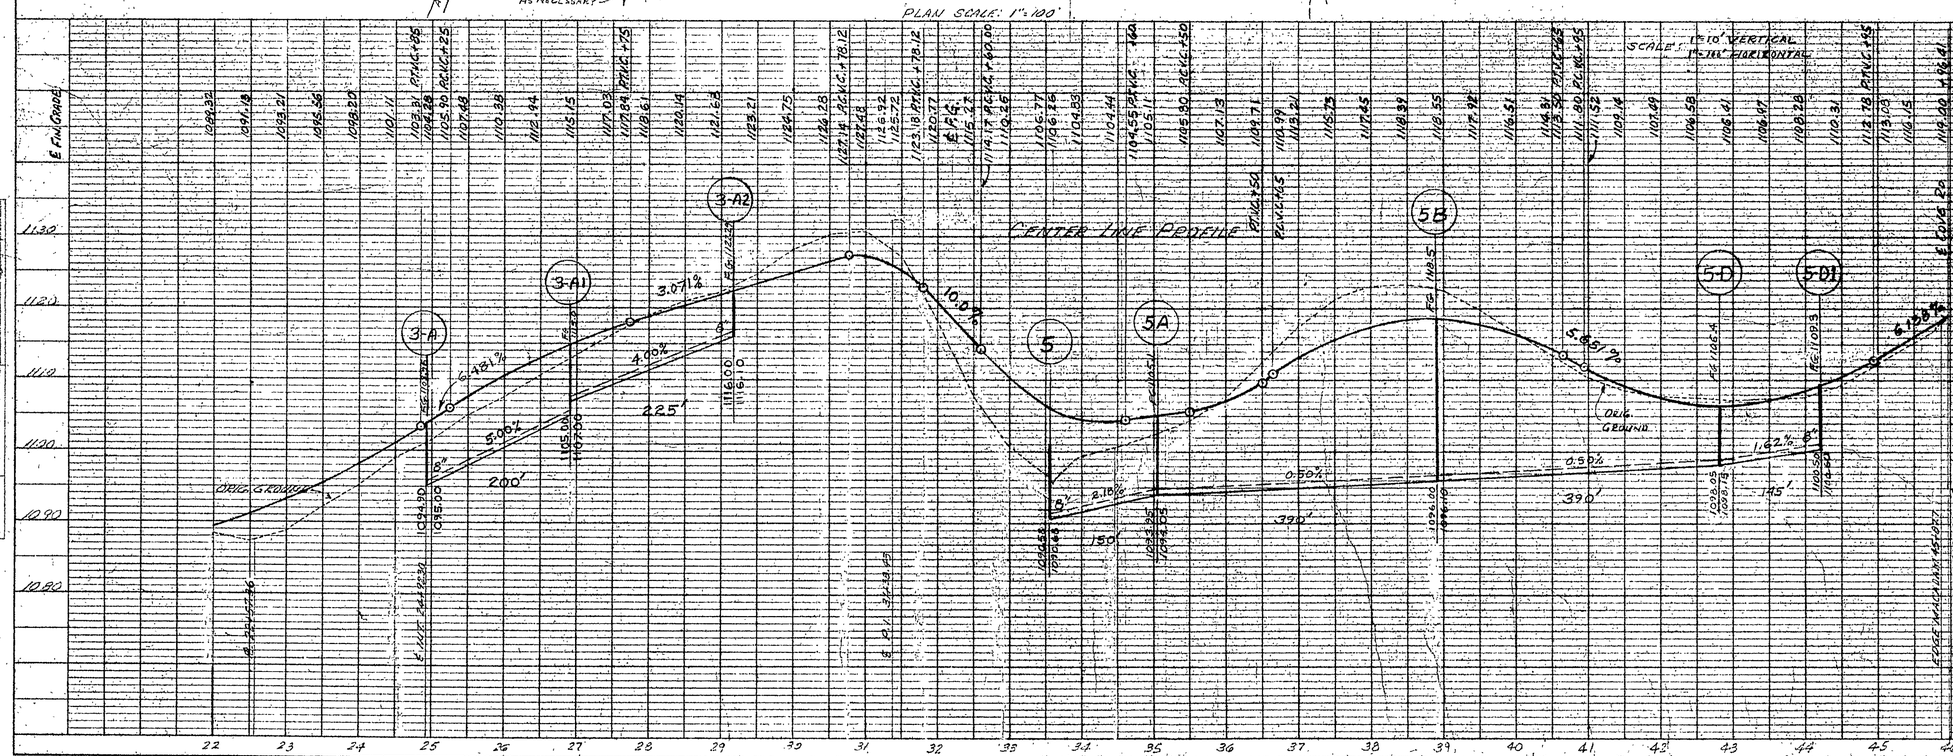

SHEET 2 OF SHEETS

PLAN AND PROFILE OF PROPOSED ROADS IN PROPERTY OF ARROW WOOD COUNTRY CLUB, INC.

By: C. B. Malcolm & Son
State Cert. Engrs.

ROANOKE COUNTY, VIRGINIA

DATE: JULY 15, 1966 SCALE: AS NOTED

REVISED AUG. 26, 1966
1. MH 5-D TO 5-D SHIFTED
2. SAN SEWER & S.D. MOVED FROM BACK OF BLOCK 16 INTO ARROW WOOD ROAD
3. SHEET 3 DELETED
4. INVERTS OF DROP INLETS IN HIGHLAND FARM ROAD RAISED
5. SUPERELEVATION STA 32+50 TO STA 33+50 DELETED
6. 42" PIPE CHANGED TO 48" PIPE WITH E.H. STA 33+52

PLATE 1 — PLAN PROFILE
B.K. ELLIOTT company
No. 481 ELLCO-VEL TRACING PAPER

Sheet 2

#5153