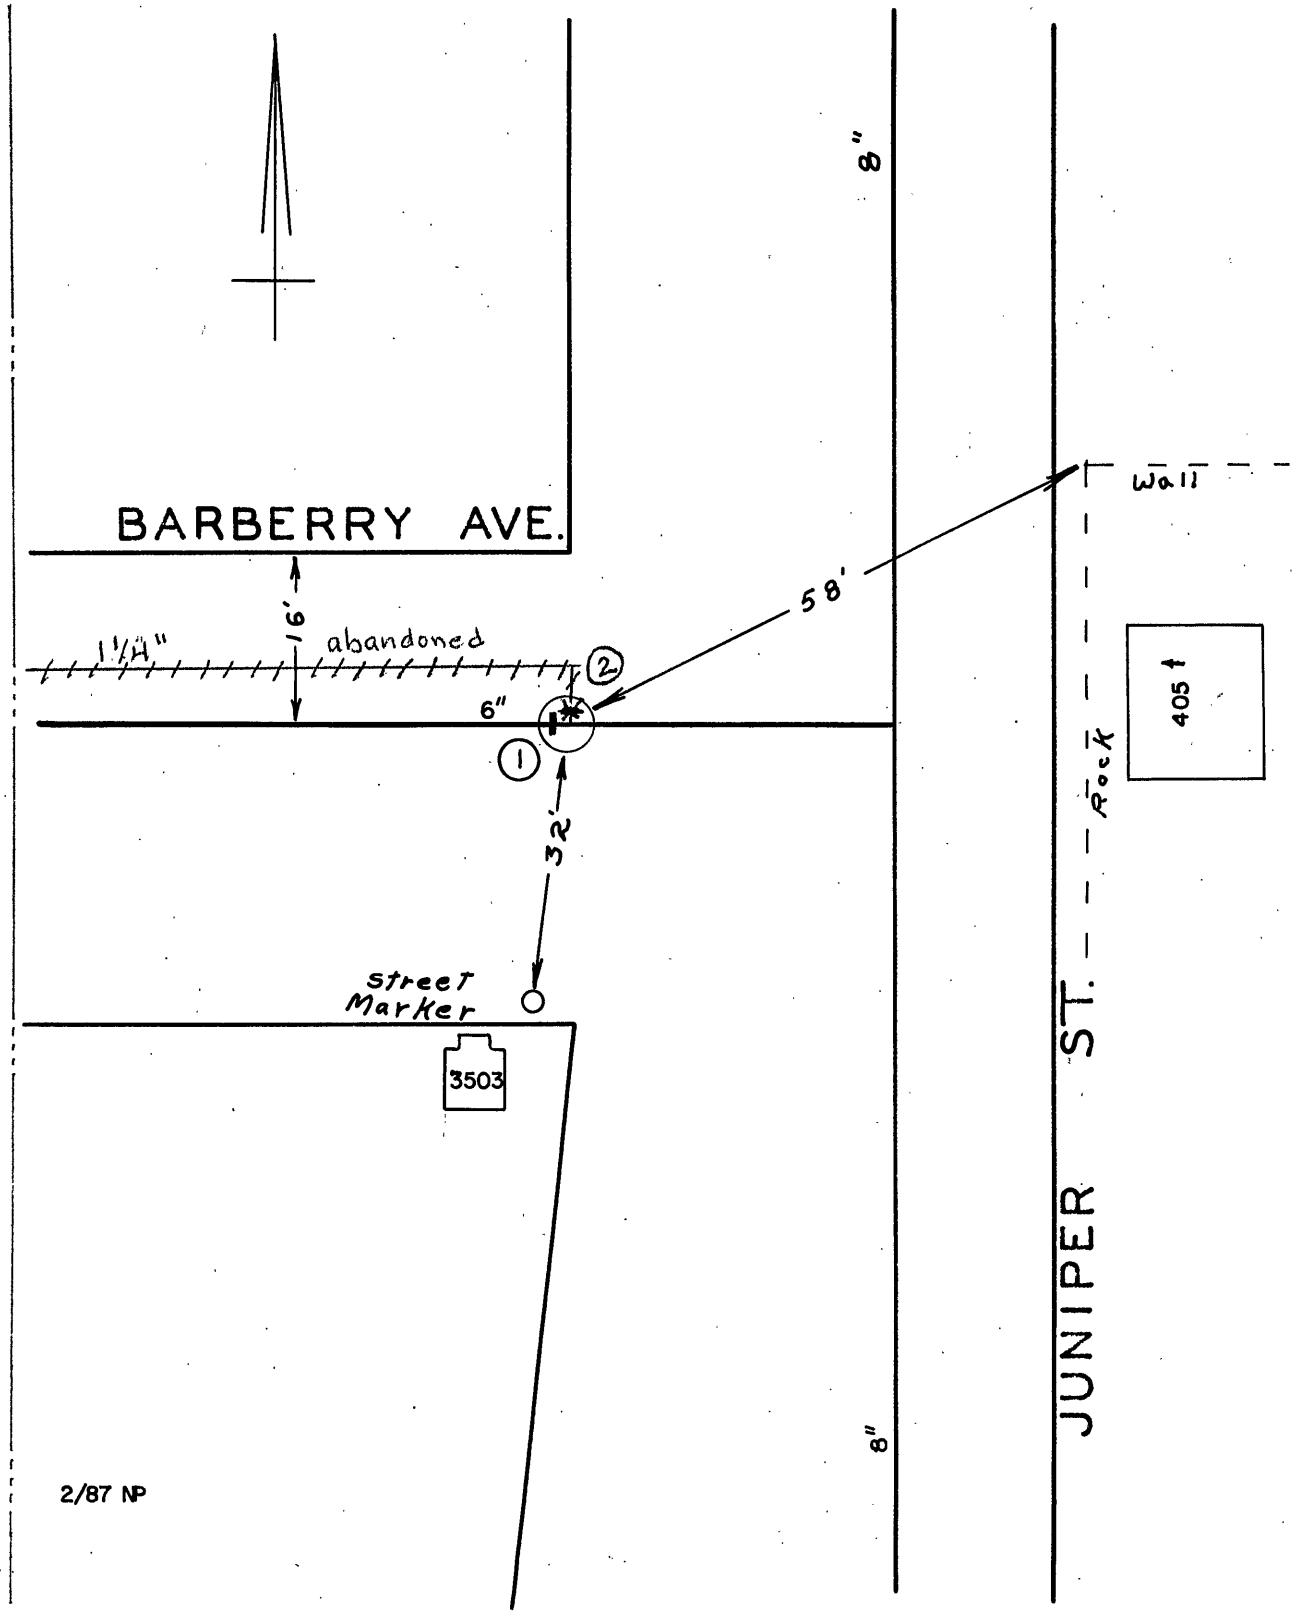

DATE	NO.	SIZE	MAKE	OPEN	TURNS
1953	1	6"	MUELLER	R	20
~~'62~~	~~2~~	~~2"~~	~~DAR.~~	~~R~~	~~7½~~
	1	0	WPL		

CITY OF ROANOKE—WATER DEPT.

VALVE DIAGRAM

BAR BERRY AVE. & JUNIPER STREET N. W.

SEC. MAP 263

DATE PAGE NO.

"IMPERIAL" TRACING CLOTH. K & E CO., N. Y.