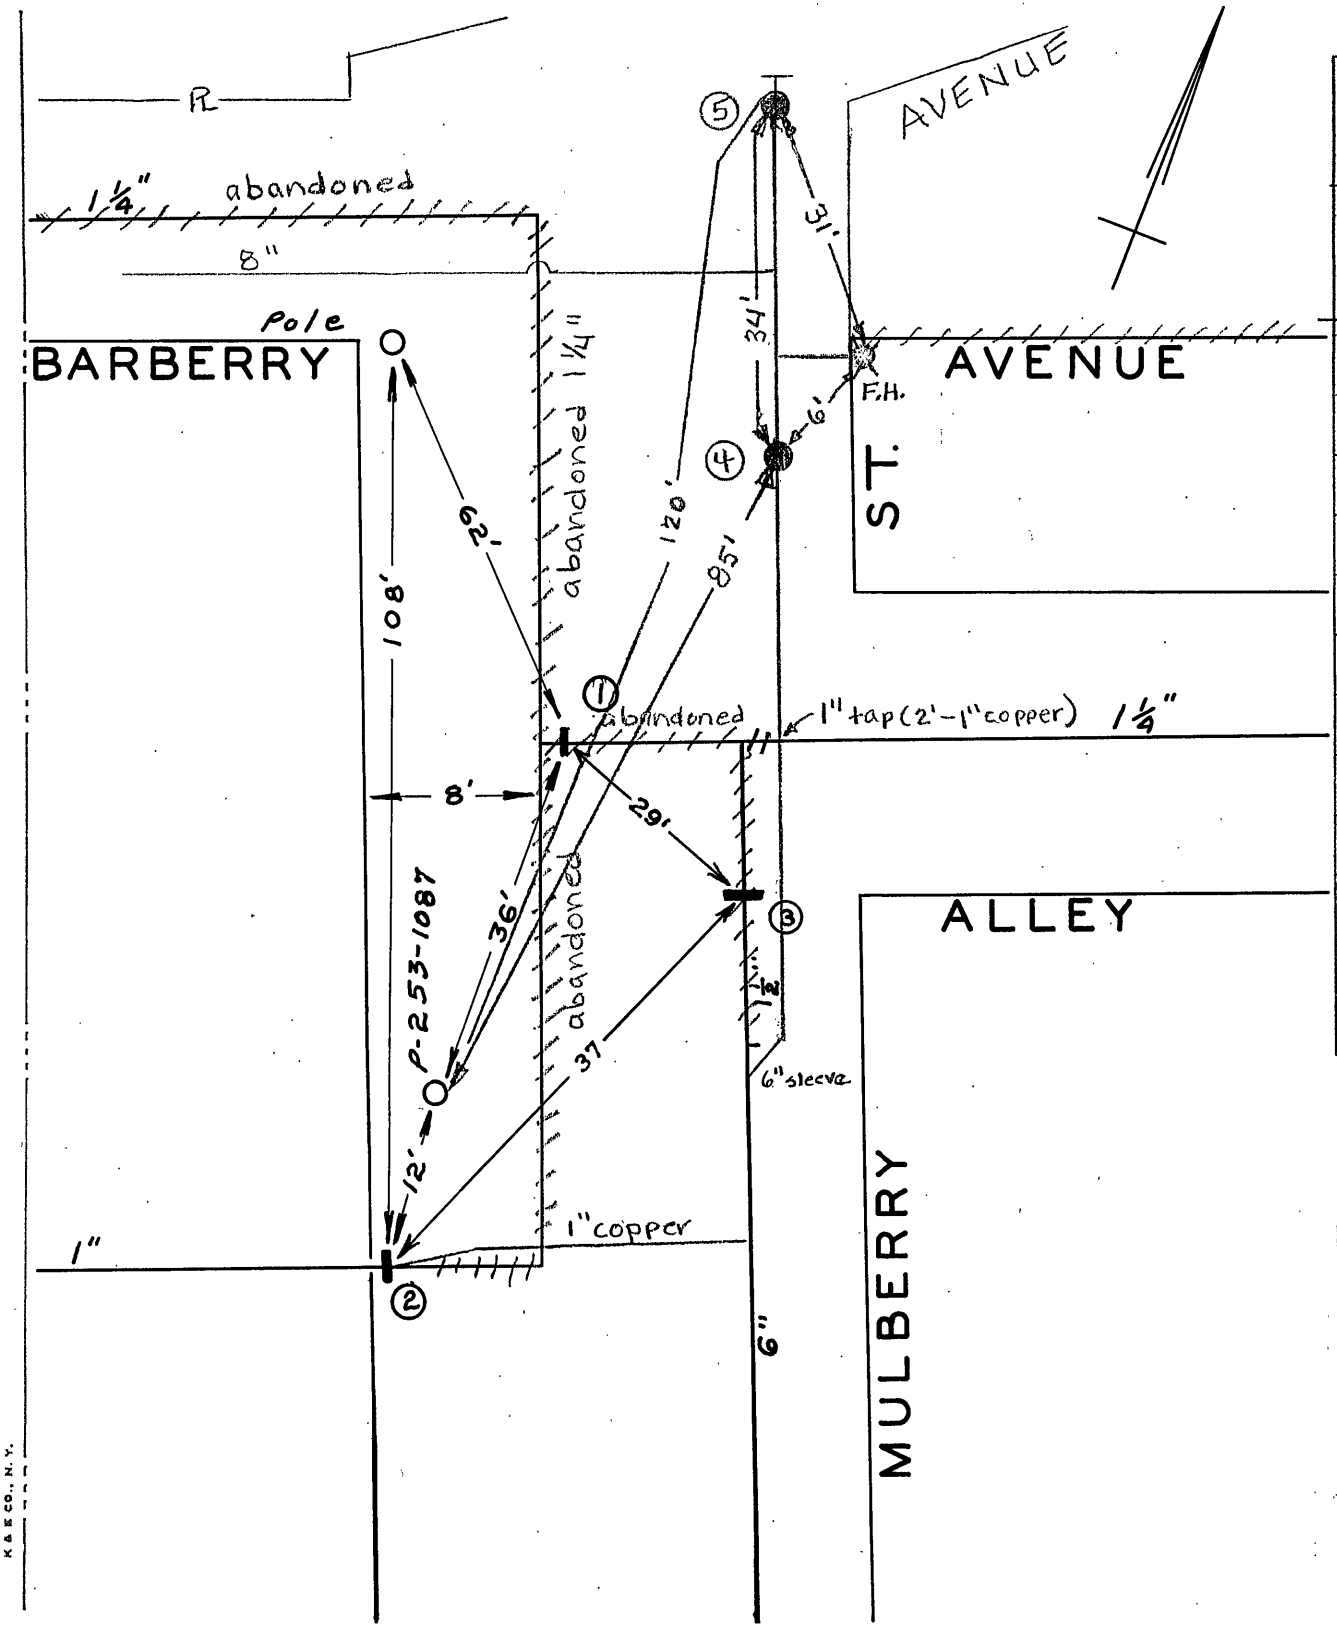

DATE	NO.	SIZE	MAKE	OPEN	TURNS
~~1959~~	~~1~~	~~1¼"~~		~~L~~	
1959	2	1"		L	
~~8-63~~	~~3~~	~~1½"~~	~~MISC.~~	~~L~~	
2001	4	6"	AVK	R	21
2001	5	6"	AVK	R	21

CITY OF ROANOKE — WATER DEPT.

VALVE DIAGRAM

~~MULBERRY ST. S. OF~~

BARBERRY AVE. N. W.

MULBERRY ST., N.W

SEC. MAP 263, 272

DATE PAGE NO.

"IMPERIAL" TRACING CLOTH. K & E CO., N. Y.