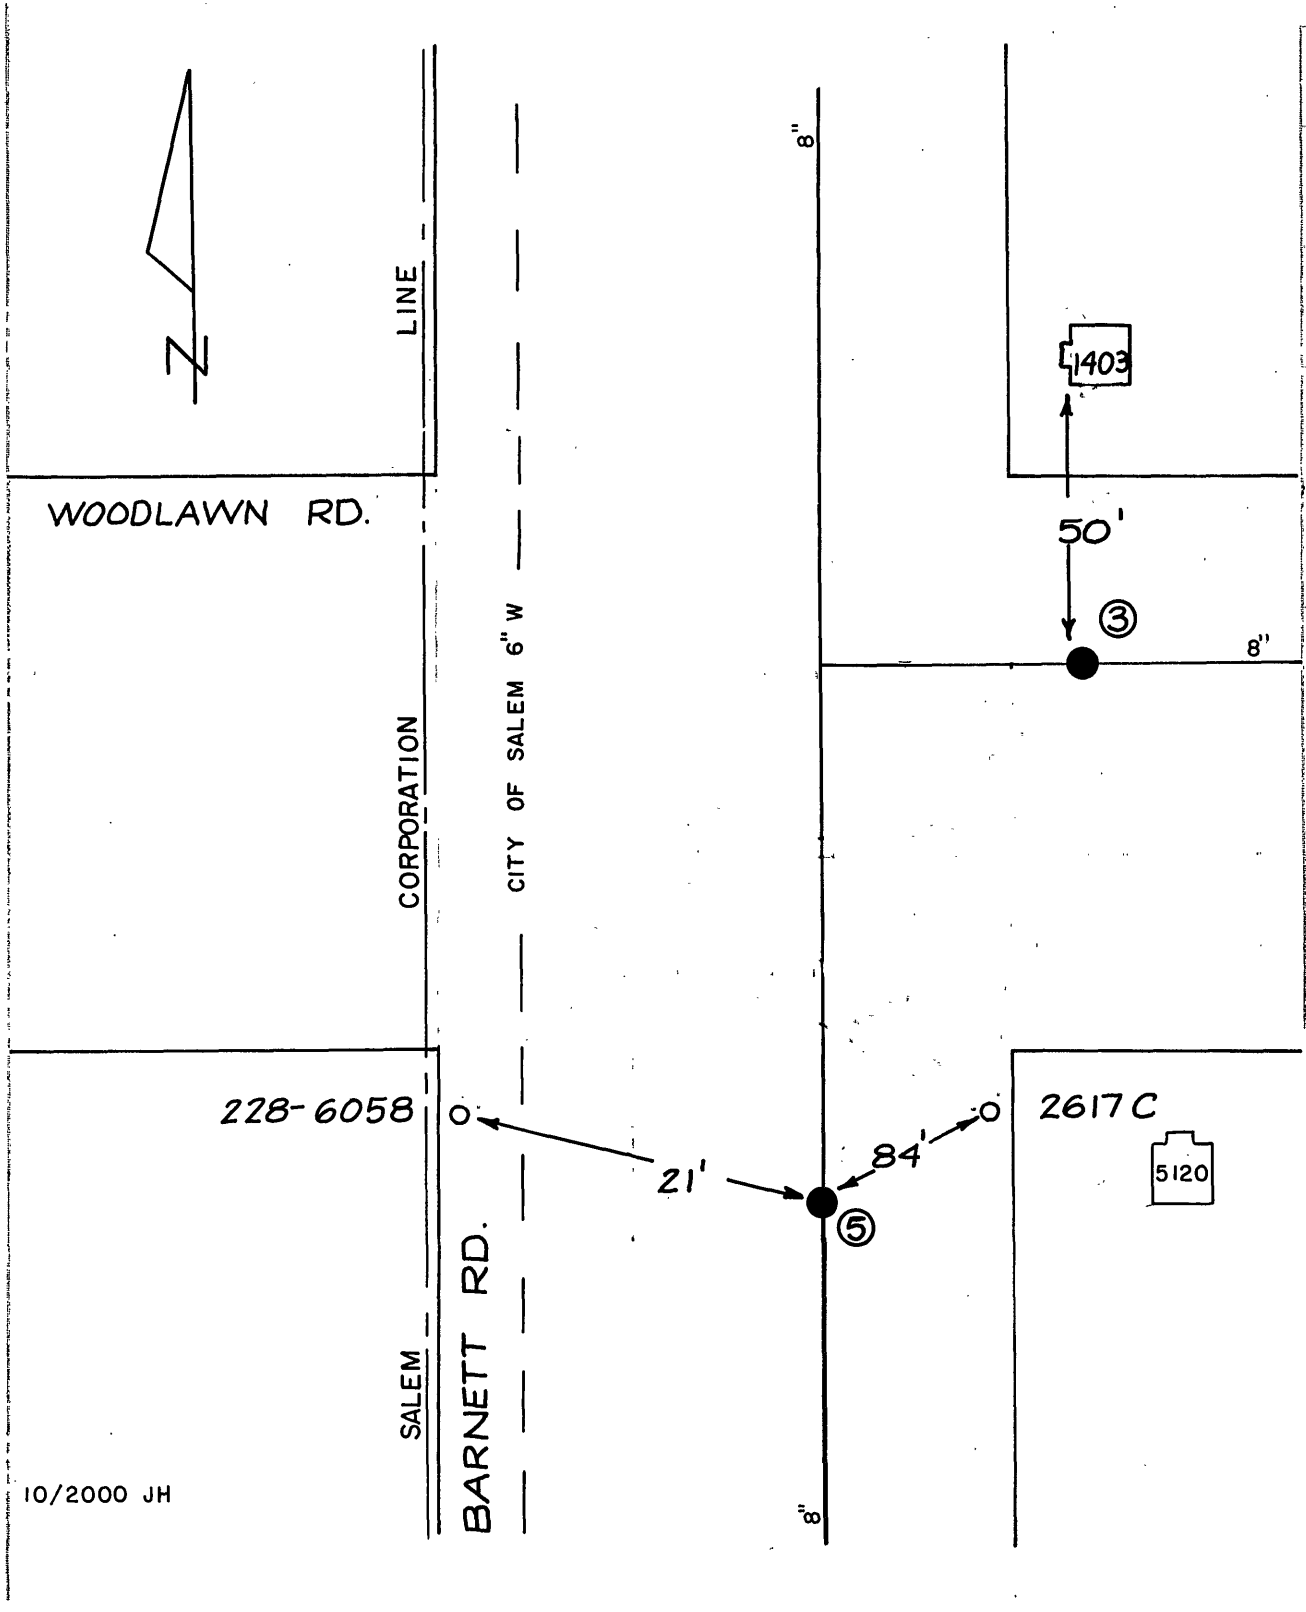

DATE	NO.	SIZE	MAKE	OPEN	TURNS
10-77	3	8"	MUELLER	R	
10-77	5	8"	MUELLER	R	

CITY OF ROANOKE—WATER DEP'T
VALVE DIAGRAM
BARNETT RD. &
WOODLAWN RD.

SEC. MAP 611 N.W.
DATE PAGE NO.

10/2000 JH