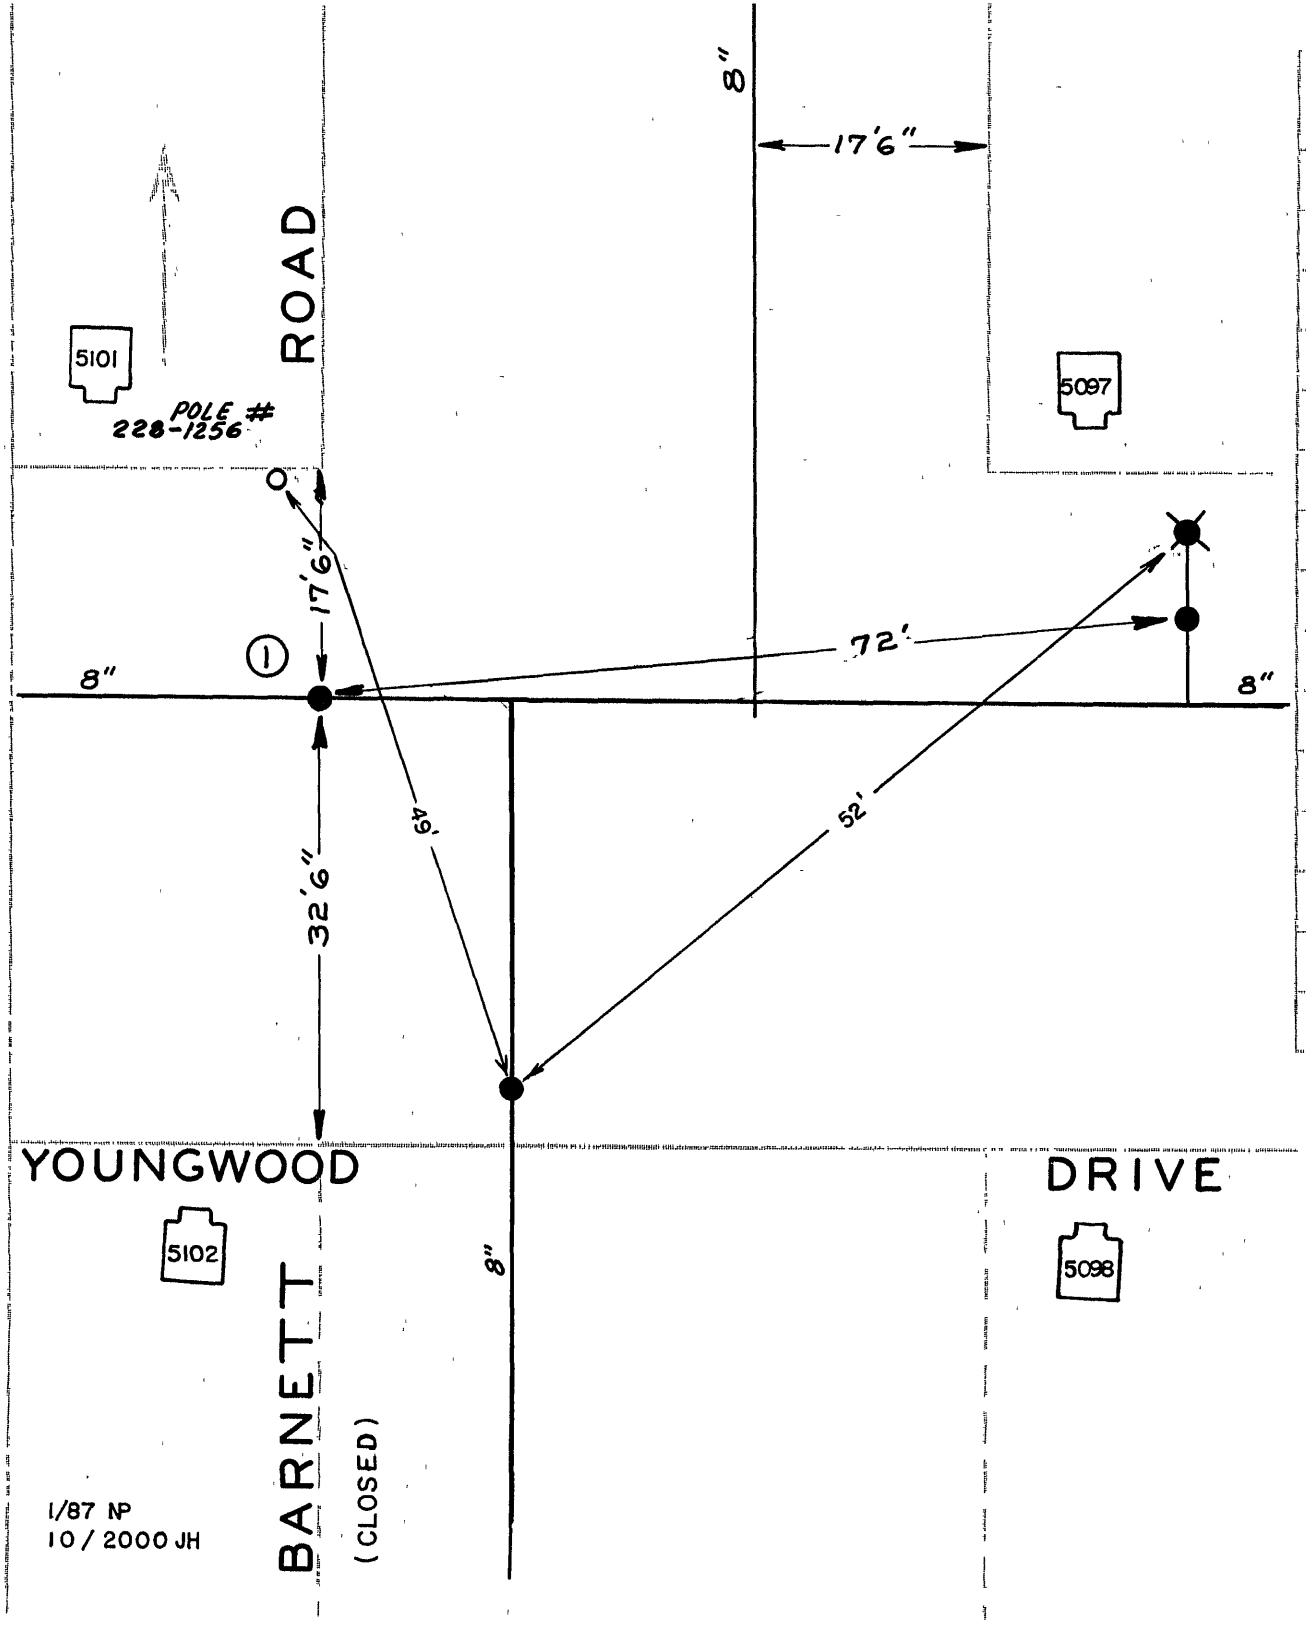

DATE	NO	SIZE	MAKE	OPEN	TURNS
'58	1	8"	DARLING	R	27
77	2	8"	MUELLER	R	
	1	0	WPL		

CITY OF ROANOKE - WATER DEPT

VALVE DIAGRAM

BARNETT RD. &

YOUNGWOOD DR.

SEQ. MAP 613 N.W.

DATE PAGE NO