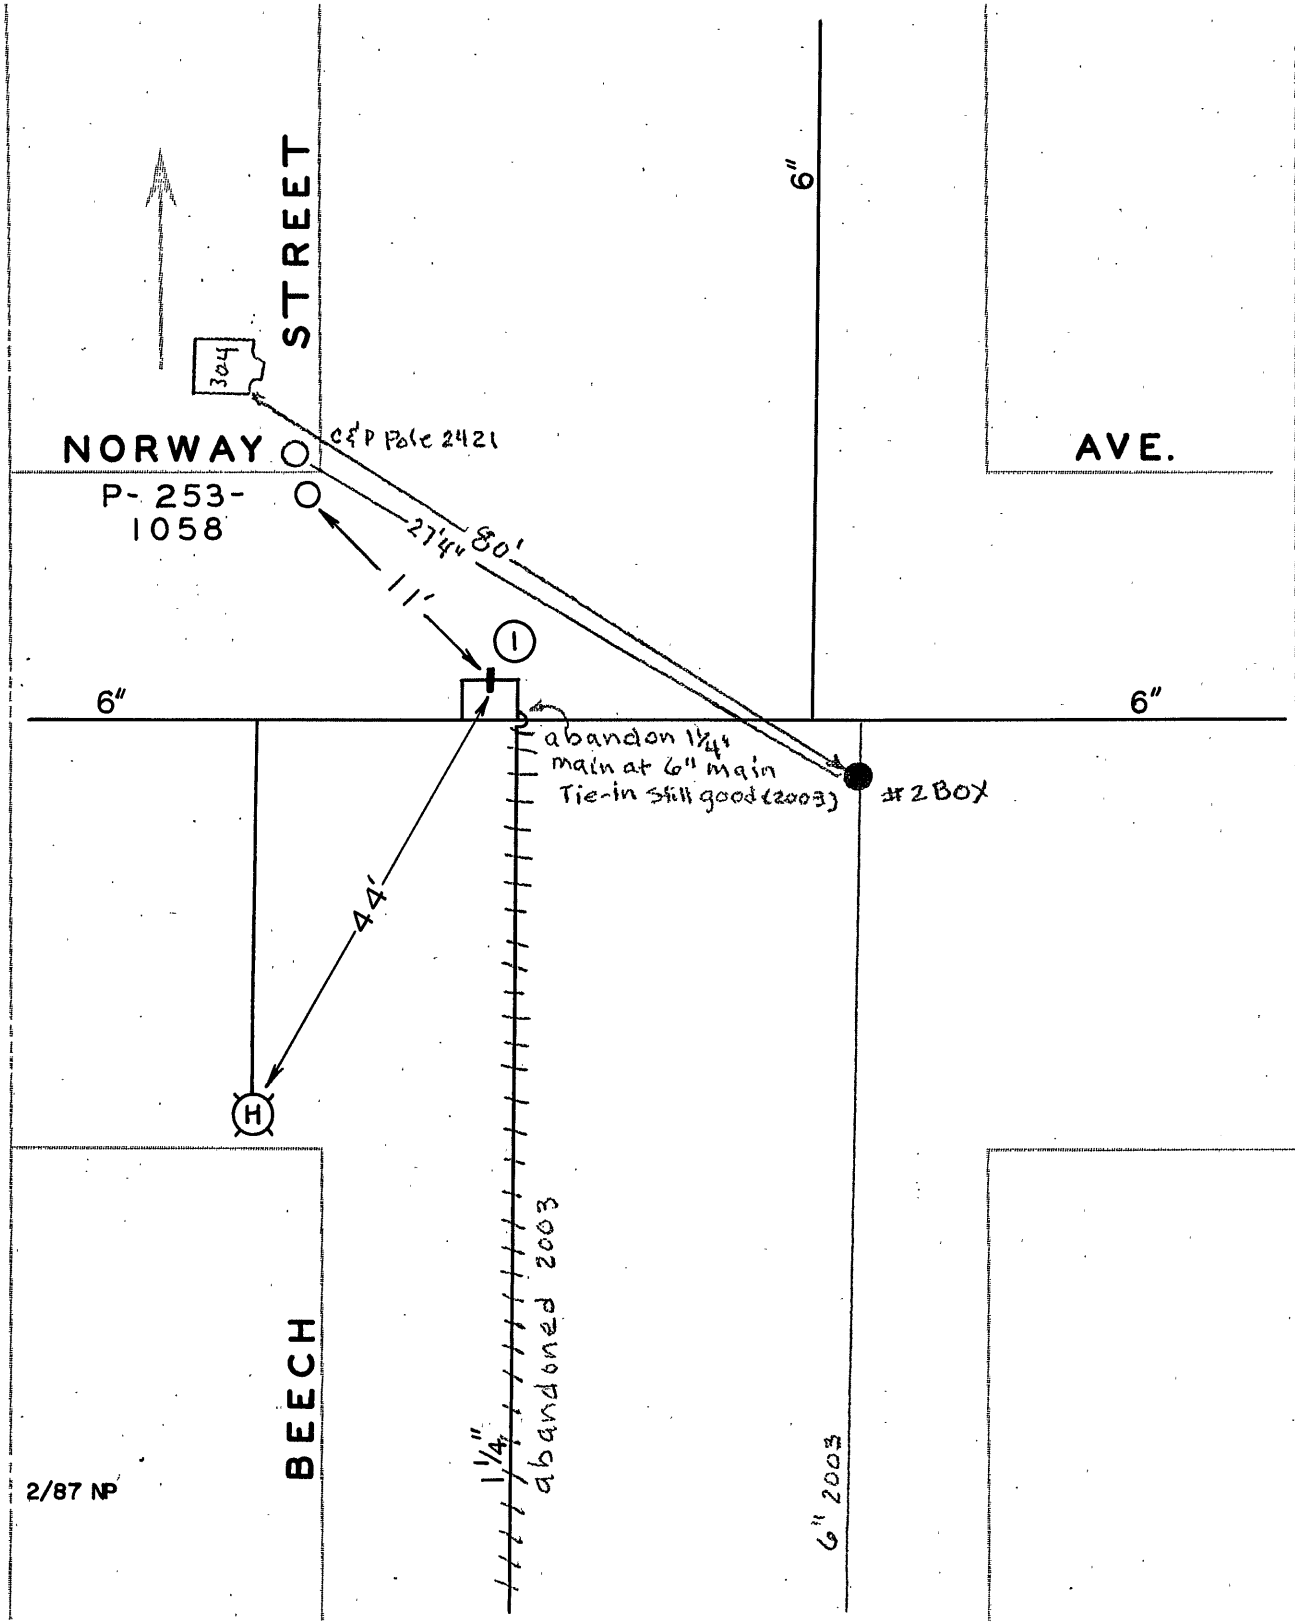

AVE.

DATE	NO.	SIZE	MAKE	OPEN	TURNS
'57	1	2"		L	
10/28 2003	2	6"	A.F	R	21
	1	10-S	NPL		

CITY OF ROANOKE—WATER DEPT

VALVE DIAGRAM

BEECH STREET &

NORWAY AVE. N.W.

SEC. MAP 263

DATE PAGE NO