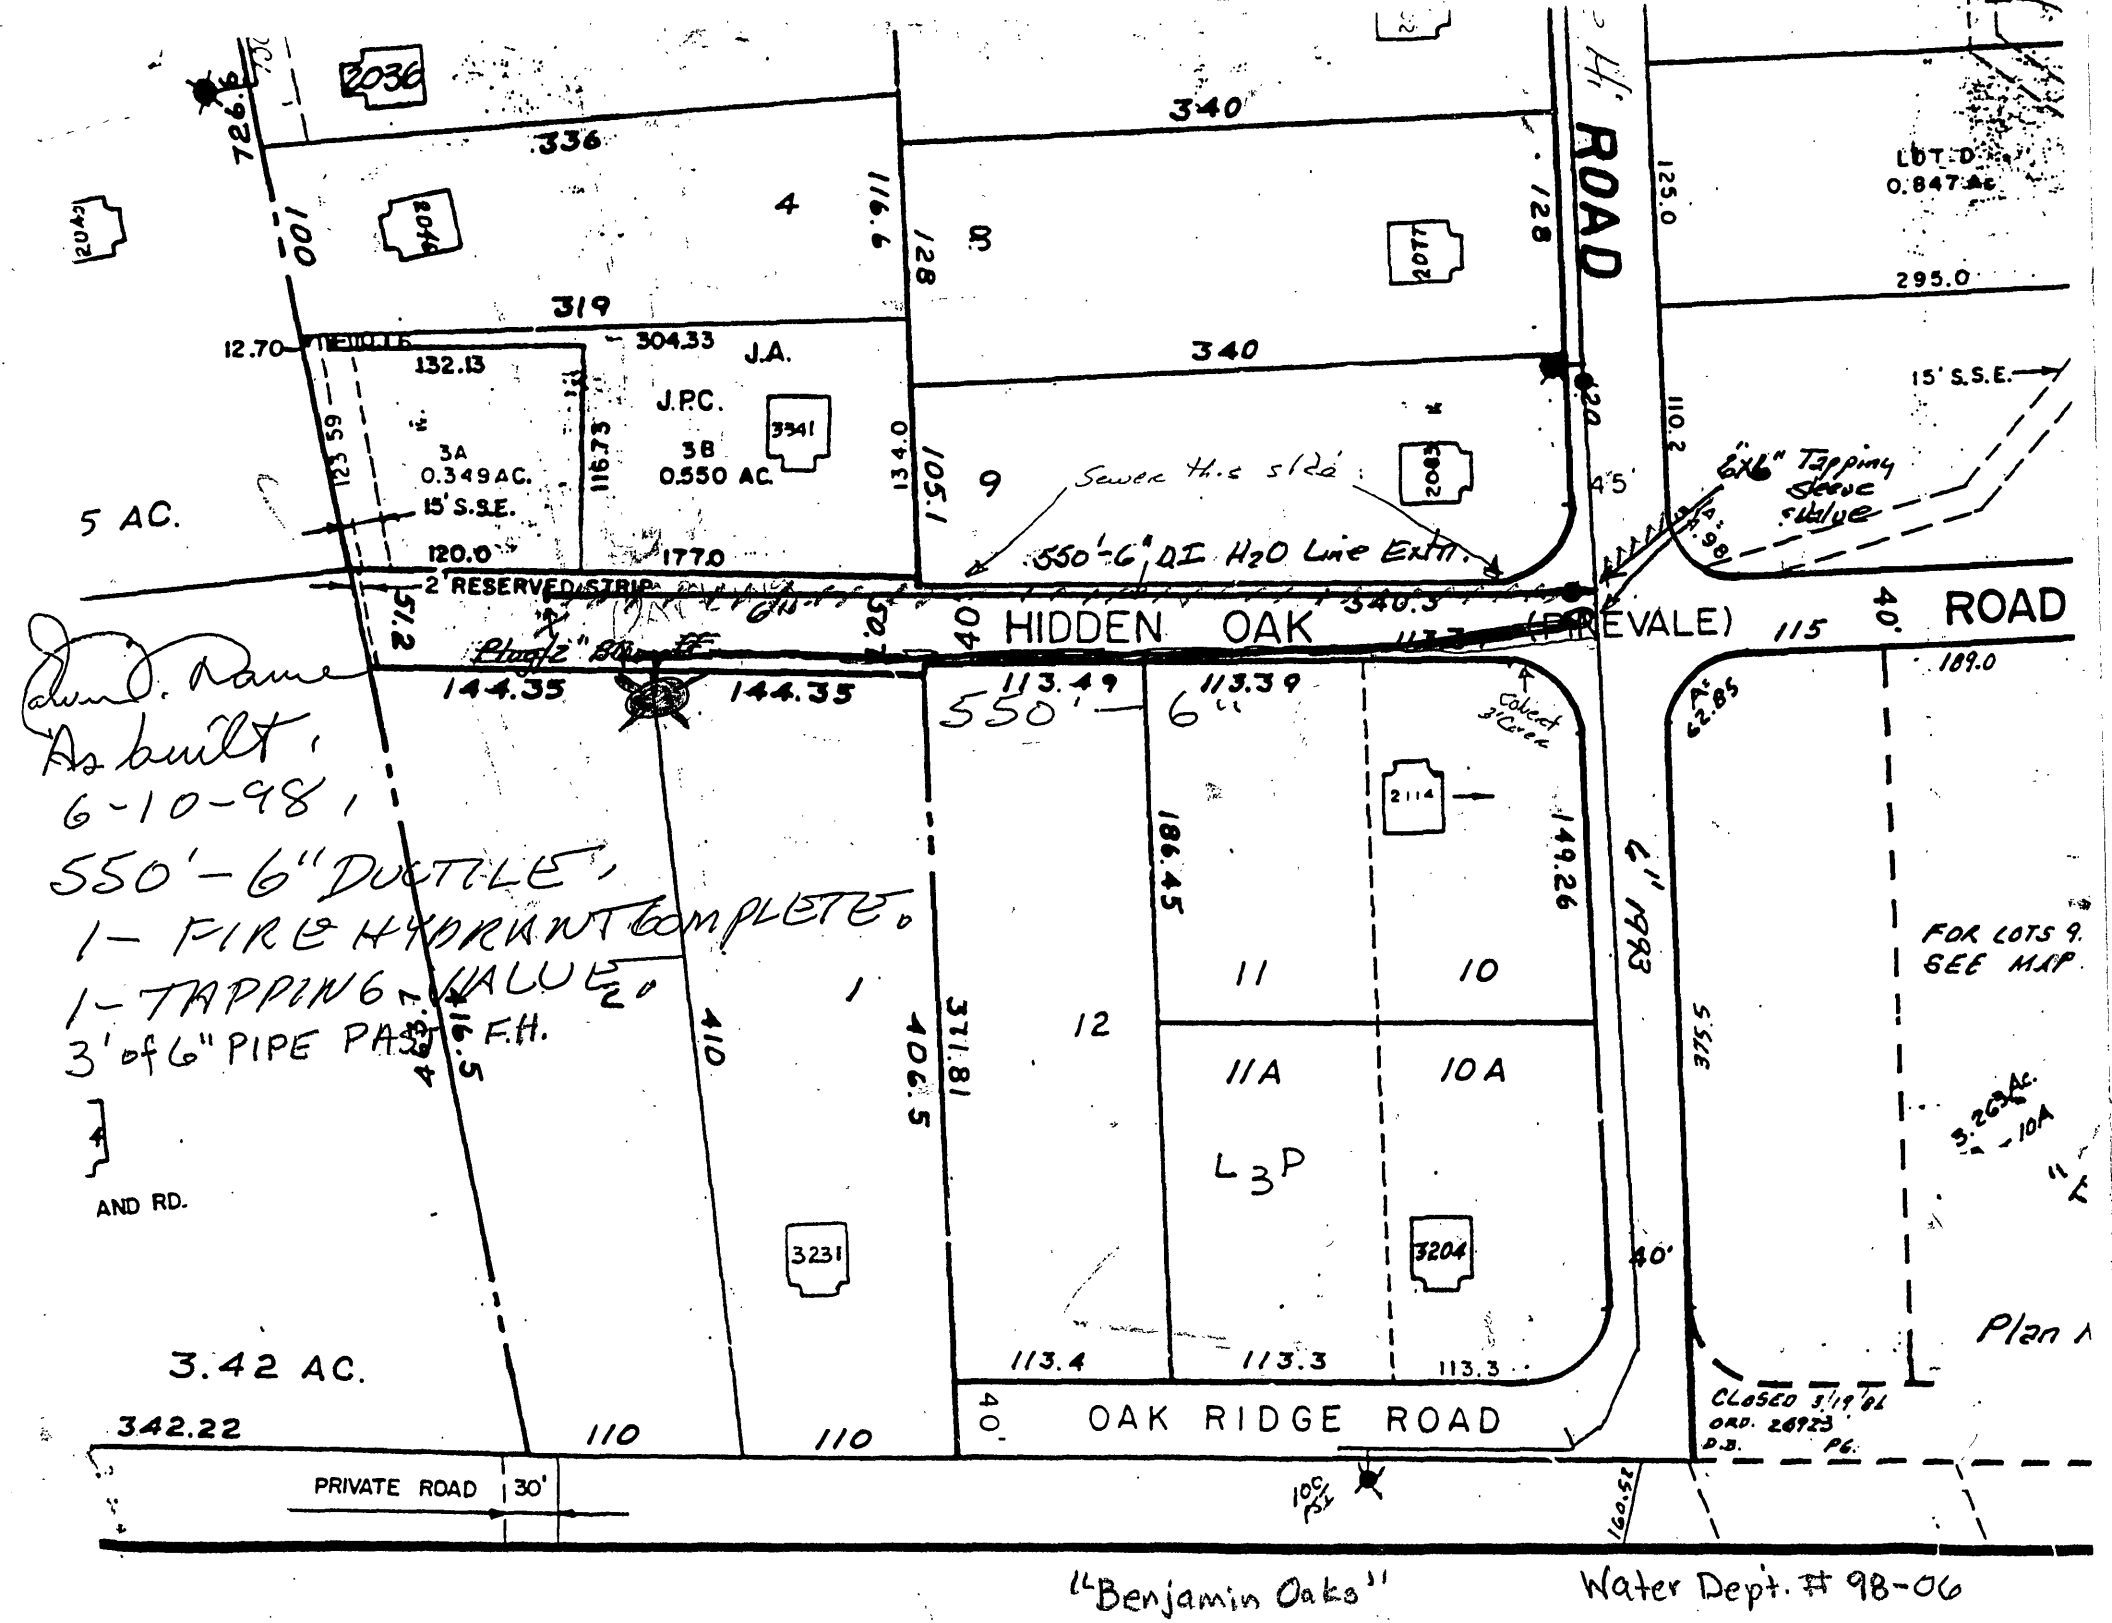
ROAD
HIDDEN OAK (PREVALE) ROAD
OAK RIDGE ROAD
PRIVATE ROAD 30'
2 RESERVED STRIP
5 AC.
3.42 AC.
J.A.
J.P.C.
3A 0.349 AC.
3B 0.550 AC.
15' S.S.E.
Sewer this side
550'-6" D.I. H2O Line Extn.
6x6" Tapping Sleeve & Valve
Collect 3" Creek
LOT D 0.847 AC
FOR LOTS 9. SEE MAP.
CLOSED 3/19/86 ORD. 26923 D.B. PG.
Plan A
AND RD.
550'-6" DUCTILE,
1- FIRE HYDRANT COMPLETE.
1- TAPPING VALVE.
3' of 6" PIPE PAST F.H.
As built,
6-10-98,
"Benjamin Oaks"
Water Dept. # 98-06