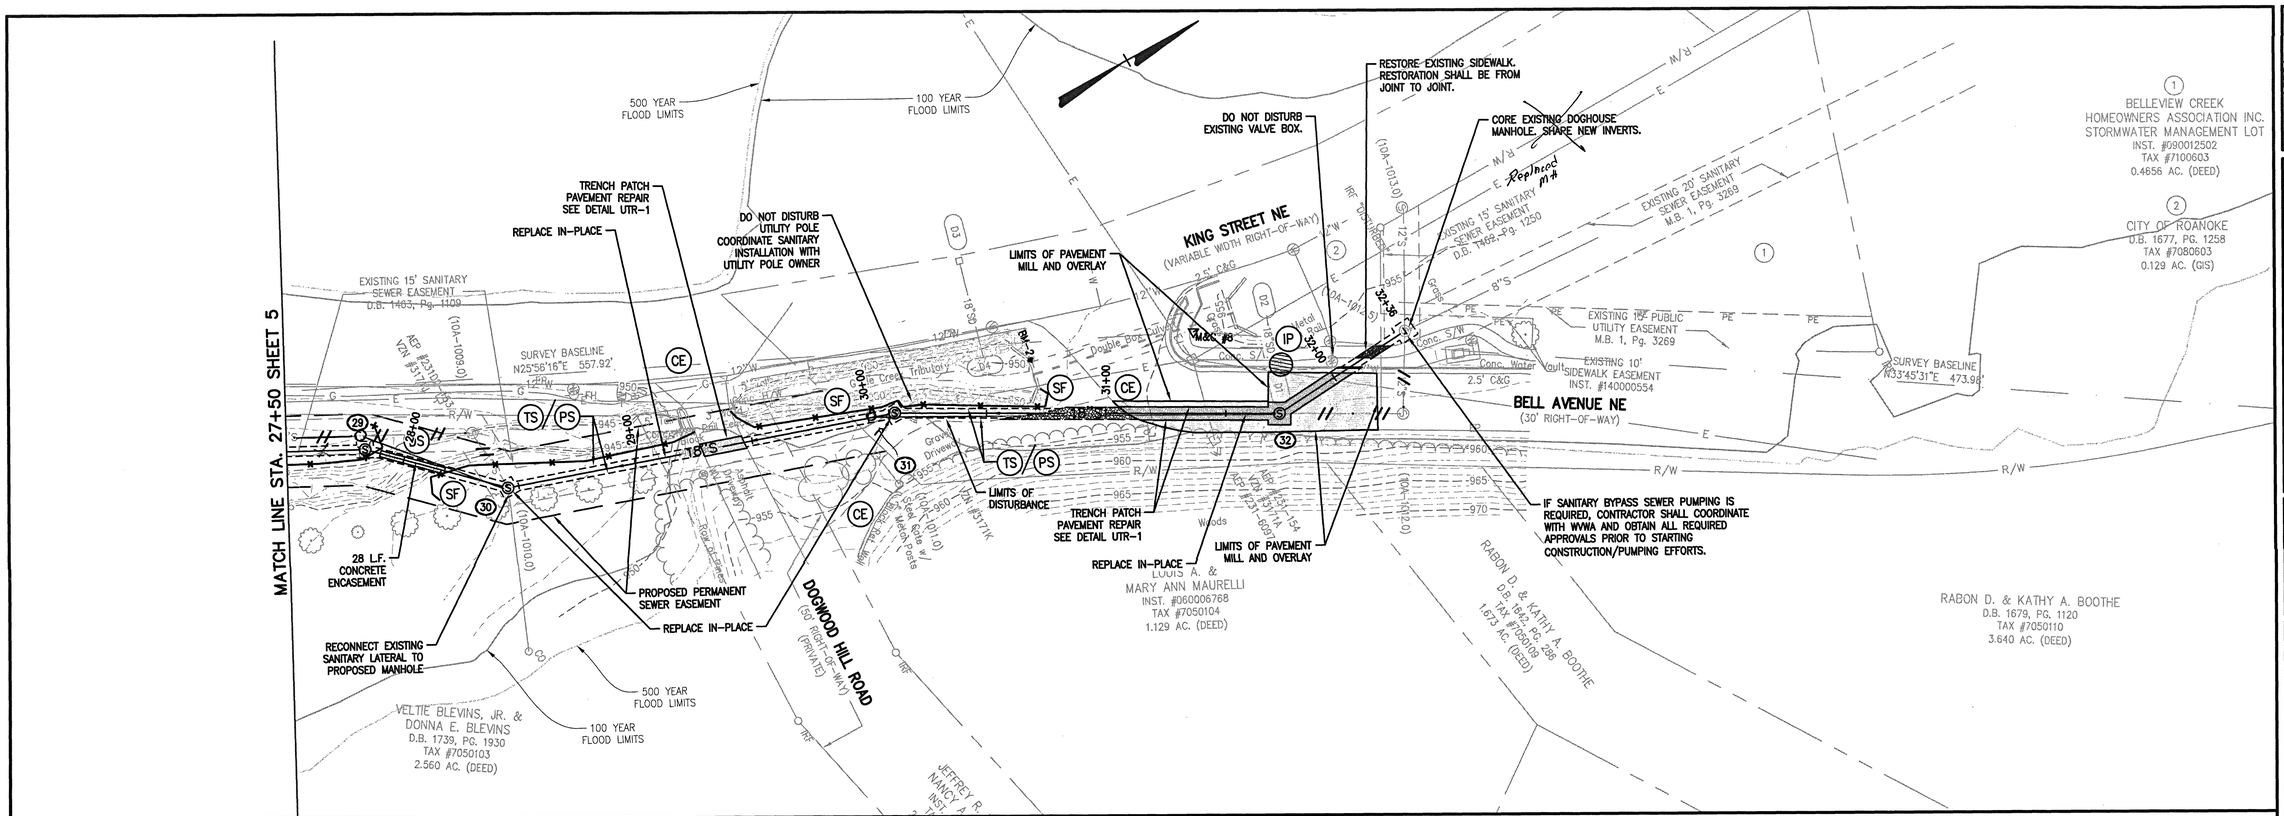

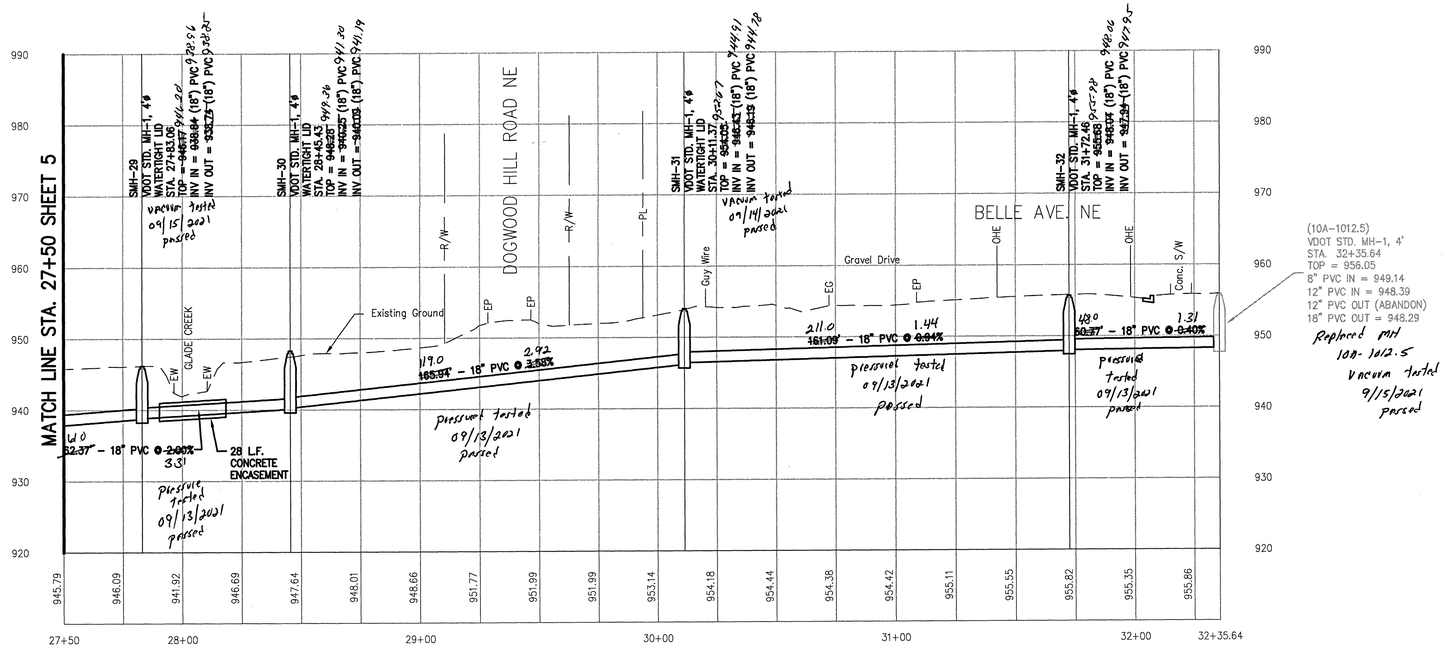

0 15' 30' 60'
SCALE: 1" = 30'

COMMONWEALTH OF VIRGINIA
BRADLEY C. CRAIG
Lic. No. 023879
PROFESSIONAL ENGINEER
4/5/21

Revisions	Date

Issue Date: APR. 5, 2021
Drawn By: RPK/MLC
Designed By: RPK
Checked By: BCC
Date: 4/5/21

Mattern & Craig
ENGINEERS•SURVEYORS
701 FIRST STREET, S.W.
ROANOKE, VIRGINIA 24016
(540) 345-9342
FAX (540) 345-7691

BERKLEY ROAD SANITARY SEWER REPLACEMENT
PLAN AND PROFILE – 18" SANITARY SEWER
ROANOKE, VIRGINIA

Vertical Scale: 1"=10'
Horizontal Scale: 1"=30'
Commission Number: 3941
Sheet No.: 6