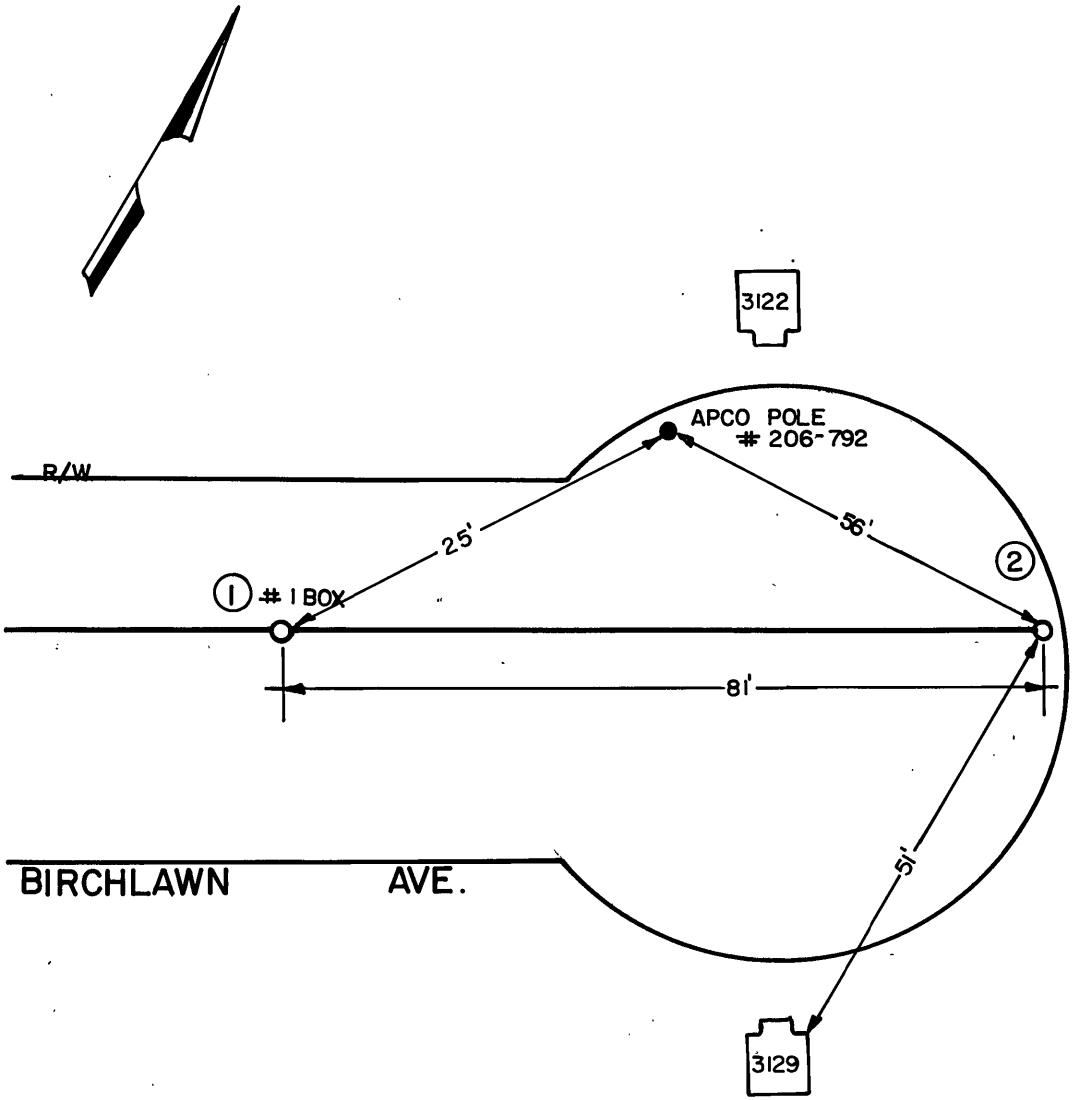

DATE	NO.	SIZE	MAKE	OPEN	TURNS
9-89	1	2"			
9-89	2	2"	BLOW OFF		

CITY OF ROANOKE—WATER DEP'T

VALVE DIAGRAM

BIRCHLAWN AVENUE

3100 BLOCK

N.W.

SEC. MAP 217

DATE PAGE NO.

10/90 NP