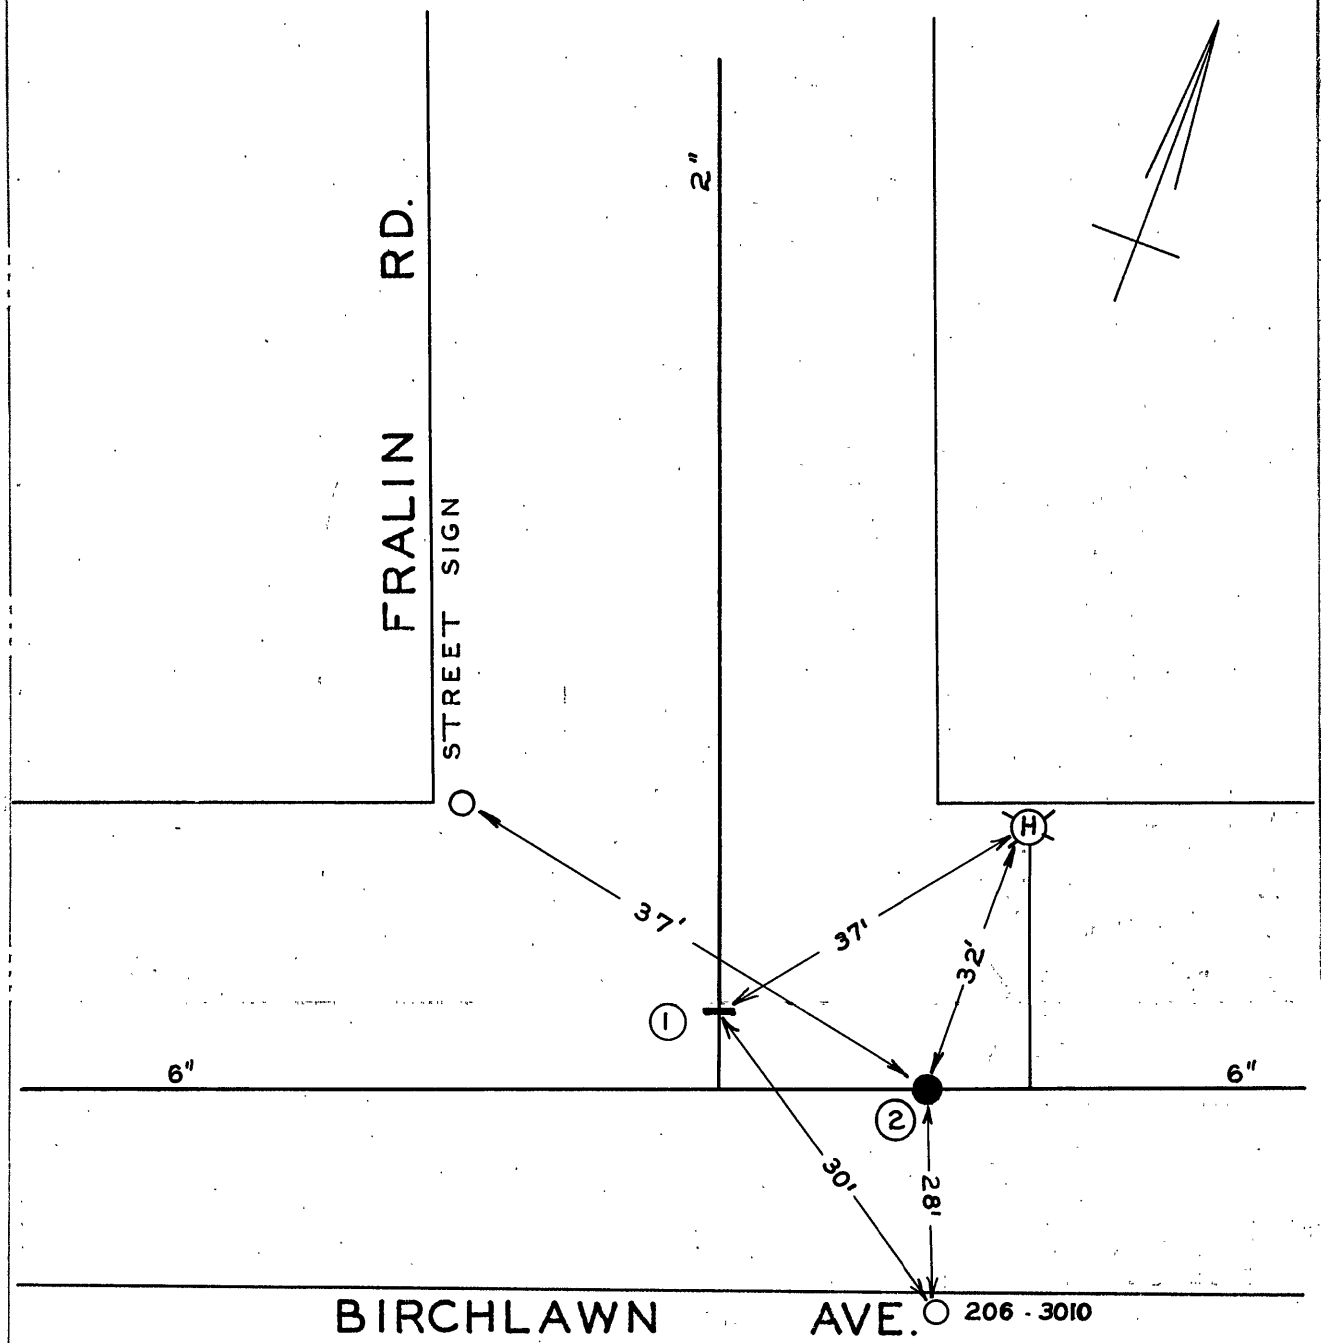


| DATE | NO. | SIZE | MAKE | OPEN | TURNS |
|---|---|---|---|---|---|
| 9-61 | 2 | 2" | DARLING | R | |
| 11-52 | 12 | 6" | D.A.R. | R | |
| | | | | | |
| | | | | | |
| | 1 | | | | |
| | 2 | 0 | EPL | | |

CITY OF ROANOKE — WATER DEPT.

VALVE DIAGRAM

BIRCHLAWN AVE. &

FRALIN RD. N.W.

SEC. MAP 218

DATE PAGE NO.

2/87 NP

"IMPERIAL" TRACING CLOTH K & E CO., N. Y.