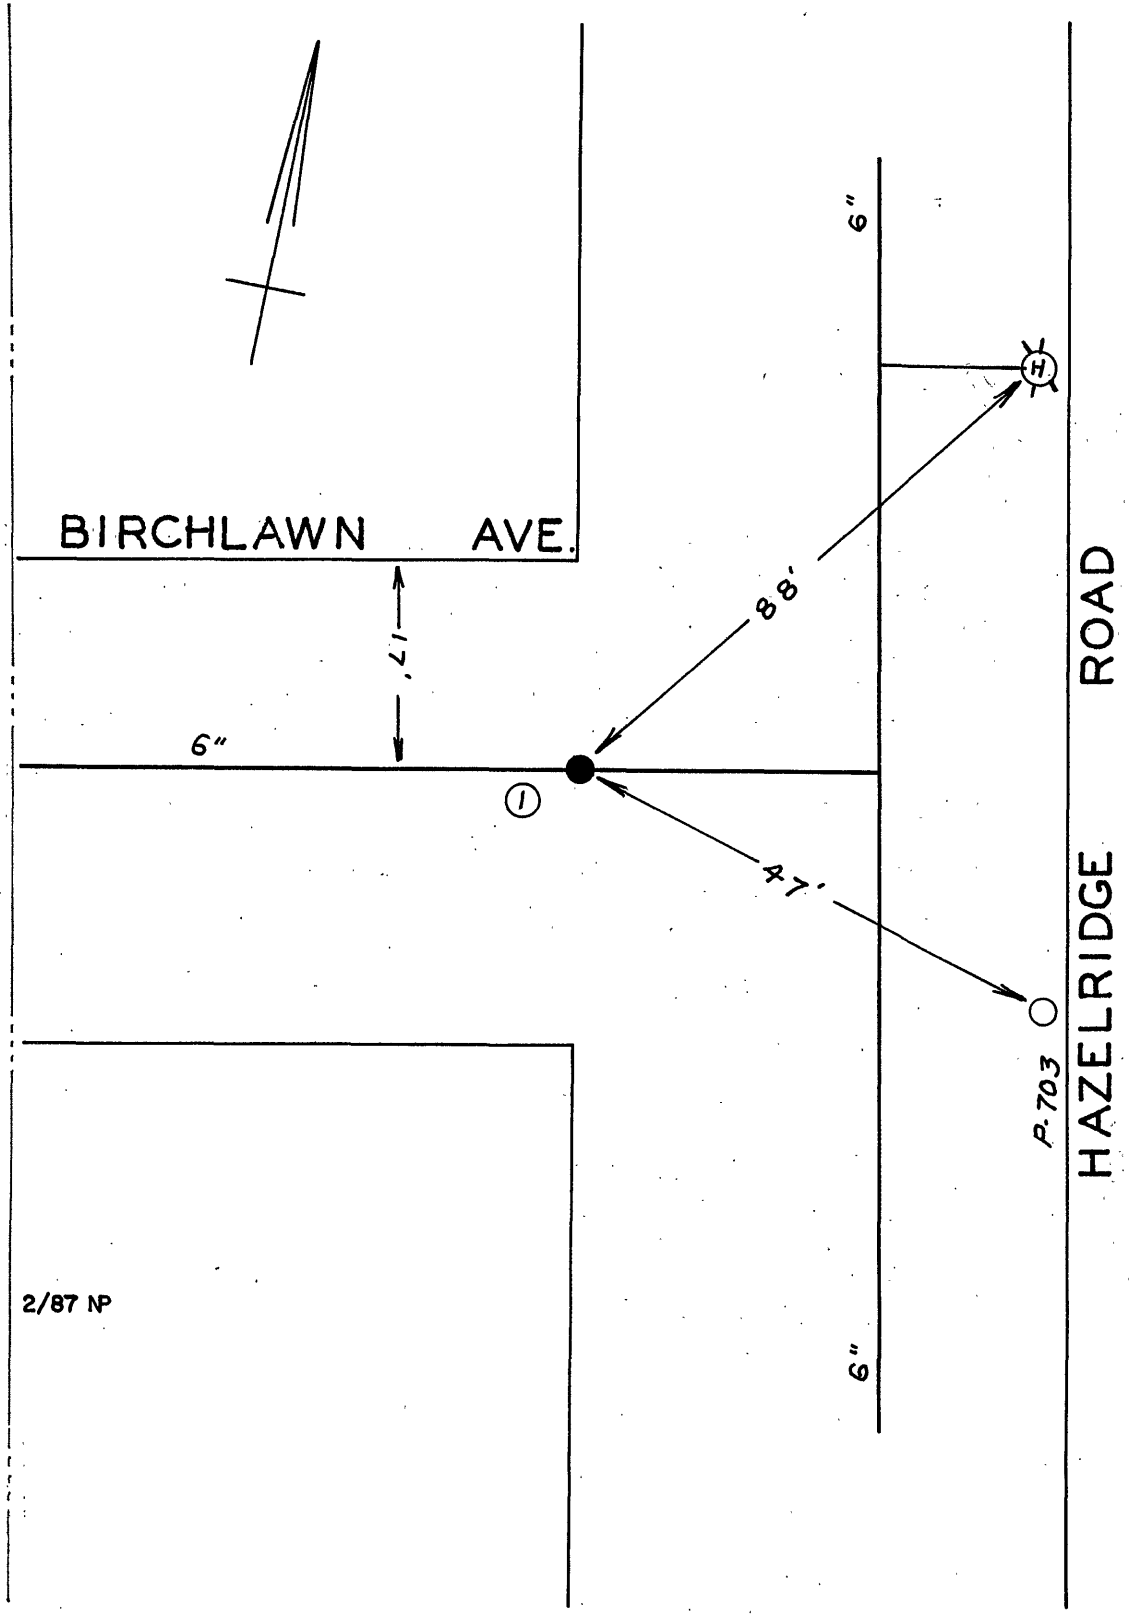

DATE	NO.	SIZE	MAKE	OPEN	TURNS
11-52	1	6"			
	1	0	WPL		

CITY OF ROANOKE—WATER DEPT.

VALVE DIAGRAM

BIRCHLAWN AVE.&

HAZELRIDGE RD. N.W.

SEC. MAP 218

DATE PAGE NO.

"IMPERIAL" TRACING CLOTH.
K & E CO., N.Y.