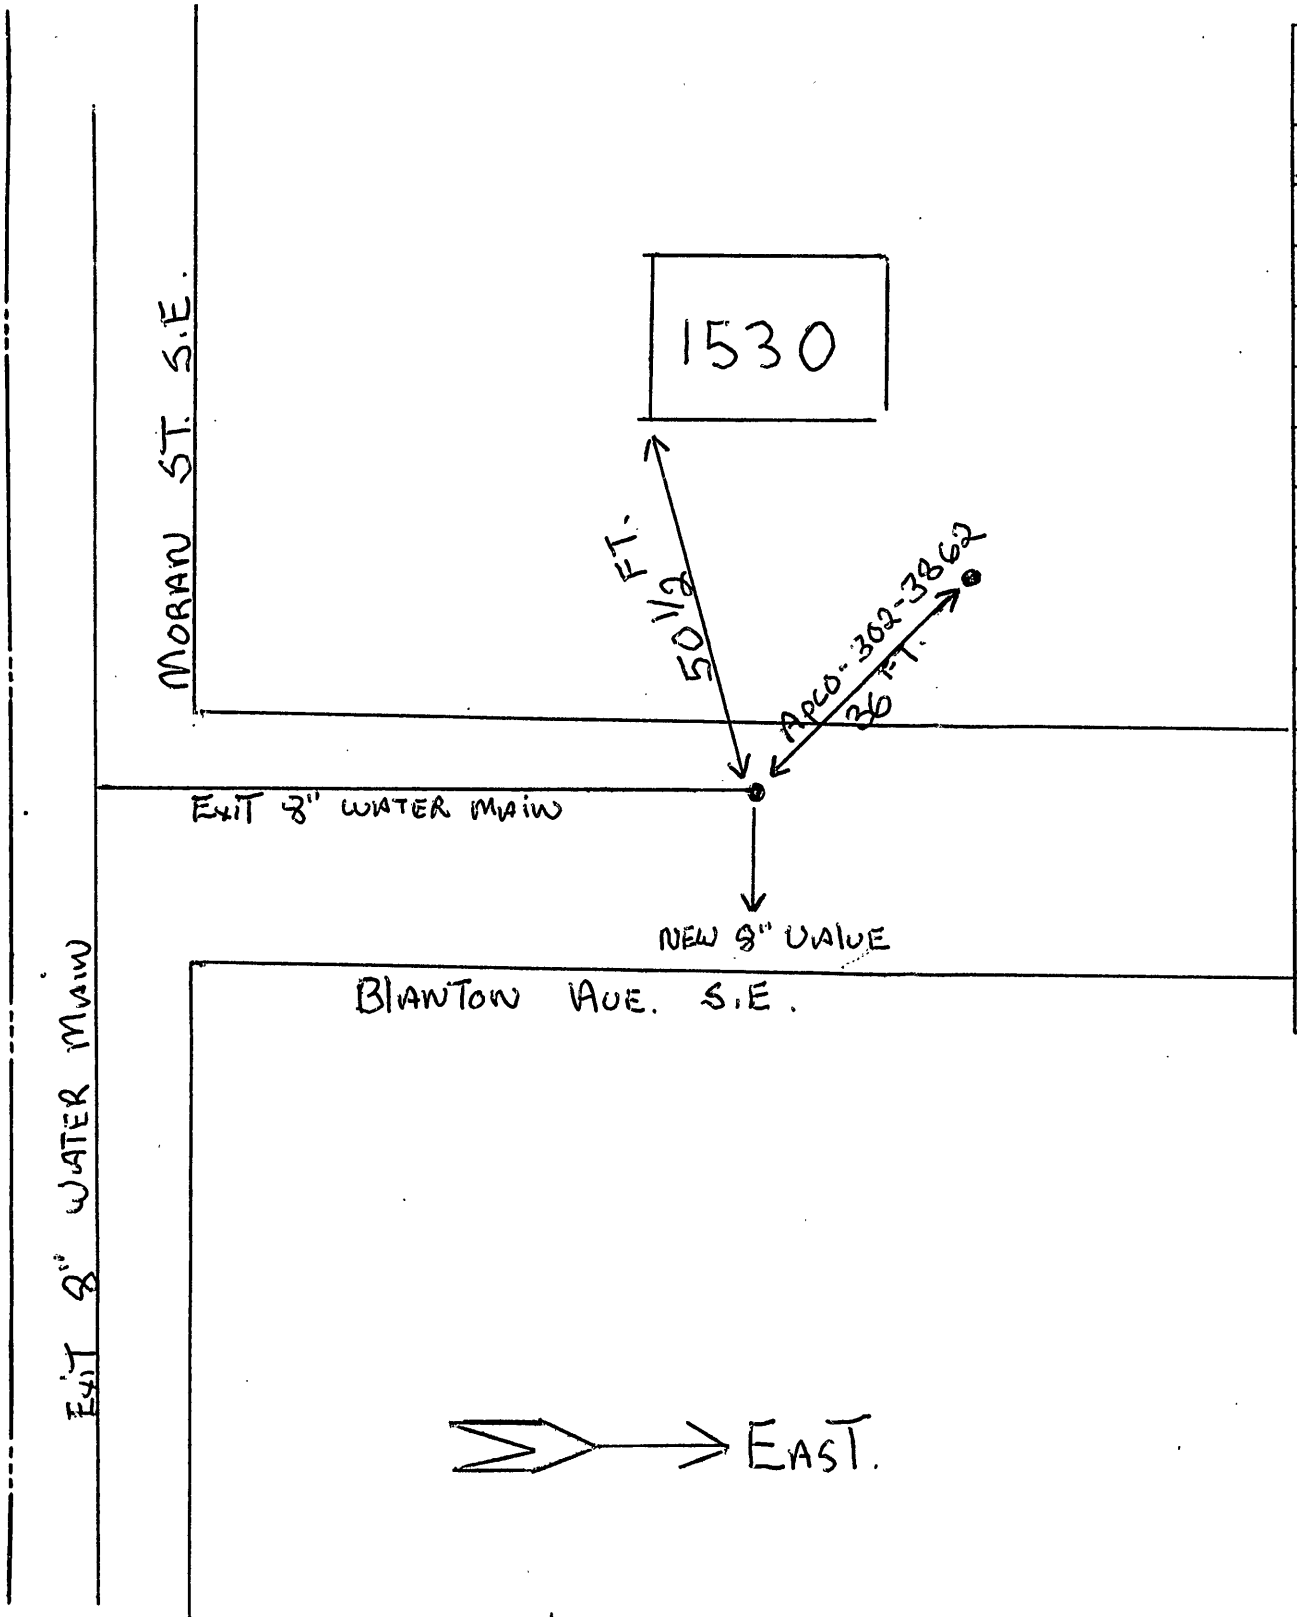


| DATE | NO. | SIZE | MAKE | OPEN | TURNS |
|---|---|---|---|---|---|
| 3-69 | 2 | 8" | AWA | R | 27 |
| | | | | | |
| | | | | | |
CITY OF ROANOKE—WATER DEP'T

**VALVE DIAGRAM**

1530 BLANTON AVE. S.E.

SEC. MAP 4140

DATE 3-6-02 PAGE NO. 4139